


WASTE GAS BURNERS FOR DIGESTER TANKS 9-14

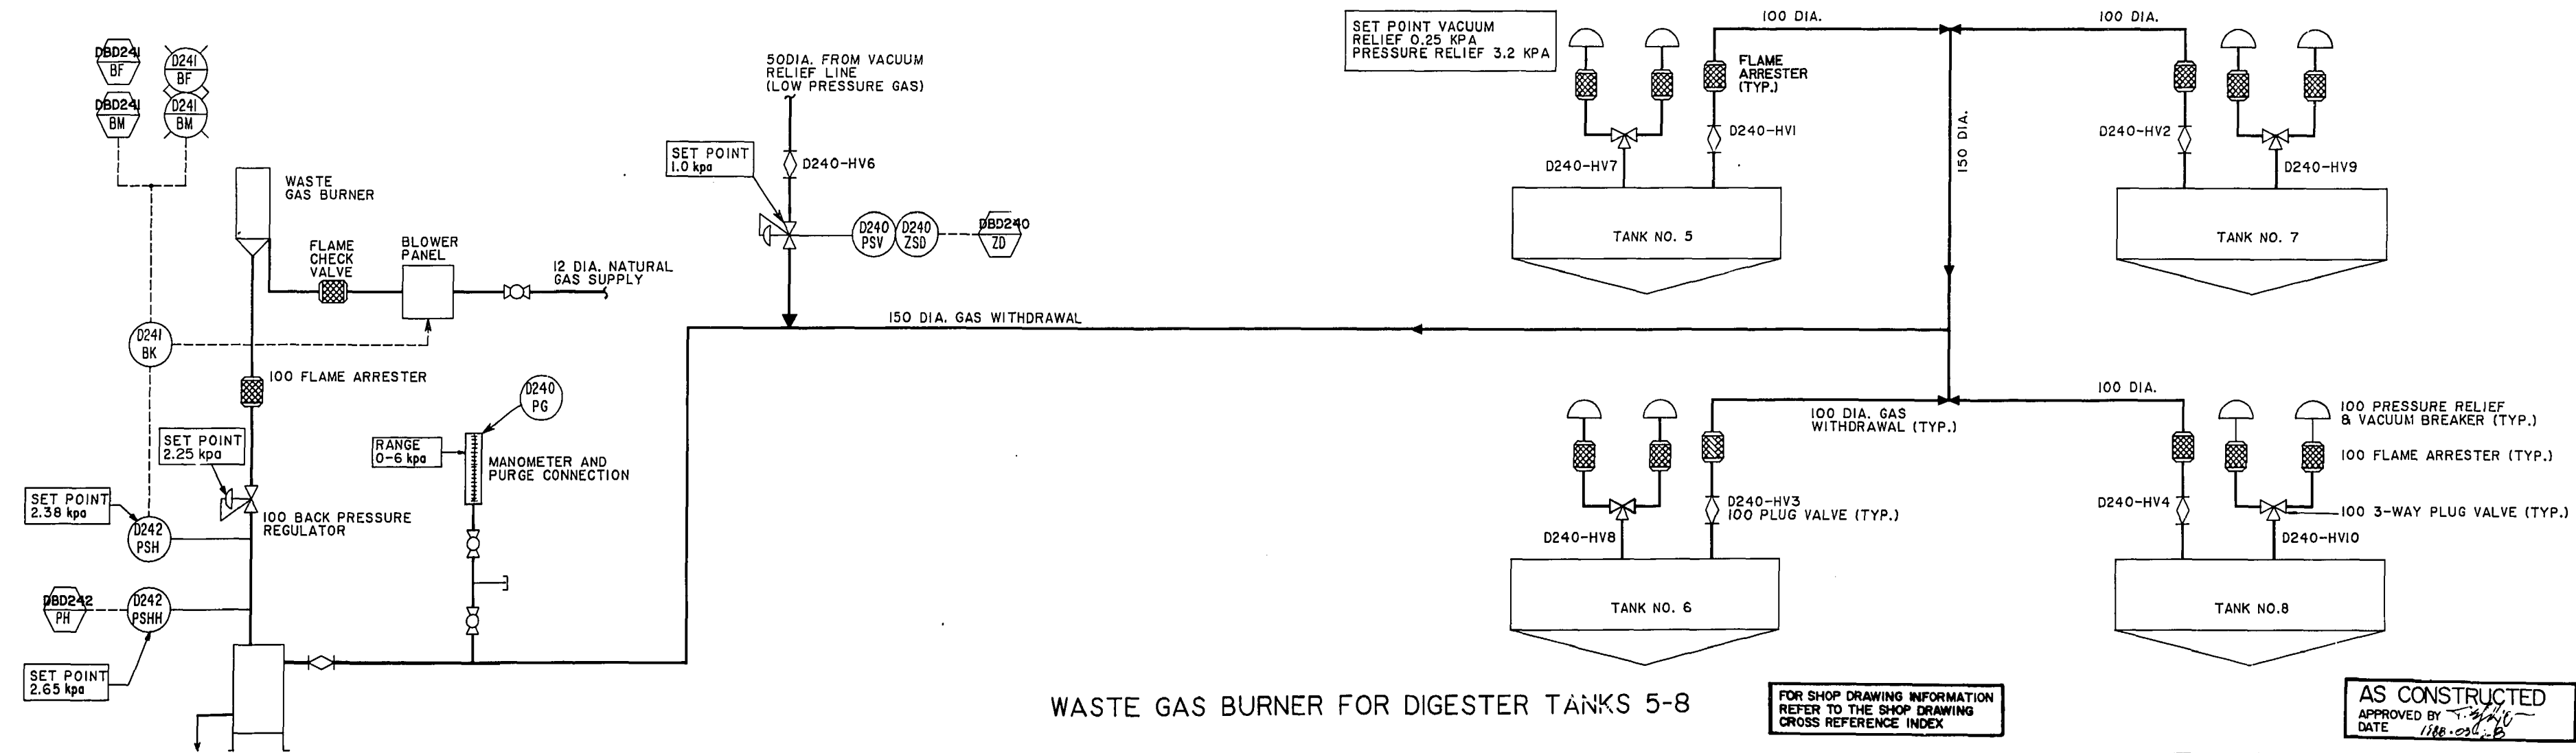

WASTE GAS BURNER FOR DIGESTER TANKS 5-8

FOR SHOP DRAWING INFORMATION REFER TO THE SHOP DRAWING CROSS REFERENCE INDEX

AS CONSTRUCTED APPROVED BY DATE

1. FOR CONTRACT DRAWING, SEE NEP-1333.
2. THIS DRAWING IS BASED ON FIELD DATA PROVIDED BY UMA.

NO	REVISIONS	DATE	APP
A	REVISED TO AS CONSTRUCTED		

AP.E.M. - 134 - 87
EXP. DATE : 88-10-13

ENGINEER'S SEAL

Underwood McLellan Ltd.
Consulting Engineers and Planners
GORE & STORRIE LIMITED
CONSULTING ENGINEERS

DESIGNED BY: C.A.D.D.
CHECKED BY: G. CRAWFORD
APPROVED BY:

DRAWN BY: C.A.D.D.
DATE: NOV. 87

THE CITY OF WINNIPEG
WORKS & OPERATIONS DIVISION
WATERWORKS, WASTE & DISPOSAL DEPARTMENT

NORTH END WATER POLLUTION CONTROL CENTRE
SLUDGE DIGESTION EXPANSION
WASTE GAS BURNERS
GAS PROCESS & INSTRUMENTATION DIAGRAMS

RELEASED FOR CONSTRUCTION DATE
AS CONSTRUCTED

SCALE: N.T.S.
DRAWING NO.: NEP-1333A