
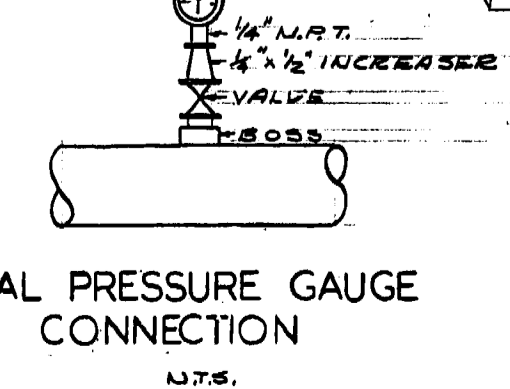
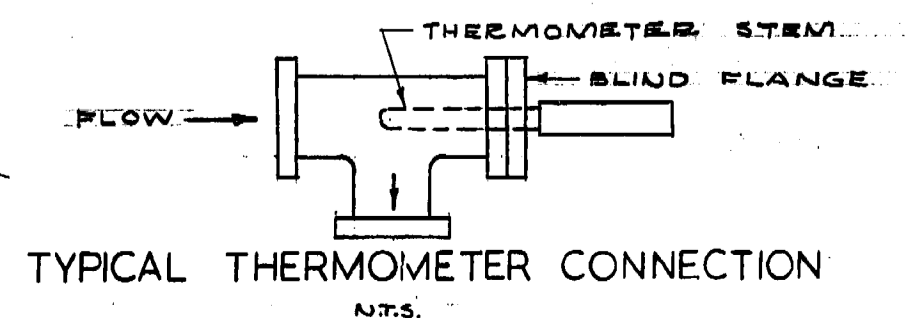


REF. or Drawing No. N.E.P.-134

DETAILS

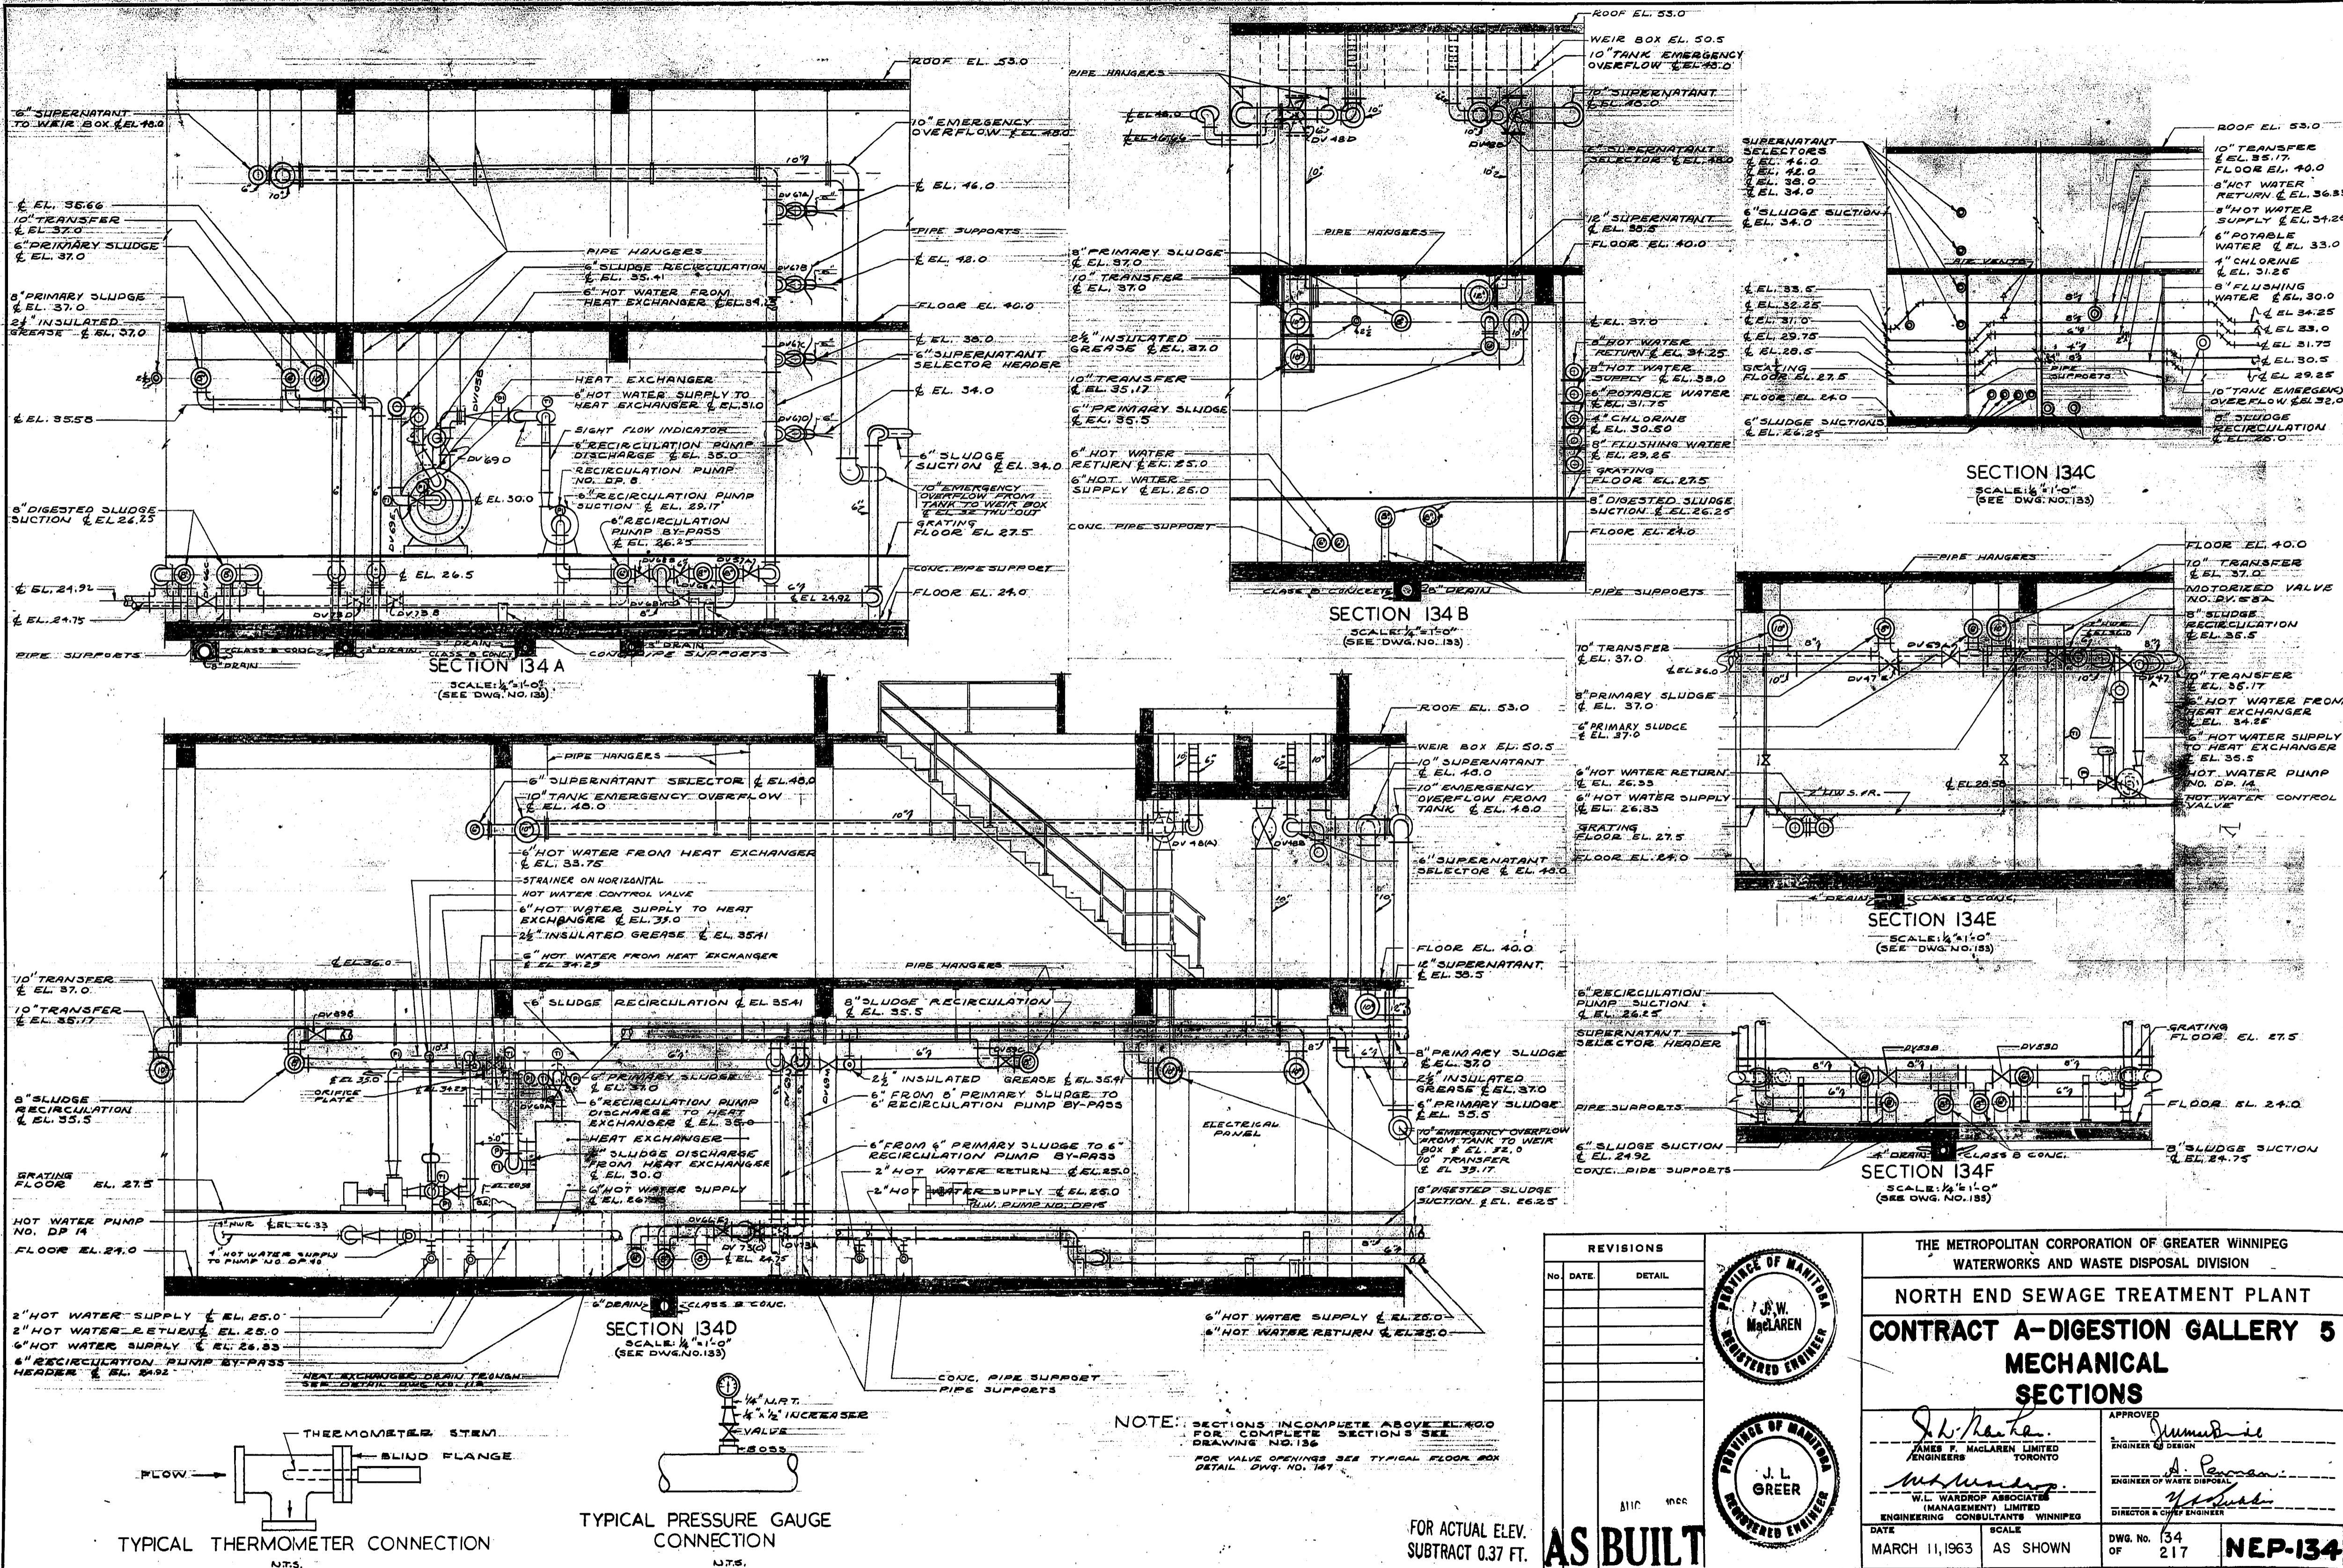


NOTE: SECTIONS INCOMPLETE ABOVE E.L. 40.0 FOR COMPLETE SECTION 5 SEE DRAWING NO. 136 FOR VALVE OPENINGS SEE TYPICAL FLOOR BOX DETAIL DWG. NO. 147

FOR ACTUAL ELEV. SUBTRACT 0.37 FT.

AS BUILT

REVISIONS		
No.	DATE	DETAIL

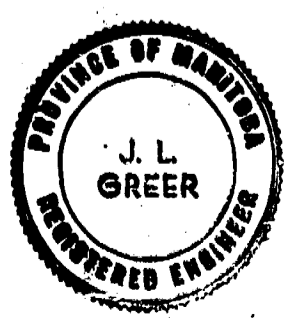

THE METROPOLITAN CORPORATION OF GREATER WINNIPEG
WATERWORKS AND WASTE DISPOSAL DIVISION

NORTH END SEWAGE TREATMENT PLANT

CONTRACT A-DIGESTION GALLERY 5

MECHANICAL SECTIONS

APPROVED: *J. MacLaren*
ENGINEER IN CHARGE

A. P. ...
ENGINEER OF WASTE DISPOSAL

W.L. Wardrop
W.L. WARDROP ASSOCIATES (MANAGEMENT) LIMITED
ENGINEERING CONSULTANTS WINNIPEG

DATE: MARCH 11, 1963 SCALE: AS SHOWN DWG. No. 134 OF 217 **NEP-134**