



**ROOF KEY PLAN OF DIGESTION TANKS**  
SCALE: 1" = 20'-0"

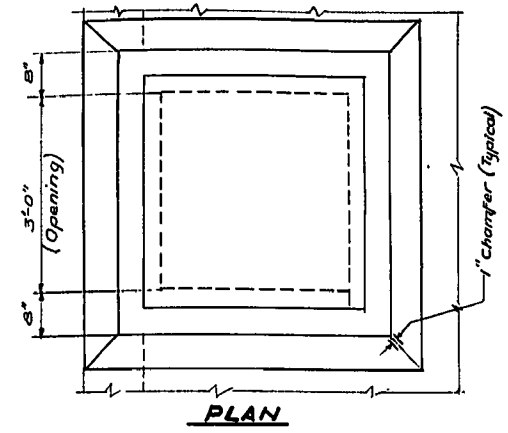


**PLAN**  
Supplier of mixer mechanism to provide Manhole Frames and Covers.

**SEC. B-B**  
TYPICAL OPENING FOR MIXER  
2 REQD. PER TANK  
SCALE: 1/4" = 1'-0"


NOTE: Supplier of mixer mechanism to provide frame and cover

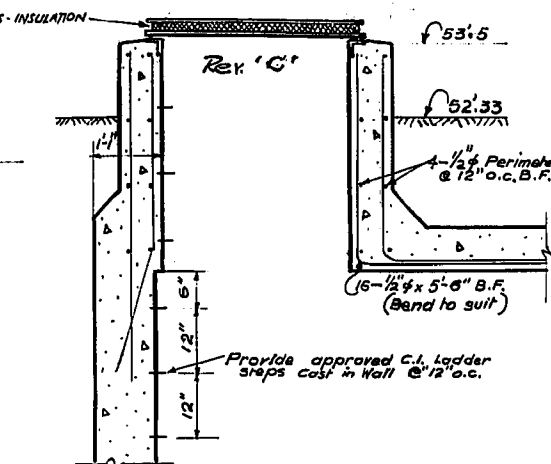


**SEC. C-C**  
TYPICAL MANHOLE - 2 REQD. PER TANK  
SCALE: 1/2" = 1'-0"

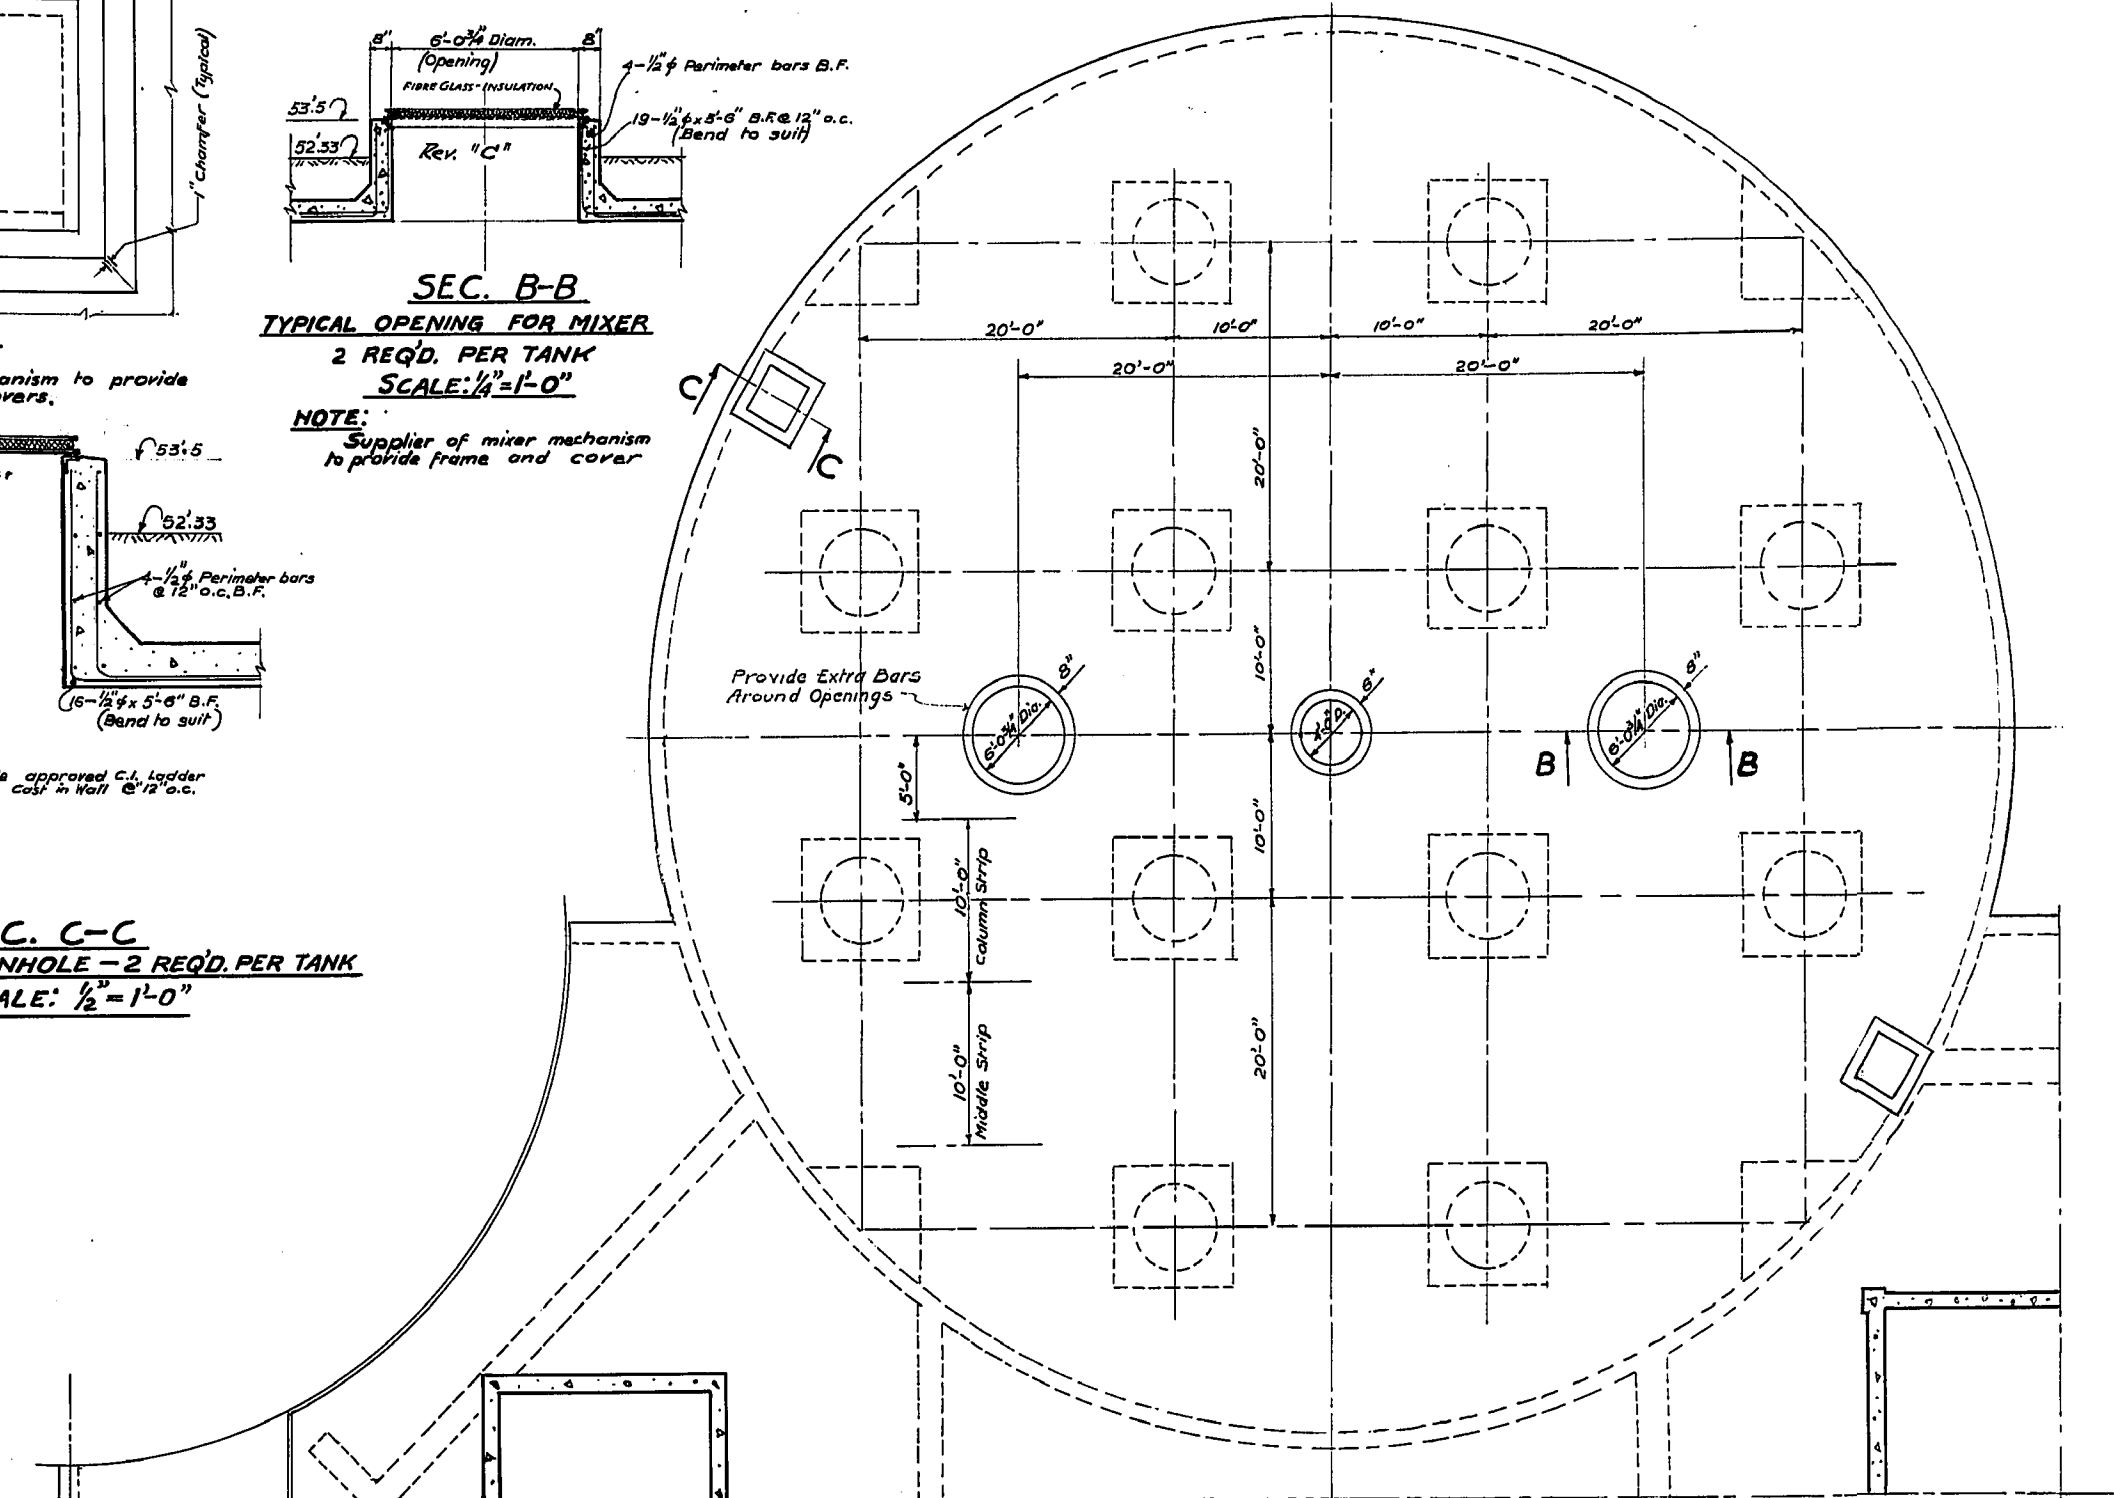


**TYPICAL PLAN VIEW OF DIGESTION TANK ROOF**  
SCALE: 1/8" = 1'-0"

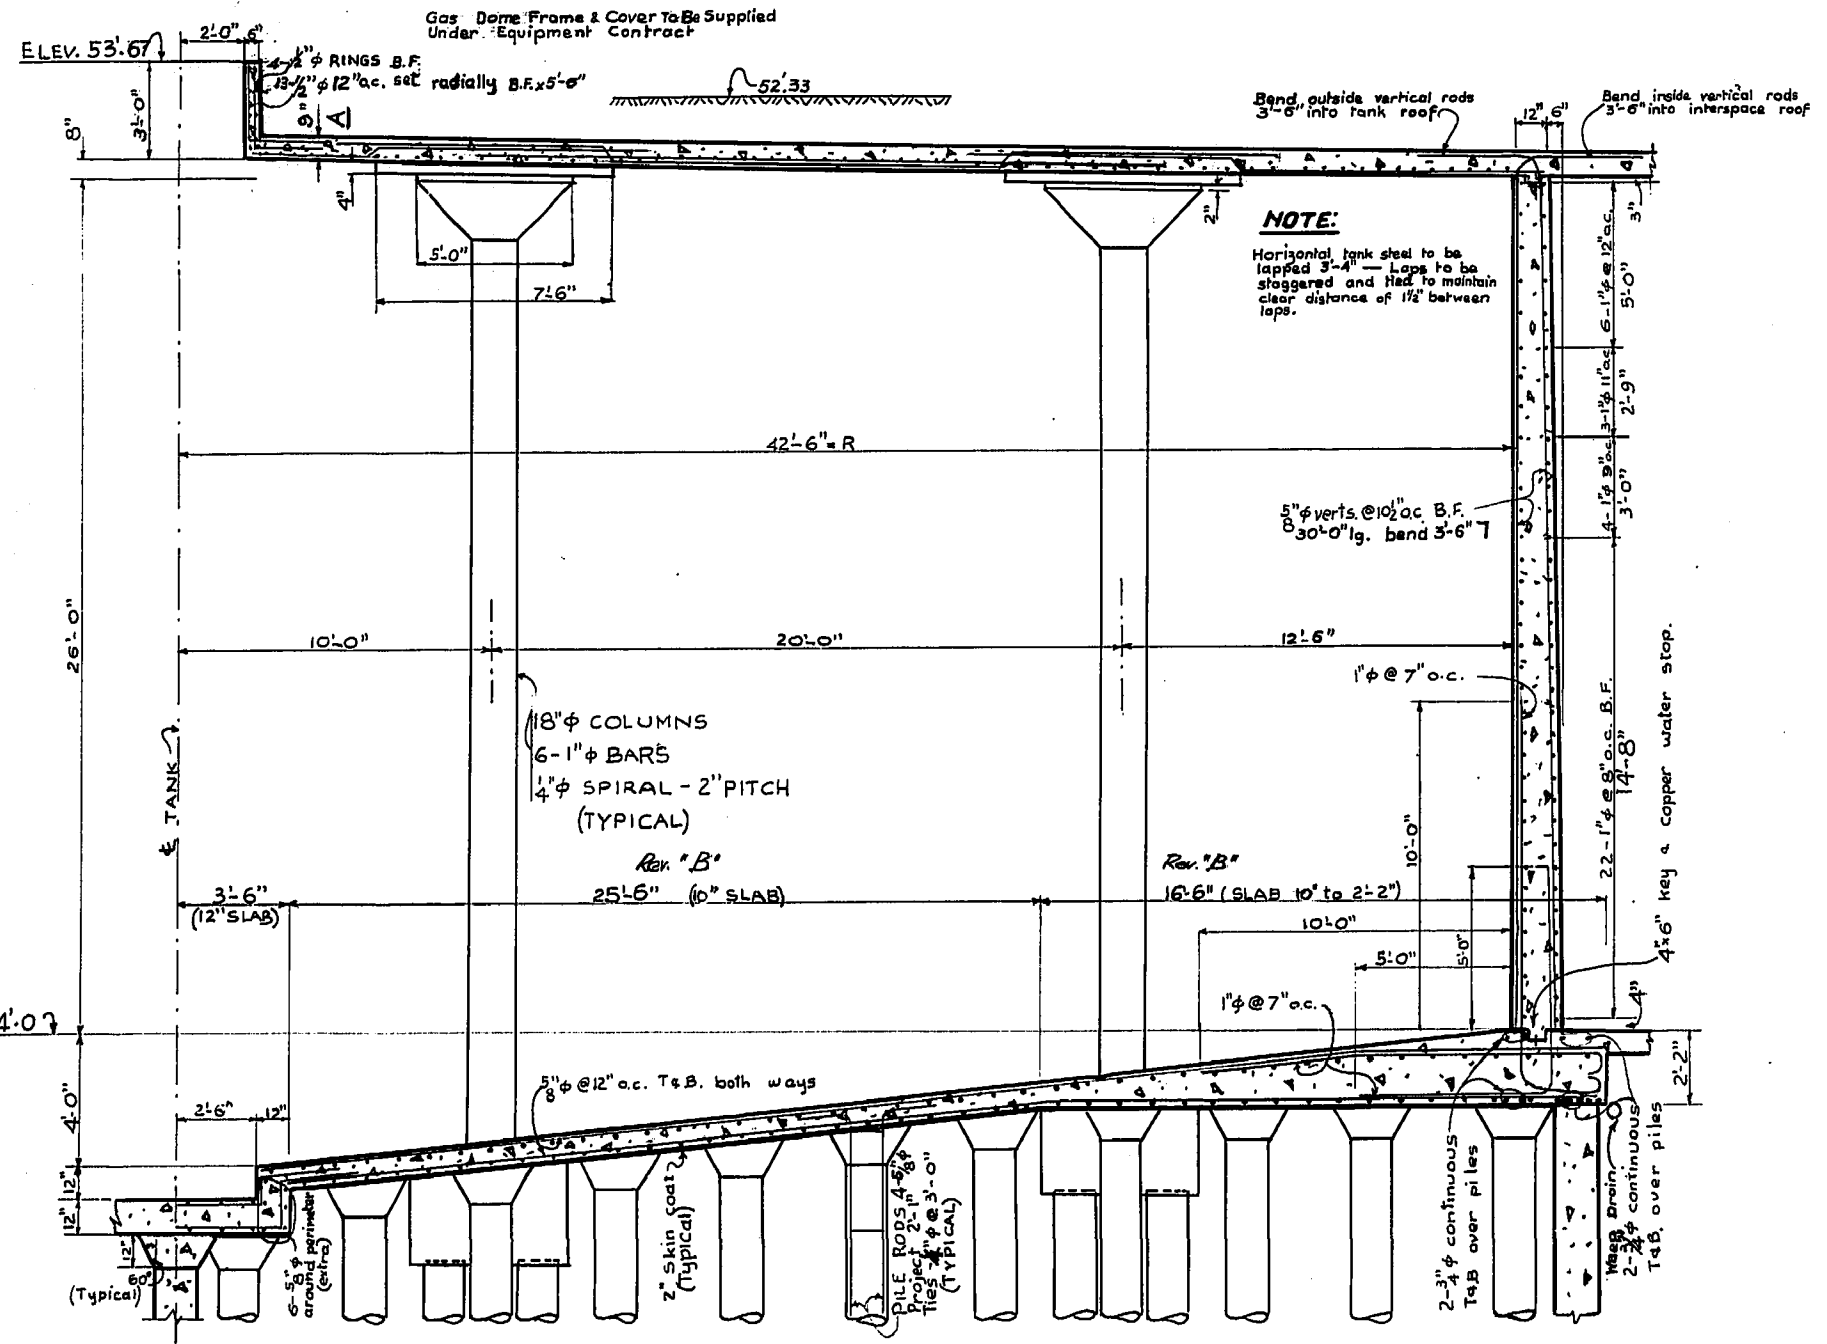


**SEC. A-A**  
TYPICAL SECTIONAL VIEW OF DIGESTION TANK  
SCALE: 1/4" = 1'-0"

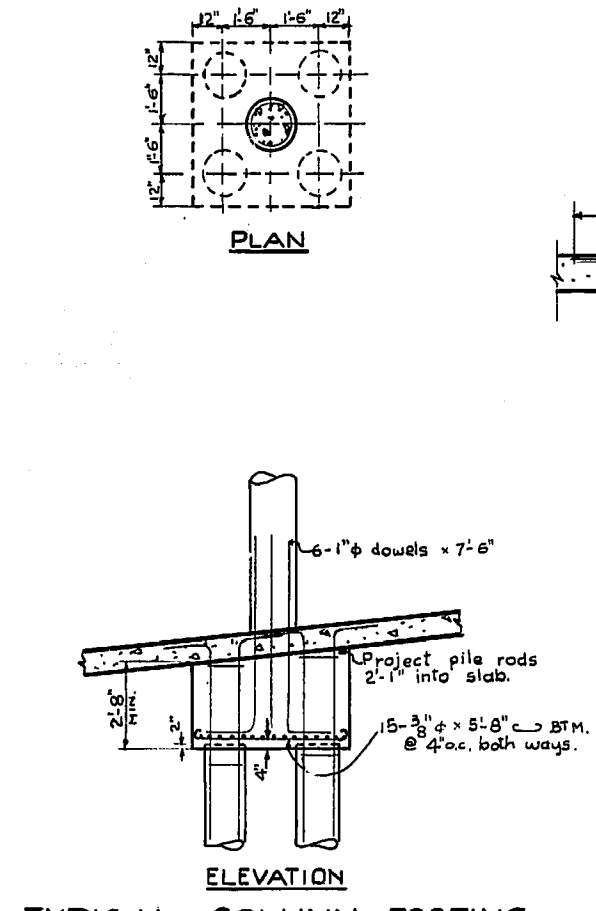

**TYPICAL COLUMN FOOTING**  
SCALE: 1/4" = 1'-0"

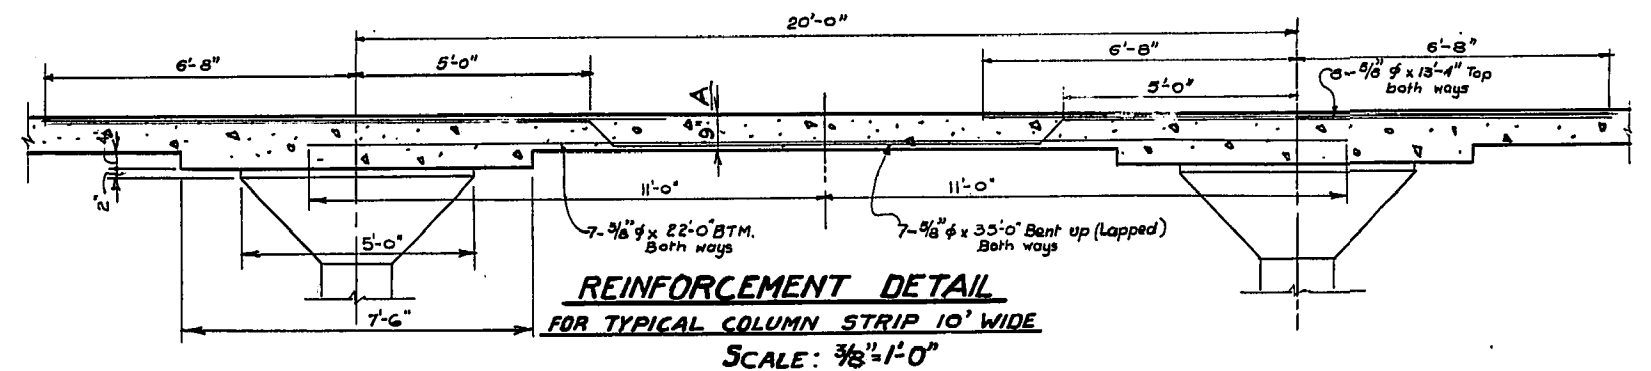


**REINFORCEMENT DETAIL**  
FOR TYPICAL COLUMN STRIP 10' WIDE  
SCALE: 3/8" = 1'-0"

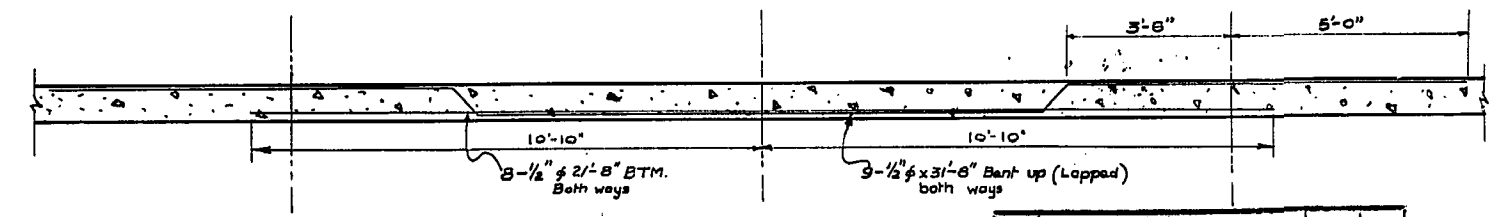


**REINFORCEMENT DETAIL**  
FOR TYPICAL MIDDLE STRIP 10' WIDE

REV.	DESCRIPTION	DATE	BY
A	REINF. STEEL REDESIGNED SEE DWG. PE 21 & 39	10-15-52	W.R.H.
B	10' FLOOR SLAB WAS 8" 2" SLAB CONCRETE WAS 10" ROOT SLAB WAS 9" SEE DWG. PE 21 & 32	7-4-53	A.P.
C	MANHOLE FRAMES AND COVERS ATTACHED		
D	18" 25' x 16" WAS 24" x 16" WAS 18" x 16"	12-4-53	A.P.

**APPROVED FOR CONSTRUCTION**  
Date APR 8 1959  
of this drawing covers only the design and general material or equipment and does not in any way constitute an approval of the work.

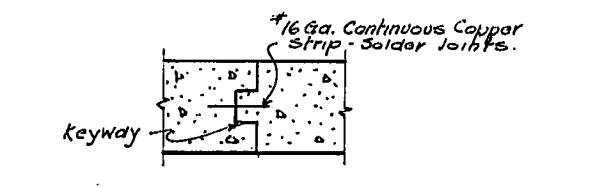

**TYPICAL ROOF SLAB CONSTRUCTION JOINT.**

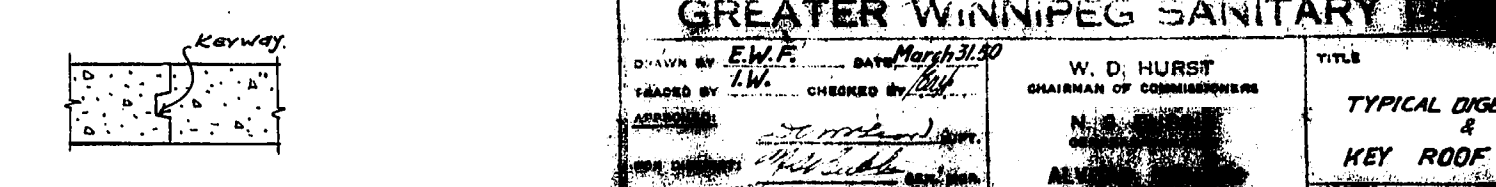

**TYPICAL VERTICAL WALL AND FLOOR SLAB CONSTRUCTION JOINT.**

**GREATER WINNIPEG SANITARY**  
CHAIRMAN OF COMMISSIONERS

W. D. HURST  
CHAIRMAN OF COMMISSIONERS

**TYPICAL DIGESTER SECTION & KEY ROOF PLAN**  
As Shown PE-5

DRAWN BY E.W.F. DATE March 31, 59  
CHECKED BY L.W. DATE