


**CONSTRUCTION NOTES**

① ADD FUSE TO VIBRATION TRANSMITTER SUPPLY.

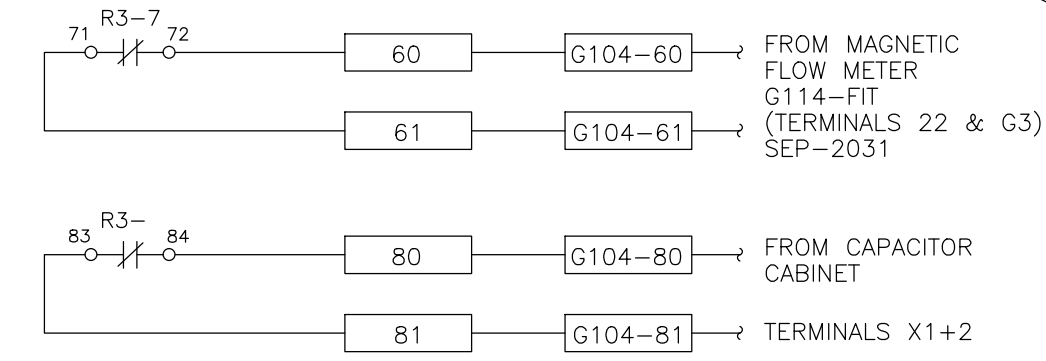

<p>SNC-LAVALIN INC. 148 Nature Park Way Winnipeg, Manitoba Canada R3P 0X7</p>				
DESIGNED: <b>T. CHURCH</b>	APPROVED: <b>C. REIMER</b>			
CHECKED: <b>C. REIMER</b>	DATE: <b>2010/10/01</b>			
PROJECT No. <b>112577</b>	SUBDIV. <b>0112</b>	SUBJECT <b>48 DD</b>	SERIAL <b>0117</b>	REV. <b>4</b>

**DRAWING ORIGINATED BY MacLAREN ENGINEERS INC. WARDROP ENGINEERING INC. ENGINEERING CONSULTANTS**

4	ADDED FUSE FOR VIBRATION TRANSMITTER	2010/10/01	TMC
3	GENERAL REVISIONS	01/07	CJH
2	REVISED TO DATE	11/06	P.B.
1	AS CONSTRUCTED	12/93	B.T.
0	ISSUED FOR CONSTRUCTION	09/92	B.T.
NO.	REVISIONS	DATE	BY

ORIGINAL DRAWING SEALED BY:  
T. CHURCH  
SNC-LAVALIN INC.  
2010/10/01  
REV. 04  
CHANGES ONLY

CONSULTANT DWG. NO.  
870012-01-20

**THE CITY OF WINNIPEG**  
WATER AND WASTE DEPARTMENT

SOUTH END WATER POLLUTION CONTROL CENTER	CITY DWG. NO.
PUMP & SCREEN BUILDING - I & C	SHEET 5 OF 5
RAW SEWAGE PUMPING SYSTEM	
RAW SEWAGE PUMP CONTROL	
LOOP NO. G104	SEP-2023