


- 1 LT, LEVEL INDICATION TO DCS
- 2 LIT, LEVEL INDICATING TRANSMITTER
- 3
- 4
- 5 LE, ULTRASONIC LEVEL SENSOR
- 6 LI, PANEL MOUNTED WET WELL LEVEL INDICATOR
- 7 RY, LOW WET WELL LEVEL RELAY #2
- 8 RX, LOW WET WELL LEVEL PUMP LOCKOUT RELAY
- 9
- 10
- 11
- 12
- 13
- 14
- 15
- 16 LA, LOW LEVEL ALARM TO DCS
- 17

LEGEND:
 - - - - - WORK TO BE REMOVED
 ———— WORK TO BE ADDED

CONSTRUCTION NOTES
 ① REMOVE TRIP CONTACT FROM LI-G107 AND MOVE TO LIT-G107.

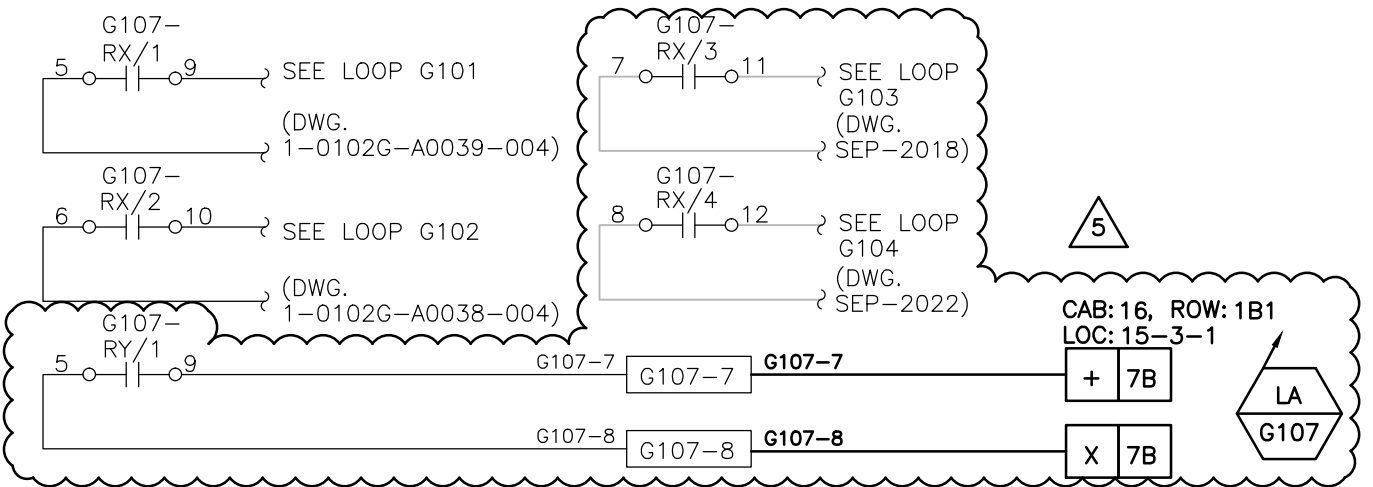

SNC-LAVALIN INC. 148 Nature Park Way Winnipeg, Manitoba Canada R3P 0X7				
DESIGNED: T. CHURCH		APPROVED: C. REIMER		
CHECKED: C. RIEMER		DATE: 2010/10/01		
PROJECT No.	SUBDIV.	SUBJECT	SERIAL	REV.
112577	0112	48 DD	0119	5

MacLAREN ENGINEERS INC. WARDROP ENGINEERING INC. ENGINEERING CONSULTANTS				
5	ADDED DCS LOW LEVEL ALARM	2010/10/01	TMC	DESIGNED BY: RH
4	REMOVE RESET SWITCH	10.01.28	SPH	DRAWN BY: RH
3	ADDED MANUAL RESET	07/94	DOD	SCALE: N.T.S.
2	AS CONSTRUCTED	09/92	B.T.	
1	ISSUED FOR CONSTRUCTION	07/92	B.T.	
-	ADD RELAY "RY"	09/92	B.T.	
NO. REVISIONS	DATE	BY	DATE:	06/92

ORIGINAL DRAWING
 SEALED BY:
 T. CHURCH
 SNC-LAVALIN INC.
 2010/10/01
 REV. 05
 CHANGES ONLY

CONSULTANT DWG. NO.
 870012-01-20

THE CITY OF WINNIPEG WORKS AND OPERATIONS DIVISION WATERWORKS, WASTE & DISPOSAL DEPARTMENT	
SOUTH END WATER POLLUTION CONTROL CENTER PUMP & SCREEN BUILDING - I & C RAW SEWAGE PUMPING EAST WET WELL LEVEL LOOP NO. G107	CITY DWG. NO. SHEET 1 OF 1 SEP-2025