


FDP-G (FIELD DEVICE PANEL -G) (120VAC DISTRIBUTION)

FROM POWER DISTRIBUTION PANEL 4G CCT. #4

N ↗
L ↘

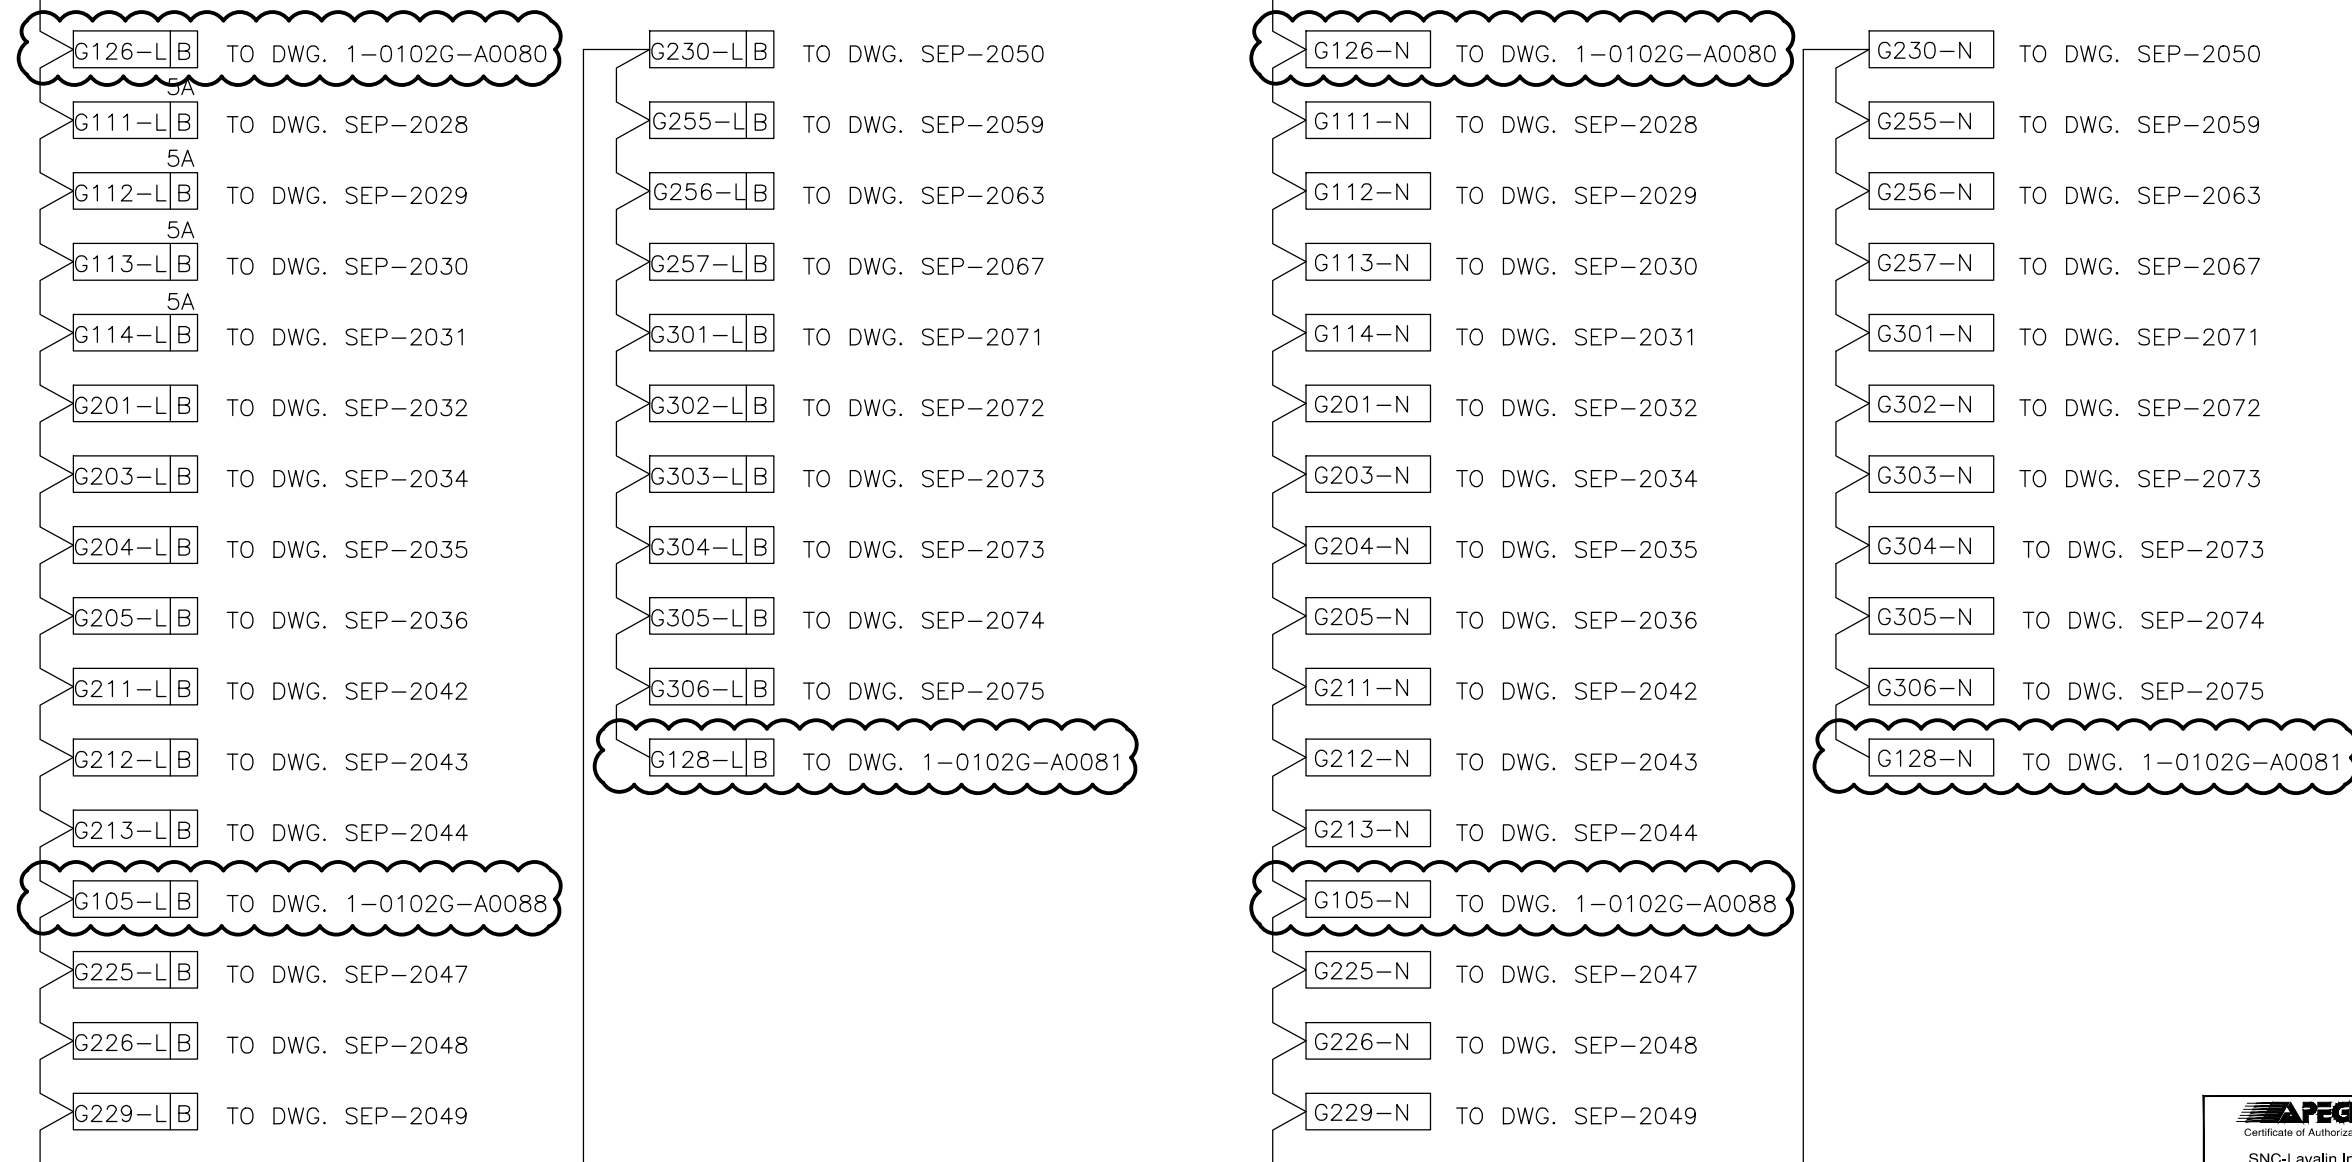

NOTE:

1. ALL BREAKERS RATED AT 120 VAC, 1 AMP. UNLESS OTHERWISE NOTED.

SNC-LAVALIN INC. 148 Nature Park Way Winnipeg, Manitoba Canada R3P 0X7				
DESIGNED: T. CHURCH		APPROVED: C. RIEMER		
CHECKED: C. RIEMER		DATE: 2010/10/01		
PROJECT No.	SUBDIV.	SUBJECT	SERIAL	REV.
112577	0112	48 DD	0150	3

MacLAREN ENGINEERS INC. WARDROP ENGINEERING INC. ENGINEERING CONSULTANTS				
3	HEADWORKS UPGRADES MODIFICATIONS	2010/10/01	TMC	DESIGNED BY: RH
2	CHANGE TERMS. TO SPARE	10.02.03	SPH	DRAWN BY: RH
1	ISSUED FOR CONSTRUCTION	08/92	B.T.	SCALE: N.T.S.
0	AS CONSTRUCTED	09/92	B.T.	
-		12/93	B.T.	
NO. REVISIONS		DATE	BY	DATE: 08/92

ORIGINAL DRAWING SEALED BY:
 T. CHURCH
 SNC-LAVALIN INC.
 2010/10/01
 REV. 03
 CHANGES ONLY

CONSULTANT DWG. NO.
 870012-01-20

THE CITY OF WINNIPEG WORKS AND OPERATIONS DIVISION WATERWORKS, WASTE & DISPOSAL DEPARTMENT		
SOUTH END WATER POLLUTION CONTROL CENTER		CITY DWG. NO.
PUMP AND SCREEN BUILDING - I & C		SHEET 1 OF 1
FIELD DEVICE PANEL FDP-G		
120 VAC POWER DISTRIBUTION		
WIRING DIAGRAM		SEP-2128