


FDP-G (FIELD DEVICE PANEL -G) (120VAC,24VDC AND 12VDC DISTRIBUTION)

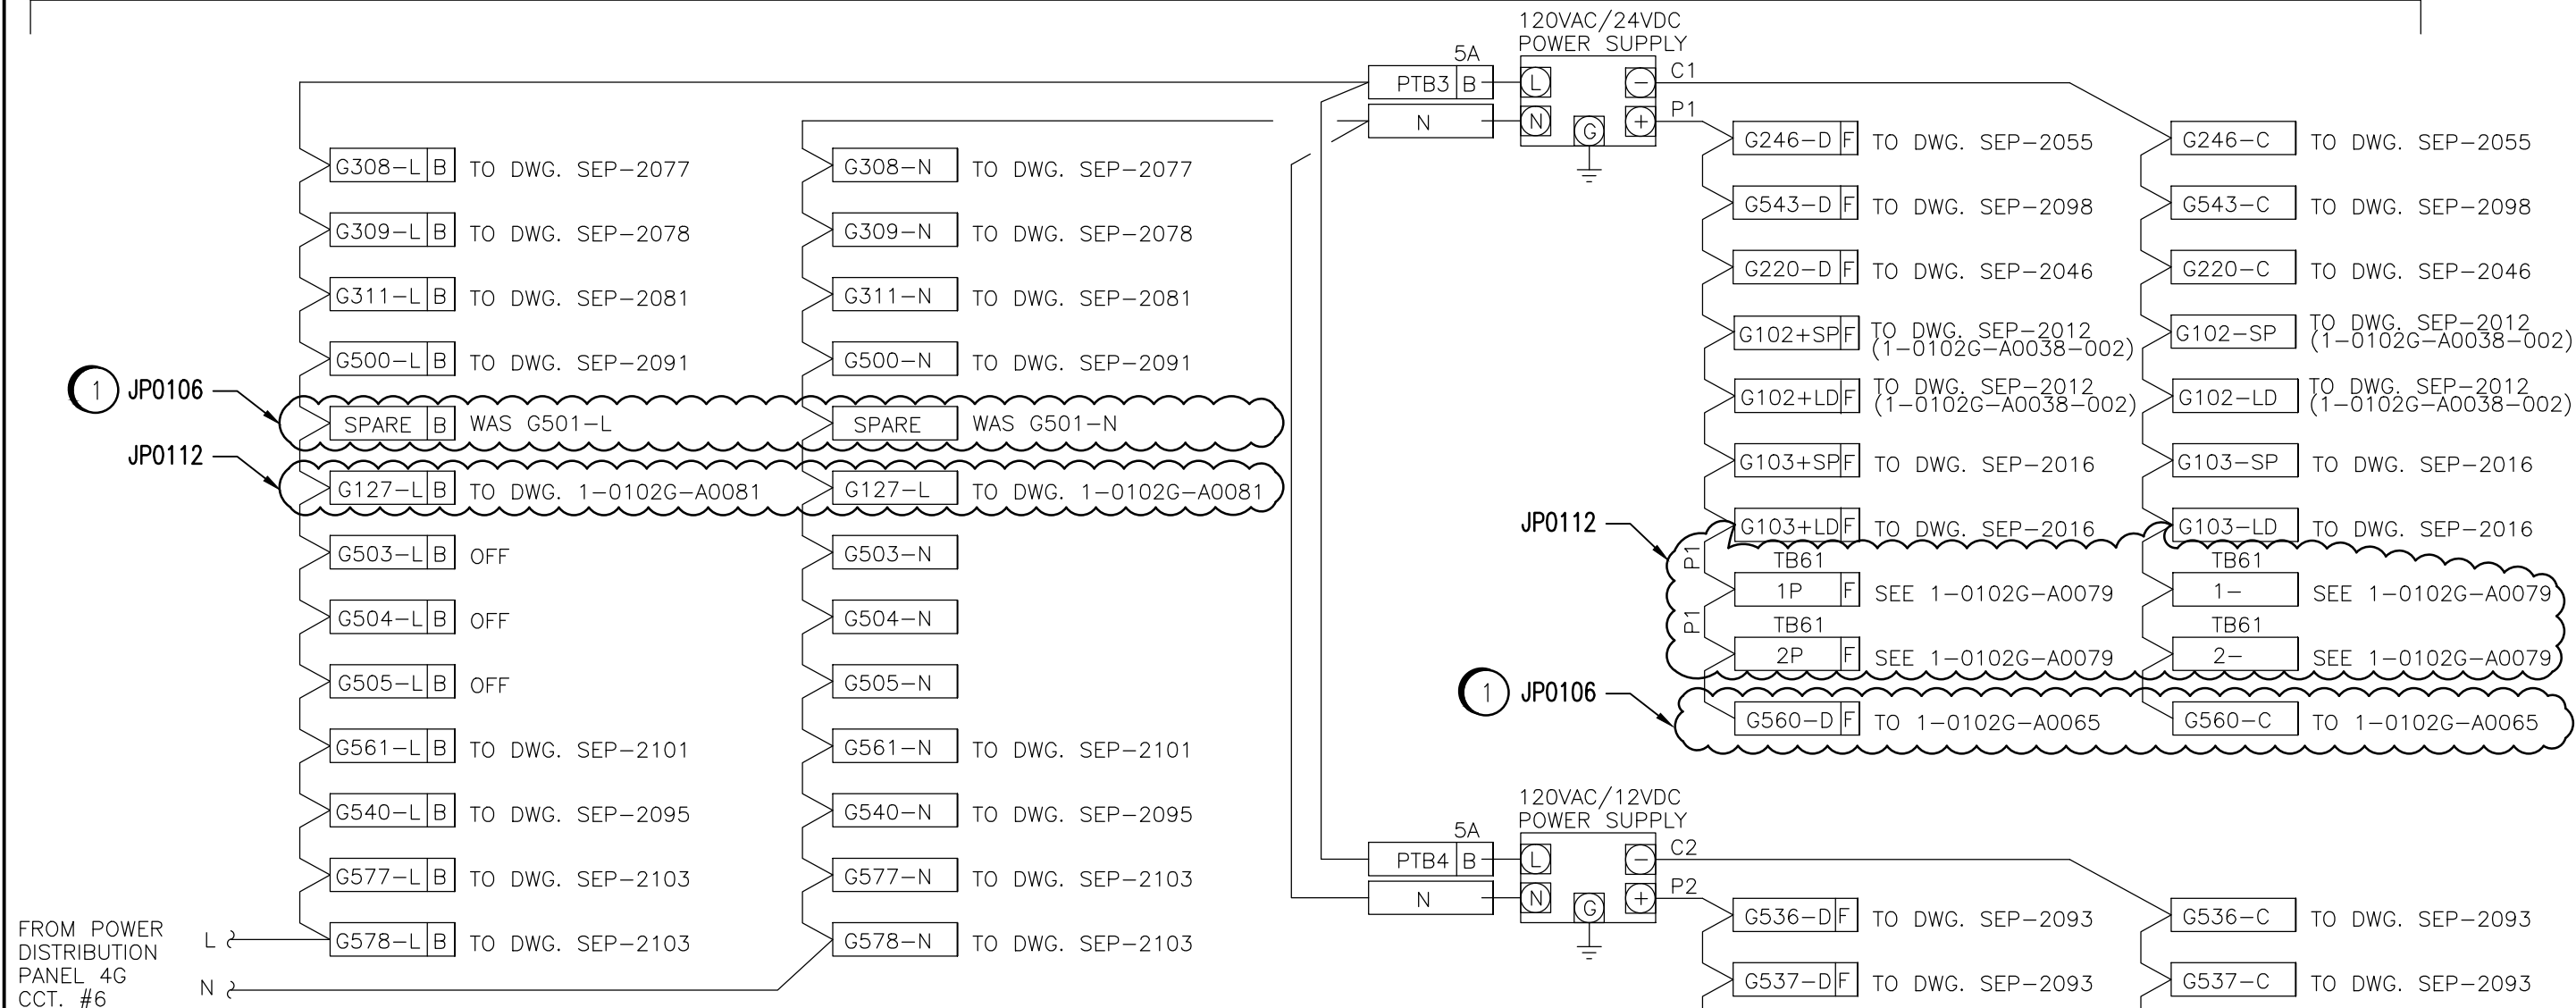

FROM POWER DISTRIBUTION PANEL 4G CCT. #6
L ↗
N ↘

CONSTRUCTION NOTES

1 WORK MARKED AS JP0106 IS NOT WITHIN THE SCOPE OF WORK OF THE HEADWORKS UPGRADES.

 SNC-LAVALIN INC. 148 Nature Park Way Winnipeg, Manitoba Canada R3P 0X7				
DESIGNED:	T. CHURCH		APPROVED:	C. REIMER
CHECKED:	C. REIMER		DATE:	2010/10/01
PROJECT No.	SUBDIV.	SUBJECT	SERIAL	REV.
112577	0112	48 DD	0151	3

NOTE:

1. ALL BREAKERS AND FUSES RATED AT 120 VAC, 1 AMP. UNLESS OTHERWISE NOTED.



MacLAREN ENGINEERS INC. WARDROP ENGINEERING INC. ENGINEERING CONSULTANTS				
3	HEADWORKS UPGRADES MODIFICATIONS	2010/10/01	TMC	DESIGNED BY: RH
2	ADD TERMINALS	10.02.03	SPH	DRAWN BY: RH
1	ISSUED FOR CONSTRUCTION	08/92	B.T.	SCALE: N.T.S.
0	AS CONSTRUCTED	09/92	B.T.	
-		12/93	B.T.	
NO.	REVISIONS	DATE	BY	DATE: 08/92

ORIGINAL DRAWING SEALED BY:
 T. CHURCH
 SNC-LAVALIN INC.
 2010/10/01
 REV. 03
 CHANGES ONLY

CONSULTANT DWG. NO.
 870012-01-20

 THE CITY OF WINNIPEG WORKS AND OPERATIONS DIVISION WATERWORKS, WASTE & DISPOSAL DEPARTMENT	
SOUTH END WATER POLLUTION CONTROL CENTER PUMP & SCREEN BUILDING - I & C FIELD DEVICE PANEL FDP-G 120 VAC, 24VDC & 12 VDC POWER DISTRIBUTION WIRING DIAGRAM	CITY DWG. NO. SHEET 1 OF 1 SEP-2129