

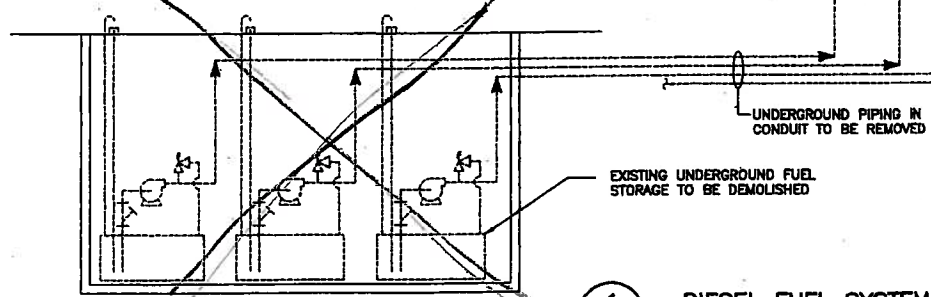
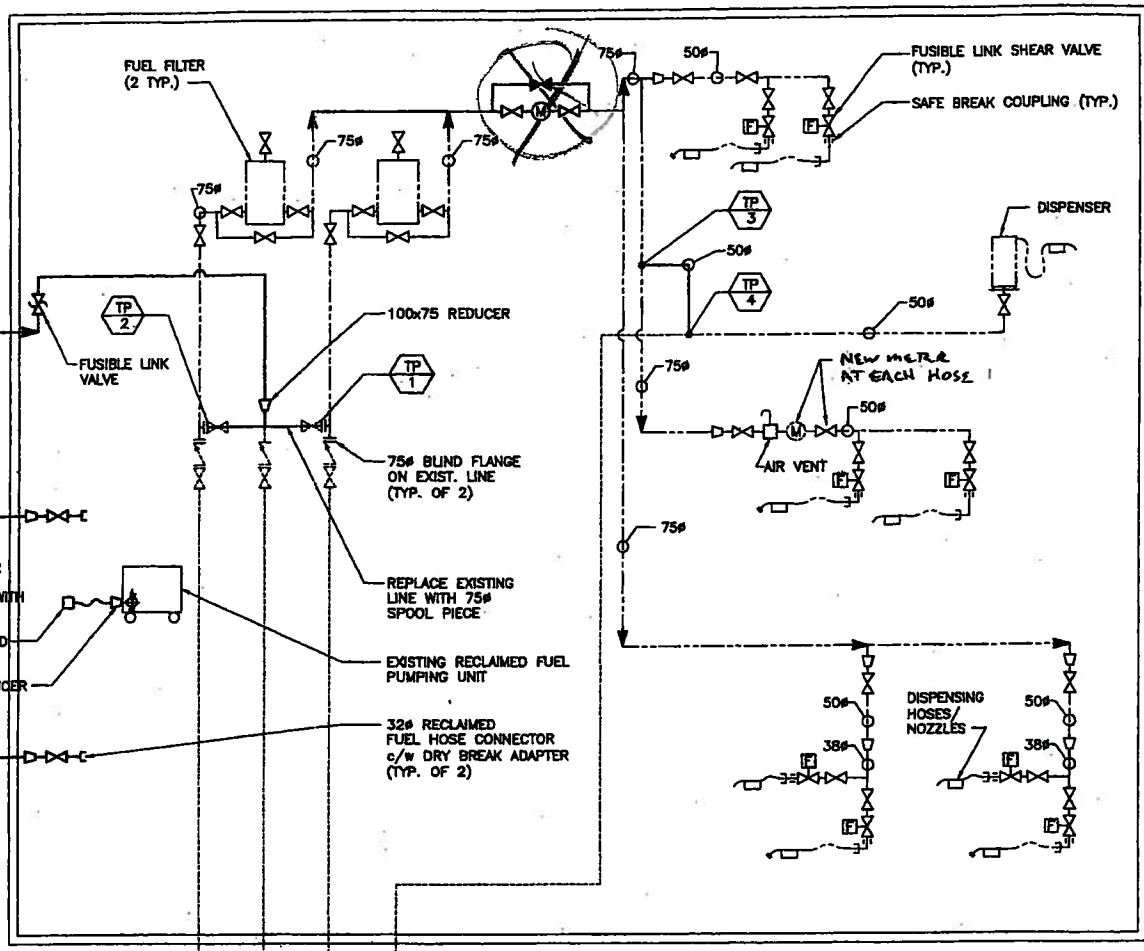
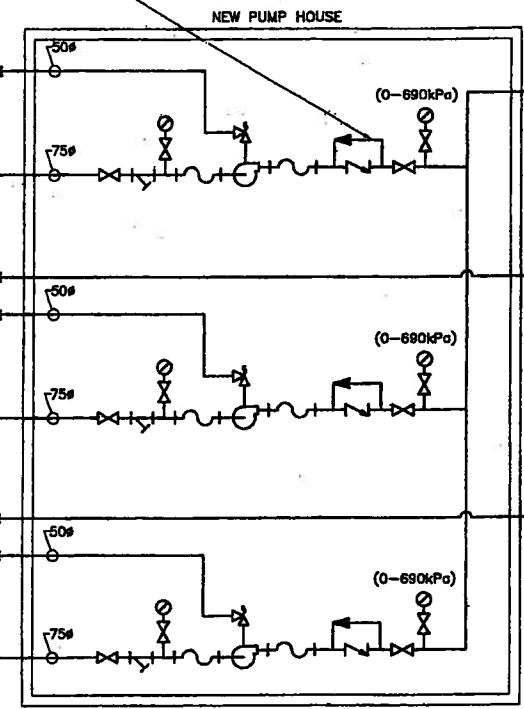


NOTES:

SEE DRAWING M0001 FOR LEGEND

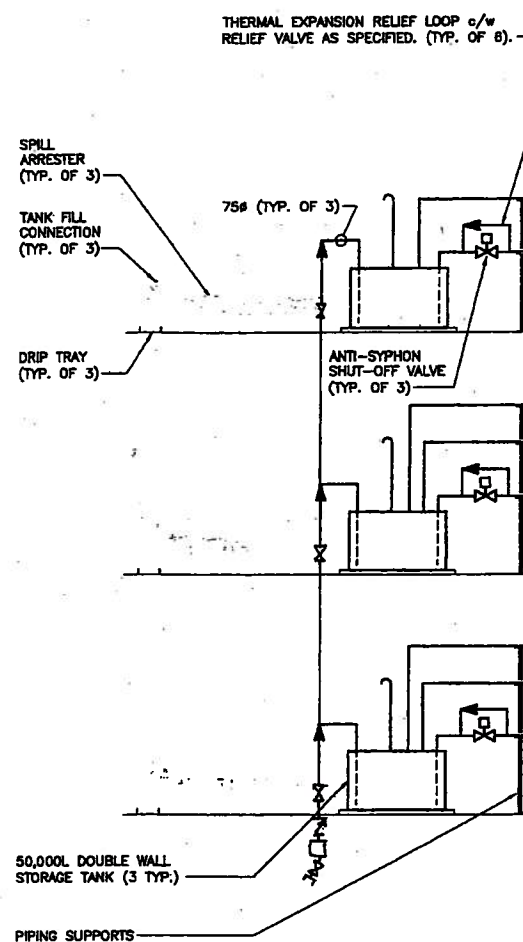

1 DIESEL FUEL SYSTEM
N.T.S.

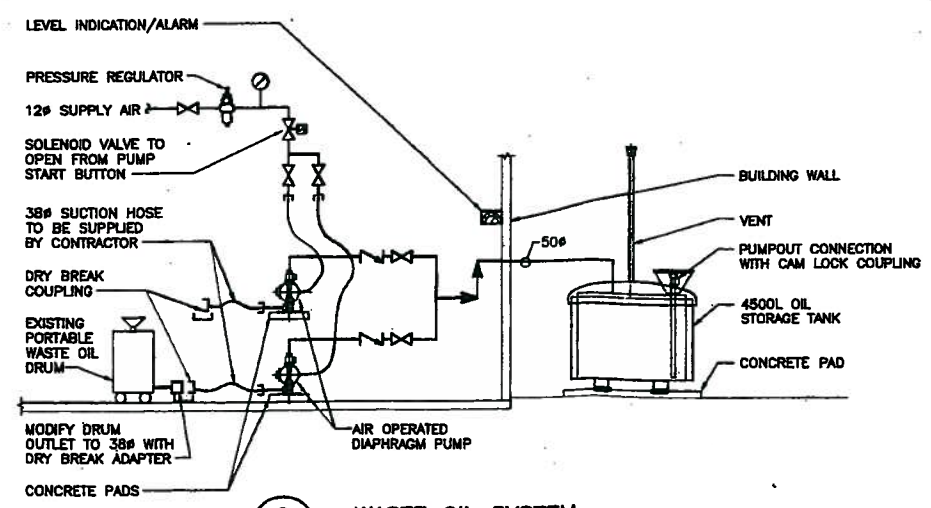

2 WASTE OIL SYSTEM
N.T.S.

J.A. Robinson Pump Service Ltd.
APPROVED
By: *J. Hode* Date: Nov. 24/08
As Built Drawing: This drawing has been revised to show mechanical system as installed.



0 ISSUED FOR TENDER		07.04.08	LWS
NO.	DESCRIPTION	DATE	ISSUED BY
REVISIONS/ISSUE			
<small>THE CONTENT OF THIS DOCUMENT IS NOT INTENDED FOR THE USE OF, NOR IS IT DESIGNED TO BE RELIED UPON BY ANY PERSON, FIRM OR CORPORATION OTHER THAN THE CLIENT AND WARDROP ENGINEERING INC. WARDROP ENGINEERING DOES NOT UNDERTAKE TO GUARANTEE THE ACCURACY OF THE INFORMATION CONTAINED HEREIN. WARDROP ENGINEERING SHALL NOT BE RESPONSIBLE FOR ANY DAMAGE OR LIABILITY SUFFERED BY SUCH THIRD PARTY ARISING FROM USE OF THIS DOCUMENT IF THAT THIRD PARTY DOES NOT OBTAIN WRITTEN AUTHORITY OF WARDROP ENGINEERING AND OUR CLIENT. THIS DOCUMENT IS SUBJECT TO FURTHER RESTRICTIONS IMPOSED BY THE CONTRACT BETWEEN THE CLIENT AND WARDROP ENGINEERING INC AND THESE PARTY'S PERMISSION MUST BE OBTAINED REGARDING THIS DOCUMENT IN ALL OTHER CIRCUMSTANCES.</small>			
CLIENT			
CITY OF WINNIPEG TRANSIT DEPARTMENT			
WARDROP Engineering Inc.			
PROJECT NAME			
PETROLEUM STORAGE AND HANDLING SYSTEMS REPLACEMENT			
DRAWING DESCRIPTION			
OSBORNE STREET GARAGE MECHANICAL - DIESEL FUEL AND WASTE OIL FLOW SCHEMATICS			
DESIGNED BY:	DRAWN BY:	CHECKED BY:	
L.S.	D.D.		
APPROVED BY:			
SCALE:	AS NOTED	DATE:	07.01.16
DRAWING NO.	0729720100-DWG-M0003		REV. 0