


AS-BUILT BATTER PILE DATA - PIER SU3				AS-BUILT VERTICAL PILE DATA		
PILE NUMBER	DISTANCE OF BASE FROM ϕ FT.-IN.	LENGTH FT.-IN.	BATTER VERTICAL : HORIZONTAL	PILE NUMBER	DISTANCE OF PILE FROM ϕ FT.-IN.	LENGTH FT.-IN.
9	5'-11 1/4"	15'-10"	3.9 : 1	1	2'-10 1/2"	15'-6"
10	6'-3 3/4"	17'-4"	3.9 : 1	2	2'-10 1/2"	16'-10"
11	6'-8 1/2"	17'-3"	3.9 : 1	3	2'-8 1/2"	15'-11"
12	7'-7 1/2"	22'-7"	4.3 : 1	4	2'-8 1/2"	16'-10"
13	8'-1 1/2"	22'-9"	3.9 : 1	5	2'-9 1/2"	19'-4"
14	9'-7 1/2"	25'-11"	3.3 : 1	6	2'-9 1/2"	14'-8"
15	6'-8"	18'-2"	3.9 : 1	7	2'-9 1/2"	20'-7"
16	7'-8 1/2"	20'-3"	3.7 : 1	8	2'-10"	20'-4"

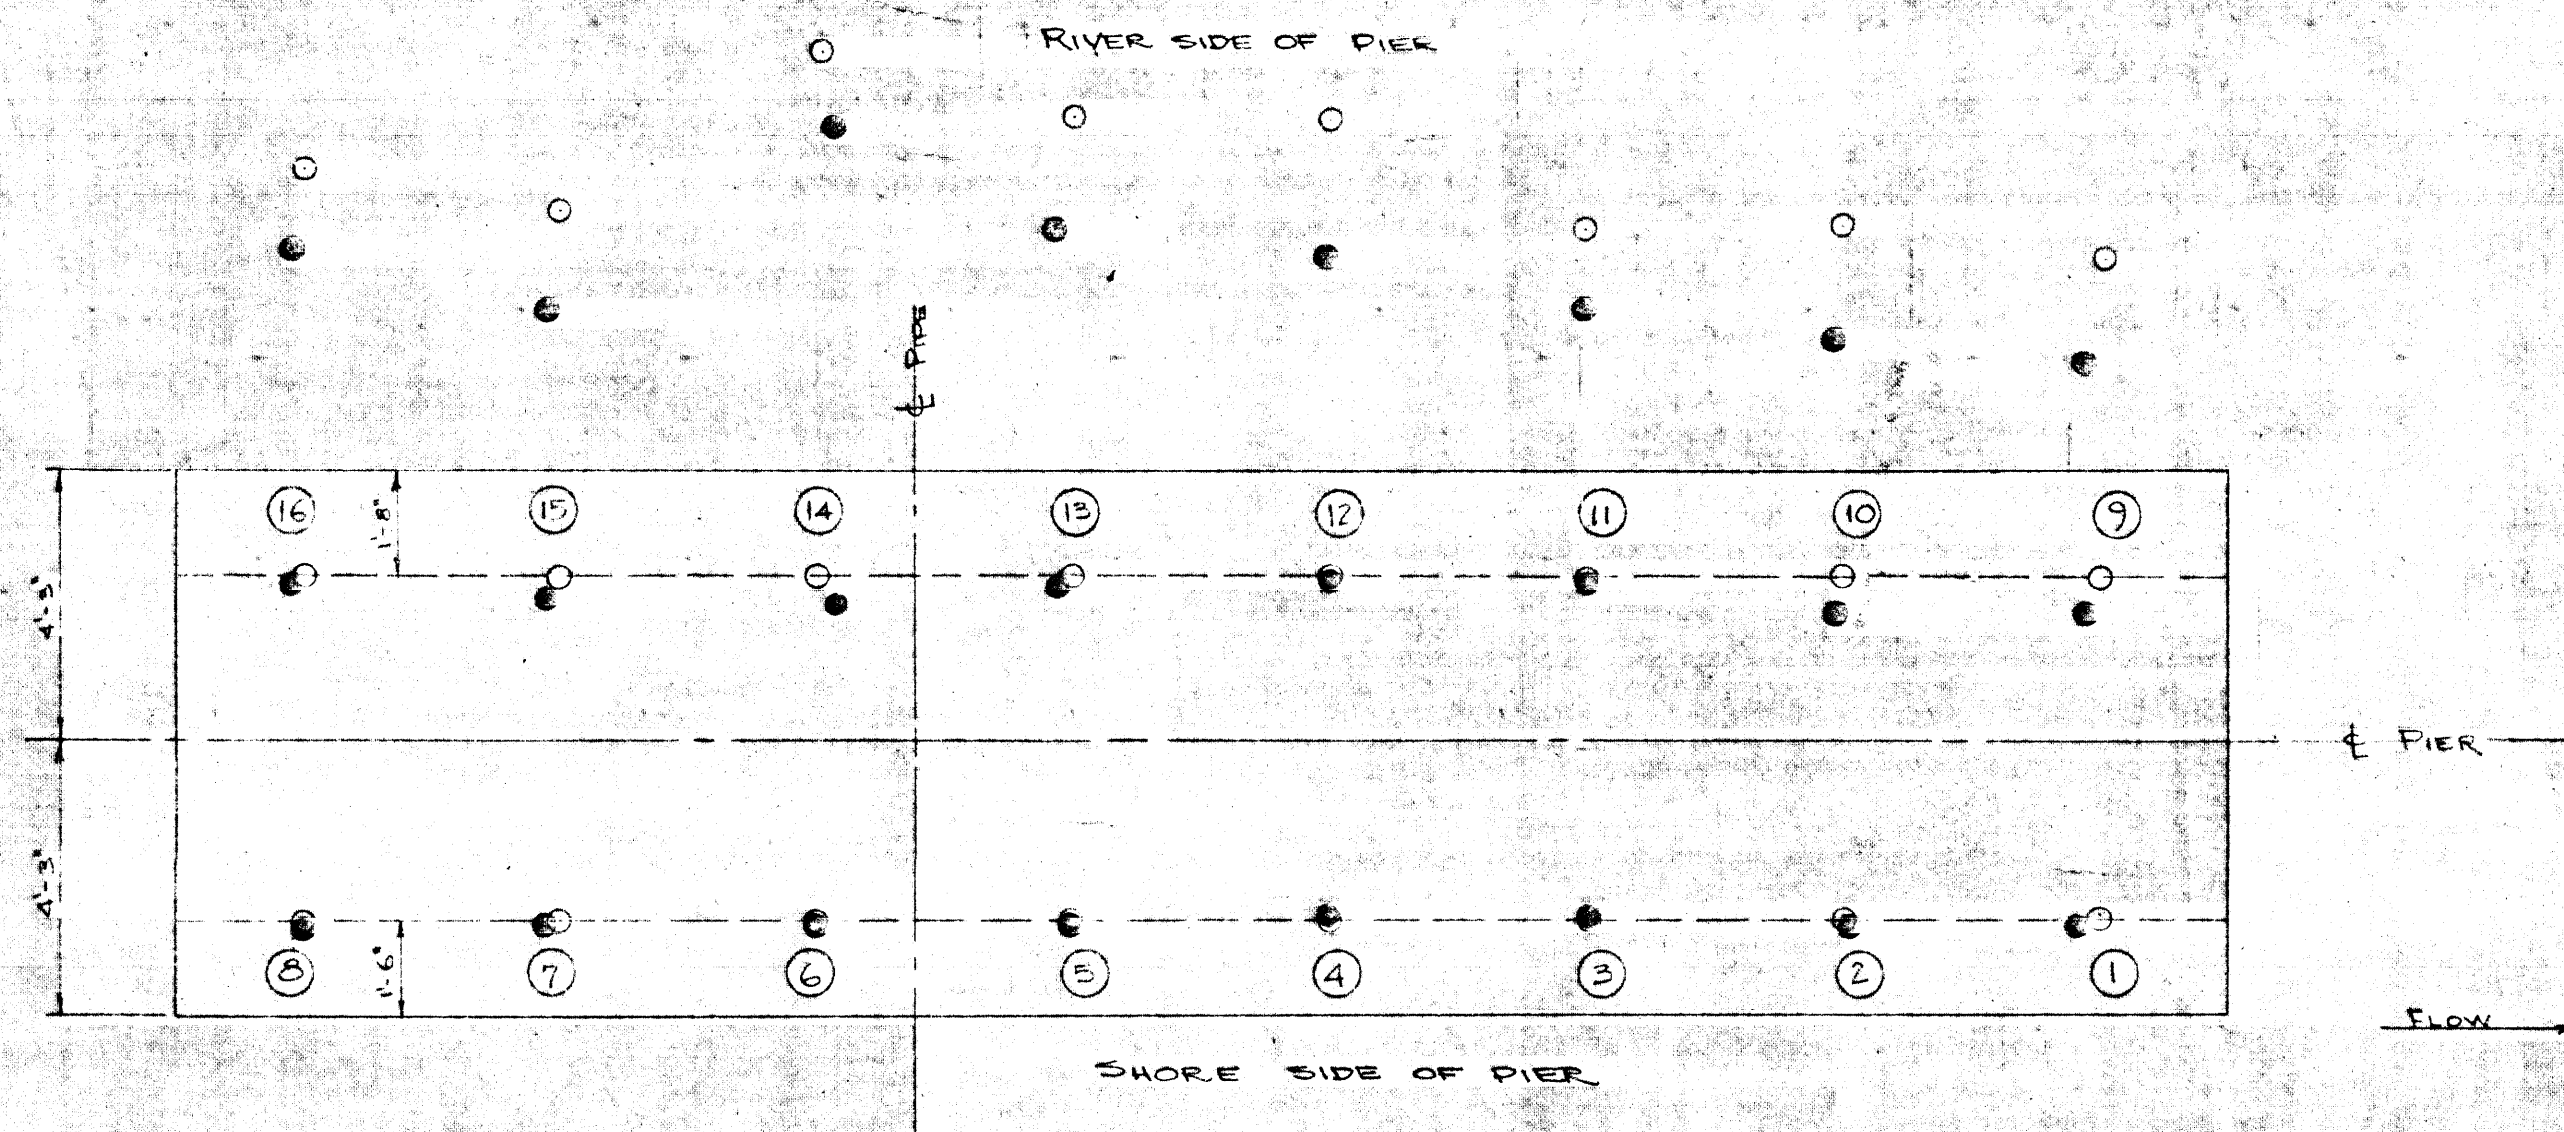

PLAN SHOWING LOCATION OF PILES - PIER SU3
SCALE: 1" = 3'

NOTE:

LOCATIONS AS PER PLAN ARE SHOWN THUS $\circ$
LOCATIONS AS DERIVED ARE SHOWN THUS $\bullet$
LOCATIONS SHOWN OUTSIDE PERIMETER OF
PIER REPRESENT BASE OF BATTERED PILES.

BC 4505-4
Microfilm 1965

CITY OF WINNIPEG
AUBREY STREET WATER CROSSING
AS-BUILT LOCATION OF PILES
AT PIER SU3

TEMPLETON ENGINEERING COMPANY

DESIGNED BY	SCALE: AS SHOWN	PLAN NO.
DRAWN BY: <i>REH</i>	DATE: AUGUST 15, 1957	W-21-38
APPROVED BY:		

File # FE70832