

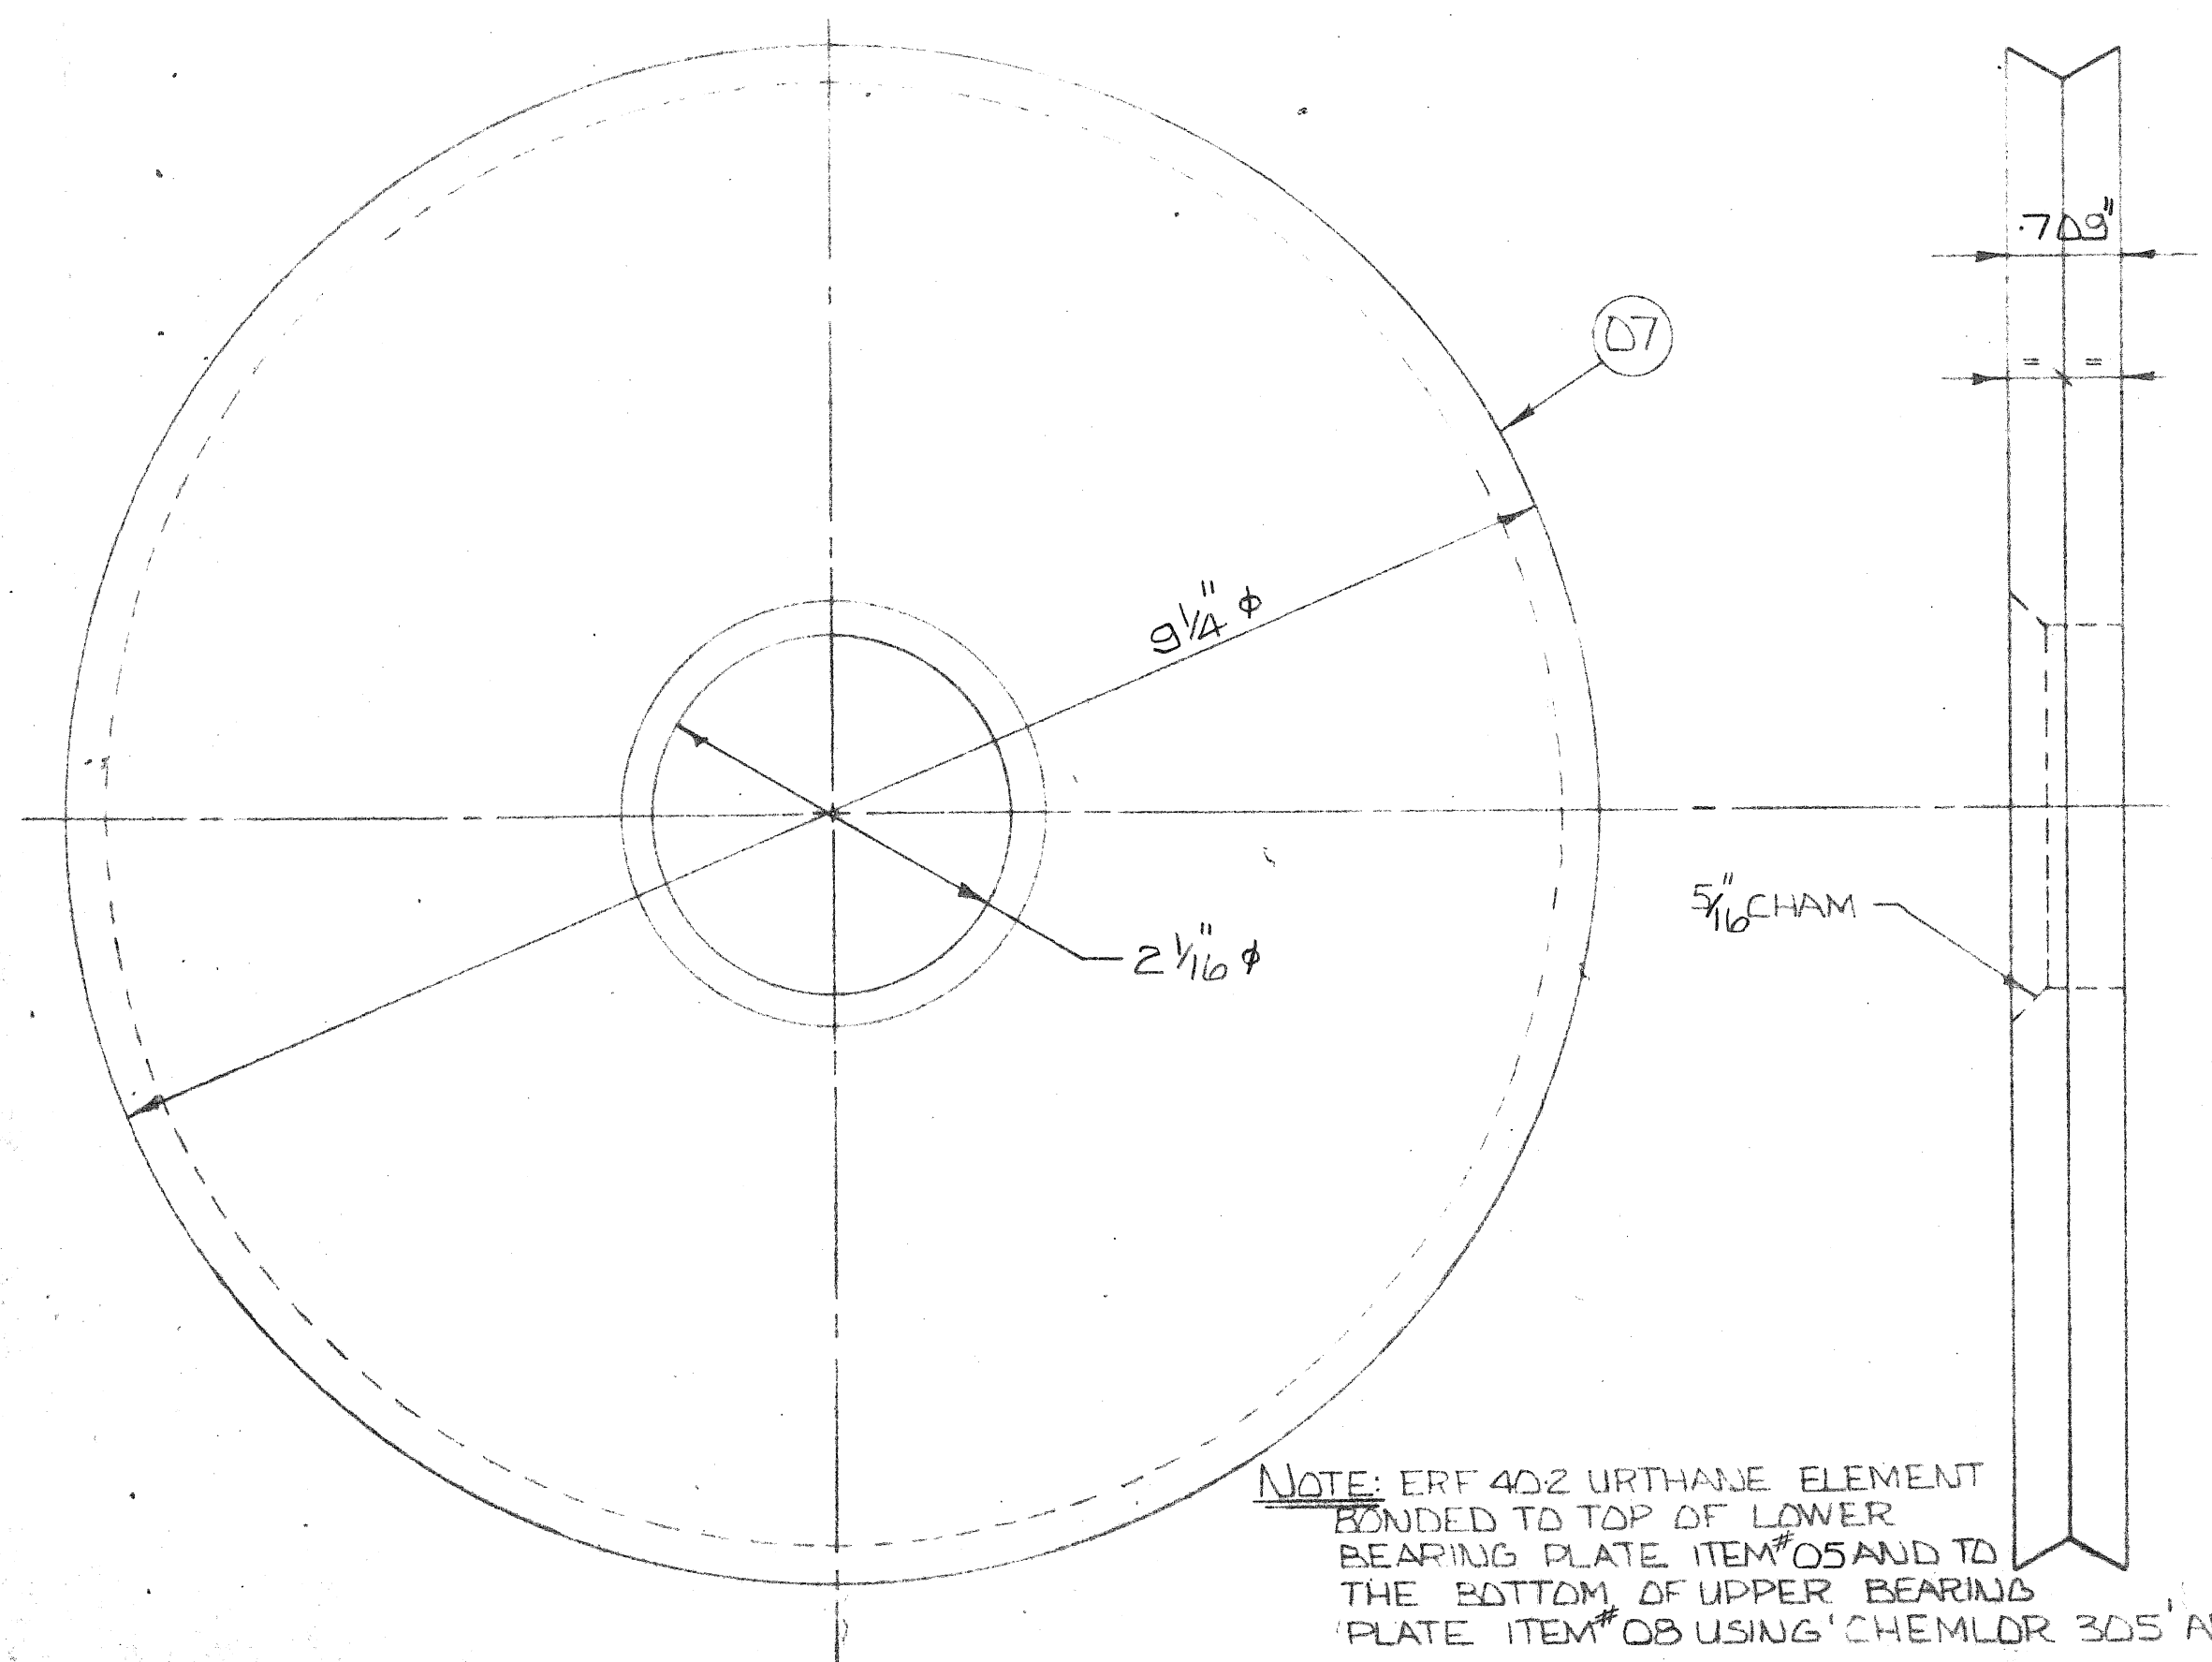
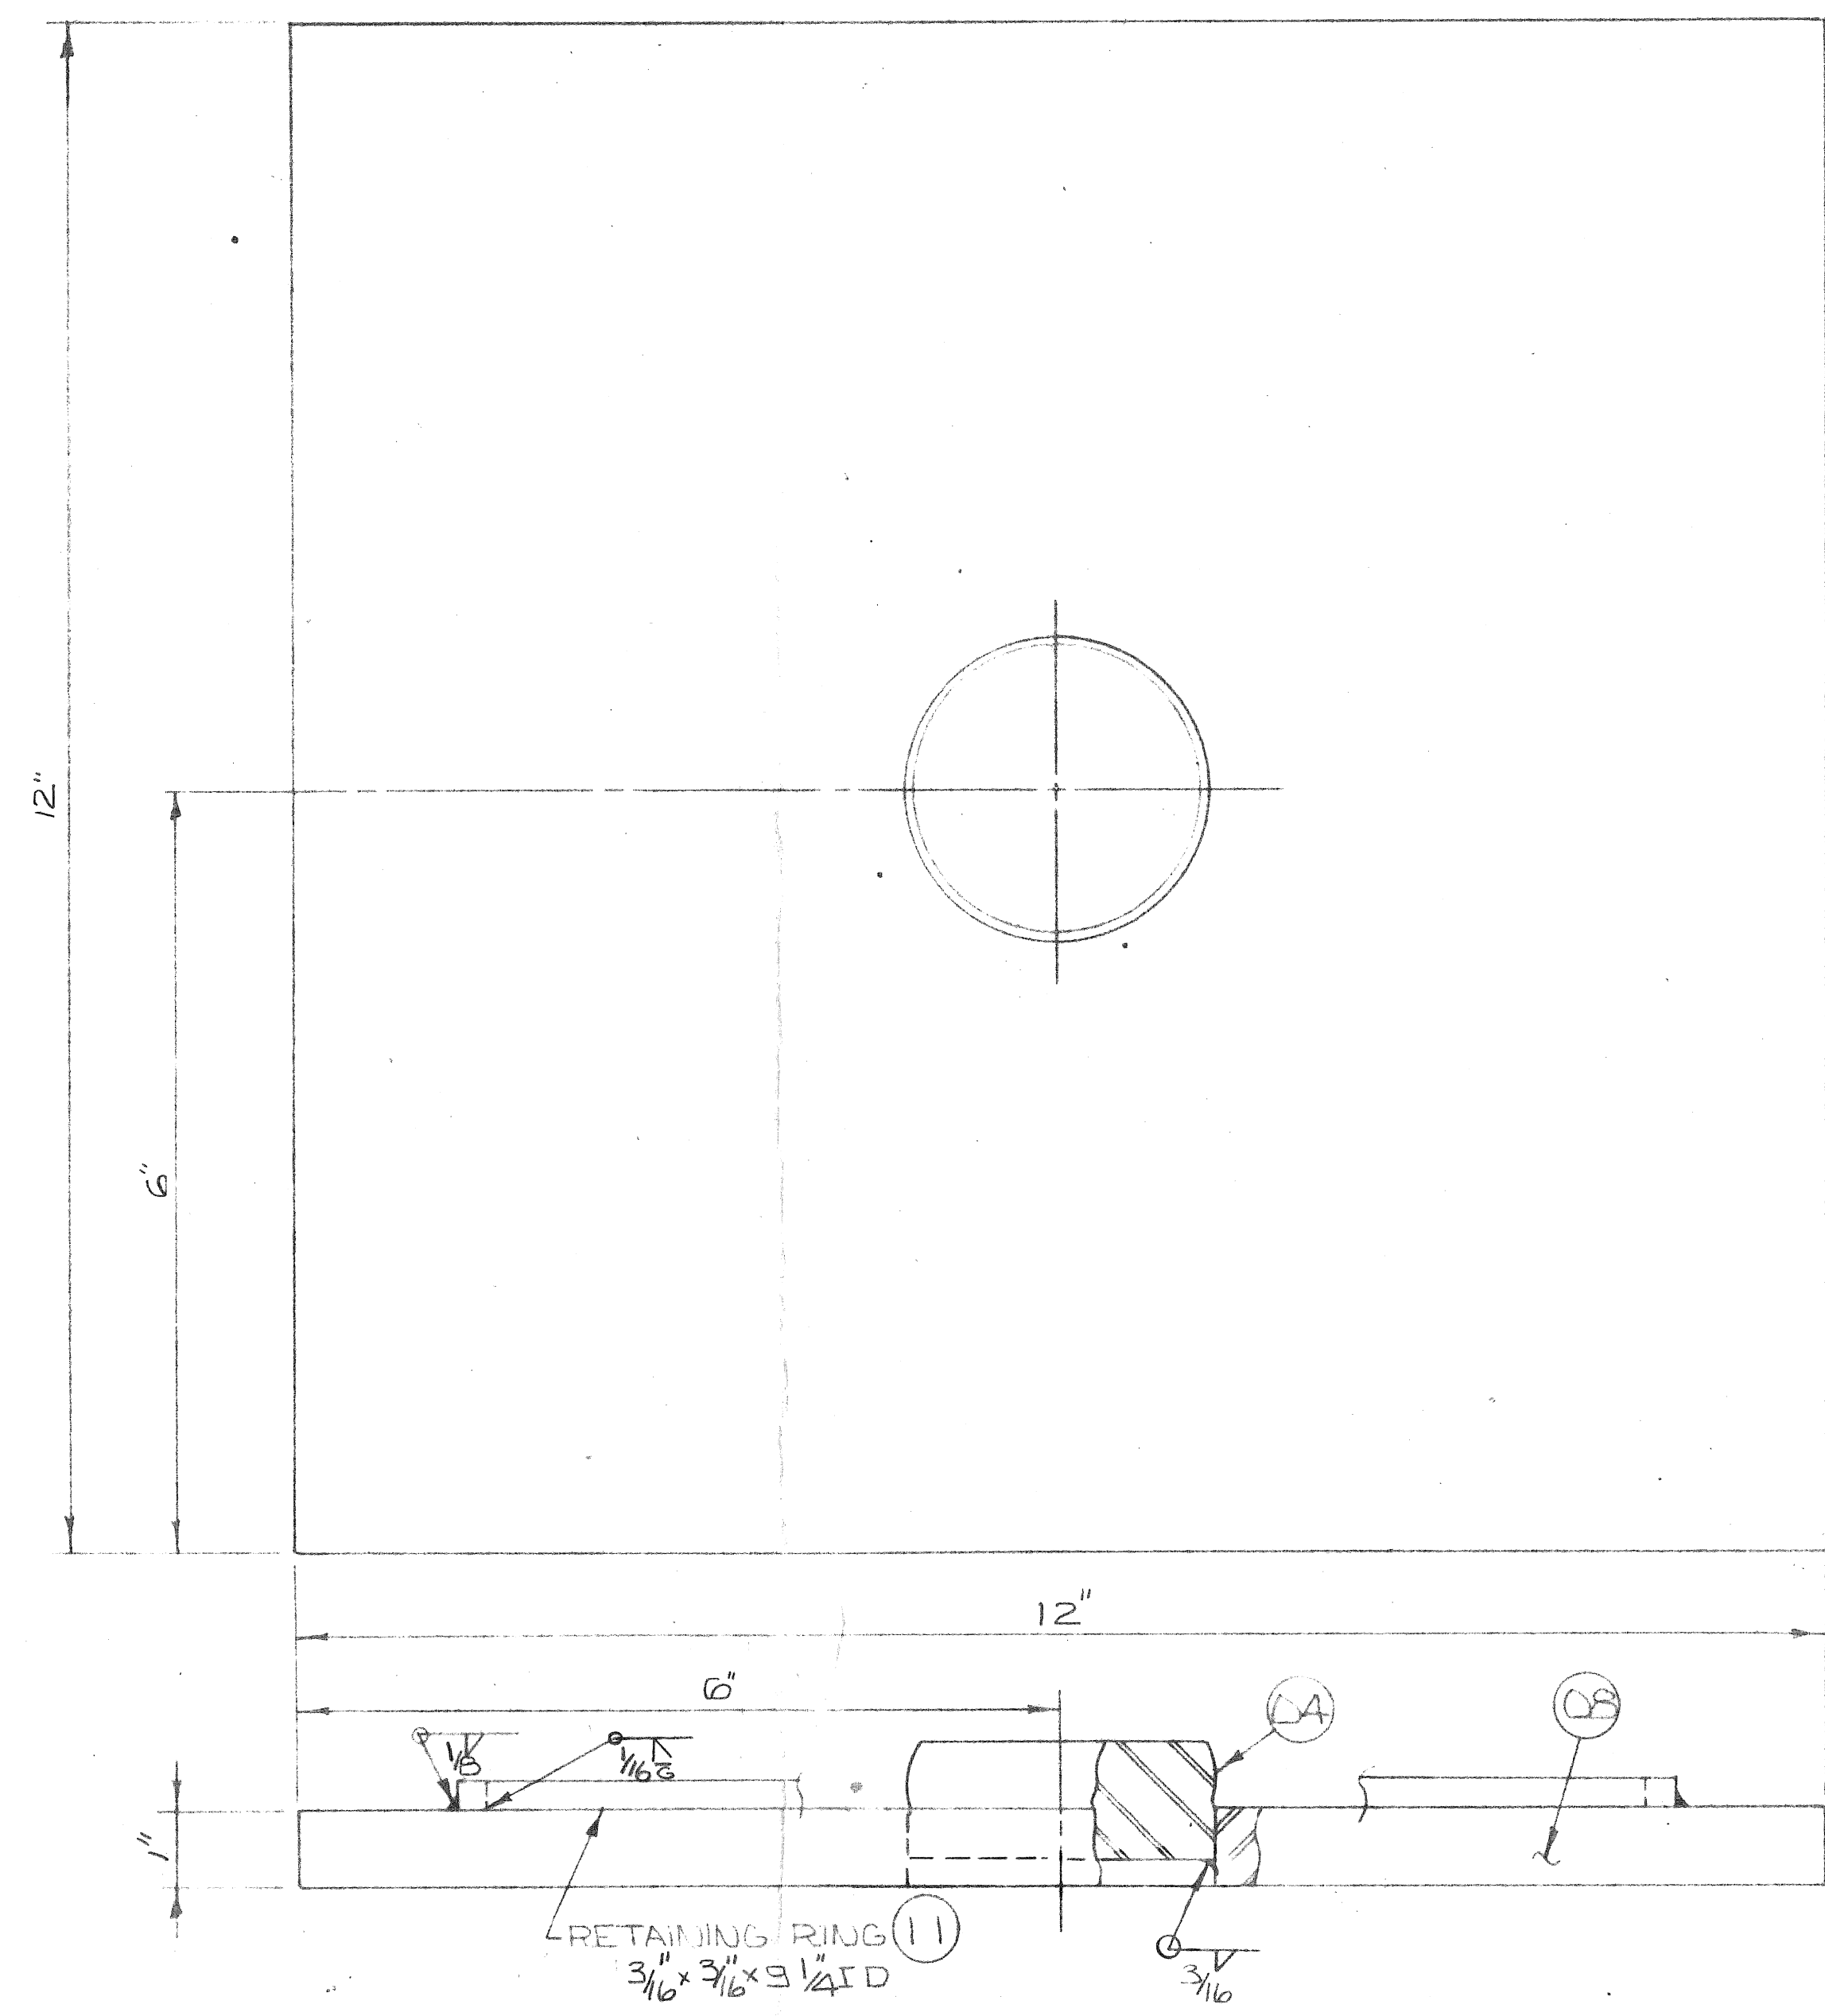


NO.	RECD	ITEM	DESCRIPTION
28.01			UPPER PLATE 3/4" x 17" x 17"
28.02			STAINLESS STEEL .0375" THK x 17" x 17"
28.03			SHEAR RESTRICTION RING 1 1/2" x 2"
28.04			SHEAR RESTRICTION PIN 1 3/8" x 1 1/2"
28.05			UPPER BEARING PLATE 1/2" x 11 1/2" x 11 1/2"
28.06			TEFLON DISC 1/16" THK x 9 1/4"
28.07			ERF 402 URTHANE ELEMENT 703" x 9 1/4"
28.08			LOWER BEARING PLATE 1/2" x 12" x 12"
112.09			3/16" x 6 LG ANCHOR STUDS (NELSON)
28.10			CONCRETE ANCHOR 1 1/2" x 6 LG
56.11			RETAINING RING 3/16" x 3/16" x 9 1/4" ID

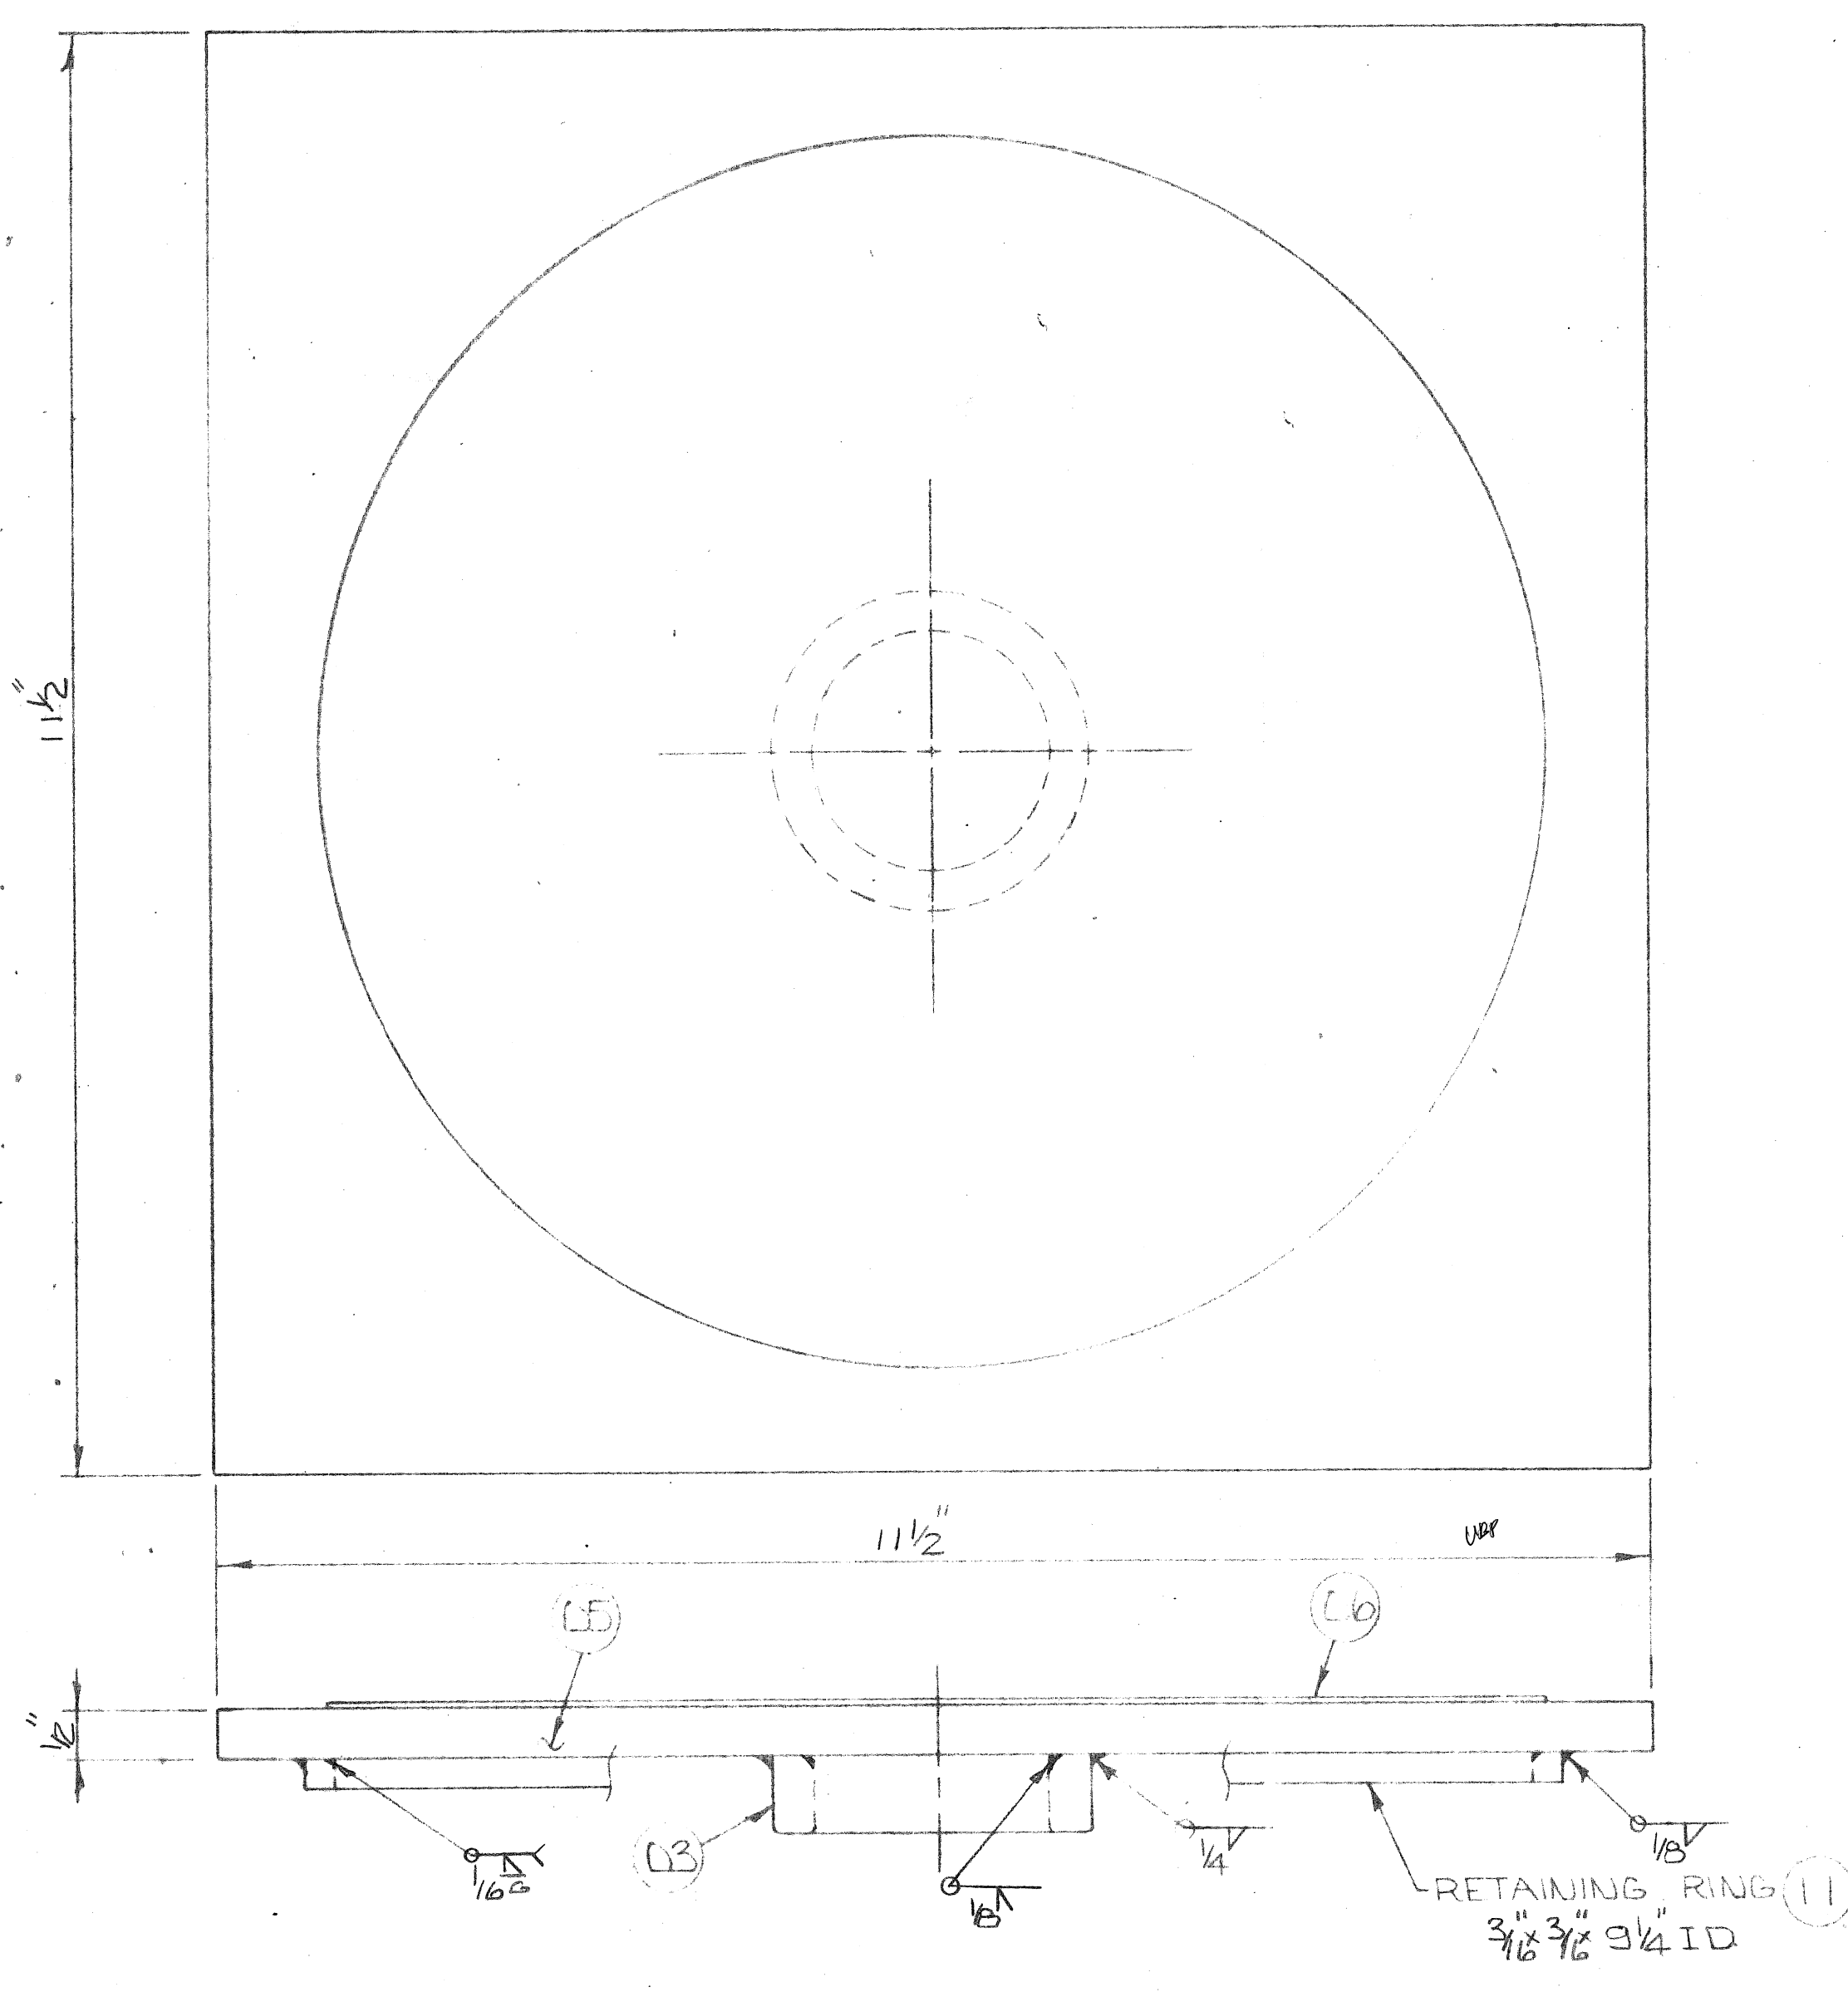

NOTE: ERF 402 URTHANE ELEMENT BONDED TO TOP OF LOWER BEARING PLATE ITEM #05 AND TO THE BOTTOM OF UPPER BEARING PLATE ITEM #08 USING CHEMLOR 305 ADHESIVE.

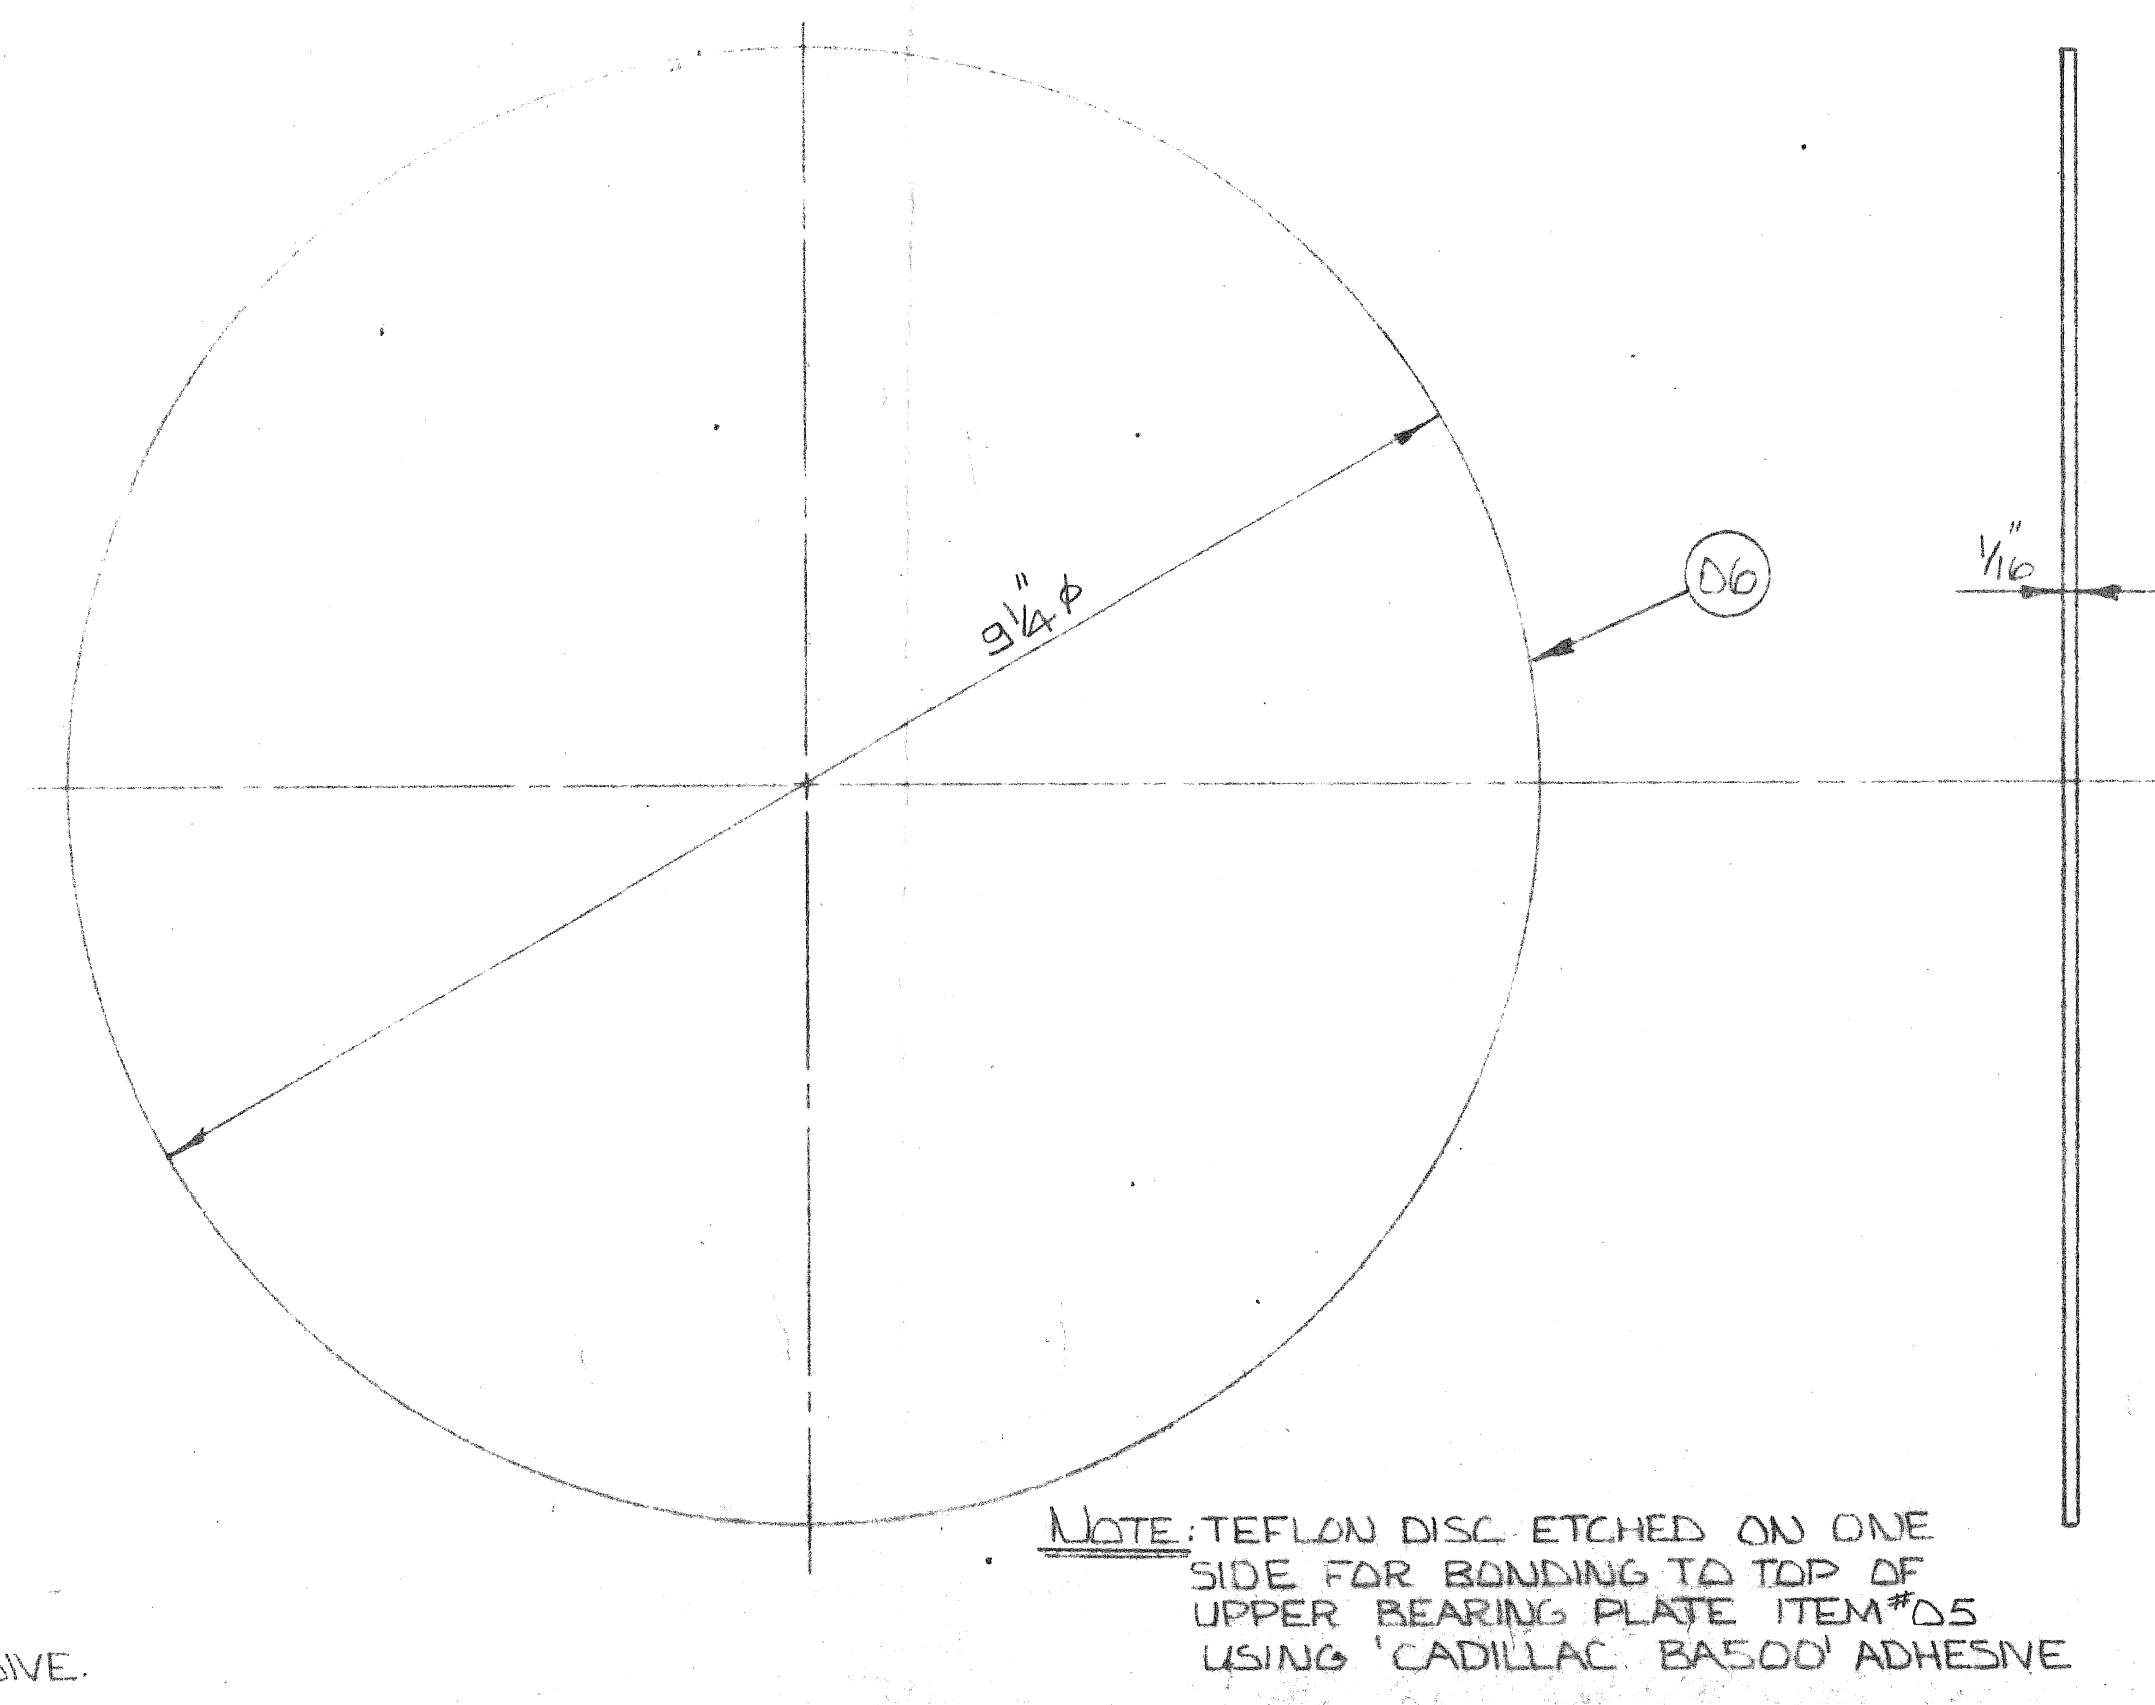

NOTE: TEFLON DISC ETCHED ON ONE SIDE FOR BONDING TO TOP OF UPPER BEARING PLATE ITEM #05 USING 'CADILLAC' BA500 ADHESIVE

REID, CROWTHER & PARTNERS LIMITED
REVIEWED ONLY
 MATERIAL MUST MEET REQUIREMENTS OF SPECIFICATIONS AND DRAWINGS. APPROVAL OF DIMENSIONS AND OTHER GENERAL CONSTRUCTION FEATURES NOT IMPLIED.
 CORRECTIONS ARE REQUIRED WHERE NOTED IN RED
 Project _____ Date JAN 28 1966
 Proj. No. 3477A Sig. _____

— NOTE —
 INFORMATION AND KNOWHOW ON THIS DRAWING IS THE PROPERTY OF ELASTOMETAL LIMITED USE OR REPRODUCTION IS PROHIBITED WITHOUT WRITTEN PERMISSION
 DWG. NO.: E-669
 PROJECT: OSBORNE ST. BRIDGE
ELASTOMETAL LIMITED
 DRAWN BY: EVAL TAYLOR PROJECT #62-71 DATE: JAN 20 1966
 CHECKED BY: SHEET 3 OF 3 SCALE: NTS
 WABD-FYFE MULTIDIRECTIONAL 75 TON BRG.