


FIELD

FDP-G (FIELD DEVICE PANEL - G)

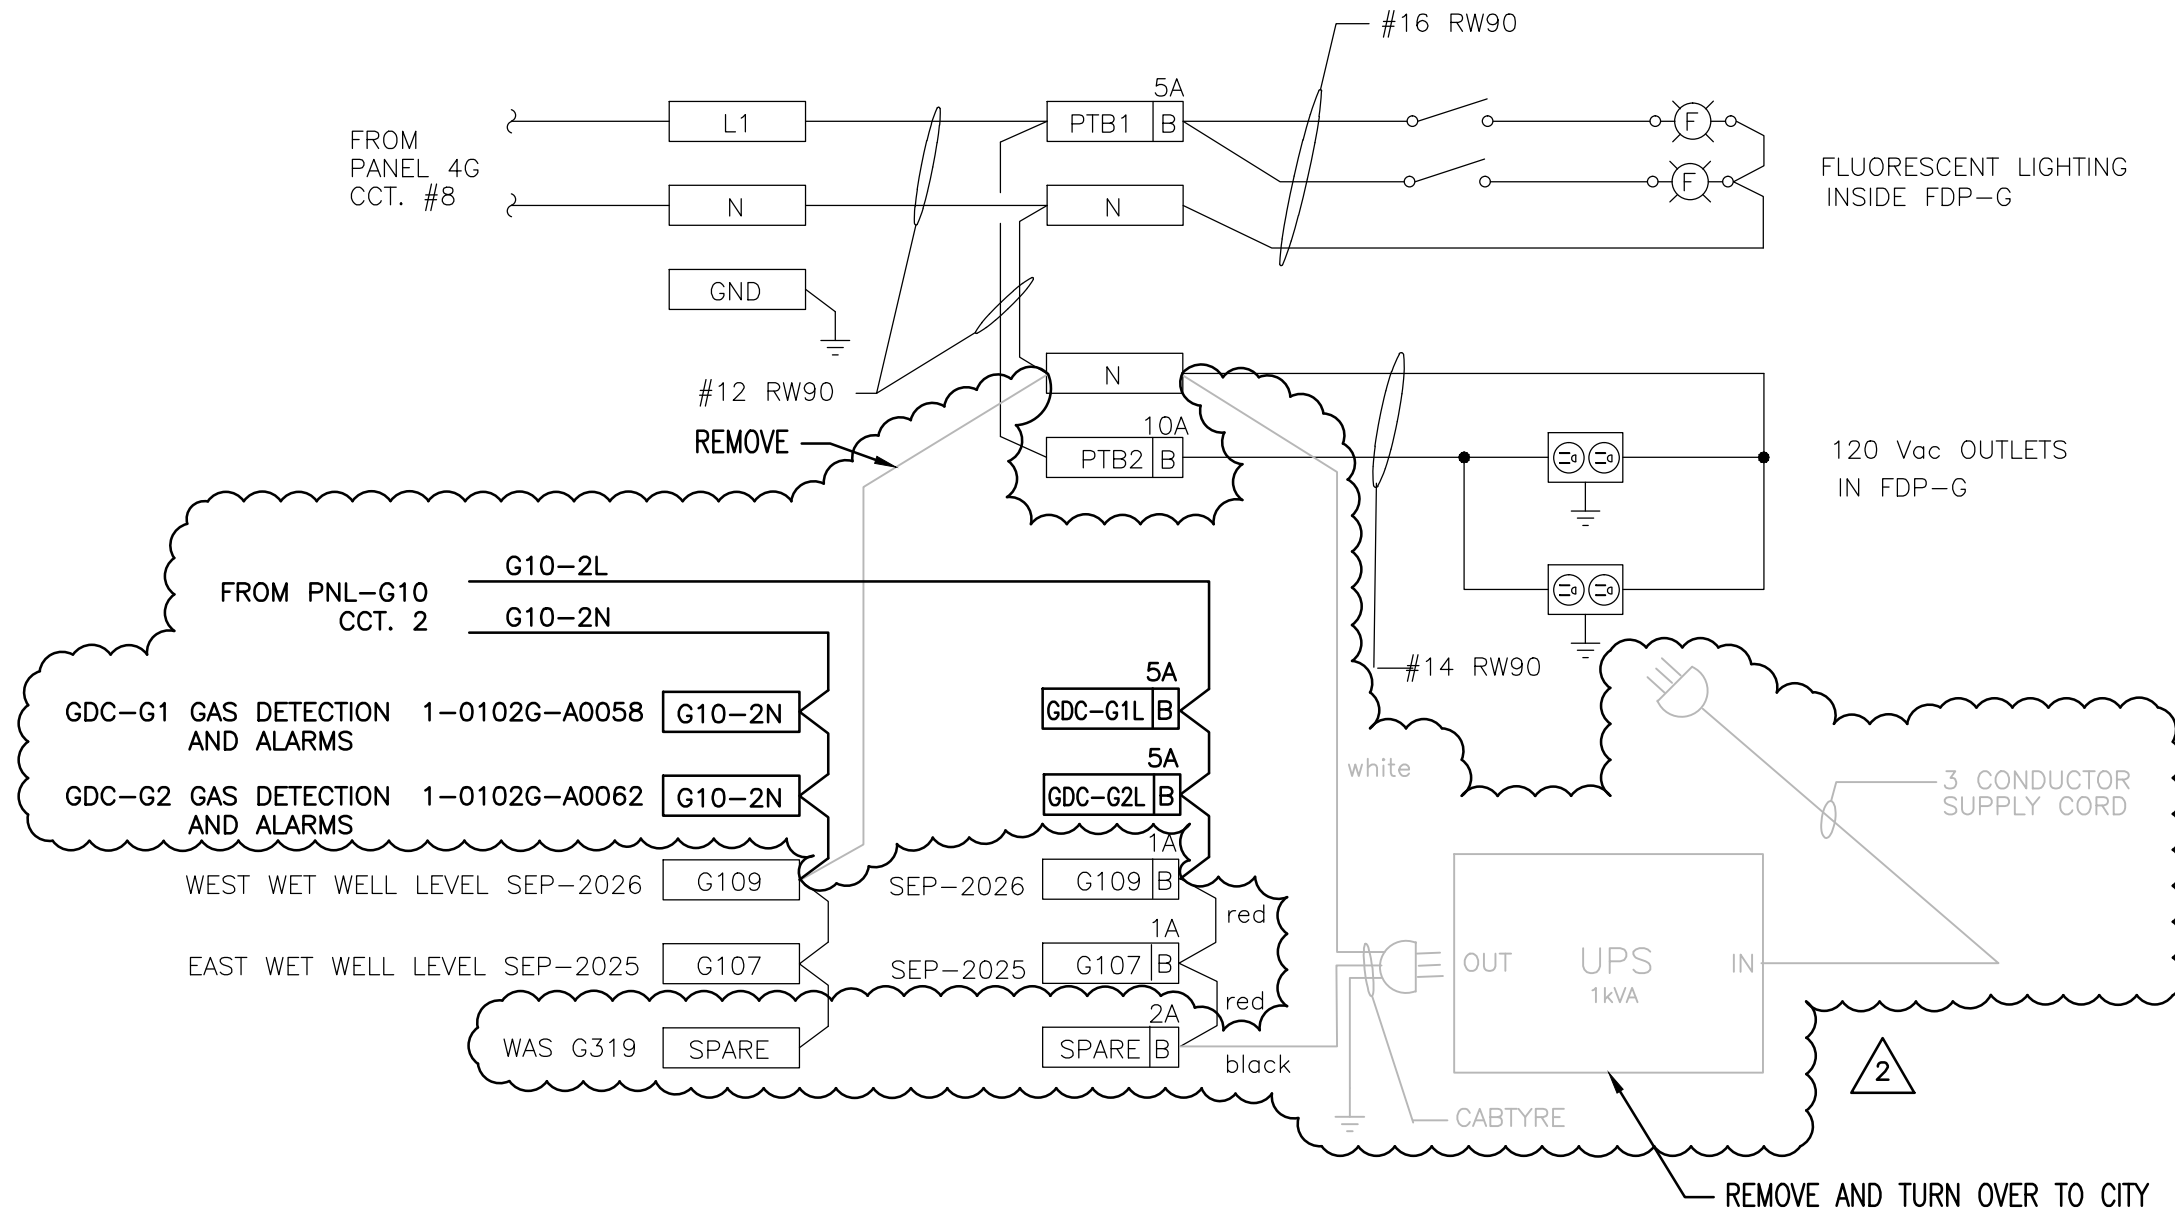

1
2
SNC-LAVALIN INC. 148 Nature Park Way Winnipeg, Manitoba Canada R3P 0X7				
DESIGNED: T. CHURCH	APPROVED: C. REIMER			
CHECKED: C. REIMER	DATE: 2011/03/11			
PROJECT No.	SUBDIV.	SUBJECT	SERIAL	REV.
112577	0106	47 DD	1202	2



MacLAREN ENGINEERS INC. WARDROP ENGINEERING INC. ENGINEERING CONSULTANTS			
2	REMOVED UPS	2011/03/11	TMC
1	ADD UPS UNIT AND LOADS	10.01.28	SPH
0	AS CONSTRUCTED	12/93	B.T.
-		10.01.28	B.T.
NO	REVISIONS	DATE	BY
		DATE: 09/92	

ORIGINAL DRAWING
SEALED BY:
T. M. CHURCH
SNC-LAVALIN
2011/03/25
REV. 02
CHANGES ONLY

DESIGNED BY: RH
DRAWN BY: RH
SCALE: N.T.S.

CONSULTANT DWG. NO.
870012-01-20

THE CITY OF WINNIPEG WORKS AND OPERATIONS DIVISION WATERWORKS, WASTE & DISPOSAL DEPARTMENT	
SOUTH END WATER POLLUTION CONTROL CENTER PUMP & SCREEN BUILDING - I & C FIELD DEVICE PANEL FDP-G POWER DISTRIBUTION	CITY DWG. NO. SHEET 1 OF 1 SEP-2130