


REF. OF DRAWING No. N.E.P.-252

DETAILS

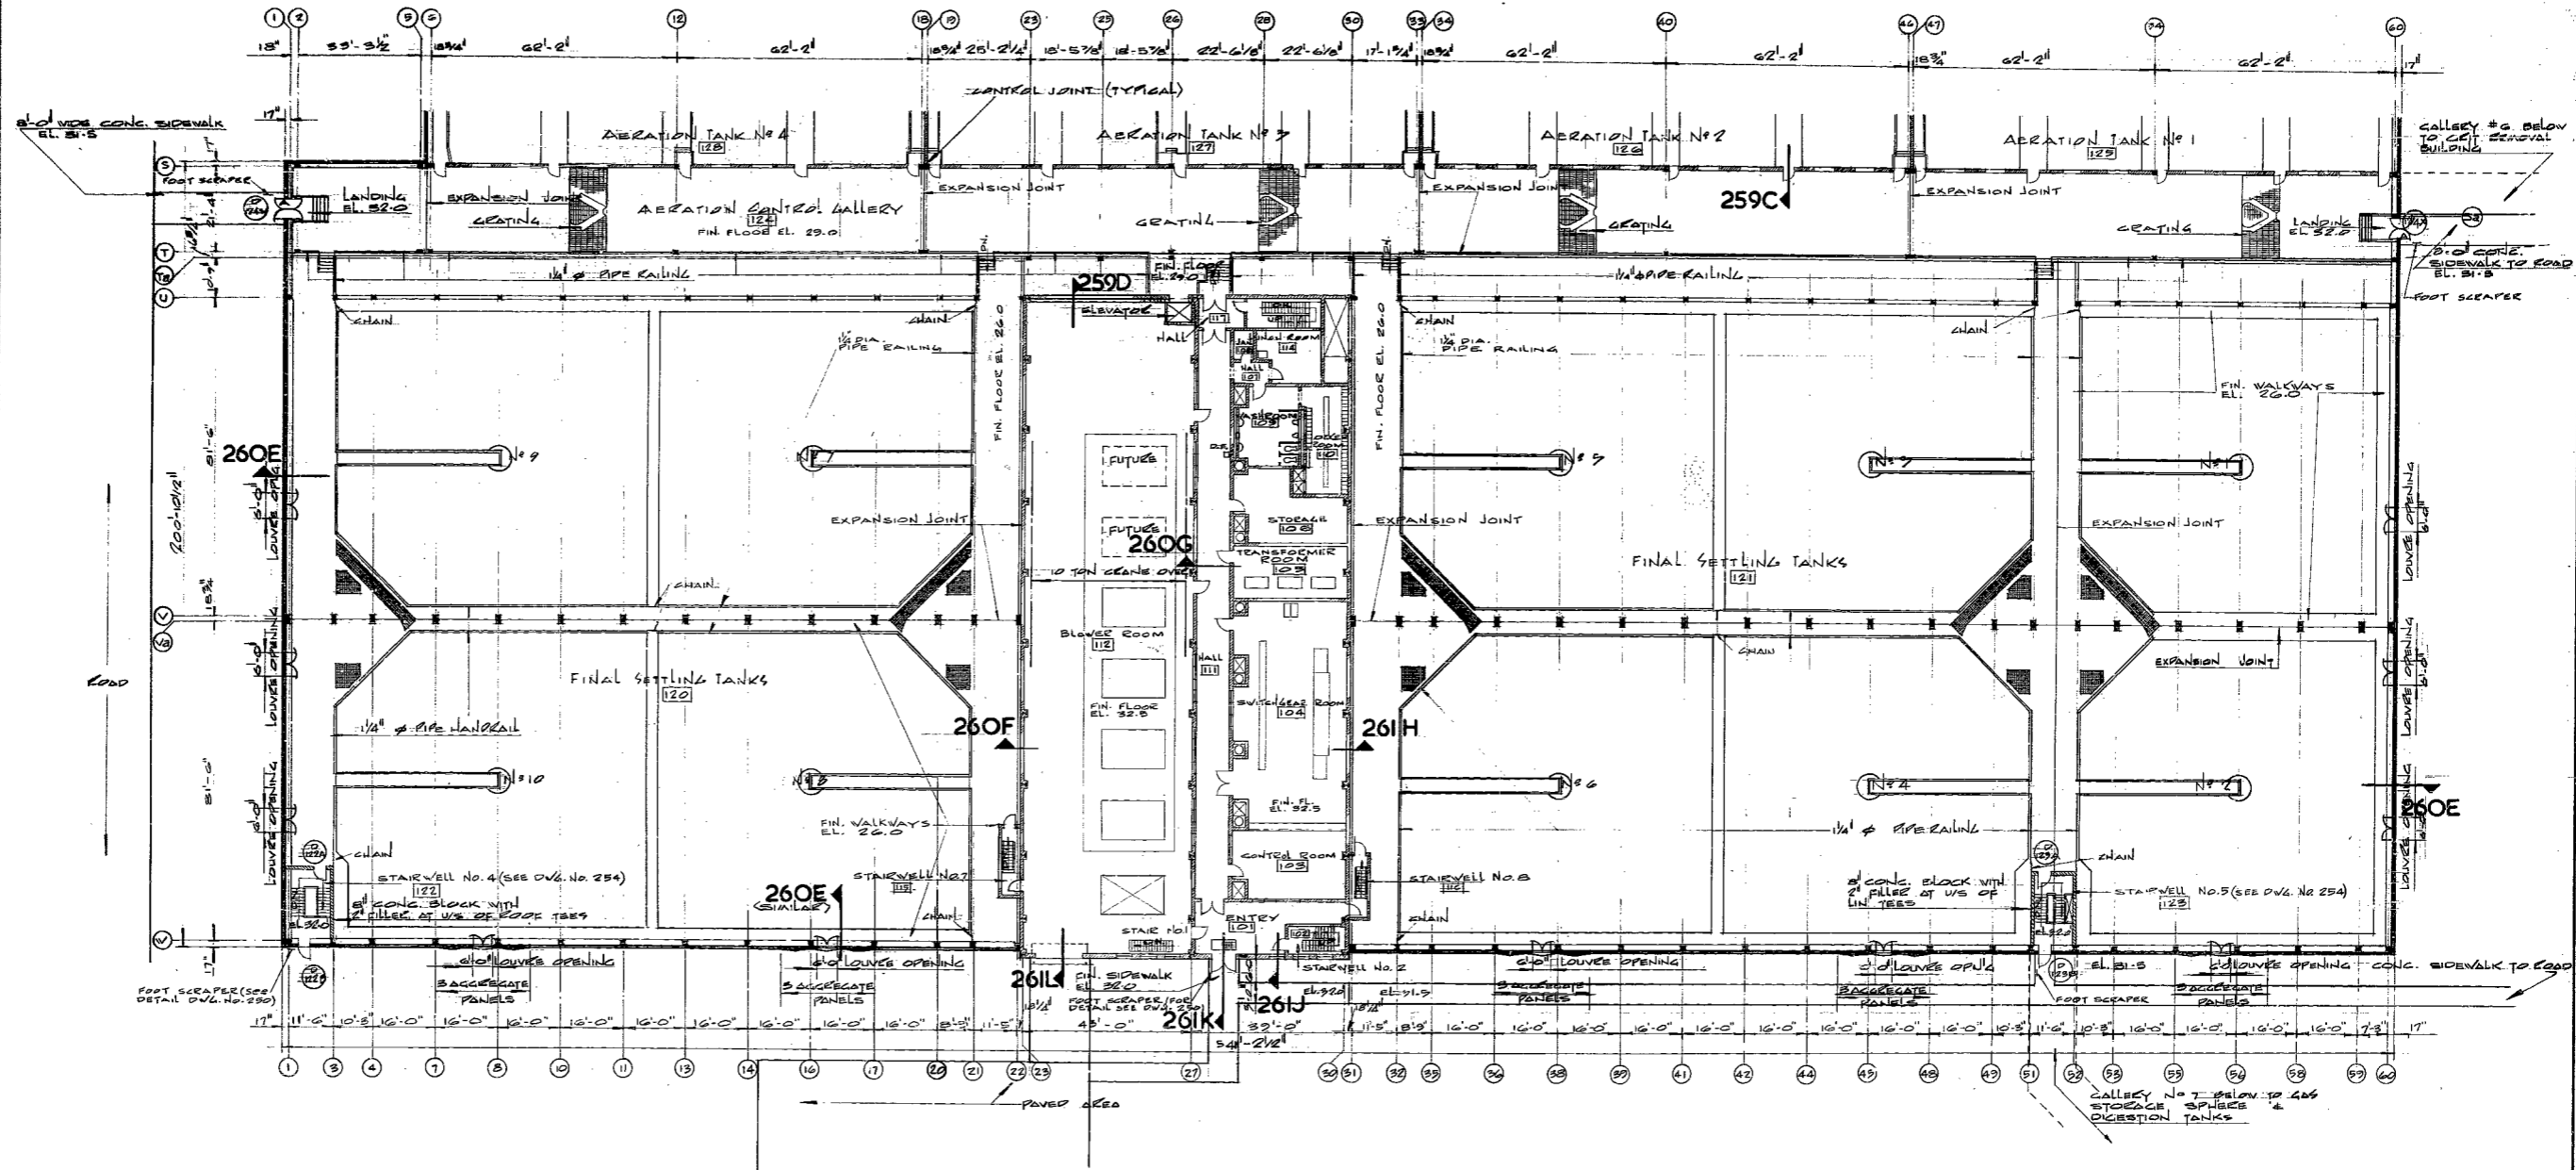

SOUTHERN PART PLAN ABOVE EL 32.5

SCALE: 1/4" = 1'-0"

REVISIONS		
No.	DATE	DETAIL



THE METROPOLITAN CORPORATION OF GREATER WINNIPEG  
WATERWORKS AND WASTE DISPOSAL DIVISION

**NORTH END SEWAGE TREATMENT PLANT  
CONTRACT B - SUPERSTRUCTURE  
FINAL SETTLING TANKS AND  
BLOWER BUILDING PLAN**

APPROVED  
*J. MacLaren*  
JAMES F. MACLAREN LIMITED  
ENGINEERS  
TORONTO

ENGINEER OF DESIGN  
*A. Pannan*  
W.L. WARDROP ASSOCIATES  
(MANAGEMENT) LIMITED  
ENGINEERING CONSULTANTS  
WINNIPEG  
DIRECTOR & CHIEF ENGINEER

DATE: AUGUST 15, 1963  
SCALE: AS SHOWN  
DWG. No. 252 OF 315  
**NEP-252**

AUG 11 1966  
FOR ACTUAL ELEV.  
SUBTRACT 0.37 FT.  
**AS BUILT**