

PLAN ABOVE EL. 10.45
20'-1'-0"


PLAN ABOVE EL. 26.0 & 29.0
20'-1'-0"

PLAN ABOVE EL. 10.45
20'-1'-0"


PLAN ABOVE EL. 10.45 & 18.0
20'-1'-0"

NOTE - ALL CABLE TRAY IN THE FINAL SETTLING TANK AREA TO BE ALUMINUM
- ALL CONDUIT TO BE ALUMINUM OR PVC JACKETED
- ALL EQUIPMENT TO BE WEATHERPROOF

NOTE - CONDUIT RUNS, SIZE, AND NUMBER ARE SCHEMATIC ONLY. IN CONSTRUCTION, POWER FEEDERS WERE GROUPED IN ORDER TO DECREASE THE NUMBER OF CONDUIT RUNS. CONDUIT, CONDUIT AND WIRING WAS INSTALLED TO SUIT SITE CONDITIONS.

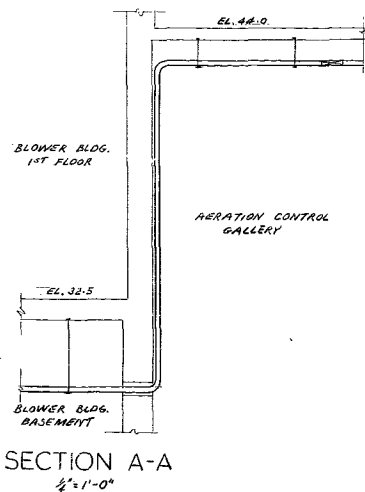

SECTION A-A
2'-1'-0"

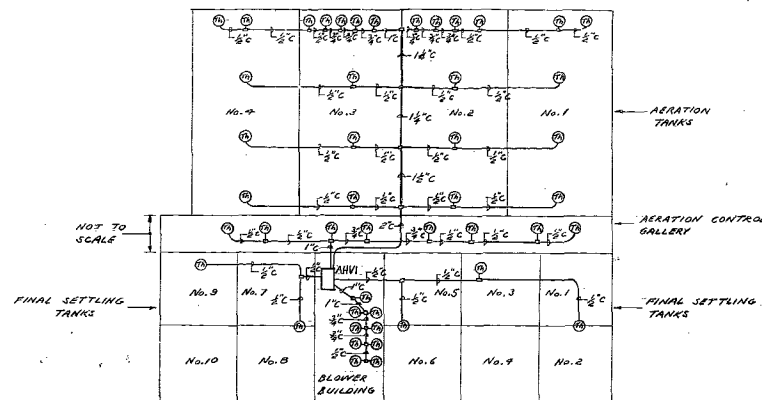

THERMOCOUPLE LOCATIONS
1" = 100'-0"

NOTE - ALL CONDUIT IN AERATION & FINAL SETTLING TANK AREAS TO BE ALUMINUM OR PVC JACKETED
- ALL EQUIPMENT TO BE WEATHERPROOF

REVISIONS		
NO.	DATE	DETAIL



THE METROPOLITAN CORPORATION OF GREATER WINNIPEG
WATERWORKS AND WASTE DISPOSAL DIVISION

NORTH END SEWAGE TREATMENT PLANT

CONTRACT B - ELECTRICAL
FINAL SETTLING TANKS - POWER

APPROVED
James F. MacLaren Limited
ENGINEERS TORONTO

APPROVED
W.L. Wardrop Associates
(MANAGEMENT) LIMITED
ENGINEERING CONSULTANTS WINNIPEG
DIRECTOR & CHIEF ENGINEER

DATE: AUGUST 15, 1963
SCALE: AS SHOWN
DWG. No. 299 OF 315

NEP-299

AUG 1963
AS BUILT
FOR ACTUAL ELEV.
SUBTRACT 0.37 FT.