



PLAN BELOW ELEV. 30.0


PLAN BELOW ELEV. 12.0

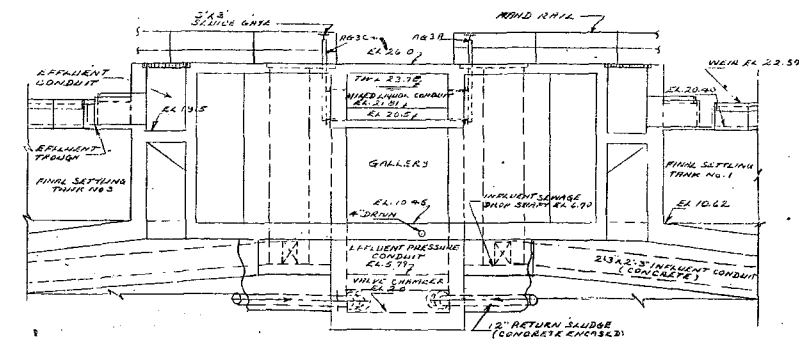

SECTION D

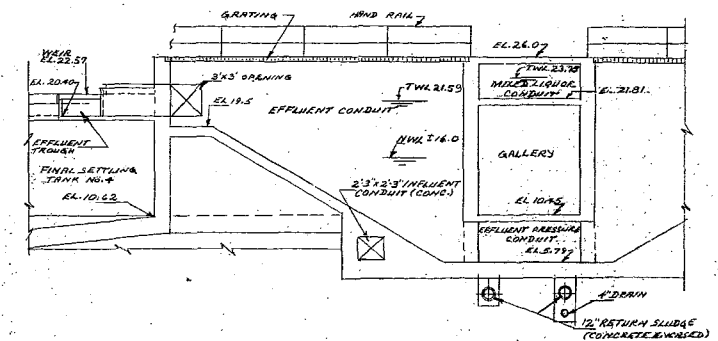

SECTION E


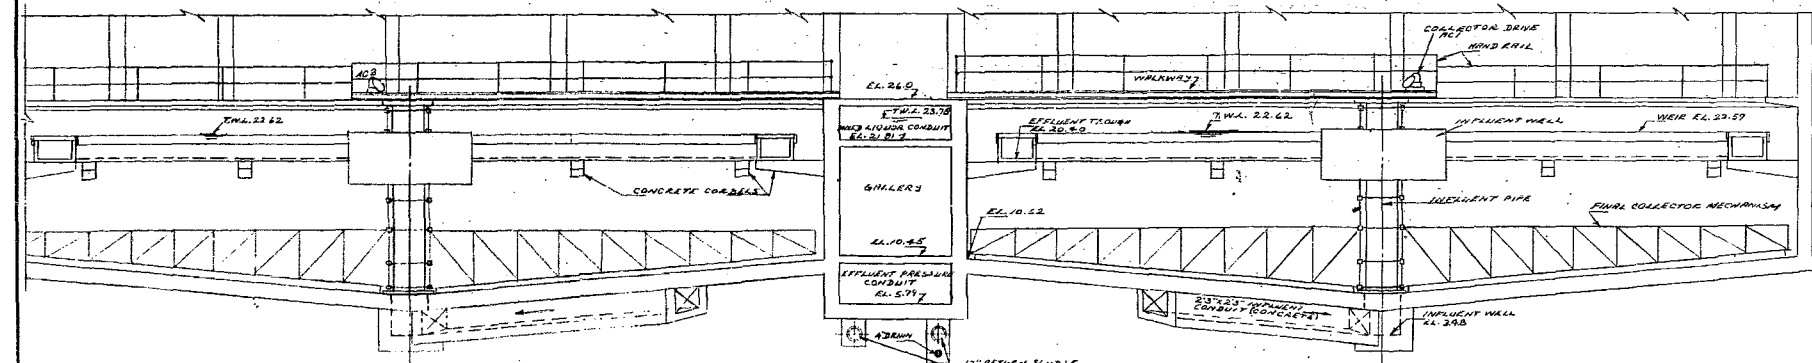


SECTION A

FOR ACTUAL ELEV. SUBTRACT 0.37 FT.

AUG 1966 AS BUILT

REVISIONS	
No.	DATE

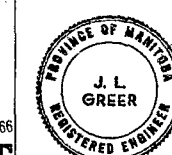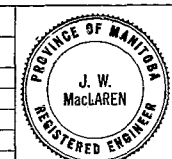

REFER TO CONTRACT DWG. 273

THE METROPOLITAN CORPORATION OF GREATER WINNIPEG  
WATERWORKS AND WASTE DISPOSAL DIVISION

NORTH END SEWAGE TREATMENT PLANT  
CONTRACT 'F'-SLUDGE COLLECTOR MECHANISMS

PLAN AND SECTIONS SHEET II

APPROVED  
James F. MacLaren  
ENGINEER OF DESIGN  
James F. MacLaren Limited  
ENGINEERS  
TORONTO  
W.L. WARDROP ASSOCIATES  
(MANAGEMENT) LIMITED  
ENGINEERING CONSULTANTS WINNIPEG  
APPROVED  
Wm. B. Side  
ENGINEER OF DESIGN  
J. P. Pannan  
ENGINEER OF WASTE DISPOSAL  
W.L. Wardrop  
DIRECTOR SENIOR ENGINEER

DATE: JULY 19, 1963  
SCALE: 1/8" = 1'-0"  
DWG. No. 2 OF 2  
NEP-330