


PLAN VIEW
SCALE: 1:25
DETAILS OF PIPING IN MONTCALM PUMPING STATION

NOTE: FOR DETAILS OF EXISTING PIPING IN THE MONTCALM PUMPING STATION SEE INFORMATION DRAWINGS - 1081, 282, 281, 229A

FOR CONTINUATION OF FORCEMAIN SEE DRWG 05356

PROJECT COMPLETION
DATE 2004.05.10

METRIC
WHOLE NUMBERS INDICATE MILLIMETRES
DECIMALIZED NUMBERS INDICATE METRES

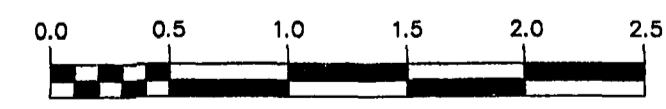

AS-CONSTRUCTED
WATER AND WASTE DEPARTMENT

B.M. ELEV.	FIELD BOOK #
POSTED TO LBIS	
2.) REVISED TO AS-CONSTRUCTED	04.10.01 WKT/C.H
1.) CHANGED SOUTH PIPE ALIGNMENT	04.01.23 WKT
NO. REVISIONS	DATE BY

**CITY OF WINNIPEG
WATER AND WASTE
ENGINEERING DIVISION**

DESIGNED BY	JE	CHECKED BY	JE
DRAWN BY	WKT	APPROVED BY	KZ
HOR. SCALE	1:25	RELEASED FOR CONSTRUCTION	
VERTICAL			
DATE	2004.01.15	DATE	

ENGINEER'S SEAL

TENDER No. 16-2004
FILENAME: 05358.dwg
PLOT DATE: 2004 10 01

**THE CITY OF WINNIPEG
WATER AND WASTE DEPARTMENT**

Winnipeg

MONTCALM SEWAGE PUMPING STATION

FORCEMAIN REPLACEMENT

SHEET 3 OF 4
CITY DRAWING NUMBER
05358