

NOTE: DASHED LINES ON THIS AND OTHER PAGES INDICATES WIRING SUPPLIED BY THE CUSTOMER


633 TYNE AVENUE
WINNIPEG, MB R2L 1J5
http://www.kingsmb.ca

KING'S ELECTRIC MOTORS LTD.
PHONE: (204) 663-5332
FAX: (204) 663-4059

REVISIONS:	DATE:	DESIGN:	DATE:
M300PP REPLACEMENT REV.	11/07/0m	BERNIE DA SILVA	00/11/10
REVISION #1	00/12/13	BERNIE DA SILVA	00/11/10
AS BUILT	01/01/29	BERNIE DA SILVA	00/11/10
AS COMMISSIONED	01/03/20	DON WILSON	00/11/22

TITLE: 400HP VFD/RVMS STARTER CONNECTIONS
PROJECT: PERIMETER PUMP STATION
CUSTOMER: City of Winnipeg / P.D.

DWG. NO: 00-4383 (page 5 of 11)
SCALE: N.T.S.

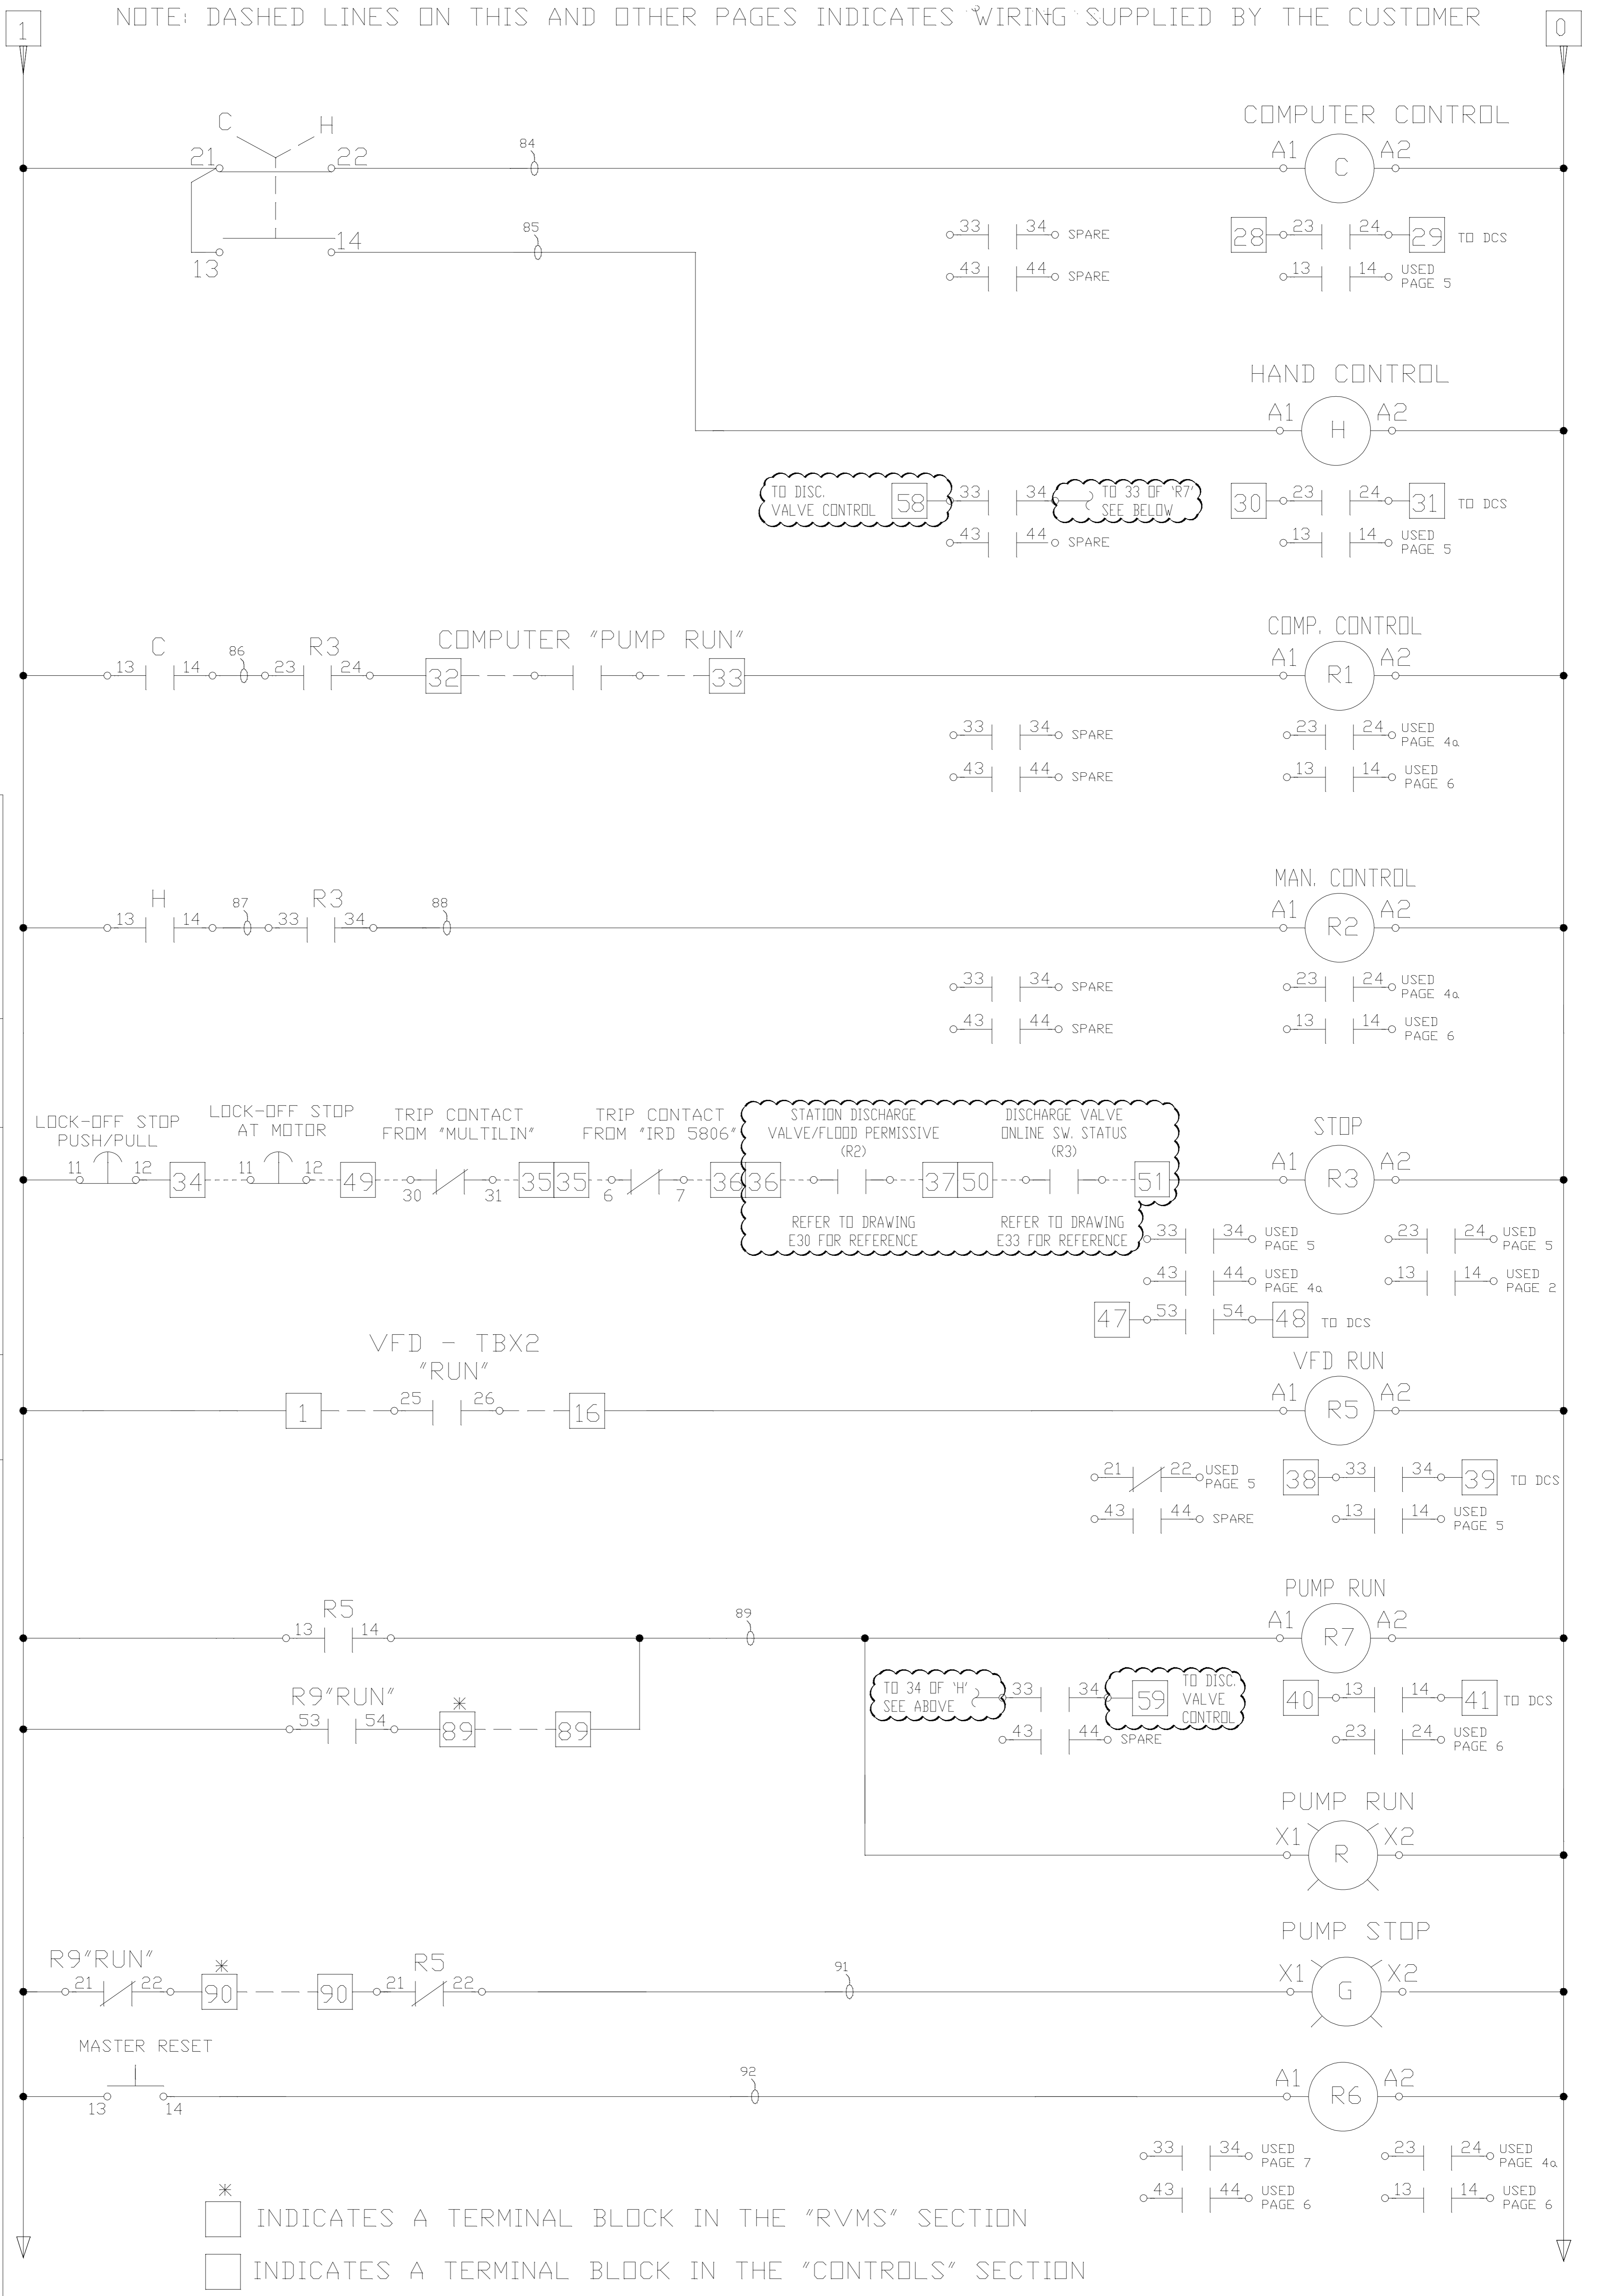

* INDICATES A TERMINAL BLOCK IN THE "RVMS" SECTION
□ INDICATES A TERMINAL BLOCK IN THE "CONTROLS" SECTION