


CONNECTION BETWEEN WEST SHAFT & WEST VALVE PIT.

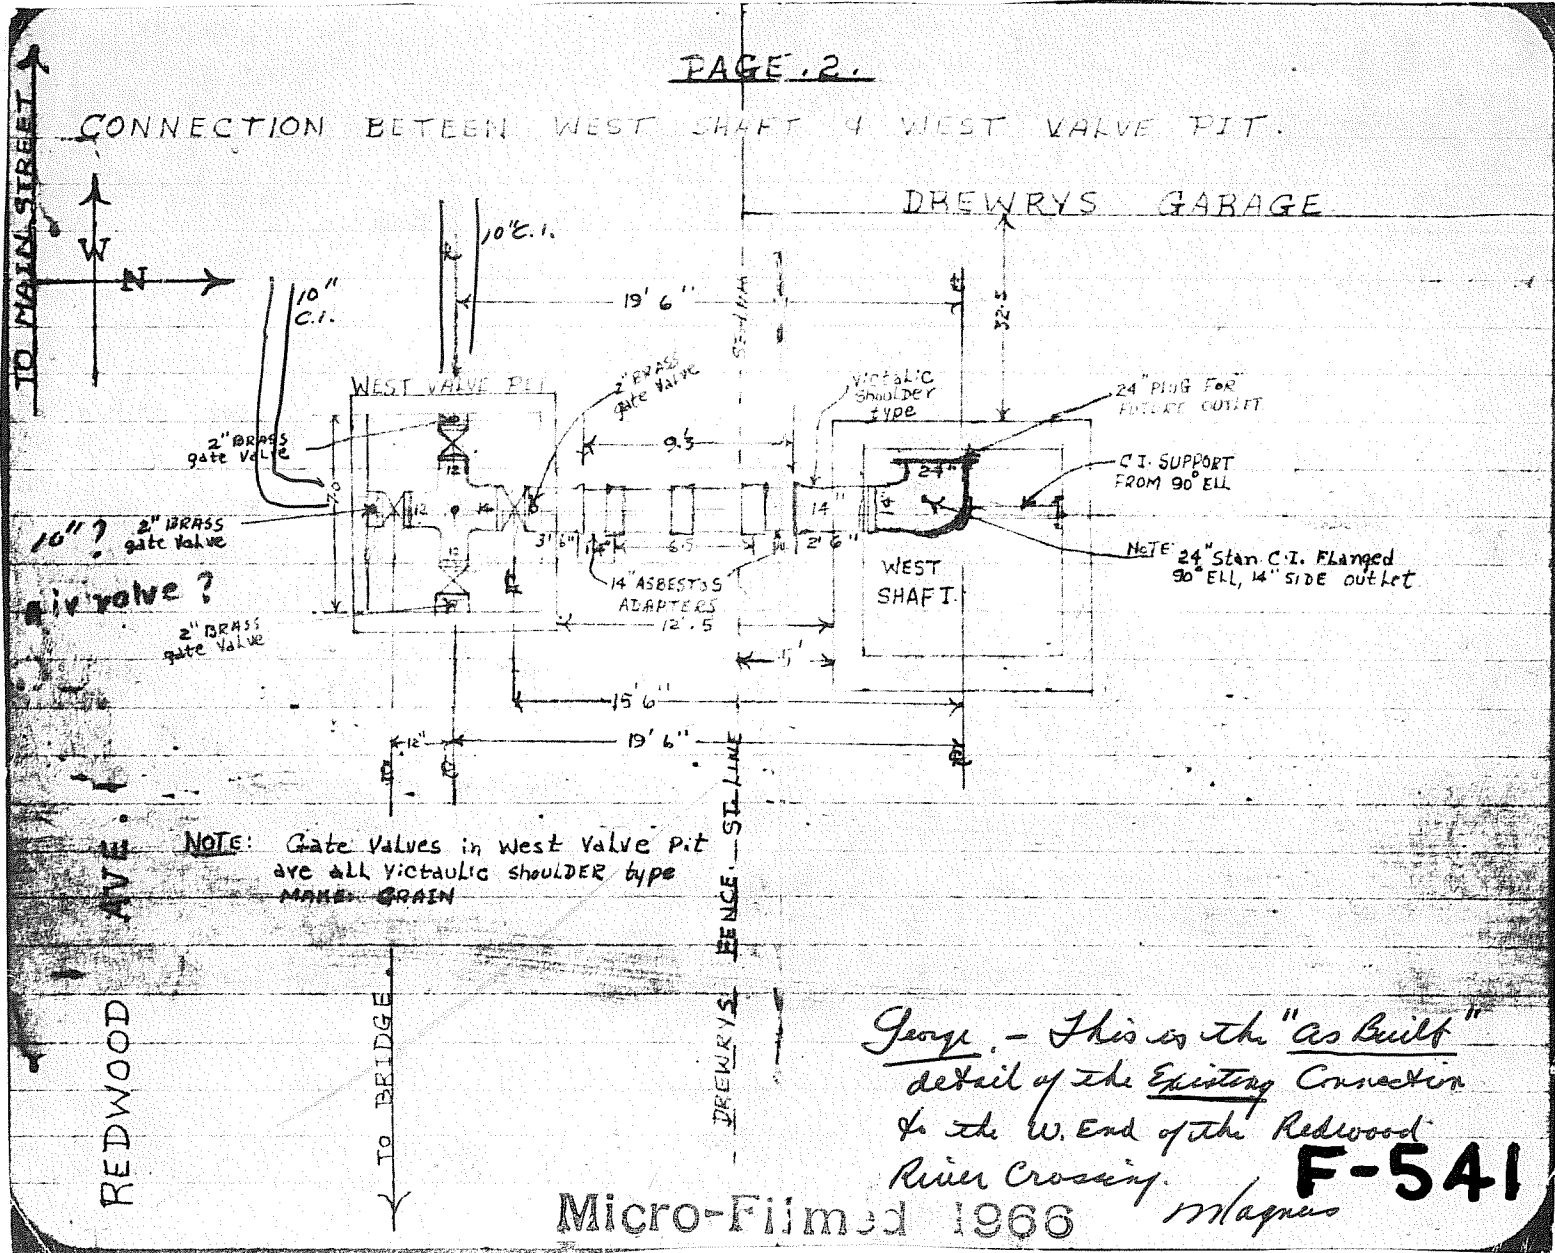

NOTE: Gate valves in West Valve Pit are all victaulic shoulder type MAKE GRAIN

George - This is the "as built" detail of the Existing Connection to the W. End of the Redwood River Crossing. F-541