



AS BUILT
 D.S. SURVEY
 ENGINEERING
 1978 U.T. 20

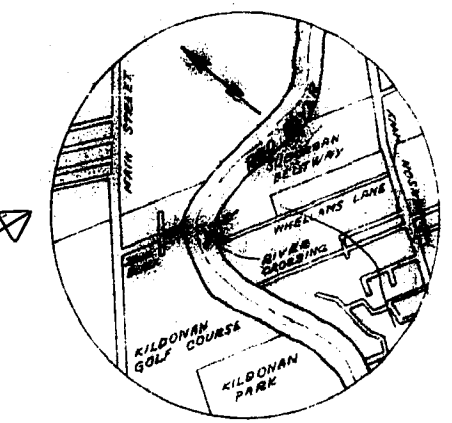

SITE PLAN
 SCALE: 1" = 200'

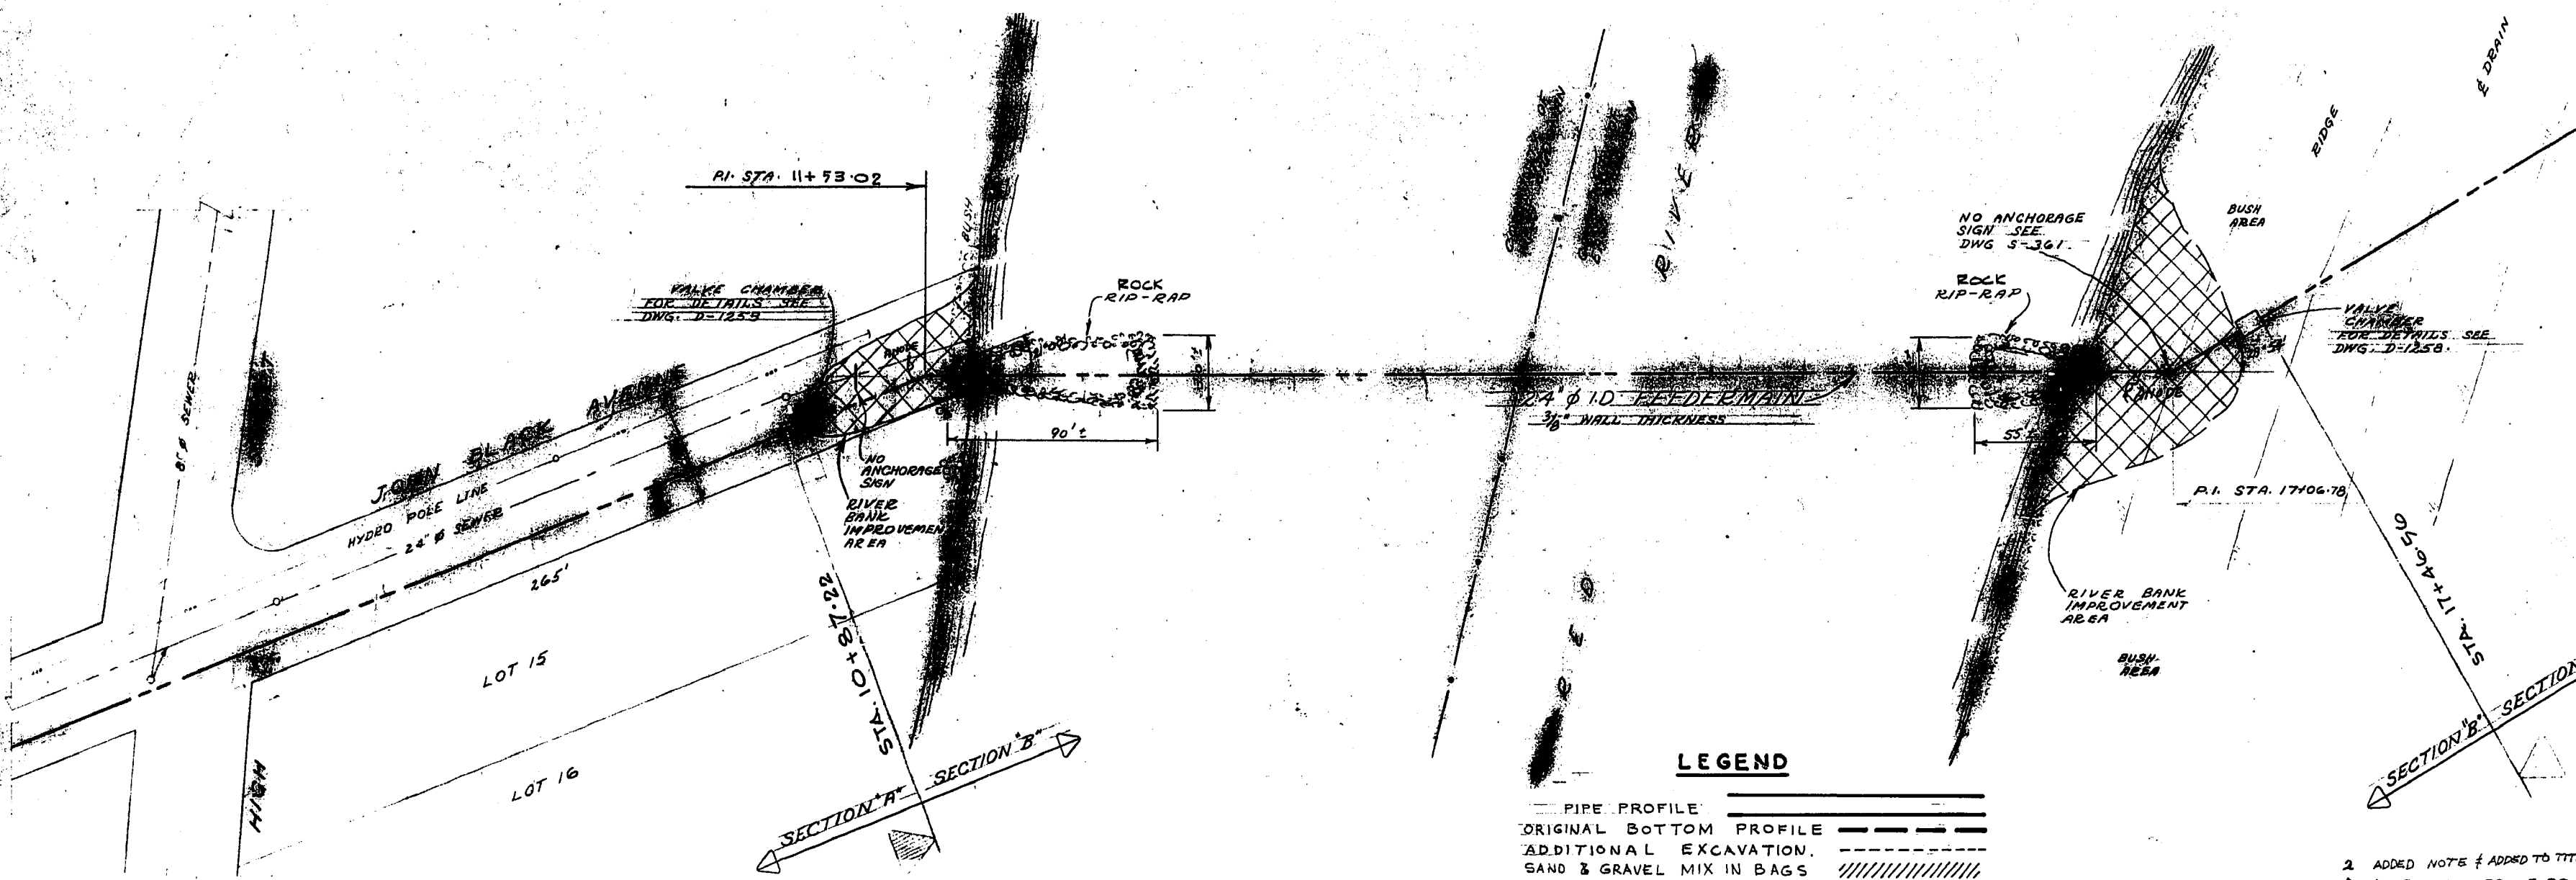


LEGEND

- PIPE PROFILE
- - - ORIGINAL BOTTOM PROFILE
- - - ADDITIONAL EXCAVATION
- ||| SAND & GRAVEL MIX IN BAGS

2. ADDED NOTE & ADDED TO TITLE 93.04.20 K.T.
 REV. A AS BUILT 1978 07 20 R.H. 770

NOTE:
 FEEDERMAIN RE-ROUTED FOR KILDONAN
 BRIDGE CONSTRUCTION - JAN. 1989 TO MAR. 1989.
 FOR DETAILS, SEE DRAWINGS D-1252.A, D-1252.B,
 AND D-1258.A.

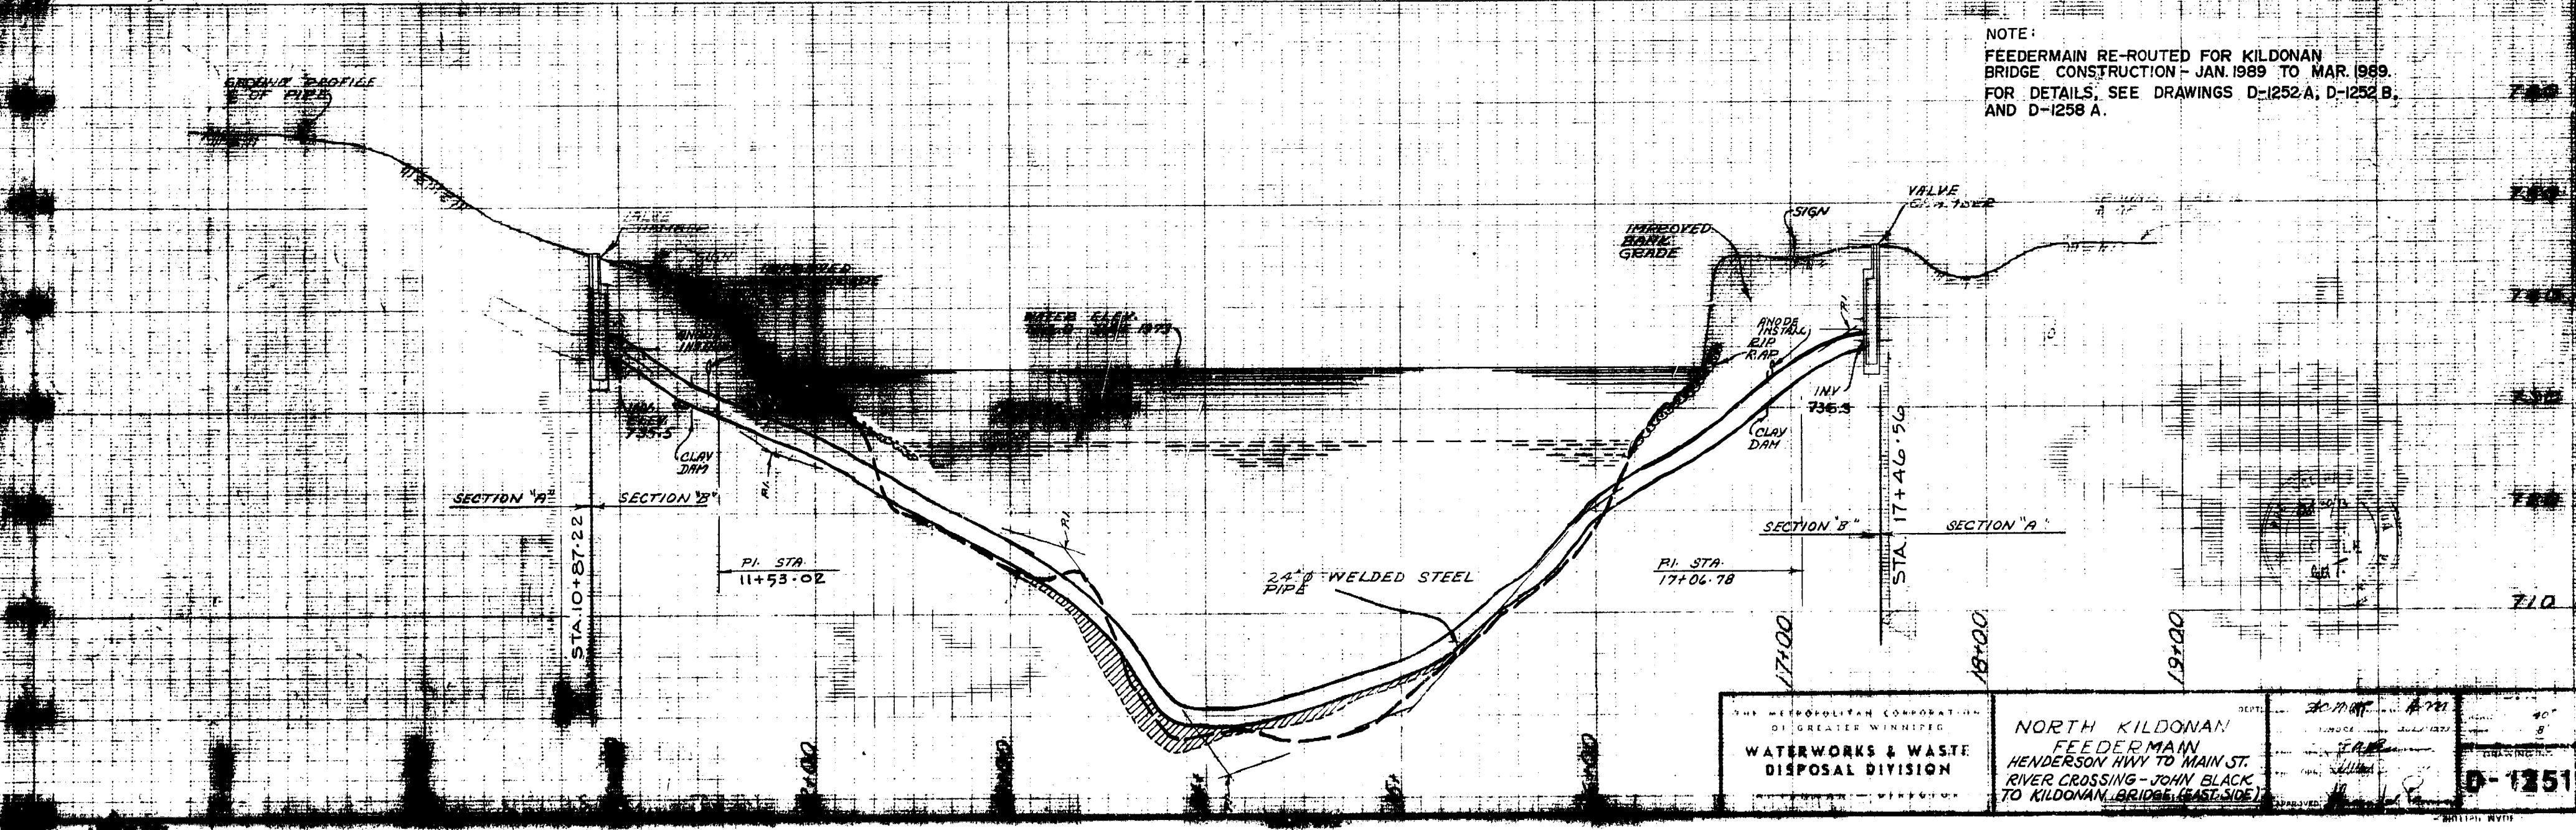

THE METROPOLITAN CORPORATION OF GREATER WINNIPEG WATERWORKS & WASTE DISPOSAL DIVISION	NORTH KILDONAN FEEDERMAIN HENDERSON HWY TO MAIN ST. RIVER CROSSING - JOHN BLACK TO KILDONAN BRIDGE (EAST SIDE)	DEPT. 30 MAR ENGINEER DATE 1989	PROJECT NO. 93.04.20 DRAWING NO. D-1251
	SURVEYED & PLAN CHECKED BY APPROVED AS BUILT		