


INSTRUMENT LOOP DIAGRAM

LOOP NO. LZ-911-TAH

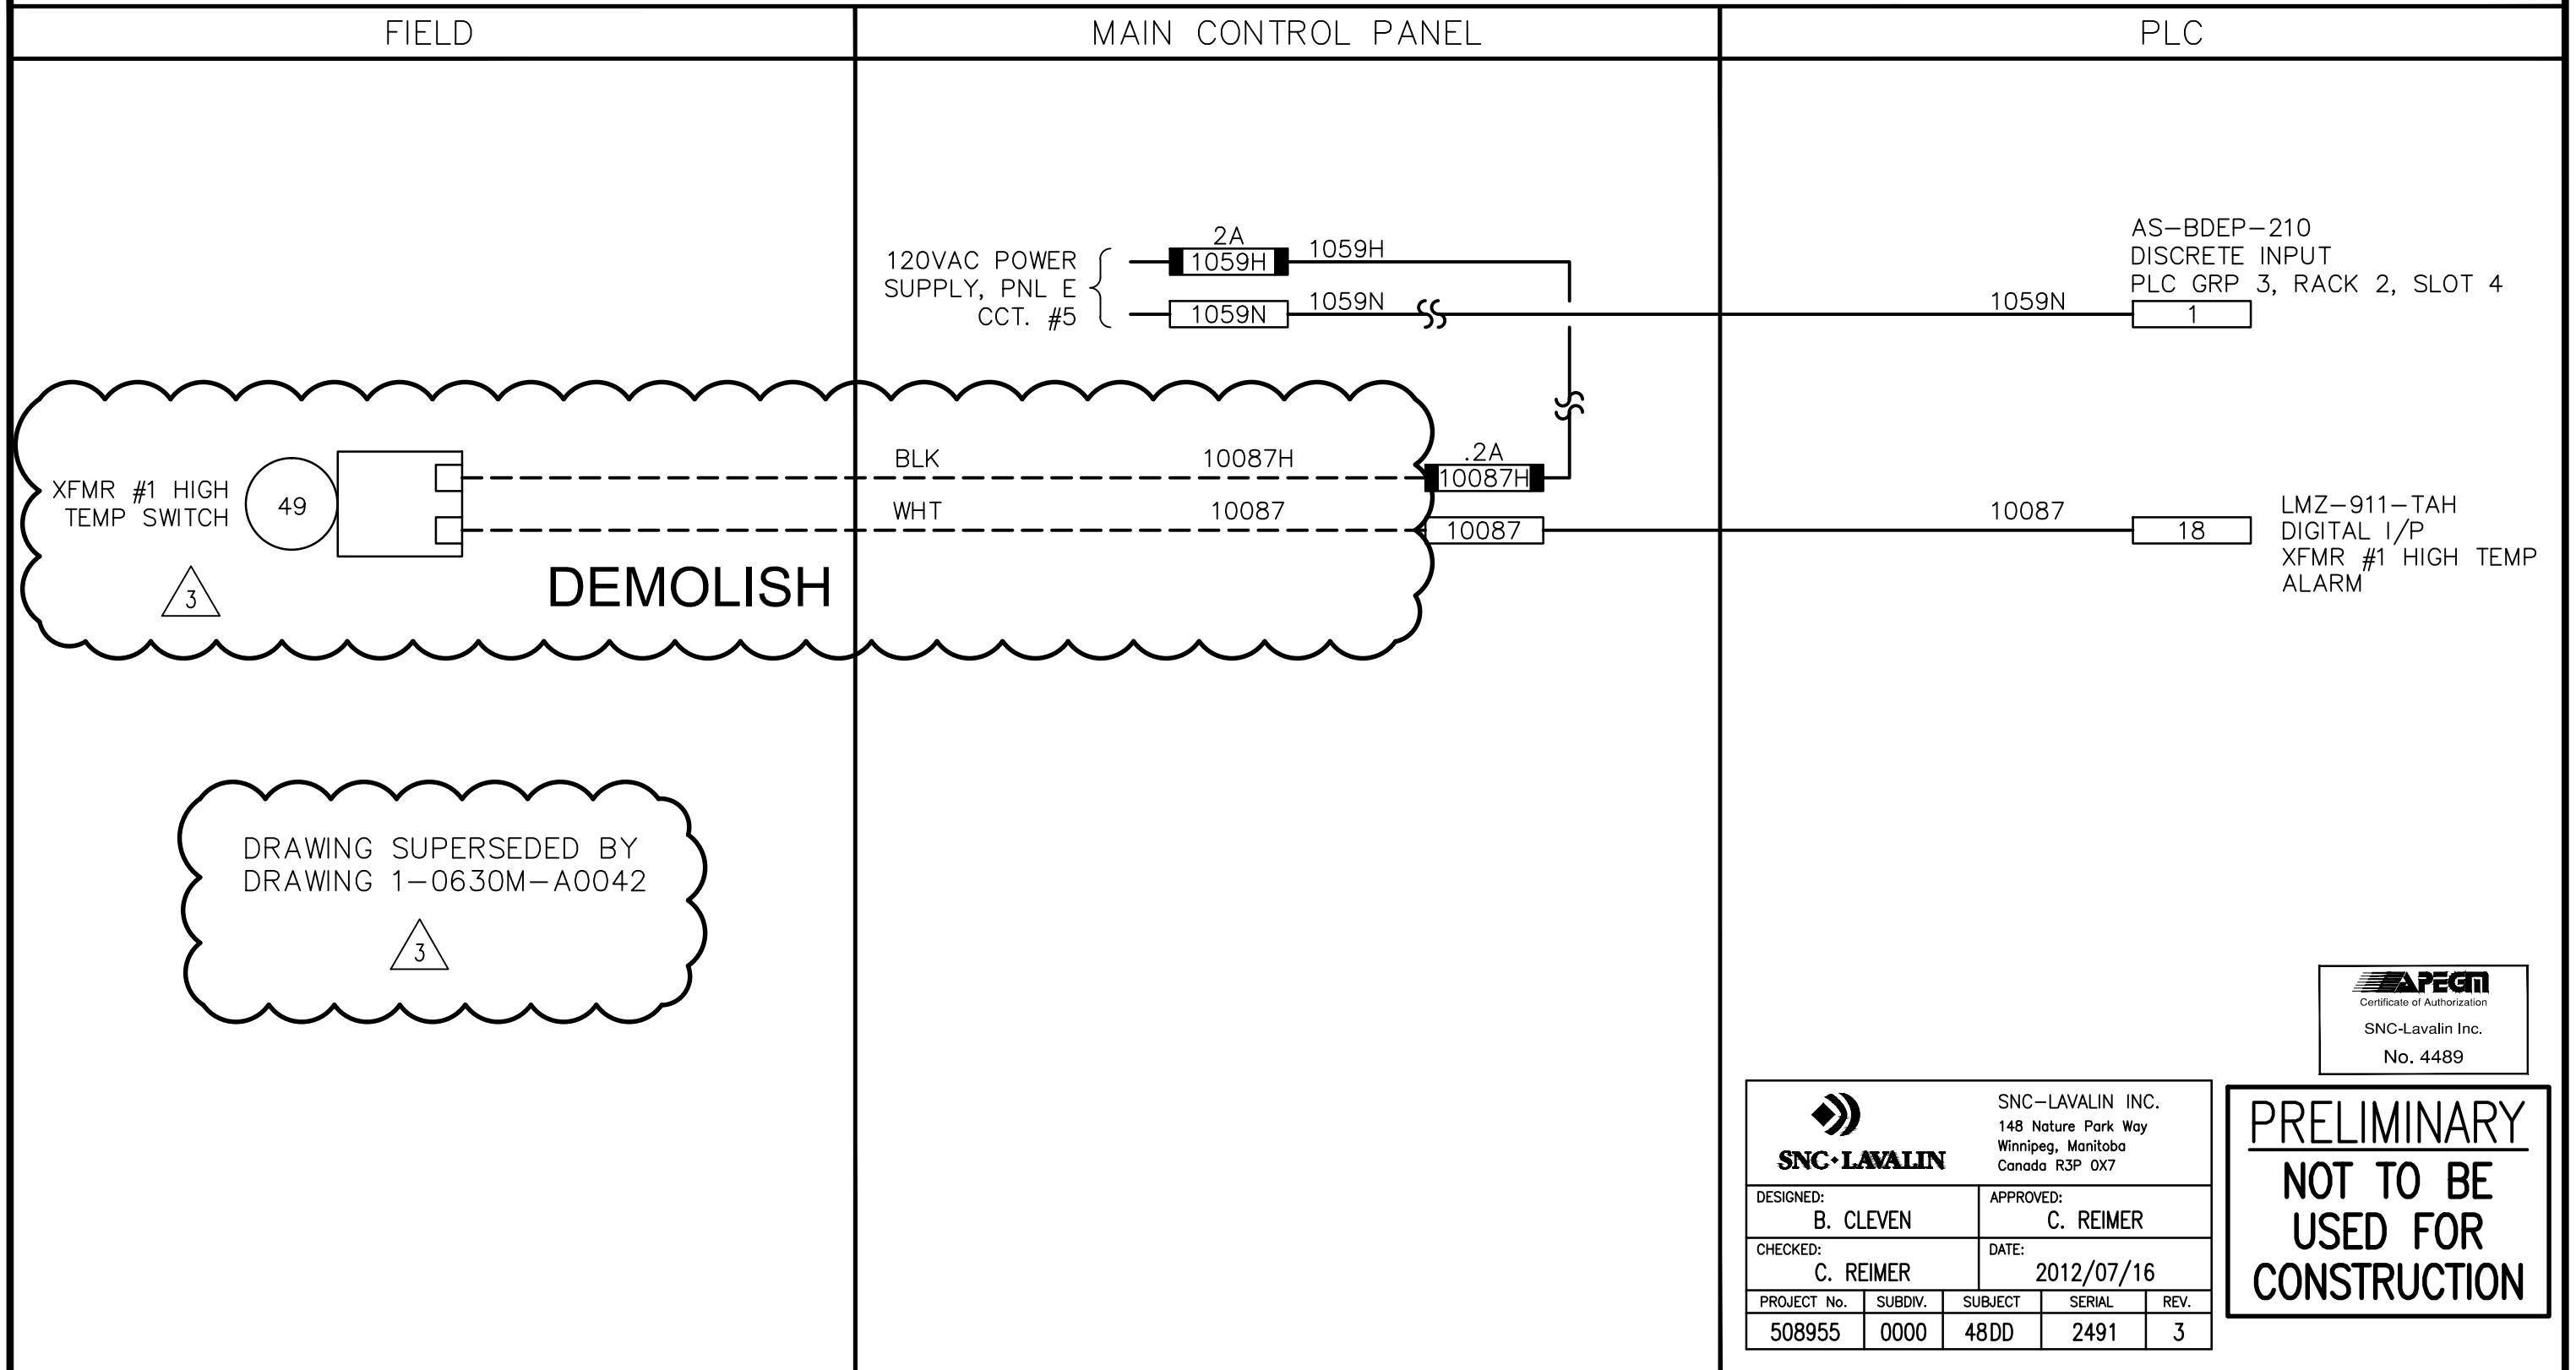

SNC-LAVALIN INC.
148 Nature Park Way
Winnipeg, Manitoba
Canada R3P 0X7

DESIGNED: B. CLEVEN		APPROVED: C. REIMER		
CHECKED: C. REIMER		DATE: 2012/07/16		
PROJECT No.	SUBDIV.	SUBJECT	SERIAL	REV.
508955	0000	48DD	2491	3

PRELIMINARY
 NOT TO BE
 USED FOR
 CONSTRUCTION

NOTE:
1. CONTACTS OPERATE IN FAILSAFE MODE.

				JOB NO. 3153			
				FILENAME D2491			
		95.07.11	1	AS-BUILT	PL		
12.07.23	3	ISSUED FOR TENDER, BID OPP.490-2012	CJR	94.08.12	0	ISSUED FOR CONST.	PL
97.02.03	2	RCPL RECORD DRAWING	PS	94.07.19	A	ISSUED FOR APPROVAL	PL
DATE		REVISION	APP.	DATE		REVISION	APP.

THE CITY OF WINNIPEG

REGIONAL WATER SUPPLY SYSTEM
SUPERVISORY CONTROL AND DATA ACQUISITION

MacLEAN REGIONAL PUMPING STATION – MCP
 TRANSFORMER #1 WINDING HIGH TEMP SWITCH

SCALE _____

DATE 94.07.19

DES PL DWN MJJ

CKD DN APP LK

DRAWING NO.
D-2491