


# INSTRUMENT LOOP DIAGRAM

LOOP NO. LZ-913-XM

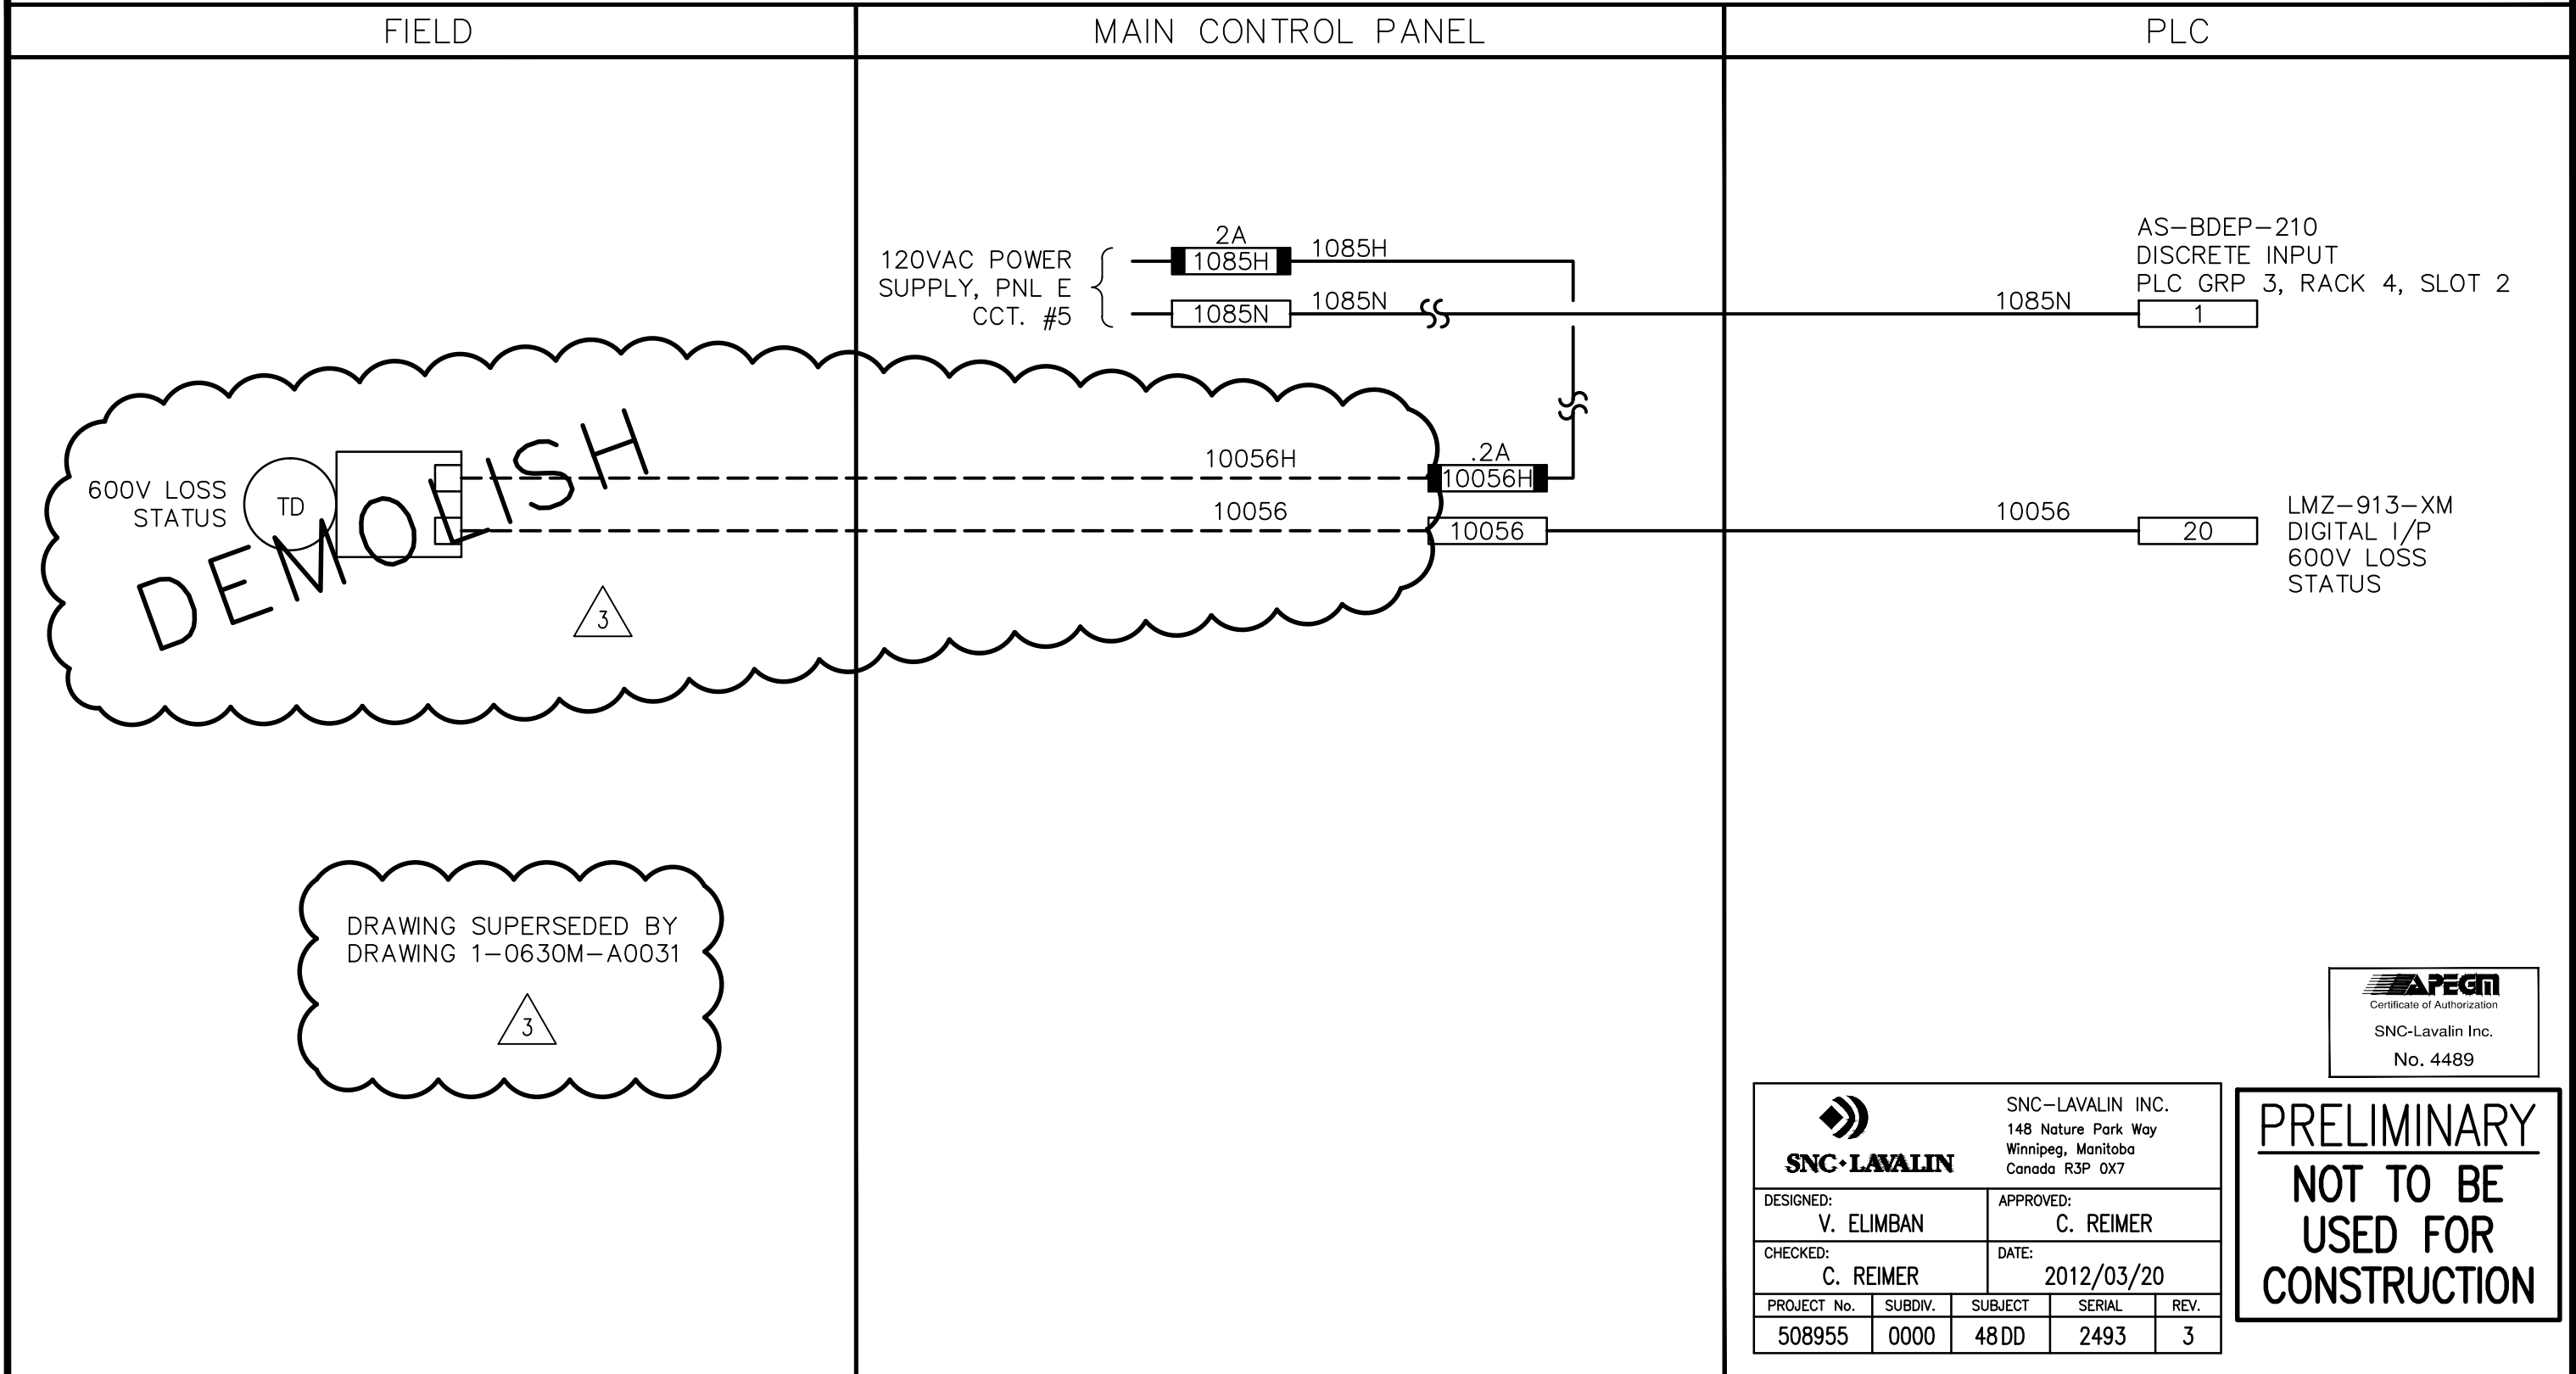

**SNC-LAVALIN**

SNC-LAVALIN INC.  
148 Nature Park Way  
Winnipeg, Manitoba  
Canada R3P 0X7

DESIGNED: V. ELIMBAN	APPROVED: C. REIMER			
CHECKED: C. REIMER	DATE: 2012/03/20			
PROJECT No. 508955	SUBDIV. 0000	SUBJECT 48DD	SERIAL 2493	REV. 3

PRELIMINARY  
NOT TO BE  
USED FOR  
CONSTRUCTION

**NOTE:**  
1. CONTACTS OPERATE IN FAILSAFE MODE.

<b>Reid Crowther</b>		<b>Consulting Engineers</b>	
DATE	REVISION	APP.	DATE

<b>dp controls ltd.</b>		<b>Edgemoor, Alberta</b>	
JOB NO. 3153	FILENAME D2493	95.07.11	1 AS-BUILT
12.07.23	3 ISSUED FOR TENDER, BID OPP.490-2012	CJR	94.08.12 0 ISSUED FOR CONST.
97.02.03	2 RCPL RECORD DRAWING	PS	94.07.19 A ISSUED FOR APPROVAL
DATE	REVISION	APP.	DATE

**THE CITY OF WINNIPEG**

REGIONAL WATER SUPPLY SYSTEM  
SUPERVISORY CONTROL AND DATA ACQUISITION

MacLEAN REGIONAL PUMPING STATION – MCP  
600V LOSS STATUS

SCALE _____
DATE <u>94.07.19</u>
DES <u>PL</u> <u>DWN</u> <u>MJJ</u>
CKD <u>DN</u> <u>APP</u> <u>LK</u>
DRAWING NO. <b>D-2493</b>