


FLOW DIAGRAM

- LEGEND**
- FANS --- AF
 - ROOF HOODS --- RH
 - ELECTRIC HEATERS --- HE
 - FAN COIL UNITS --- FC
 - VALVES --- VV
 - GRILLES --- G
 - DAMPERS --- D
 - THERMOSTATS --- T
 - THERMISTERS --- TH

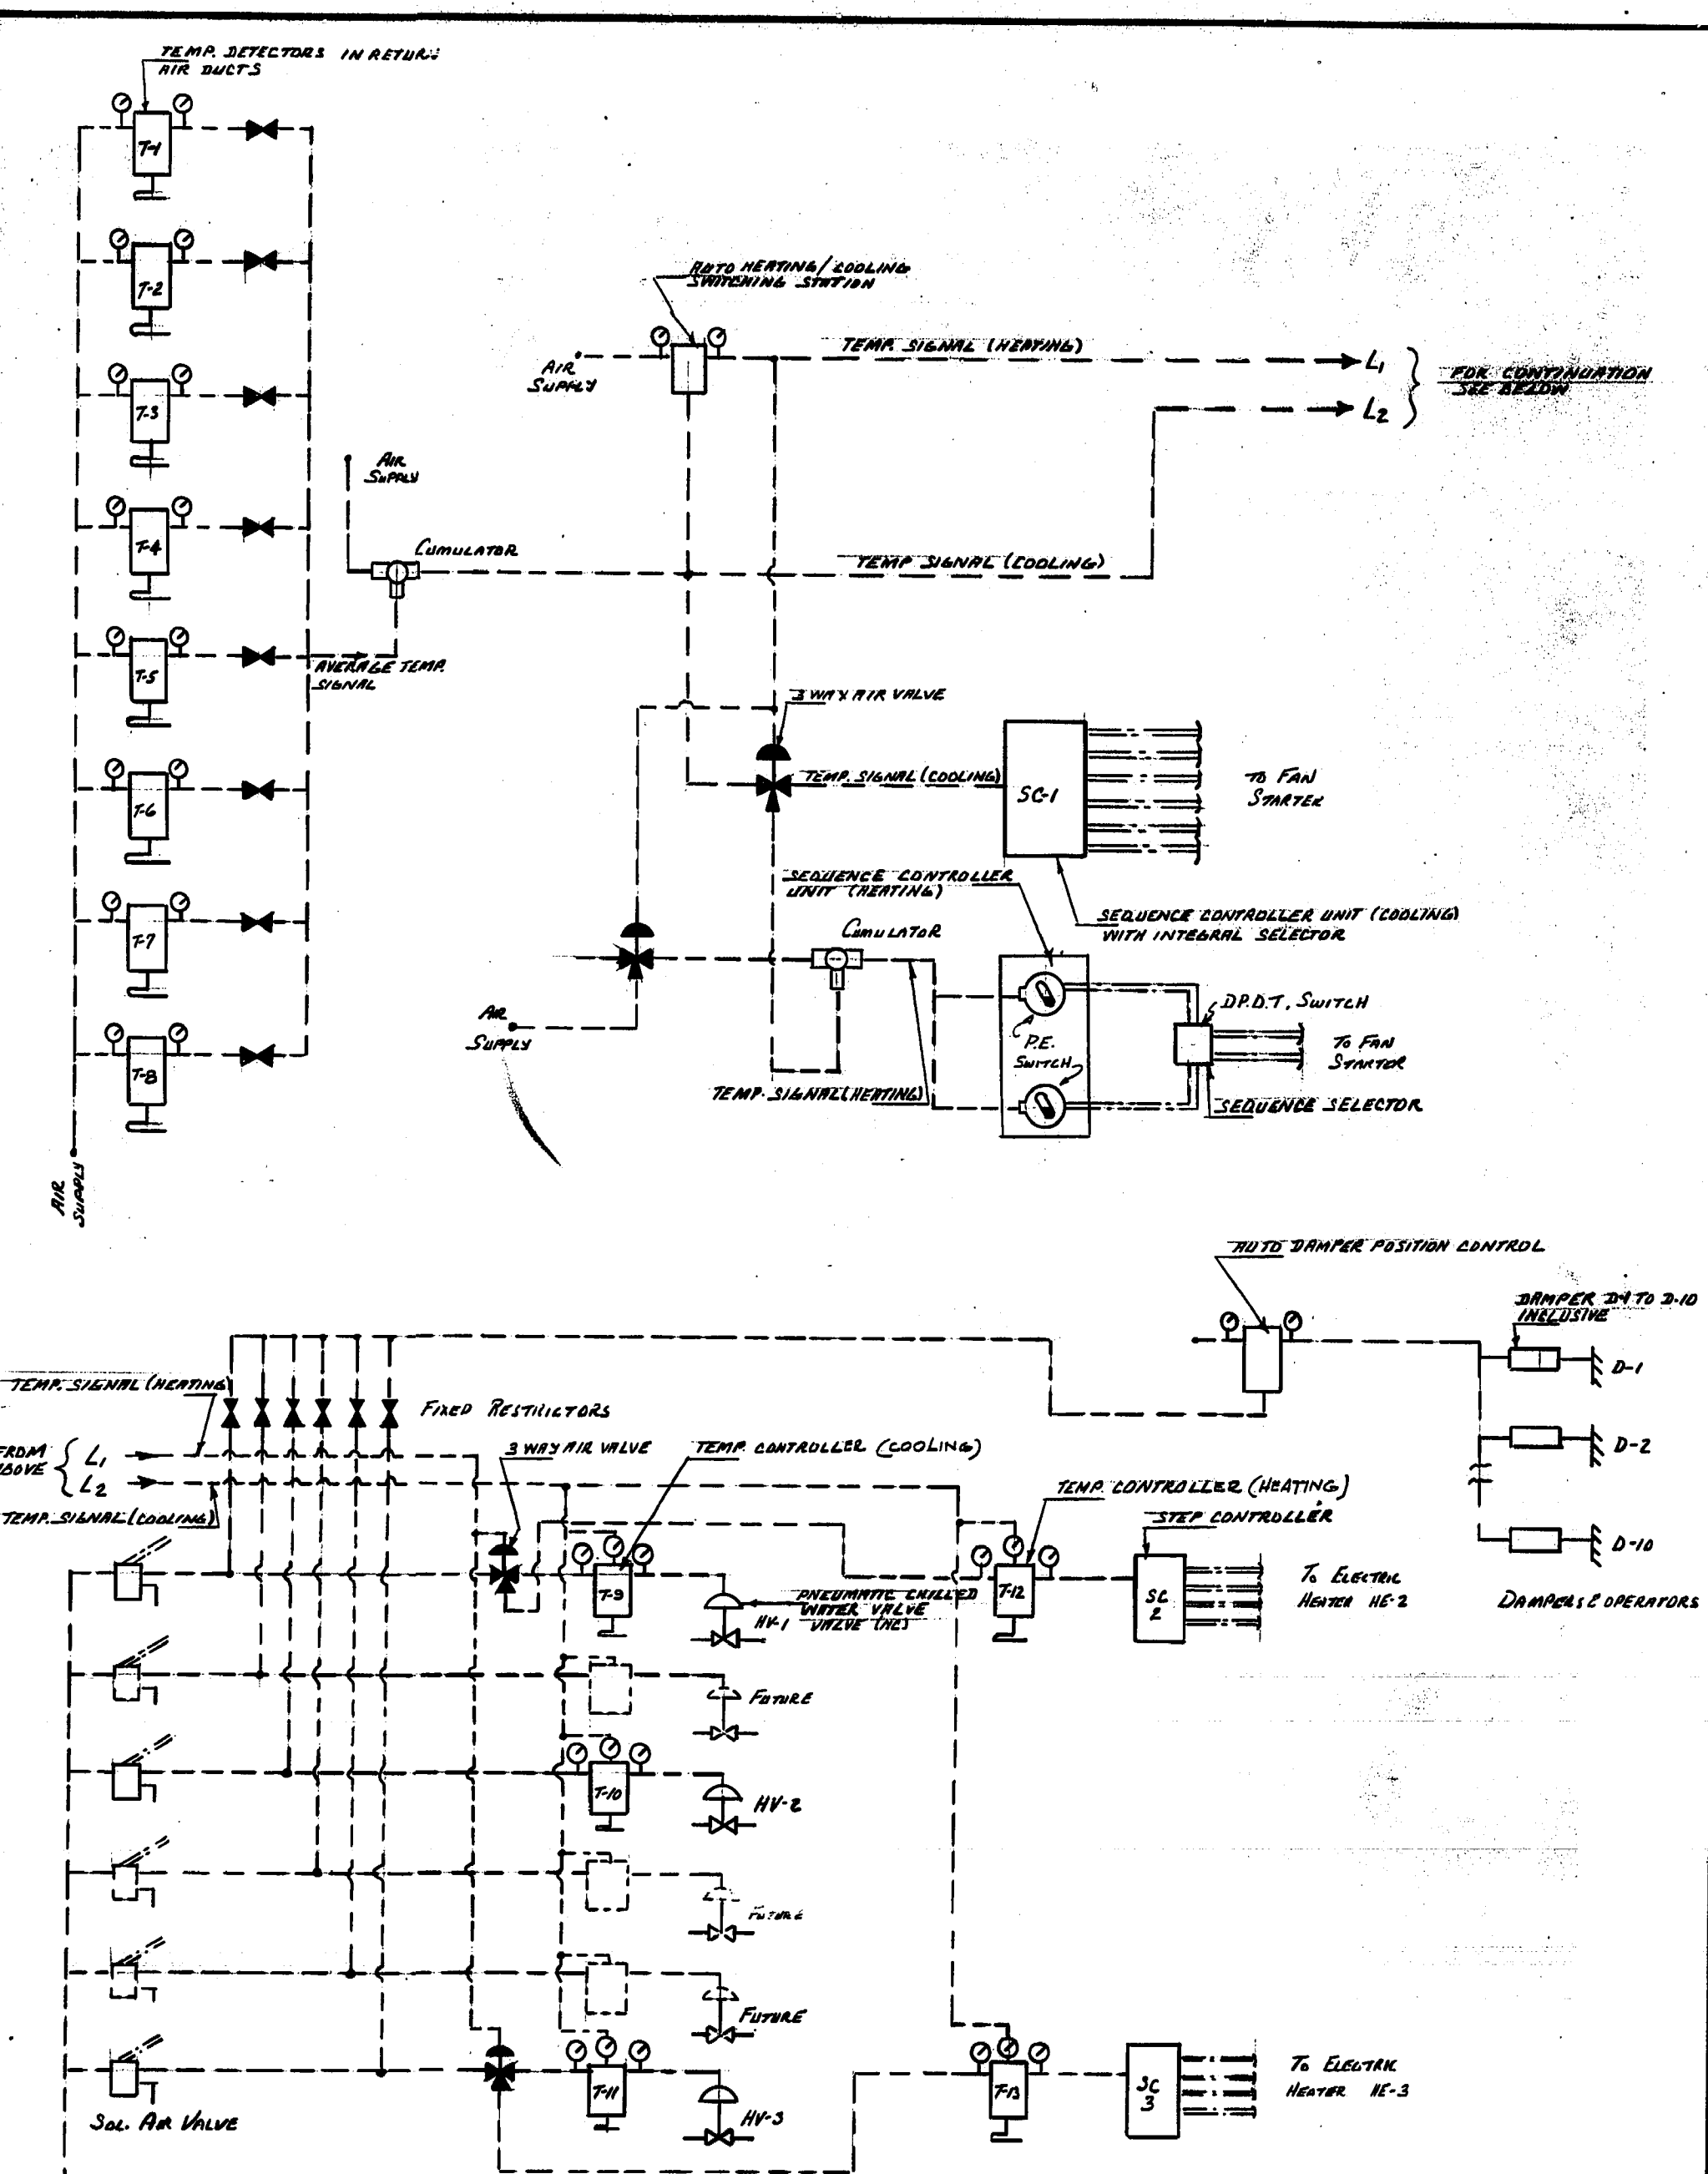

TYPICAL CONTROL DIAGRAM FOR PUMP ROOM AIR CONDITIONING SYSTEM



REVISED AS BUILT, JUNE - 1966

THE METROPOLITAN CORPORATION OF GREATER WINNIPEG
WATERWORKS AND WASTE DISPOSAL DIVISION

METRO EAST PUMPING STATION AND RESERVOIR

CONTRACT A - PUMPING STATION HEATING AND VENTILATING FLOW AND CONTROL DIAGRAMS

<p>APPROVED</p> <p><i>J. W. MacLaren</i></p> <p>J. W. MacLaren ENGINEER</p>	<p>DESIGN</p> <p><i>James T. MacLaren</i></p> <p>James T. MacLaren ENGINEER OF WATERWORKS</p>
<p>DATE</p> <p>JUNE 22, 1962</p>	<p>SCALE</p> <p>NOT TO SCALE</p>
<p>DWG. NO.</p> <p>27</p>	<p>OF</p> <p>51</p>

ME-34