

- CONSTRUCTION NOTES:**
1. CONTRACTOR SHALL TAKE PRECAUTIONARY STEPS TO AVOID DAMAGE FROM CONSTRUCTION ACTIVITIES TO EXISTING BOULEVARDS AND TREES WITHIN THE LIMITS OF CONSTRUCTION.
 2. LOCATION OF EXISTING SERVICES ARE TO BE CONFIRMED IN THE FIELD BY THE CONTRACTOR.
 3. TIE-INS TO BE VERIFIED IN THE FIELD BY THE CONTRACT ADMINISTRATOR.
 4. LIMITS OF SIDEWALK RENEWALS TO BE FINALIZED IN THE FIELD BY THE CONTRACT ADMINISTRATOR.
 5. BOULEVARD REPLACEMENT TO BE FINALIZED IN THE FIELD BY THE CONTRACT ADMINISTRATOR.

METRIC

WHOLE NUMBERS INDICATE MILLIMETRES
DECIMALIZED NUMBERS INDICATE METRES.

WARNING

- IF POWER EQUIPMENT OR EXPLOSIVES ARE TO BE USED FOR EXCAVATION ON THIS PROJECT THE CONTRACTOR MUST:
1. NOTIFY THE GAS COMPANY OF THE PROPOSED LOCATION OF EXCAVATION.
 2. TAKE PRECAUTION TO AVOID DAMAGE TO GAS COMPANY INSTALLED. SEE PROVINCIAL REGULATION 210/72 FOR DETAILS.

#	COORDINATES		RIM ELEV.	SUMP ELEV.	STATION	PIPE LEAD	LEAD INV.	INV. AT MAIN
	NORTHING	EASTING						
CB28	5526101.358	633517.114	TBD	-	-	-	-	-
CB29	5526111.790	633540.961	230.971	228.571	12+067.500	23.4m - 250mm	229.171	228.687
CB30	5526110.896	633543.026	230.971	228.671	12+067.500	2.5m - 250mm	229.271	229.201

NOTE: ALL COORDINATES SHOWN ON DRAWINGS ARE NAD 83 UTM.
COMBINED SCALE FACTOR TO OBTAIN GROUND DISTANCES IS 0.9997688




LOCATION UNDERGROUND STRUCTURES	APPROVED STRUCTURES	B.M. ELEV.
ORIGINAL SIGNED BY DERRICK SAEDAL	DATE 04/14/10	
SUPV. U/G STRUCTURES COMMITTEE	DATE	

NOTE:
LOCATION OF UNDERGROUND STRUCTURES AS SHOWN ARE BASED ON THE BEST INFORMATION AVAILABLE, BUT NO GUARANTEE IS GIVEN THAT ALL EXISTING UTILITIES ARE SHOWN OR THAT THE GIVEN LOCATIONS ARE EXACT. CONFIRMATION OF EXISTENCE AND EXACT LOCATION OF ALL SERVICES MUST BE OBTAINED FROM THE INDIVIDUAL UTILITIES BEFORE PROCEEDING WITH CONSTRUCTION.

NO.	REVISIONS	DATE	BY
3	ISSUED FOR CHANGE ORDER	-/-	TJP
2	ISSUED FOR TENDER	03/26/10	TJP
1	ISSUED FOR 75% REVIEW	03/03/10	TJP

DESIGNED BY	APPROVED BY	HOR. SCALE	VERTICAL
RTP	ORIGINAL SIGNED BY DAVE P. KRAHN	1 : 250	1 : 10
DRAWN BY	DATE		
TJH/PMW	03/26/10		
CHECKED BY	DATE		
ORIGINAL SIGNED BY TARAN J. PETERS	03/26/10		

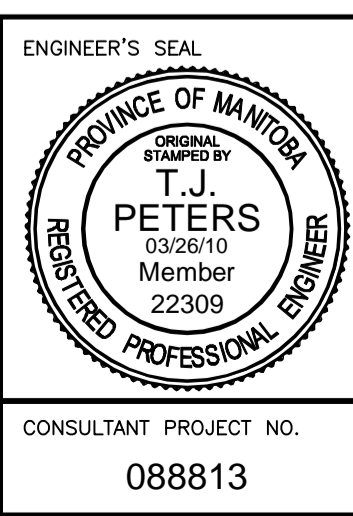

THE CITY OF WINNIPEG TRANSIT DEPARTMENT

SOUTHWEST RAPID TRANSIT CORRIDOR - STAGE 1
TRANSITWAY CONSTRUCTION, LANDSCAPING & ASSOCIATED WORKS

PAVING & GRADING - TRANSITWAY - STA. 11+905 TO 12+100 (PLAN)

CITY DRAWING NUMBER: P-3317-35
SHEET OF 35 OF 105
CONSULTANT DRAWING NUMBER: C6-C3025-C

CONSULTANT PROJECT NO.: 088813

C:\cadd\088813\sheet\Contract 6-Title Block-CO-Revisions.dwg