


PRECAST CONCRETE COLUMN MK-C-1
1:20


PRECAST CONCRETE COLUMN MK-C-2
1:20

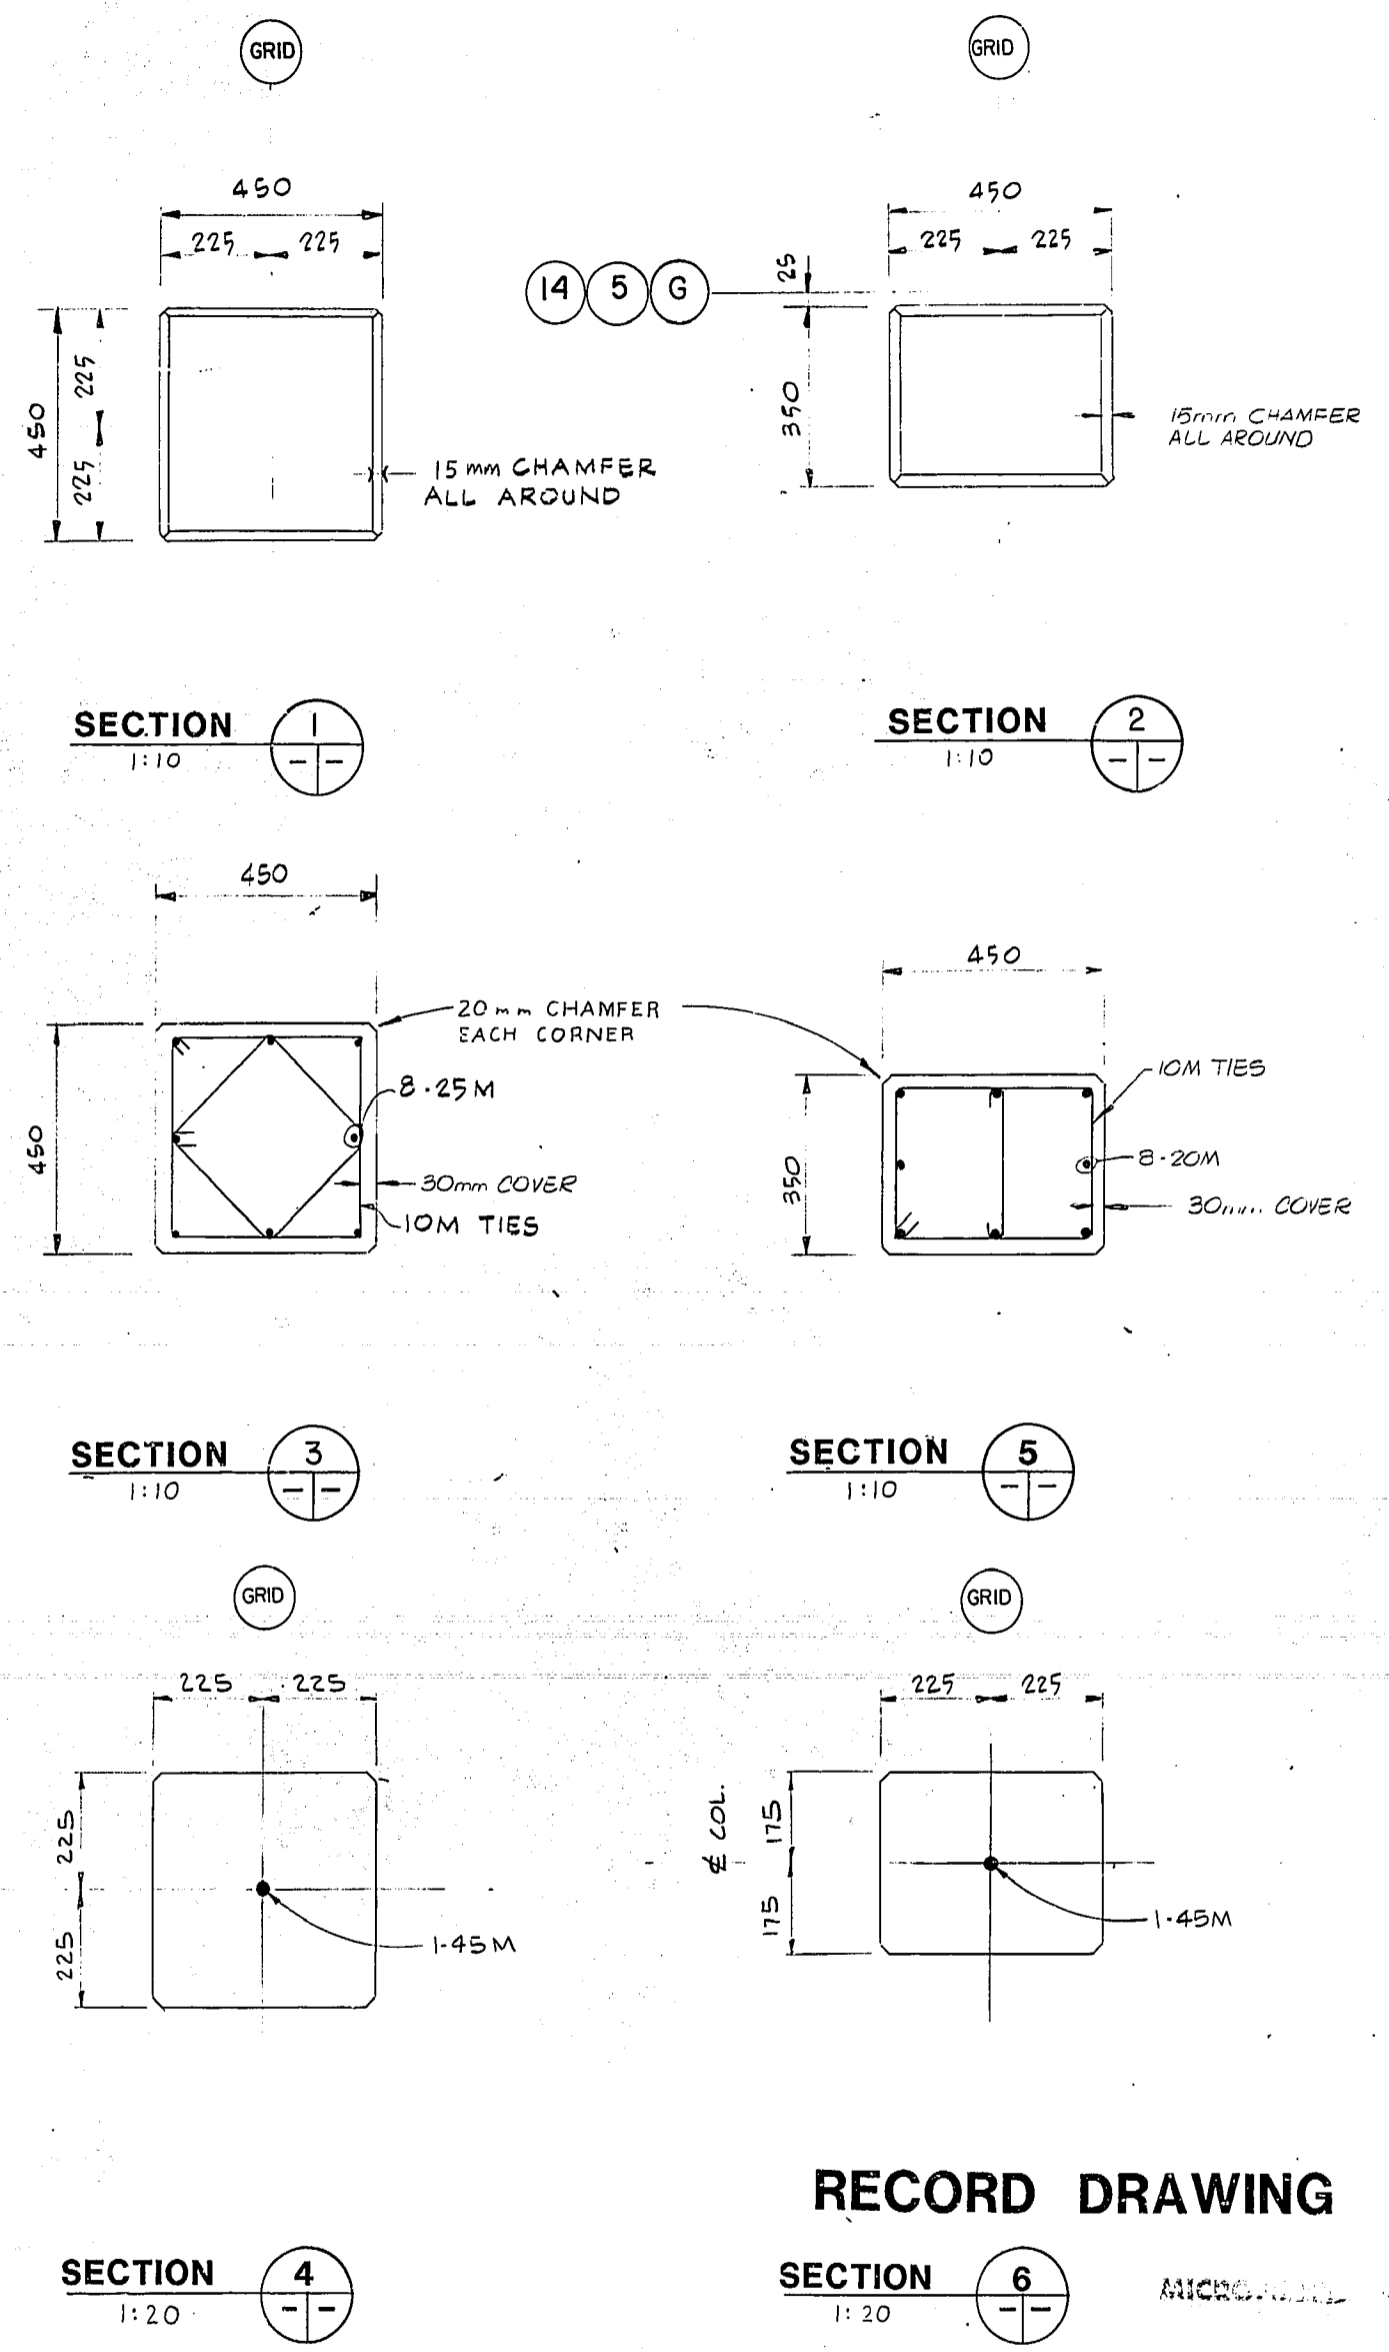

SECTION 4
1:20

SECTION 6
1:20

METRIC NOTES
WHOLE NUMBERS IND. MILLIMETRES
DECIMALIZED EXPRESSIONS IND. METRES

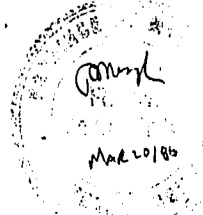

NO	REVISIONS	DATE	APP.
1	ADDENDUM NO. 1	22 APR 80	EEL
2	RECORD DRAWING	DEC 18 80	EEL

Underwood McLellan Ltd.
Consulting Engineers and Planners

DESIGNED BY: H.T.H. DRAWN BY: H.T.H.
 CHECKED BY: DATE: MARCH 20, 1980
 APPROVED BY: DATE: 20/3/80

ENGINEER'S SEAL

THE CITY OF WINNIPEG
WORKS & OPERATIONS DEPARTMENT
WATERWORKS, WASTE & DISPOSAL DIVISION

WILKES AVENUE RESERVOIR RECONSTRUCTION
PRECAST COLUMN DETAILS

RELEASED FOR CONSTRUCTION: DATE: 20/03/80
 SCALE: AS NOTED DRAWING NO: **WIL-30**
 REV. 2