
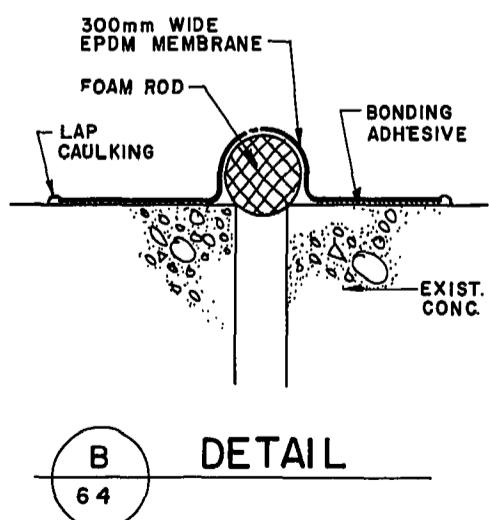
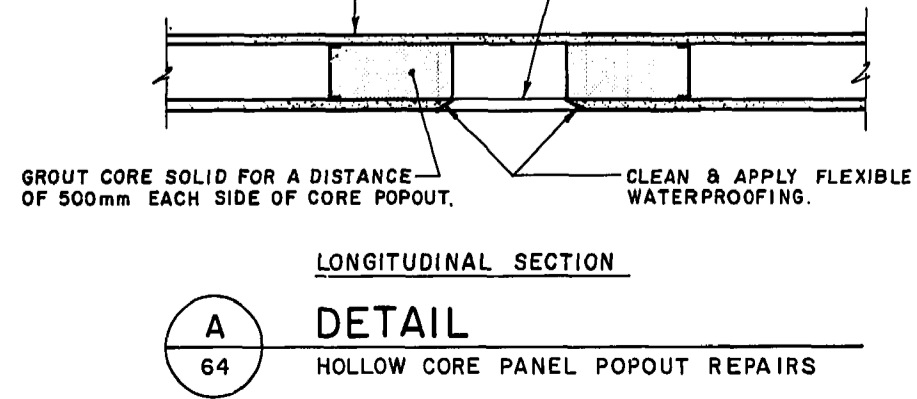


ROOF PANEL REMOVAL DETAILS - ROOF PANEL REPLACEMENT AS PER EXISTING DETAILS ON DRAWING NO. WIL-28. (EXCEPT FOR THE 6 WIDE X 6 DEEP SAWCUT TYP. (EACH EDGE) AND THE 1.3 TO 1.5 THICK SEALANT OVER PRIMED SURFACE SHOWN AT THE JOINT'S BETWEEN PANELS)

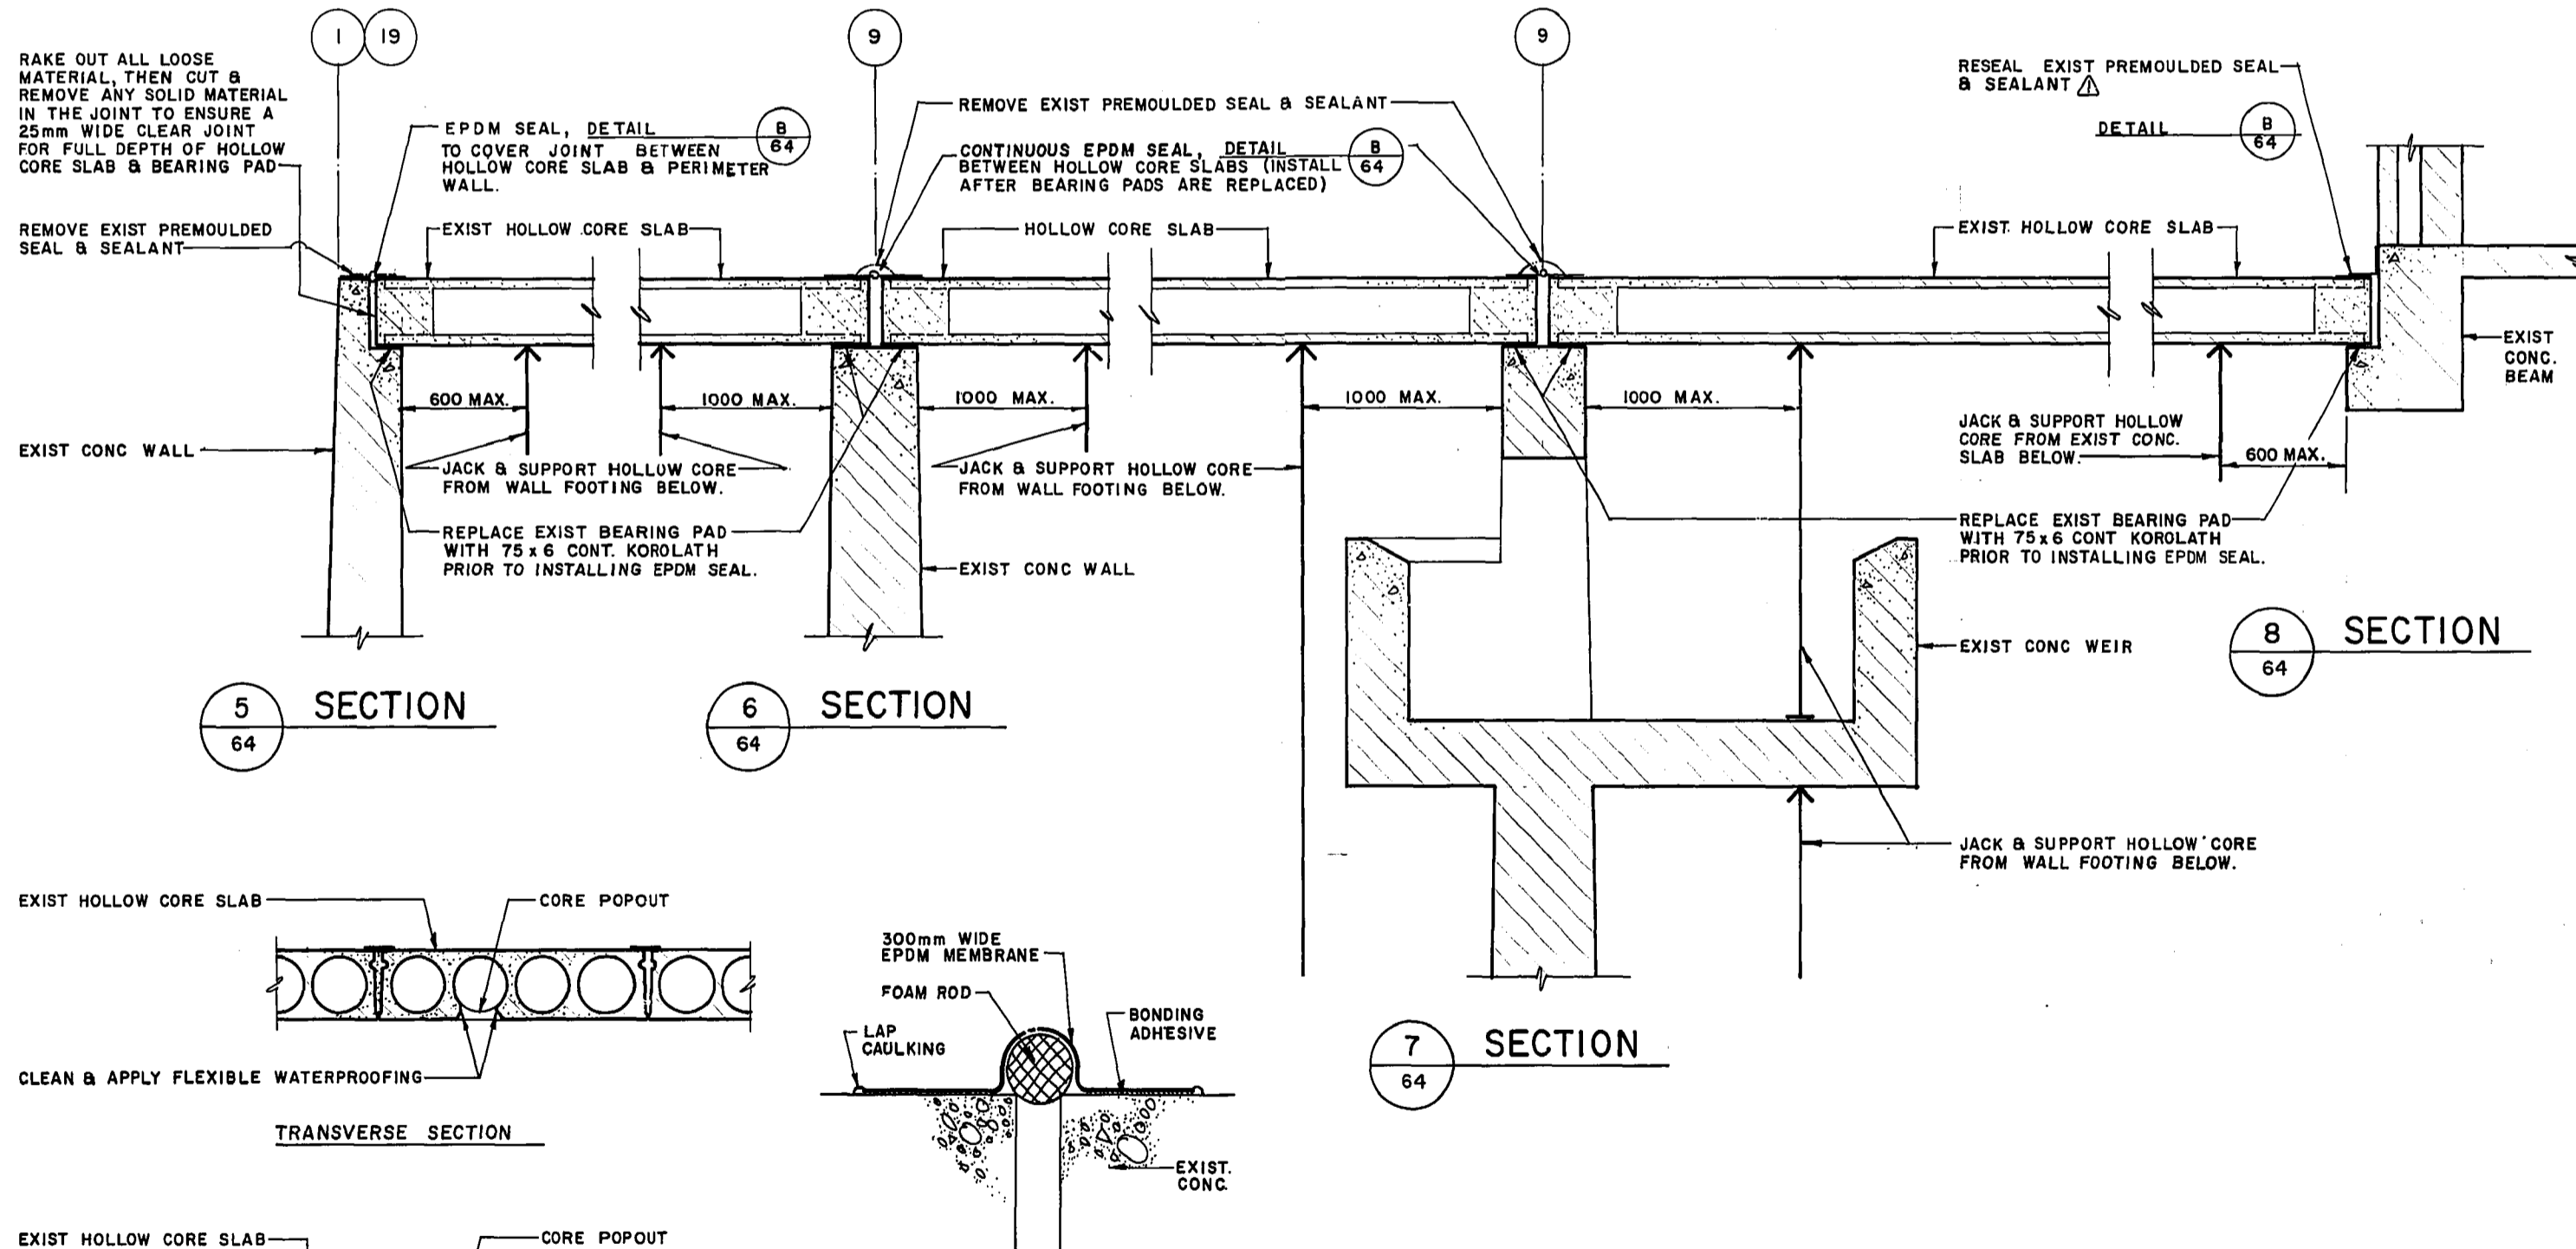

NOTES FOR HOLLOW CORE ROOF PANEL REPLACEMENTS

- A. REMOVAL
- DESIGN AND SUBMIT SHOP DRAWINGS AND DESIGN CALCULATIONS FOR REMOVALS. THE DESIGN SHALL BE BASED ON THE FOLLOWING LOADING RESTRICTIONS:
 - (A) SUPERIMPOSED LOADING ALLOWED ON PRECAST HOLLOW CORE PANELS

MOMENT	M	≤	78.65 KN/M OR 95.0 KN/M/PANEL
SHEAR	V	≤	29.7 KN/M OR 36.0 KN/PANEL
PUNCHING SHEAR	V _p	≤	30.52 b _c KN

b_c = PERIPHERY OF CRITICAL SECTIONS IN METRES LOCATED AT 0.016 METRES AWAY FROM THE PERIPHERY OF THE CONCENTRATED LOAD AREA
 - SUPERIMPOSED LOADING (IN EXCESS OF EXISTING STRUCTURAL DEAD WEIGHT) ALLOWED ON PRECAST ROOF BEAMS

MOMENT	M	≤	475.8 KN.M FOR 9.76 M SPANS
SHEAR	V	≤	602.2 KN.M FOR 10.98 M SPANS
			146.25 KN FOR 9.76 M SPANS
			164.5 KN FOR 10.98 M SPANS
 - SUPERIMPOSED LOADING ALLOWED ON EXISTING FLOOR SLAB WITH THE RESERVOIR EMPTY.

LOADING ≤ 70 KN/M²
 - REMOVE PANELS WITHOUT DAMAGING ANY PART OF THE STRUCTURE THAT IS TO REMAIN. ANY DAMAGE WILL BE REPAIRED AT THE EXPENSE OF THE CONTRACTOR TO THE SATISFACTION OF THE CONTRACT ADMINISTRATOR.

- B. REPLACEMENT
- DESIGN AND SUBMIT SHOP DRAWINGS FOR 300 HOLLOW CORE ROOF PANELS TO MATCH DIMENSIONS OF THE EXISTING. DESIGN FOR SUPERIMPOSED LOAD OF 6.0 KN/M².
 - DESIGN AND SUBMIT SHOP DRAWINGS AND DESIGN CALCULATIONS FOR INSTALLATION. THE DESIGN SHALL BE BASED ON THE SAME LOADING RESTRICTIONS AS FOR THE REMOVAL.
 - PLACE GROUT AND CONCRETE AS PER EXISTING DETAILS ON DRAWING NUMBER WIL-28.

JACKING OPERATIONS FOR PRECAST HOLLOW CORE SLABS

- INSTALL BRACING AND SHORING SYSTEM PRIOR TO ANY JACKING.
- RESTRICT DIFFERENTIAL MOVEMENT BETWEEN ADJACENT CONNECTED PANELS TO LESS THAN 1 mm DURING ALL OPERATIONS TO REPLACE THE HOLLOW CORE BEARING PADS.
- THE HOLLOW CORE SLABS SHALL NOT BE JACKED UP MORE THAN 10 mm AT ANY LOCATION.
- ADJUST BRACING AND SHORING SYSTEM DURING JACKING OPERATIONS TO RESTRICT MOVEMENT OF THE HOLLOW CORE SLABS TO LESS THAN 2 mm IN CASE OF JACKING FAILURE.

LOCATION APPROVED UNDERGROUND STRUCTURES		B.M. ELEV.	UMA Engineering Ltd. Engineers & Planners 1478 Buffalo Place, Winnipeg, Manitoba, Canada R3T 1L7	
SUPV. U/G STRUCTURES COMMITTEE	DATE		DESIGNED BY S.B.B.	CHECKED BY
			DRAWN BY K.J.L.	APPROVED BY
NOTE: LOCATION OF UNDERGROUND STRUCTURES AS SHOWN ARE BASED ON THE BEST INFORMATION AVAILABLE BUT NO GUARANTEE IS GIVEN THAT ALL EXISTING UTILITIES ARE SHOWN OR THAT THE GIVEN LOCATIONS ARE EXACT. CONFIRMATION OF EXISTENCE AND EXACT LOCATION OF ALL SERVICES MUST BE OBTAINED FROM THE INDIVIDUAL UTILITIES BEFORE PROCEEDING WITH CONSTRUCTION.			HOR. SCALE 1:20	RELEASED FOR CONSTRUCTION
			VERTICAL	
			1 TO RECORD DRAWING	10/91 AMU.
			NO. REVISIONS	DATE BY
				DATE 1991-01-31

RECORD DRAWING P.D. No. 91-19

THE CITY OF WINNIPEG WORKS AND OPERATIONS DIVISION
WATERWORKS, WASTE & DISPOSAL DIVISION

WILKES RESERVOIR PHASE II CONSTRUCTION
STRUCTURAL WORKS

CITY DRAWING NUMBER
SHEET 4 OF 5
WIL-64

ROOF PANEL REPAIR & REPLACEMENT DETAILS

ENGINEER'S SEAL
PROVINCE OF MANITOBA
REGISTERED PROFESSIONAL ENGINEER
BISWANGER
01/04/93

CONSULTANT DRAWING NO. 4113 0265 259 02

File # RE 10318