


WILKES 1992 Bldg. Envelope 0265 259 L-1

WIL-68

WILKE 1992 BLDG. ENVELOPE

FILE # RE10527

File # RE

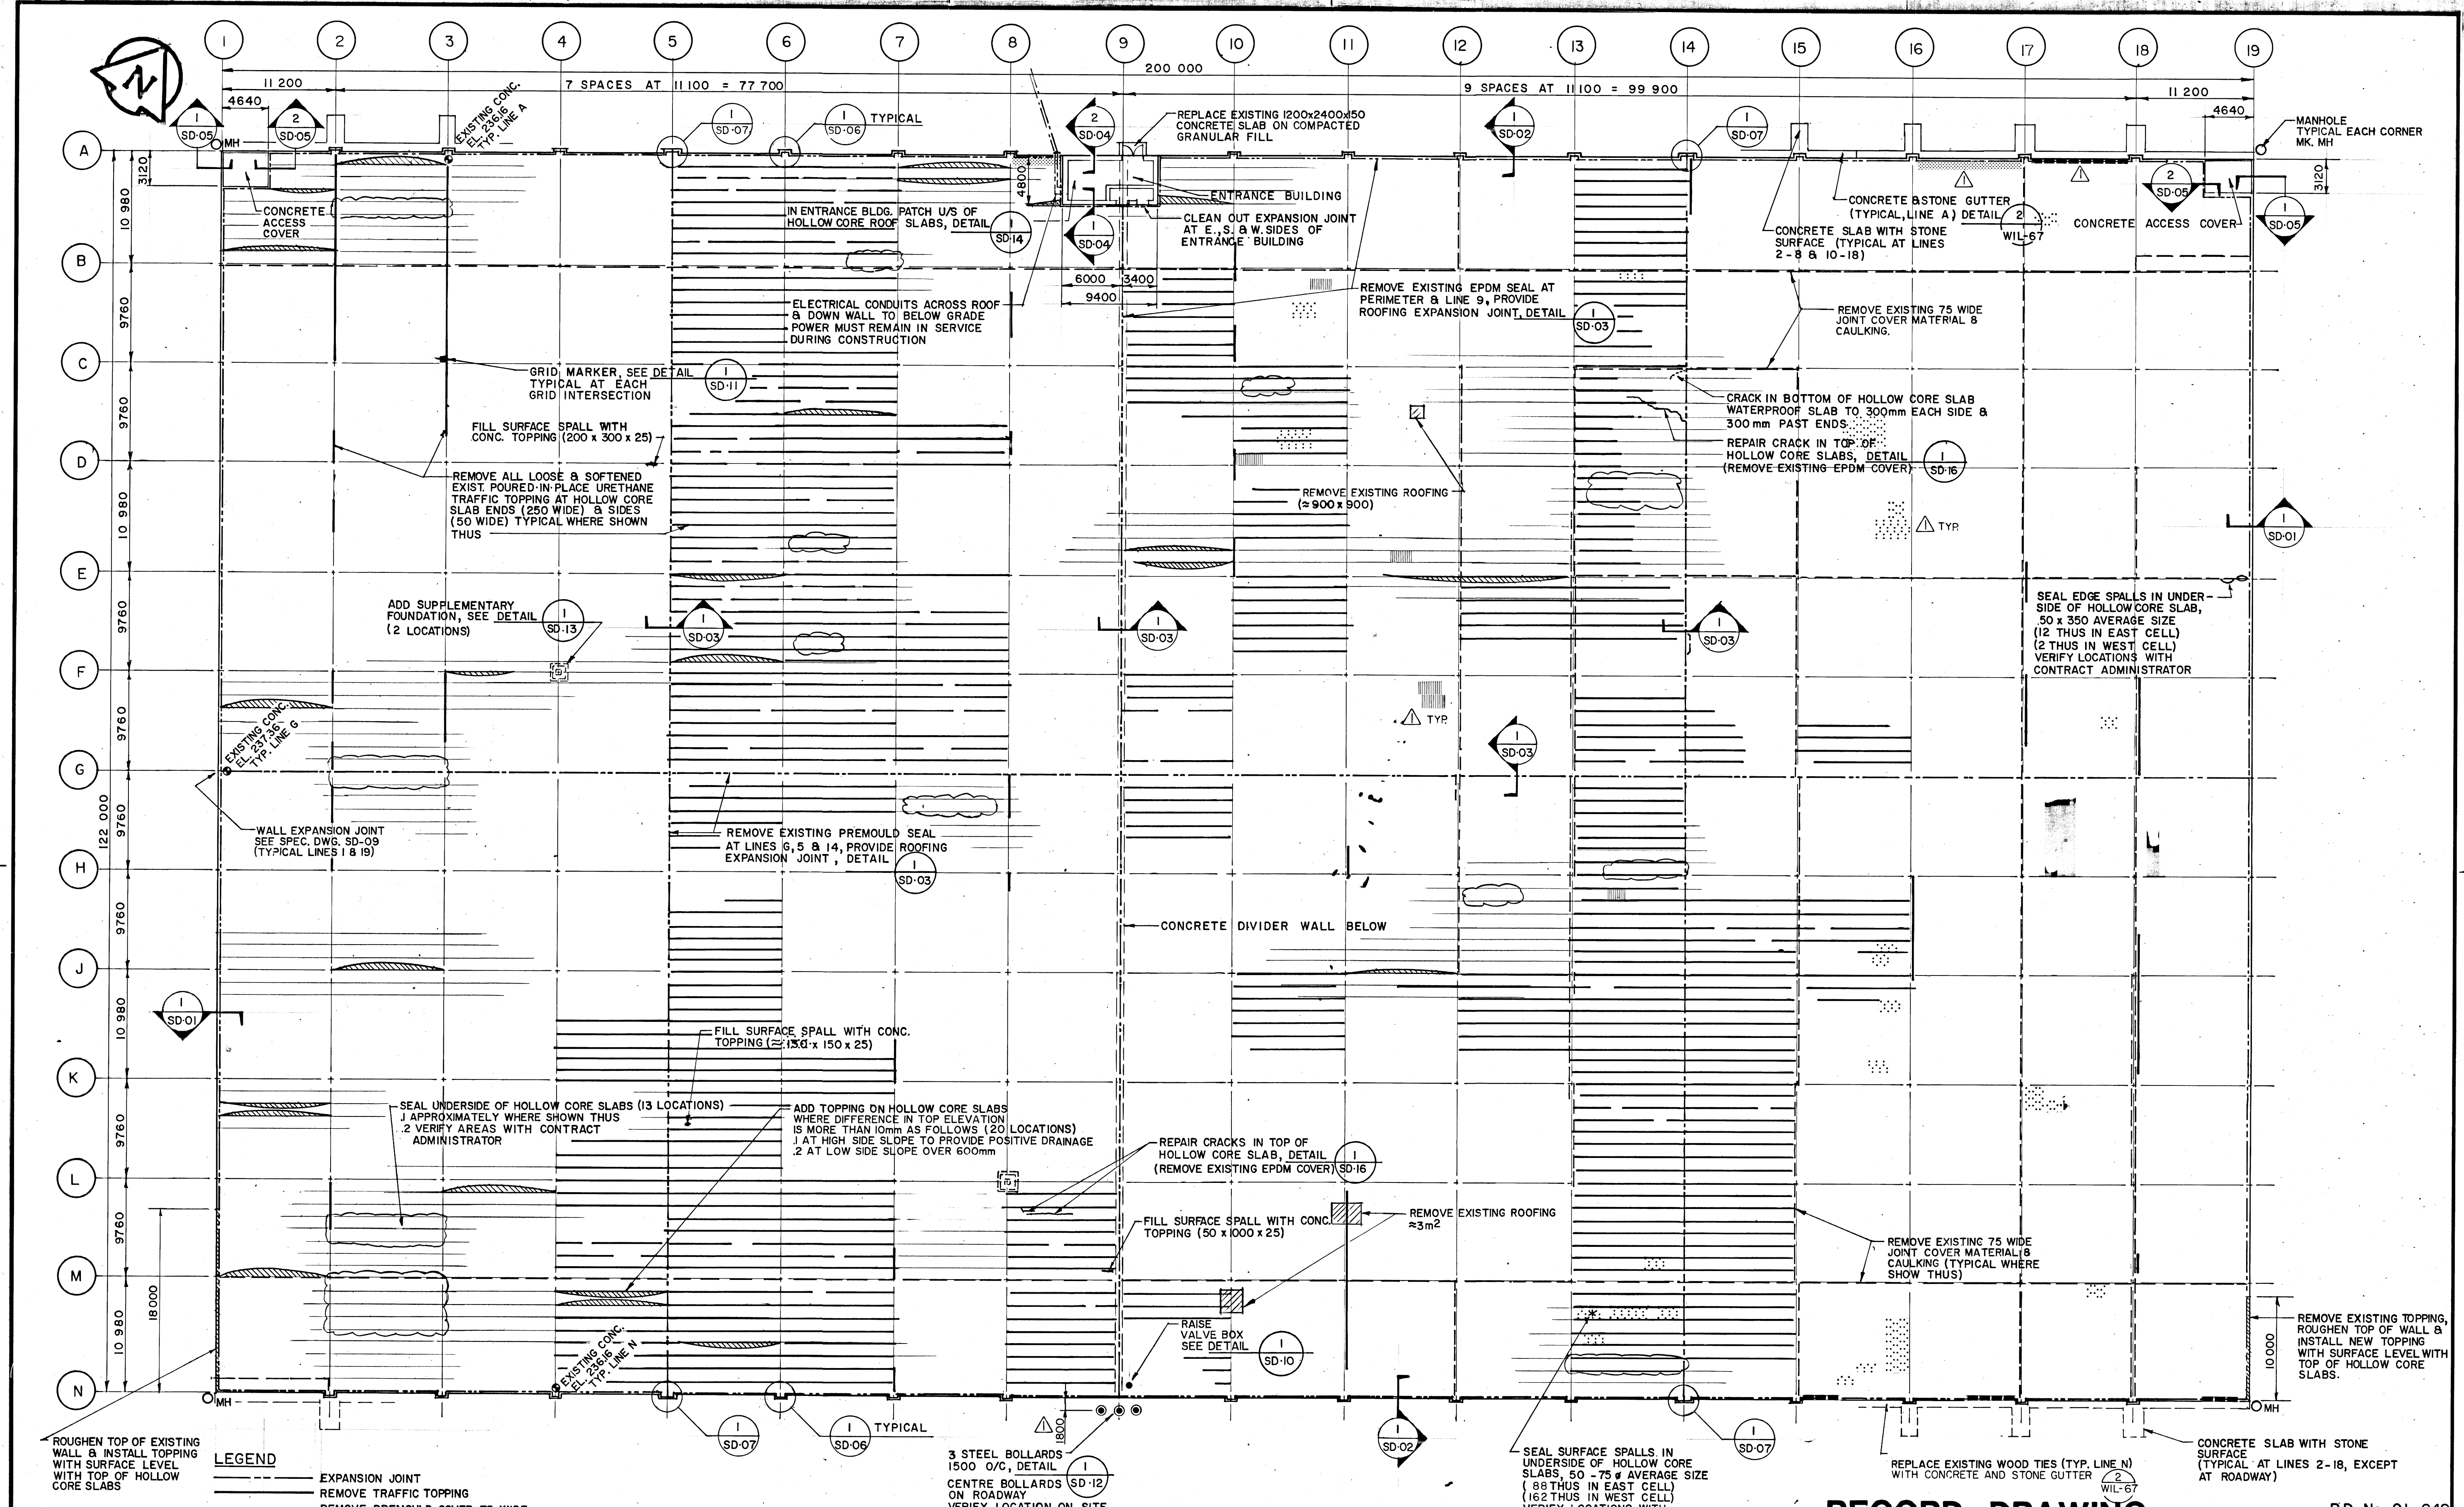

LEGEND

- EXPANSION JOINT
- REMOVE TRAFFIC TOPPING
- REMOVE PREMOULD COVER 75 WIDE
- SEAL UNDERSIDE OF HOLLOW CORE SLABS
- ADD TOPPING ON HOLLOW CORE SLABS OR PERIMETER WALLS
- REPAIR CRACKS IN TOP OF HOLLOW CORE SLABS
- REMOVE EXISTING ROOFING
- ADD SUPPLEMENTARY FOUNDATION
- SEAL SURFACE SPALLS (UNDERSIDE OF H.C. SLABS)
- SEAL EDGE SPALLS (UNDERSIDE OF H.C. SLABS)
- REMOVE AND REPLACE LOOSE GROUT & CONCRETE
- REPAIR CRACKED PANEL
- ROOF SPALL REPAIR AREAS
 - PER SD-17
 - PER SD-18

LOCATION APPROVED UNDERGROUND STRUCTURES

SUPV. U/G STRUCTURES	DATE

NOTE: LOCATION OF UNDERGROUND STRUCTURES AS SHOWN ARE BASED ON THE BEST INFORMATION AVAILABLE BUT NO GUARANTEE IS GIVEN THAT ALL EXISTING UTILITIES ARE SHOWN OR THAT THE GIVEN LOCATIONS ARE EXACT. CONFIRMATION OF EXISTENCE AND EXACT LOCATION OF ALL SERVICES MUST BE OBTAINED FROM THE INDIVIDUAL UTILITIES BEFORE PROCEEDING WITH CONSTRUCTION.

B.M. ELEV.	DATE	BY

UMA Engineering Ltd. Engineers & Planners 1479 Buffalo Place, Winnipeg, Manitoba, Canada R3T 1L7	
DESIGNED BY: J.R.C.	CHECKED BY: S.B.B.
DRAWN BY: J.R.C.	APPROVED BY: <i>[Signature]</i>
HOR. SCALE: 1:300 VERTICAL:	
1 TO RECORD DRAWING	11/92 AMU
NO REVISIONS	DATE BY

ENGINEER'S SEAL

CONSULTANT DRAWING NO. 41 13 0265 259 02

RECORD DRAWING P.D. No. 91-249

THE CITY OF WINNIPEG
 WORKS AND OPERATIONS DIVISION
 WATERWORKS, WASTE & DISPOSAL DEPARTMENT

WILKES RESERVOIR
 PHASE II CONSTRUCTION
 BUILDING ENVELOPE

CITY DRAWING NUMBER
 SHEET 2 OF 2
WIL-68

ROOF PLAN

FILE # RE 10527