

1 SITE PLAN  
N.T.S.

**AS-BUILT**  
DATE *2-14-89* BY *[Signature]*  
CHECKED BY *[Signature]*

NO	REVISIONS	DATE	BY
1	AS BUILT.	90/05	R.B.
0	ISSUED FOR TENDER	APR/89	CF
-	ISSUED FOR APPROVAL	FEB/89	CF


**Wardrop-MacLaren**  
ENGINEERING CONSULTANTS

DESIGNED BY C. F.  
DRAWN BY V. J. H.

CHECKED BY *[Signature]*  
APPROVED BY *[Signature]*

HOR SCALE  
VERTICAL

RELEASED FOR CONSTRUCTION  
*[Signature]*  
DATE 89 05 02

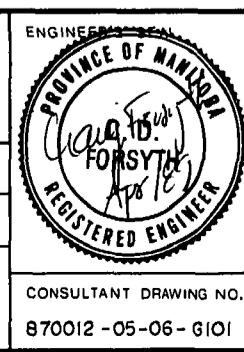

**THE CITY OF WINNIPEG**  
WORKS AND OPERATIONS DIVISION  
WATERWORKS, WASTE AND DISPOSAL DEPARTMENT

NORTH END WATER POLLUTION CONTROL CENTRE  
PRE-TREATMENT BUILDING — GENERAL

CITY DRAWING NUMBER  
SHEET OF  
NEP-1809

CONSULTANT DRAWING NO. 870012-05-06-6101

SITE PLAN