



**PLAN**  
WAYS & STREETS BUILDING  
SCALE 1/8" = 1'-0"


**NOTE**  
ALL INFRARED HEATERS LOCATED AT OUTSIDE WALL TO BE ANGLE MOUNTED AS SHOWN ON DETAIL DWG 2182-603

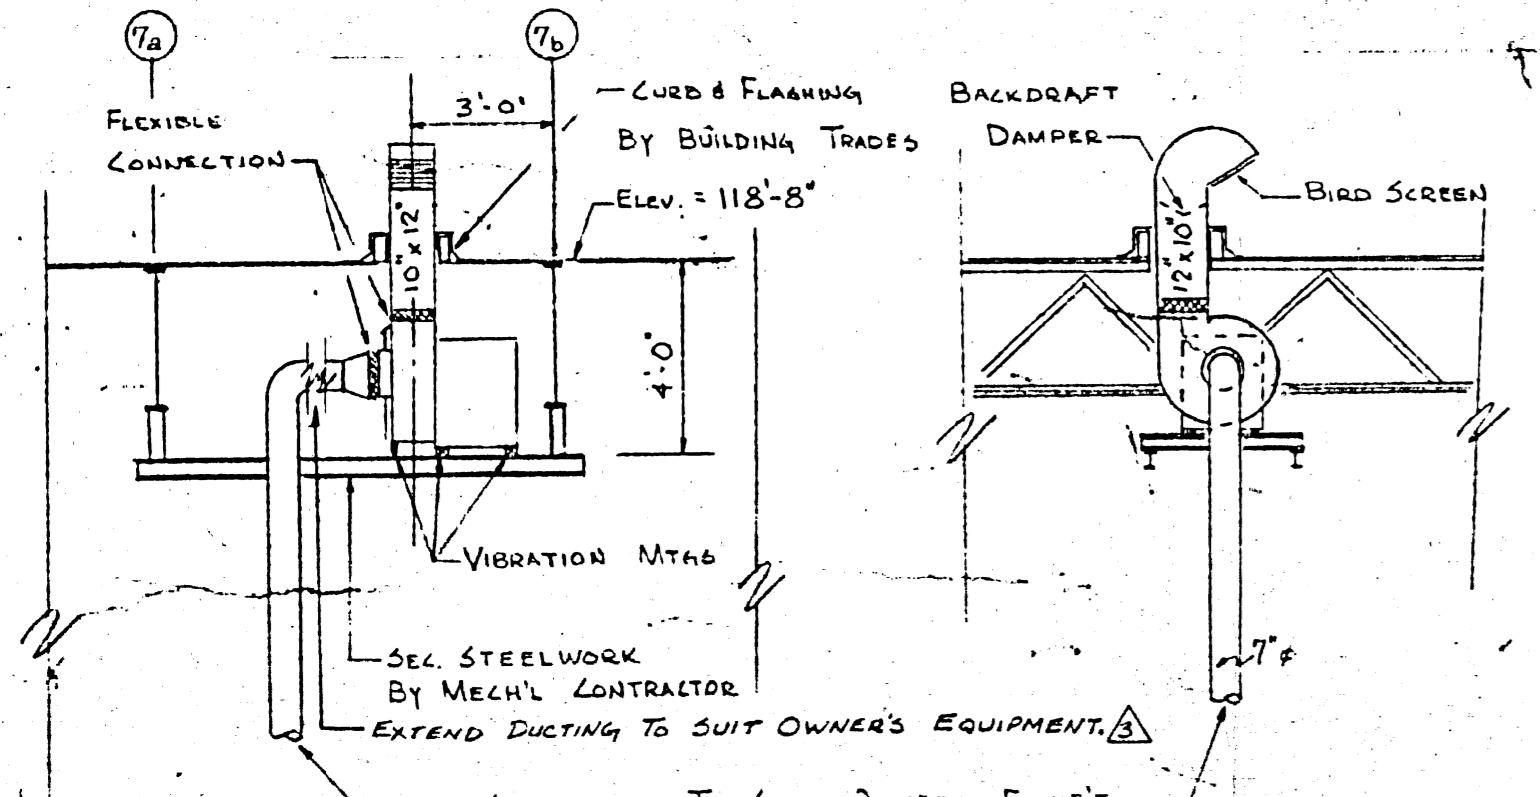


**ABRASIVE SAW VENTILATION**  
OVERHAUL & REPAIR BUILDING  
SCALE 1/4" = 1'-0"

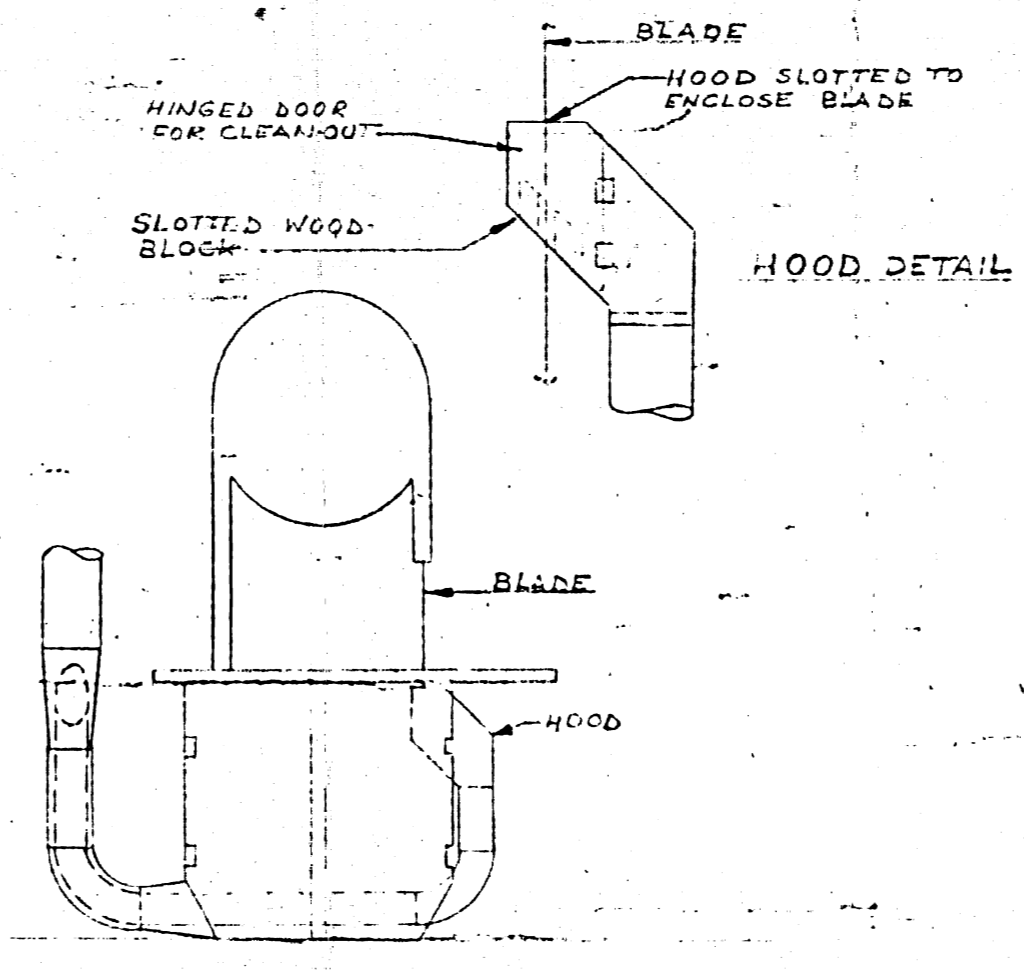


**BAND SAW EXHAUST DUCT**  
N.T.S.

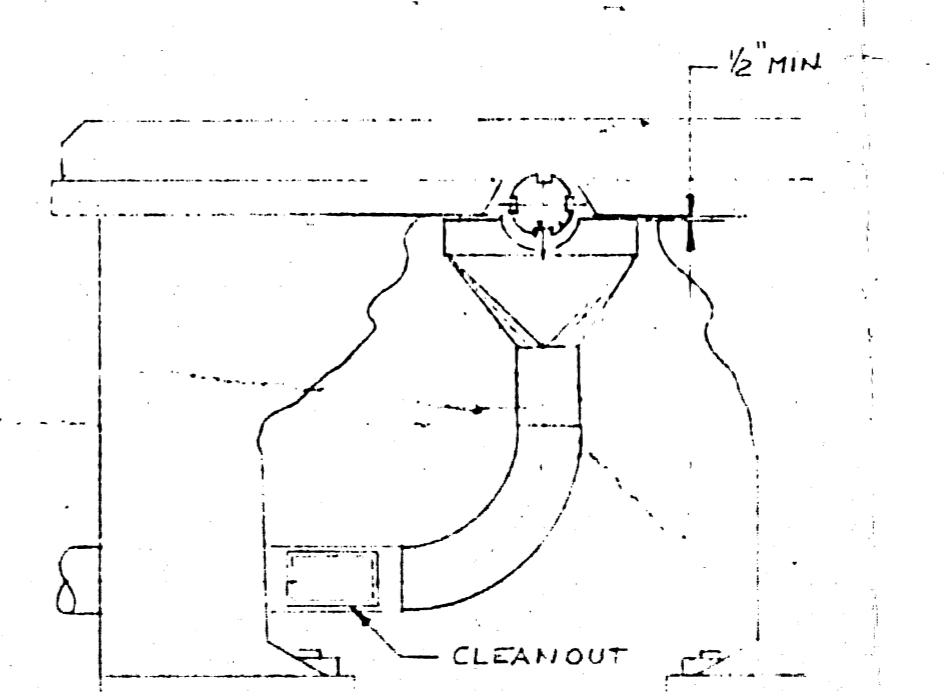

**TYPICAL PLANER EXHAUST DUCT**  
N.T.S.

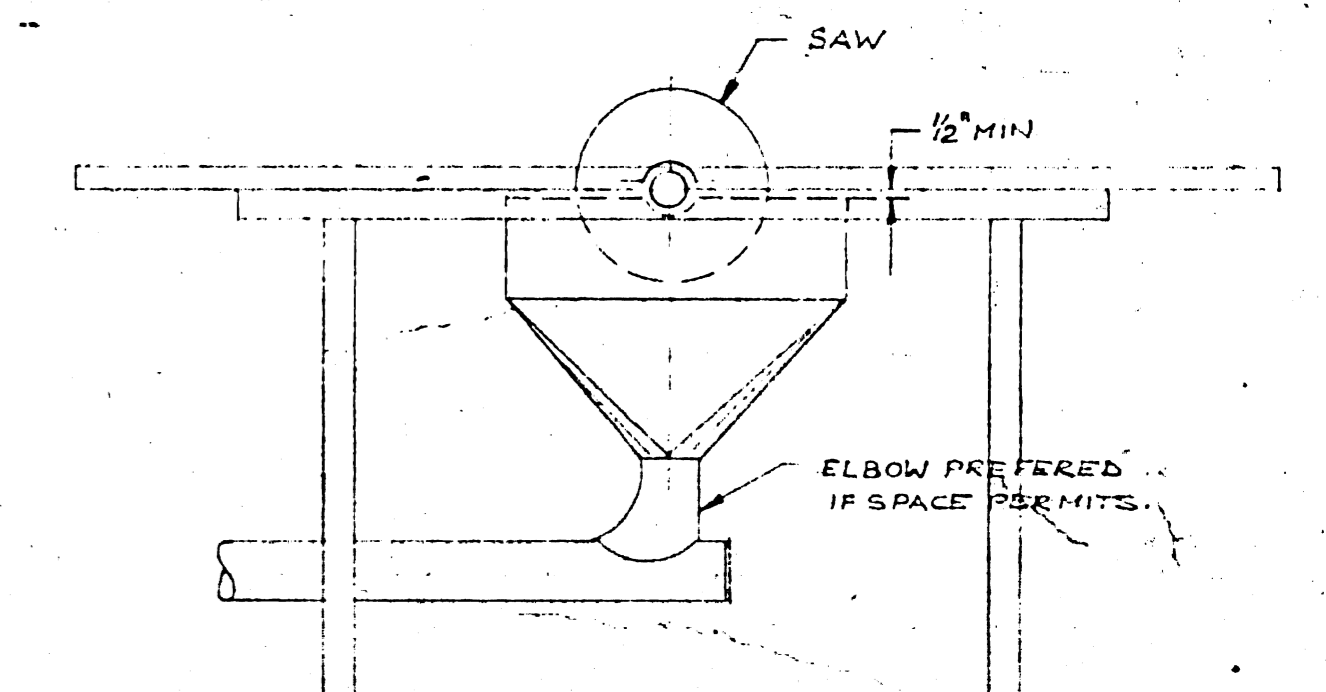


**TABLE SAW EXHAUST DUCT**  
N.T.S.

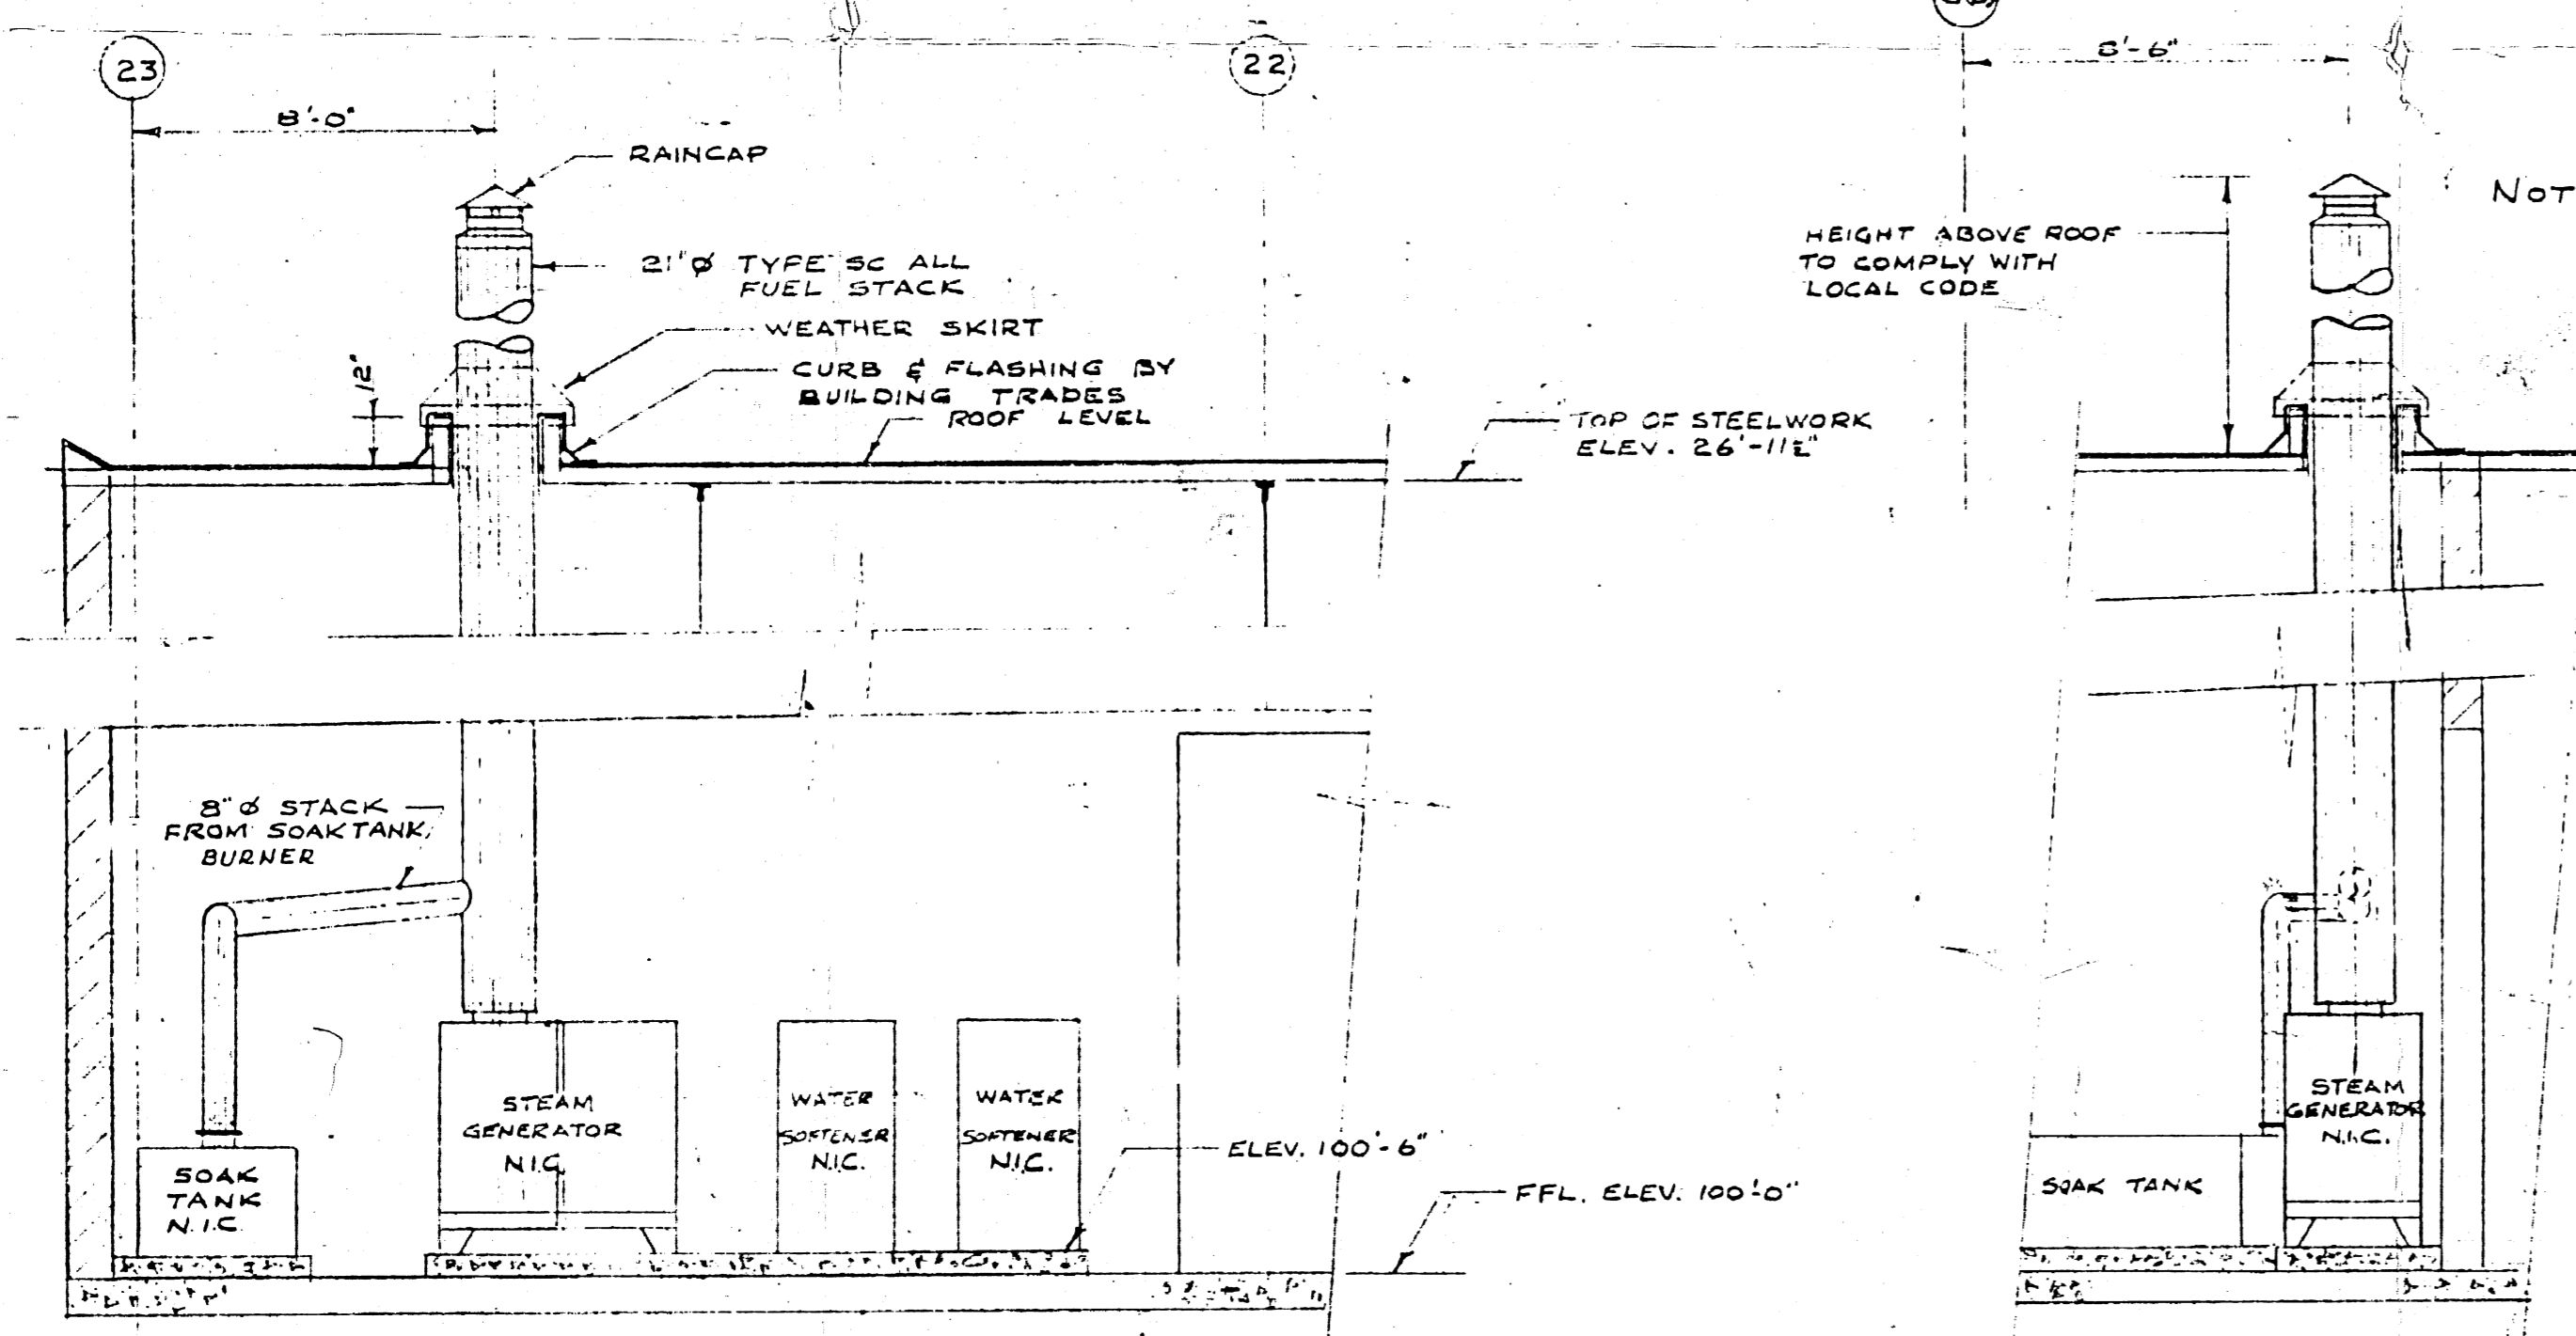


**EQUIPMENT IN DEGREASING ROOM**  
OVERHAUL & REPAIR BUILDING  
SCALE 1/2" = 1'-0"

**NOTE**  
FOR DETAILS OF STACK THROUGH ROOF SEE DWG No 2185-607

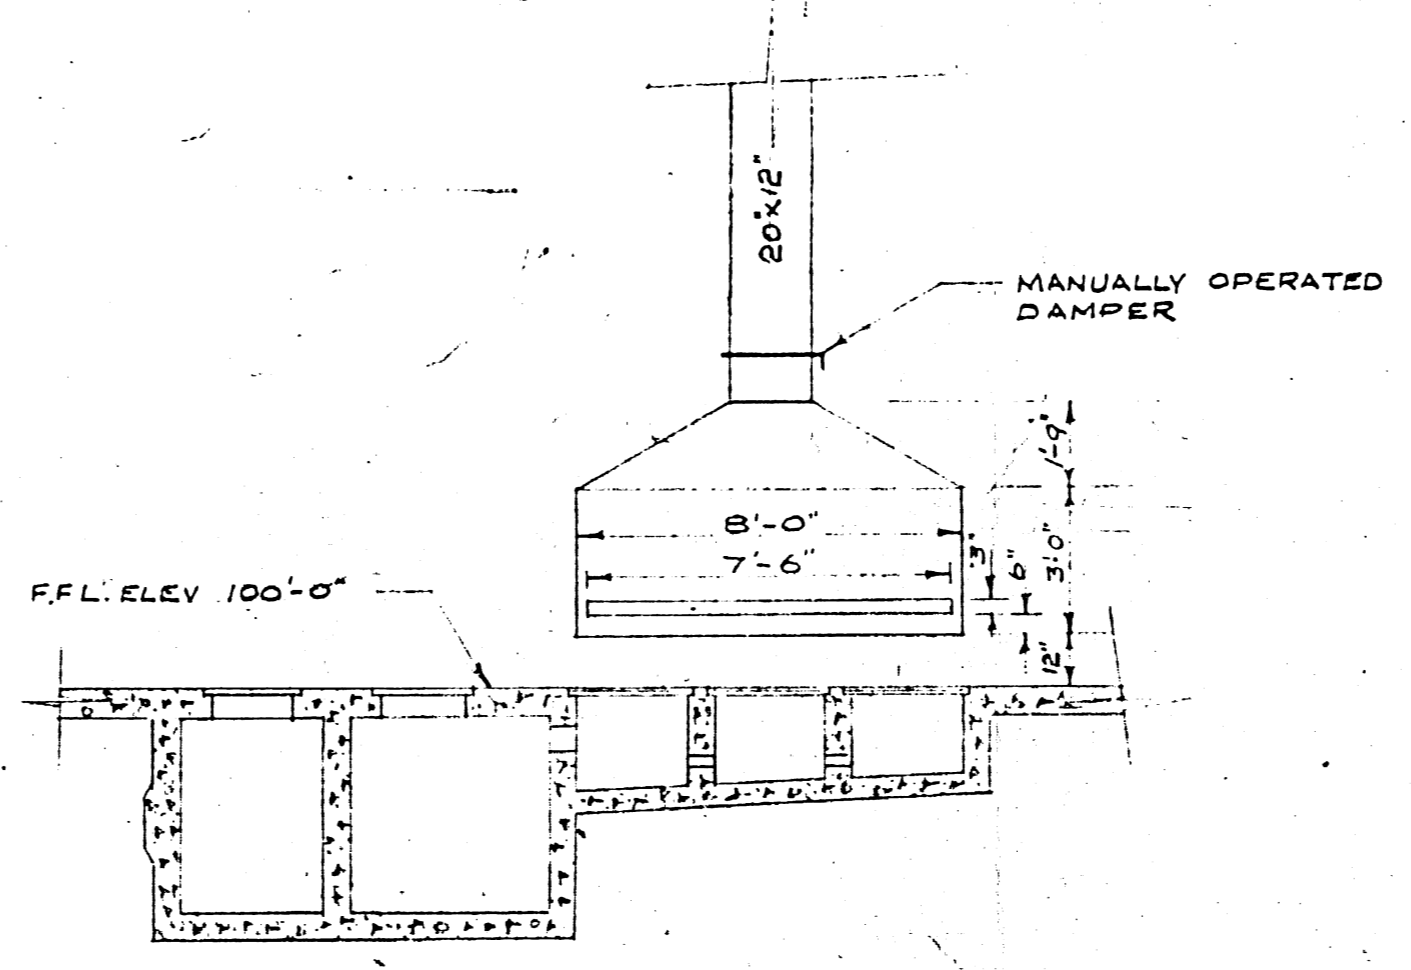


**LAYOUT OF FUME HOOD IN DEGREASING AREA**  
OVERHAUL & REPAIR BUILDING  
SCALE 1/4" = 1'-0"

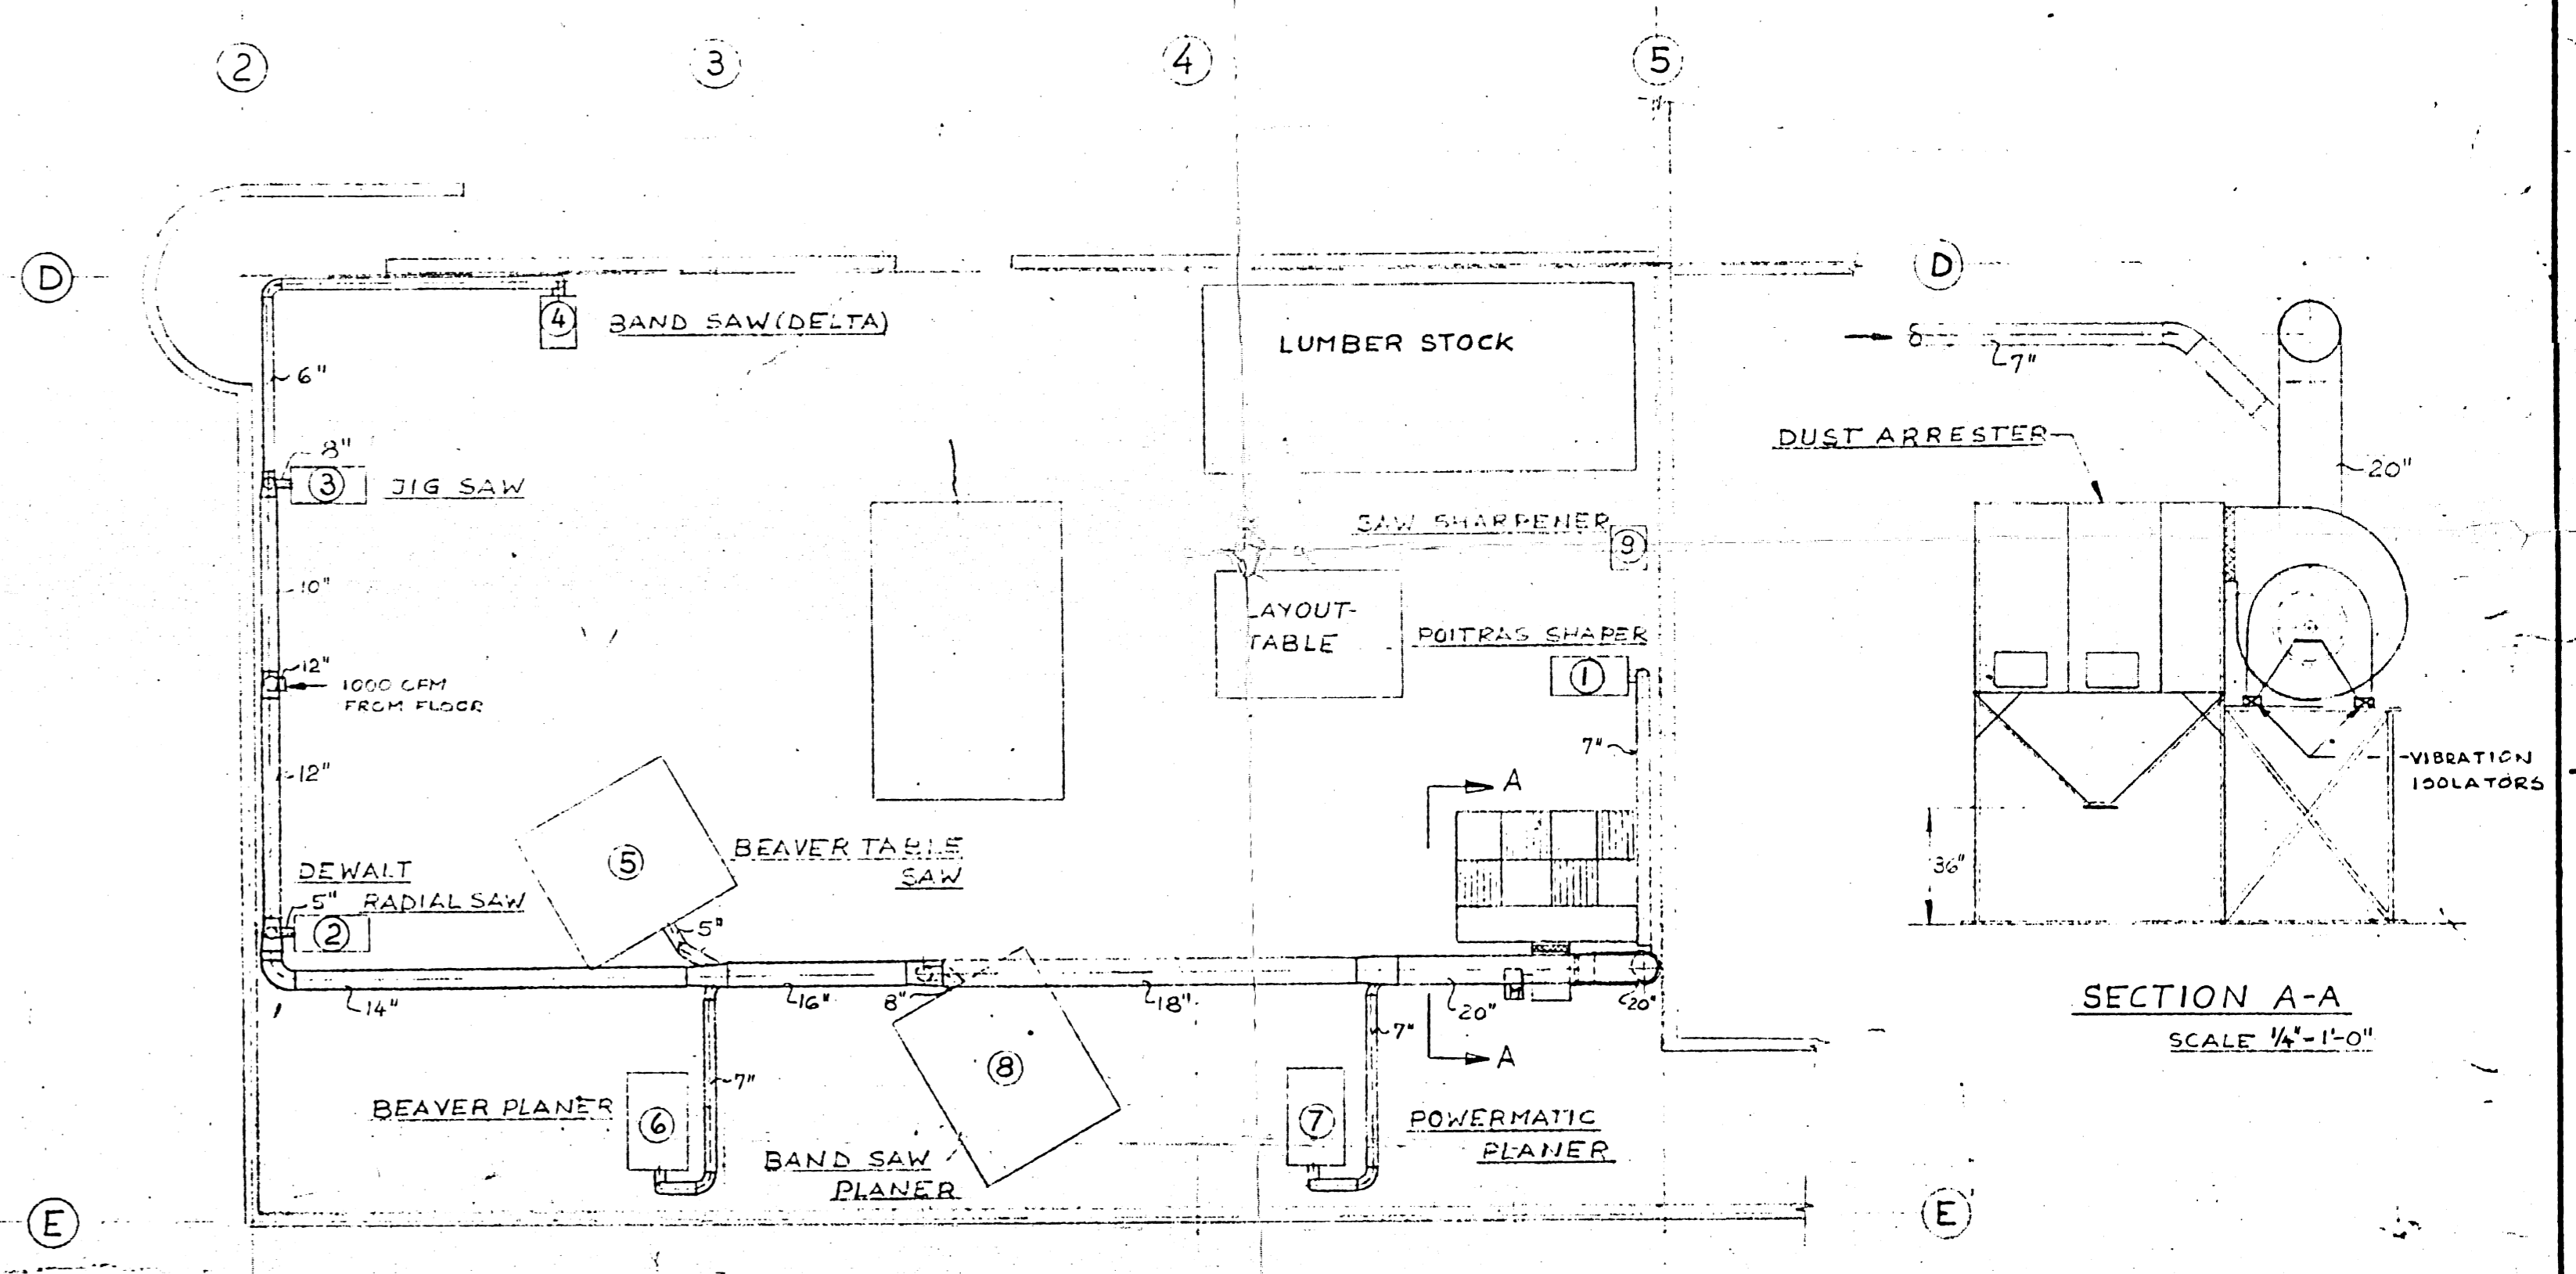

**DUST COLLECTION CARPENTER'S SHOP**

**SECTION A-A**  
SCALE 1/4" = 1'-0"

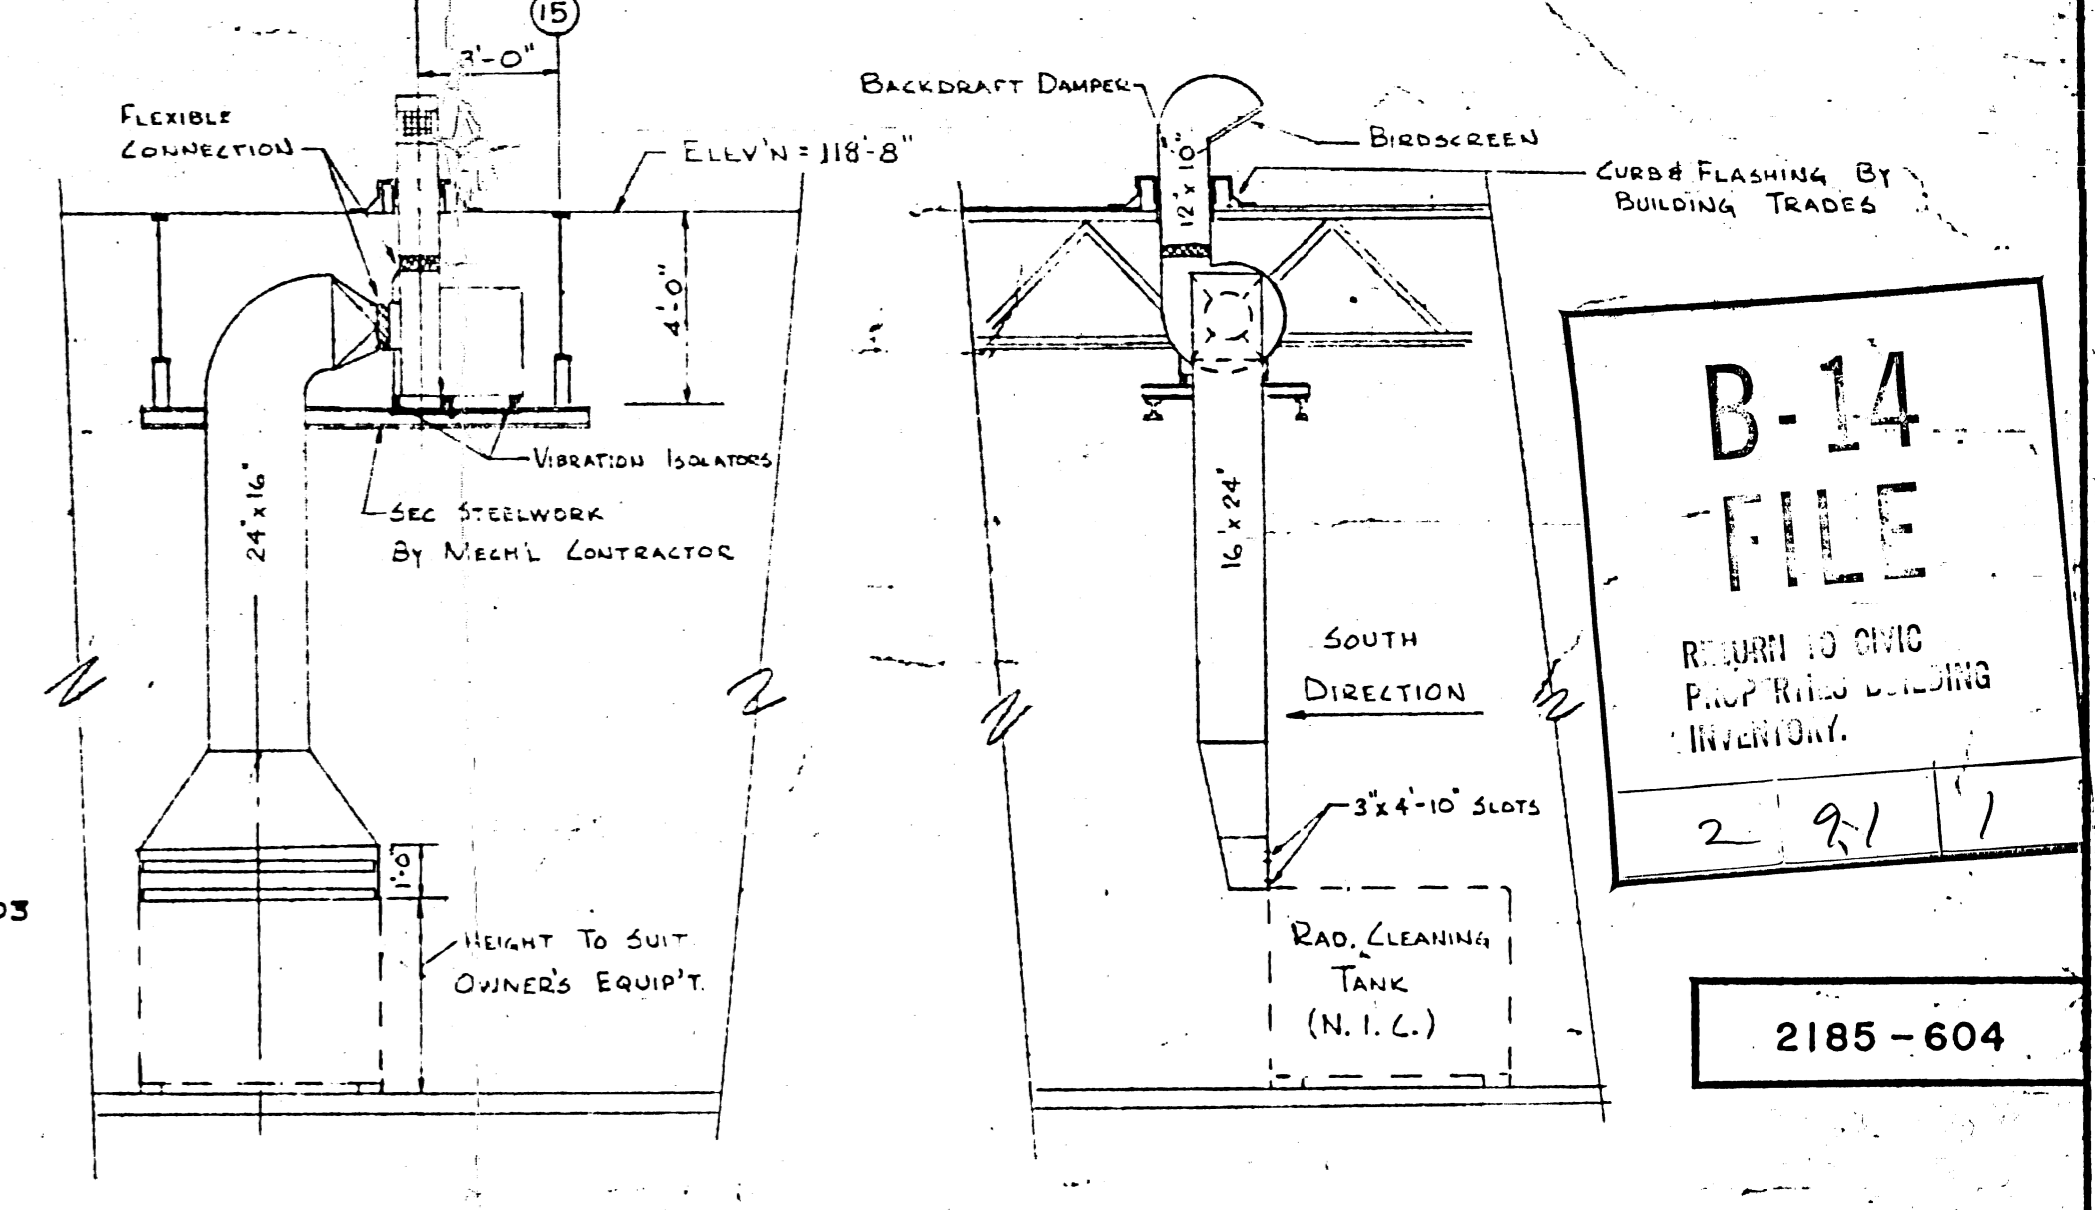

**RADIATOR CLEANING TANK VENTILATION SYSTEM**  
OVERHAUL & REPAIR BUILDING  
SCALE 1/4" = 1'-0"

**B-14 FILE**  
REVISION TO CHIC PLAN FOR VENTILATION  
2-9-77  
2185-604

DATE	ISSUE NO.	REV. NO.	DESCRIPTION	DRAWN BY
11-7-60	1		AS BUILT	R.M.C.
11-7-60	2		REVISED TO SUIT OWNER'S EQUIPMENT AND REQUIREMENTS	17E
11-9-60	3		REVISED AS PER NOTICE OF PROPOSED CHANGE NO. 38	17E
2/15/68	4		REVISED AS PER ADDENDA 1 TO 5; FOR CONSTRUCTION	W.D.K.
12/1/68	5		FOR TENDER	
12/1/68	6		FOR APPROVAL	

ISSUE OR REVISION		
METROPOLITAN CORPORATION OF GREATER WINNIPEG STREETS AND TRANSIT DIVISION		
TRANSIT STORAGE AND SHOP FACILITIES		
WAYS & STREETS FACILITIES BUILDING		
HEATING & VENTILATING - PLAN & DETAILS		
CONSULTING PROFESSIONAL ENGINEERS A. D. MARGISON & ASSOCIATES LIMITED 1155 LESLIE STREET, DON MILLS, ONTARIO		ARCHITECTS Walman Ross & Blankstein Coop Gillmor Hanna 10 DONALD STREET, WINNIPEG, MANITOBA
APPROVED <i>[Signature]</i> SENIOR ENGINEER OF STREETS AND TRANSIT	DRAWN BY <i>[Signature]</i> H.T.T.	DATE AUGUST '67
LICENSED TO PRACTICE IN THE PROVINCE OF MANITOBA My License Expires 10-JUN-1967		SCALE AS SHOWN
PROJECT NO. 2185-604		DRAWN BY MECHANICAL