



NOTES:
SEE DRAWING M0001 FOR LEGEND

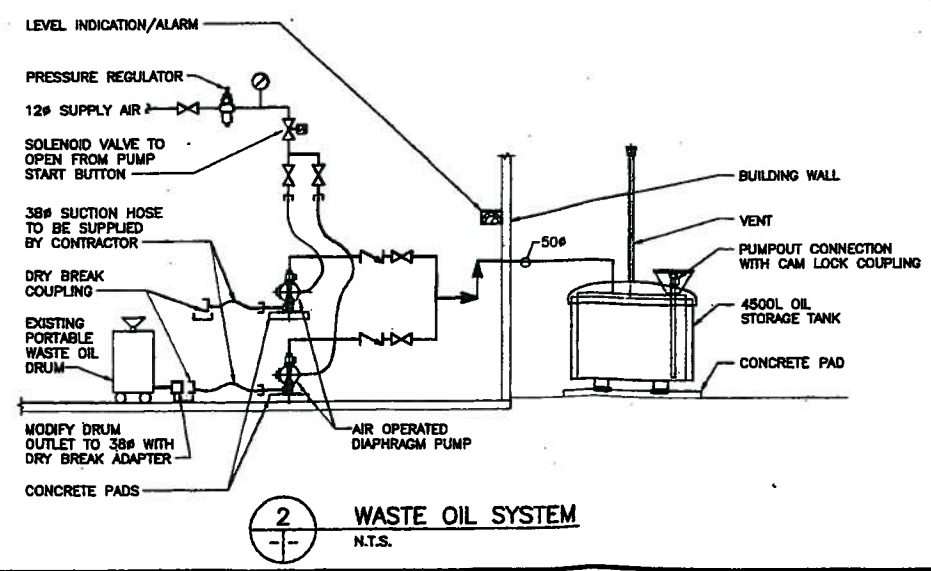

J.A. Robinson Pump Service Ltd.
APPROVED
By: *J. Hode* Date: Nov. 24/08
As Built Drawing: This drawing has been revised to show mechanical system as installed.

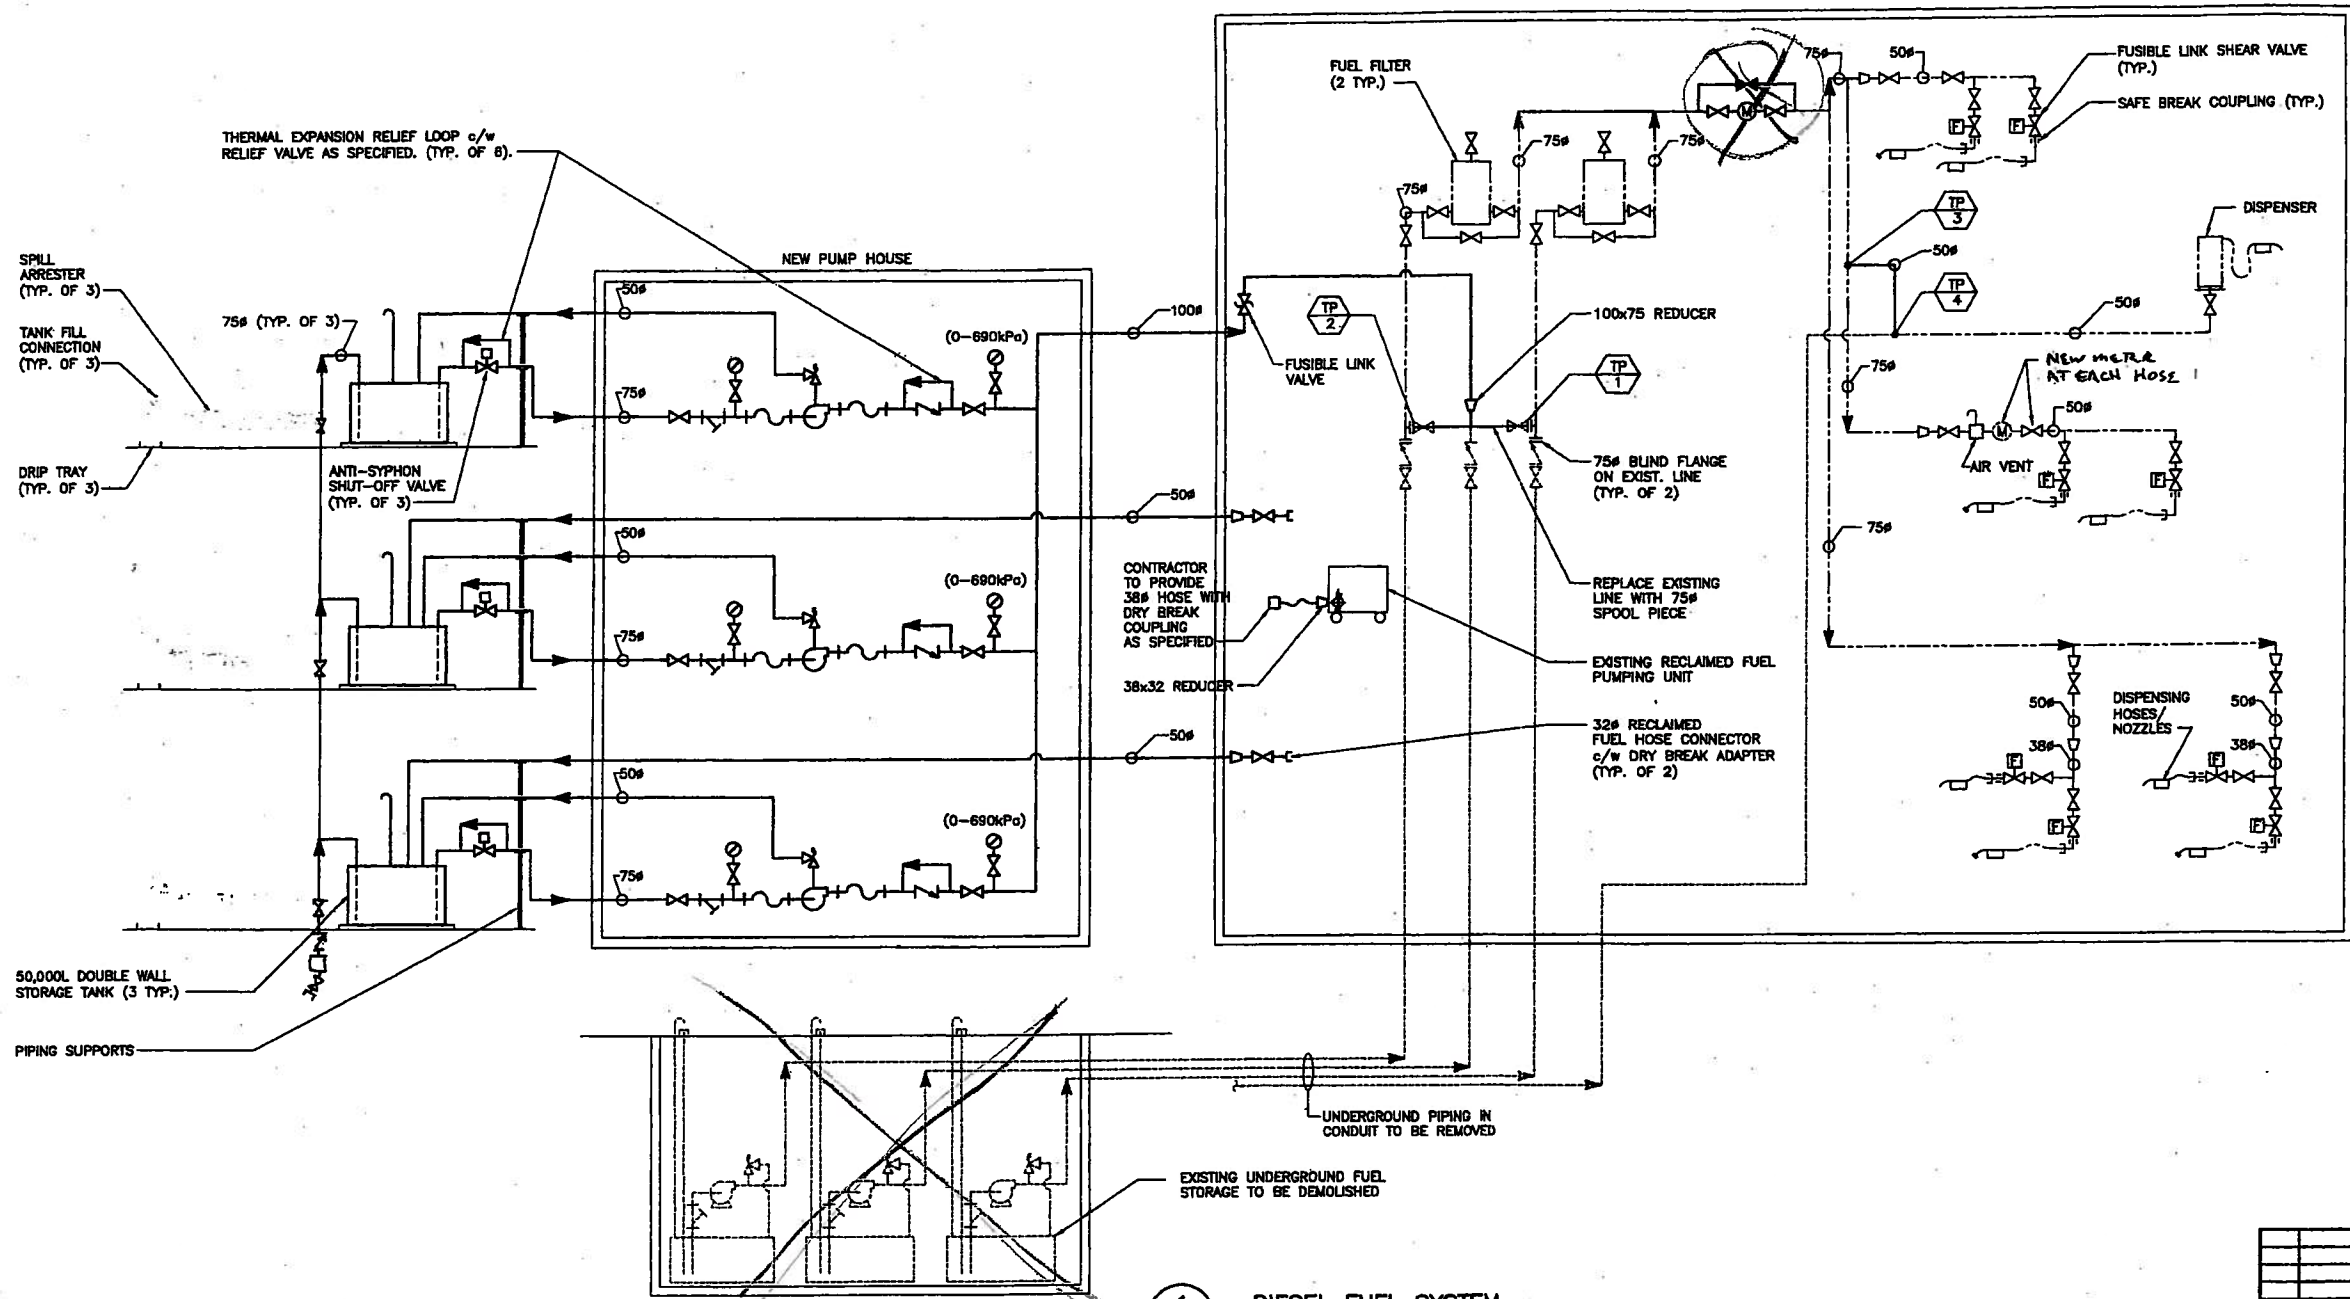

0	ISSUED FOR TENDER	07.04.08	LWS
NO.	DESCRIPTION	DATE	ISSUED BY
REVISIONS/ISSUE			
<small>THE CONTENT OF THIS DOCUMENT IS NOT INTENDED FOR THE USE OF, NOR IS IT DESIGNED TO BE RELIED UPON BY ANY PERSON, FIRM OR CORPORATION OTHER THAN THE CLIENT AND WARDROP ENGINEERING INC. WARDROP ENGINEERING DOES NOT WARRANT, GUARANTEE OR MAKE ANY REPRESENTATION FOR DAMAGES OR INJURY SUFFERED BY SUCH THIRD PARTY ARISING FROM USE OF THIS DOCUMENT OR FROM THE EXERCISE THEREOF WITHOUT THE WRITTEN AUTHORITY OF WARDROP ENGINEERING AND OUR CLIENT. THIS DOCUMENT IS SUBJECT TO FURTHER RESTRICTIONS IMPOSED BY THE CONTRACT BETWEEN THE CLIENT AND WARDROP ENGINEERING INC AND THESE RESTRICTIONS MUST BE SOUGHT REGARDING THIS DOCUMENT IN ALL OTHER CIRCUMSTANCES.</small>			
CLIENT			
CITY OF WINNIPEG TRANSIT DEPARTMENT			
WARDROP Engineering Inc.			
PROJECT NAME			
PETROLEUM STORAGE AND HANDLING SYSTEMS REPLACEMENT			
DRAWING DESCRIPTION			
OSBORNE STREET GARAGE MECHANICAL - DIESEL FUEL AND WASTE OIL FLOW SCHEMATICS			
DESIGNED BY:	DRAWN BY:	CHECKED BY:	
L.S.	D.D.		
APPROVED BY:			
SCALE:	AS NOTED	DATE:	07.01.16
DRAWING NO.		REV.	
0729720100-DWG-M0003		0	