




TYPICAL CROSS SECTION (1) 42/43

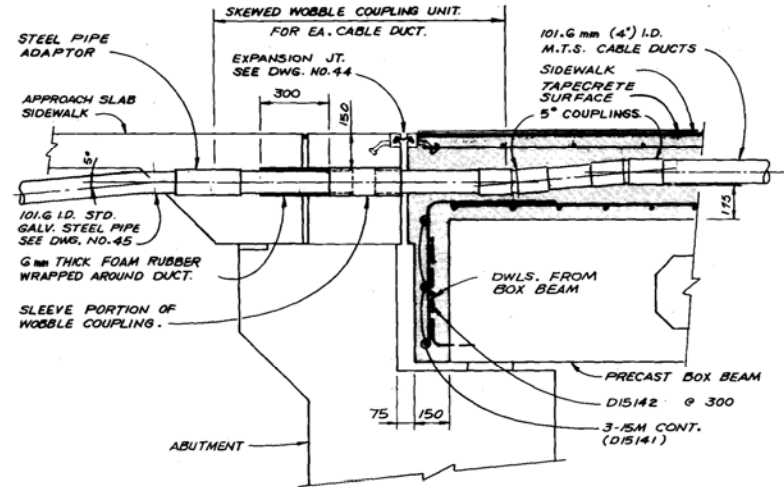


SECTION (2) 42/43

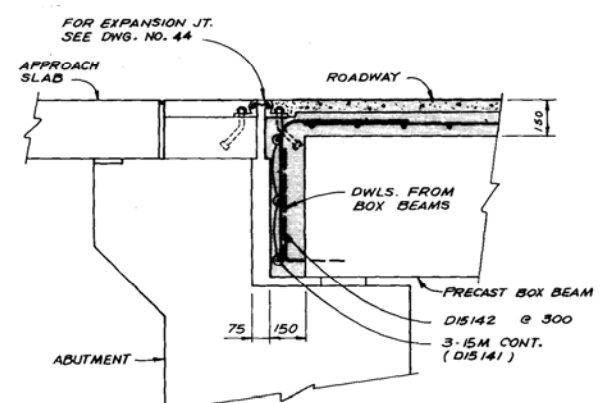


SECTION (3) 42/43

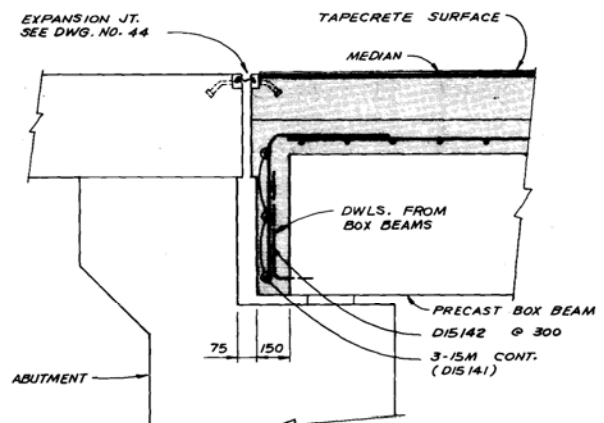


SECTION (4) 42/43

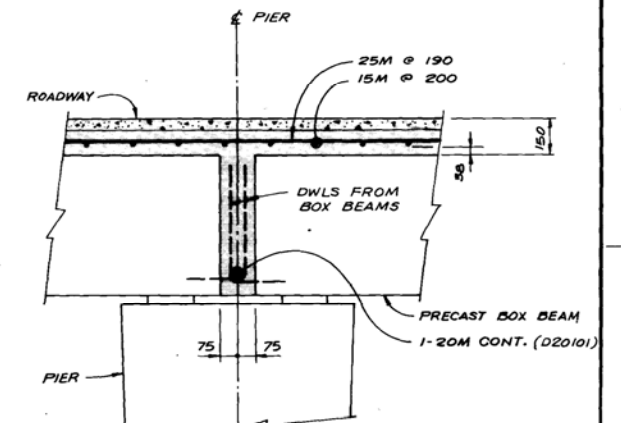


SECTION (5) 42/43

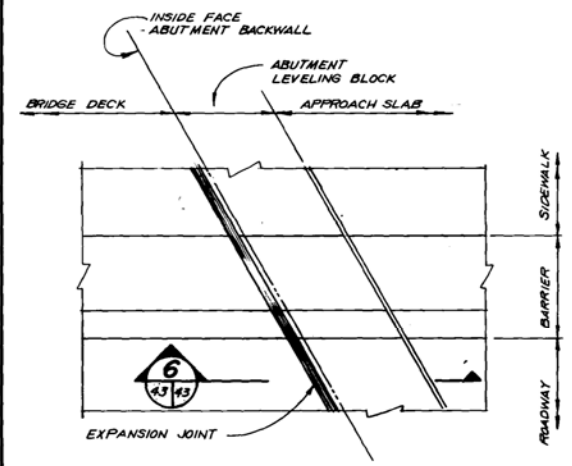

DETAIL (A) 42/43

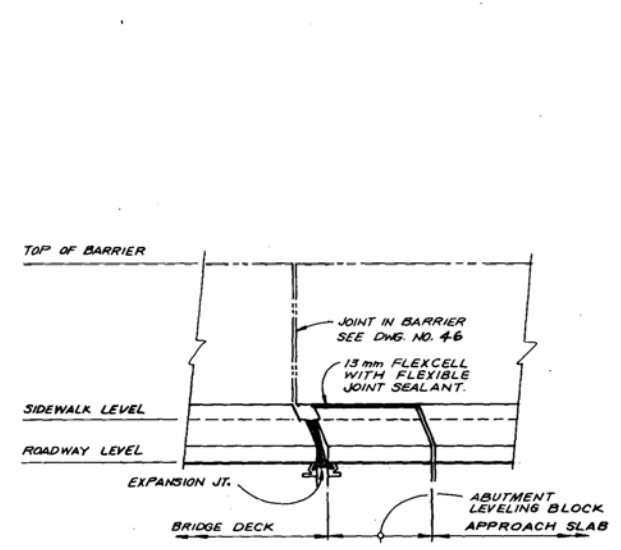


ELEVATION (6) 43/45

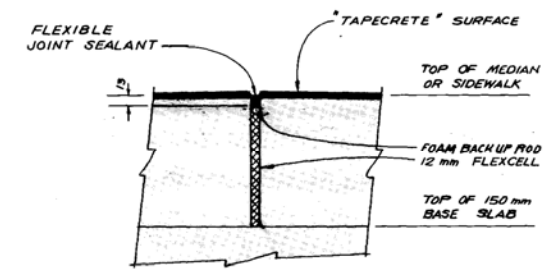

TYPICAL CONTROL JOINT IN MEDIAN OR SIDEWALK
DETAIL (B) 42/43
SCALE 1:5

DESIGNED BY	F.A.K.	DRAWN BY	W.P.S.
CHECKED BY	L.D.M.	DATE	80-08-25
APPROVED BY	DATE 23/9/80		
NO.	REVISIONS	DATE	APP.

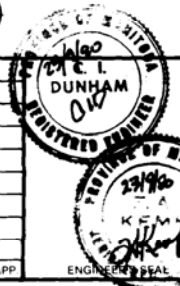

AS BUILT
APPROVED BY: *[Signature]*

B-5429

STURGEON CREEK BRIDGE ON PORTAGE AVENUE
NORTH STRUCTURE DECK DETAILS

SCALE: 1:15 UNLESS NOTED
DRAWING NO: B178-80-43
PROJ. NO. M.M.D. 7580-02 NS-14