


SEE DRAWING WS-M0404 FOR CONTAINMENT DETAILS

SEE DRAWING WS-M0453 FOR SPILL CONTAINMENT DETAILS

NOTES:
1. SEE STRUCTURAL DRAWINGS FOR PIPING TRENCH DETAILS.

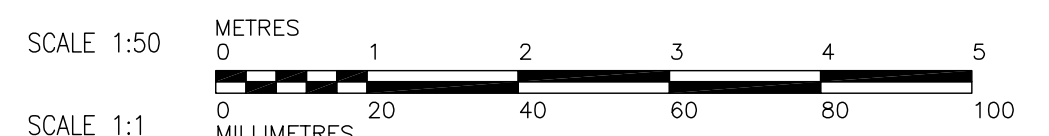

AECOM
As of January 3, 2009, EarthTech became AECOM Canada Ltd.

AECOM AS-CONSTRUCTED
SIG. _____ DATE _____

AECOM
Certificate of Authorization
AECOM Canada Ltd.
Original dated on: No. 4671 Date: 2007/01/31

B.M. ELEV.			
DESIGNED BY	SBW	CHECKED BY	SRB
DRAWN BY	JBC	APPROVED BY	AHL
SCALE:	1:50	RELEASED FOR CONSTRUCTION BY:	R. SOROKOWSKI
NO. REVISIONS	DATE	BY	DATE
02	AS CONSTRUCTED	2009/07/03	GLG
01	ISSUED FOR CONSTRUCTION	07/05/25	LAE
00	ISSUED FOR TENDER	07/01/31	JBC
2006/03/15			
2007/01/31			

CH2M HILL
Frederickson Cooper ARCHITECTS

EarthTech

ENGINEER'S SEAL
ORIGINAL SIGNED BY
S.B. WILLIAMSON
2007/01/31

CONSULTANT DRAWING NO.
WS-M0112

THE CITY OF WINNIPEG
WATER AND WASTE DEPARTMENT
ENGINEERING DIVISION

WATER TREATMENT PLANT
BULK CHEMICAL BUILDING
SODIUM HYPOCHLORITE AND CHEMICAL STORAGE BUILDING

CITY FILE NUMBER
SHEET OF
CITY DRAWING NUMBER
1-0601S-M0043-003-02

PROCESS MECHANICAL
GROUND FLOOR PLAN
SHEET 3 OF 3