




REF. or DRAWING NO. **SWD-D-197**
 DETAILS FILE NO. *SW 10366*

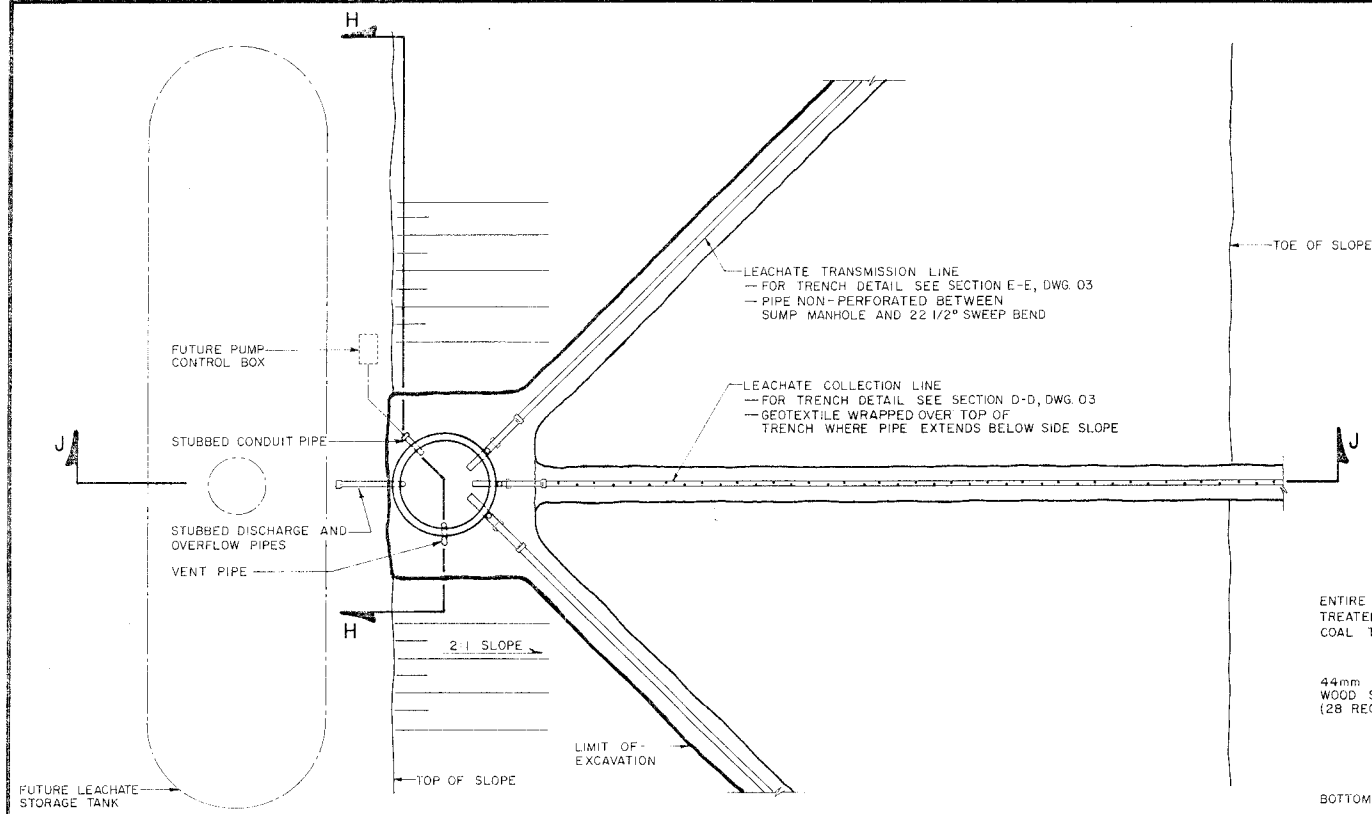


PLAN VIEW - LEACHATE COLLECTION SUMP MANHOLE
SCALE 1:50

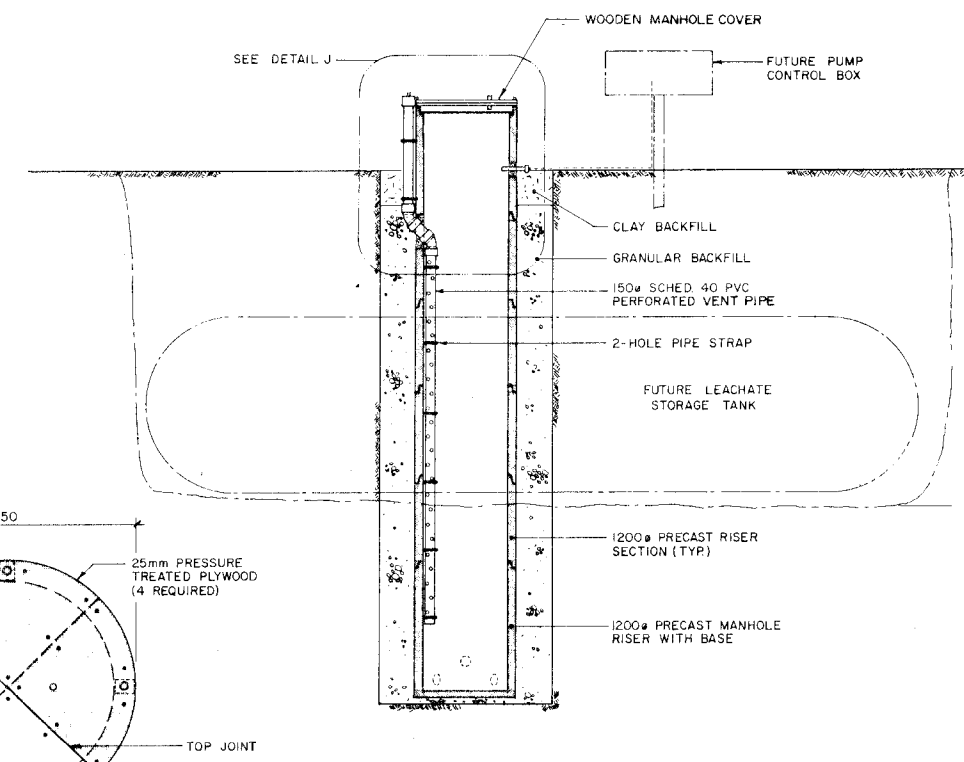


SECTION H-H
SCALE 1:50

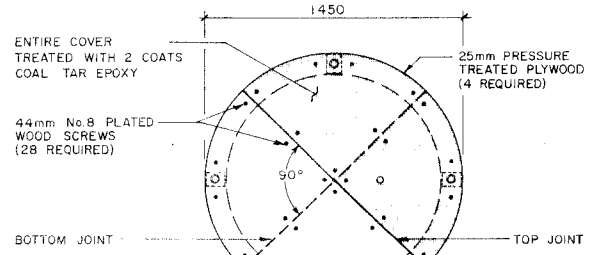


DETAIL K
SCALE 1:20

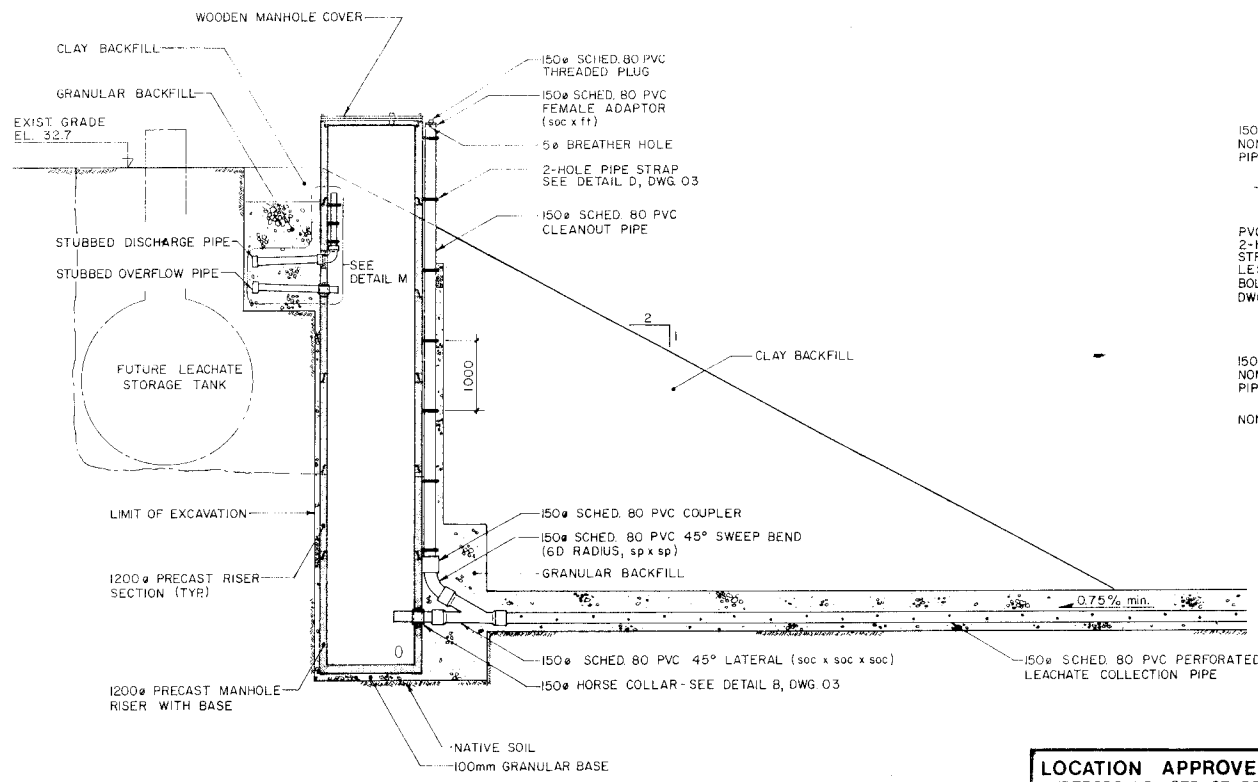


SECTION J-J
SCALE 1:50

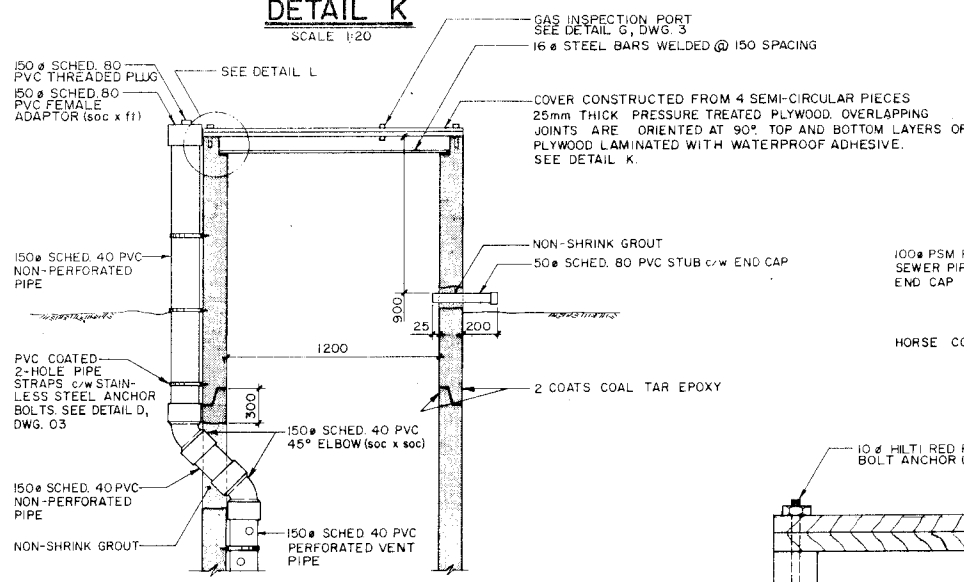

DETAIL J
SCALE 1:20

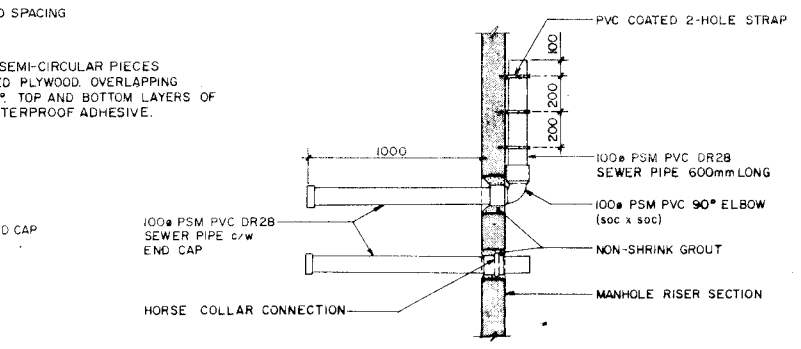


DETAIL M
SCALE 1:20

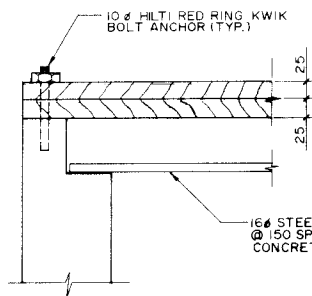

DETAIL L
SCALE 1:20

METRIC
WHOLE NUMBERS INDICATE MILLIMETRES
DECIMALIZED NUMBERS INDICATE METRES

RECORD DRAWING

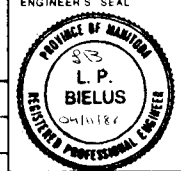LOCATION APPROVED UNDERGROUND STRUCTURES SUPPLY STRUCTURES COMMITTEE DATE _____ NOTE: LOCATION OF UNDERGROUND STRUCTURES AS SHOWN ARE BASED ON THE BEST INFORMATION AVAILABLE BUT NO GUARANTEE IS GIVEN THAT ALL EXISTING UTILITIES ARE SHOWN OR THAT THE GIVEN LOCATIONS ARE EXACT. CONFIRMATION OF EXISTENCE AND EXACT LOCATION OF ALL SERVICES MUST BE OBTAINED FROM THE INDIVIDUAL UTILITIES BEFORE PROCEEDING WITH CONSTRUCTION.		UMA Engineering Ltd. Engineers & Planners 1478 Buffalo Place, Winnipeg, Manitoba, Canada R2T 1L7		ENGINEER'S SEAL 		THE CITY OF WINNIPEG WATERWORKS, WASTE & DISPOSAL DEPARTMENT	
DESIGNED BY K.M.S. DRAWN BY D.M.L. HOR. SCALE AS NOTED VERTICAL AS NOTED		CHECKED BY L.B. APPROVED BY _____ RELEASED FOR CONSTRUCTION DATE _____		CONSULTANT DRAWING NO. 0265-230-15-72		BRADY ROAD LANDFILL EXPANSION LEACHATE COLLECTION SUMP MANHOLE AND STORAGE TANK DETAILS	
A REVISIIONS NO. _____ DATE _____ BY _____		DATE NOV. 4, 1988		CITY DRAWING NUMBER SWD-D-197		SHEET 4 OF 4	

10366