


**RESERVOIR PLAN**

MICROFILMED JUN 1982  
**RECORD DRAWING**

**METRIC NOTES**  
 WHOLE NUMBERS IND. MILLIMETRES  
 DECIMALIZED EXPRESSIONS IND. METRES

NO.	REVISIONS	DATE	APP.
2	RECORD DRAWING	NOV 20 1981	EEL
1	CONSTRUCTION CHANGES	MAR 20 1980	EEL

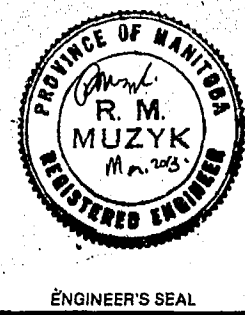

**Underwood McLellan Ltd.**  
 Consulting Engineers and Planners

DESIGNED BY: R.M.M. DRAWN BY: R.B.T.  
 CHECKED BY: DATE: MARCH 20, 1980  
 APPROVED BY: DATE: 20/3/80

**THE CITY OF WINNIPEG**  
 WORKS & OPERATIONS DEPARTMENT  
**WATERWORKS, WASTE & DISPOSAL DIVISION**

**WILKES AVENUE RESERVOIR RECONSTRUCTION**  
 GENERAL ARRANGEMENT

RELEASED FOR CONSTRUCTION: DATE: 20/03/80  
 SCALE: 1:500  
 DRAWING NO: **WIL-3**