


SECTION 1
4/3

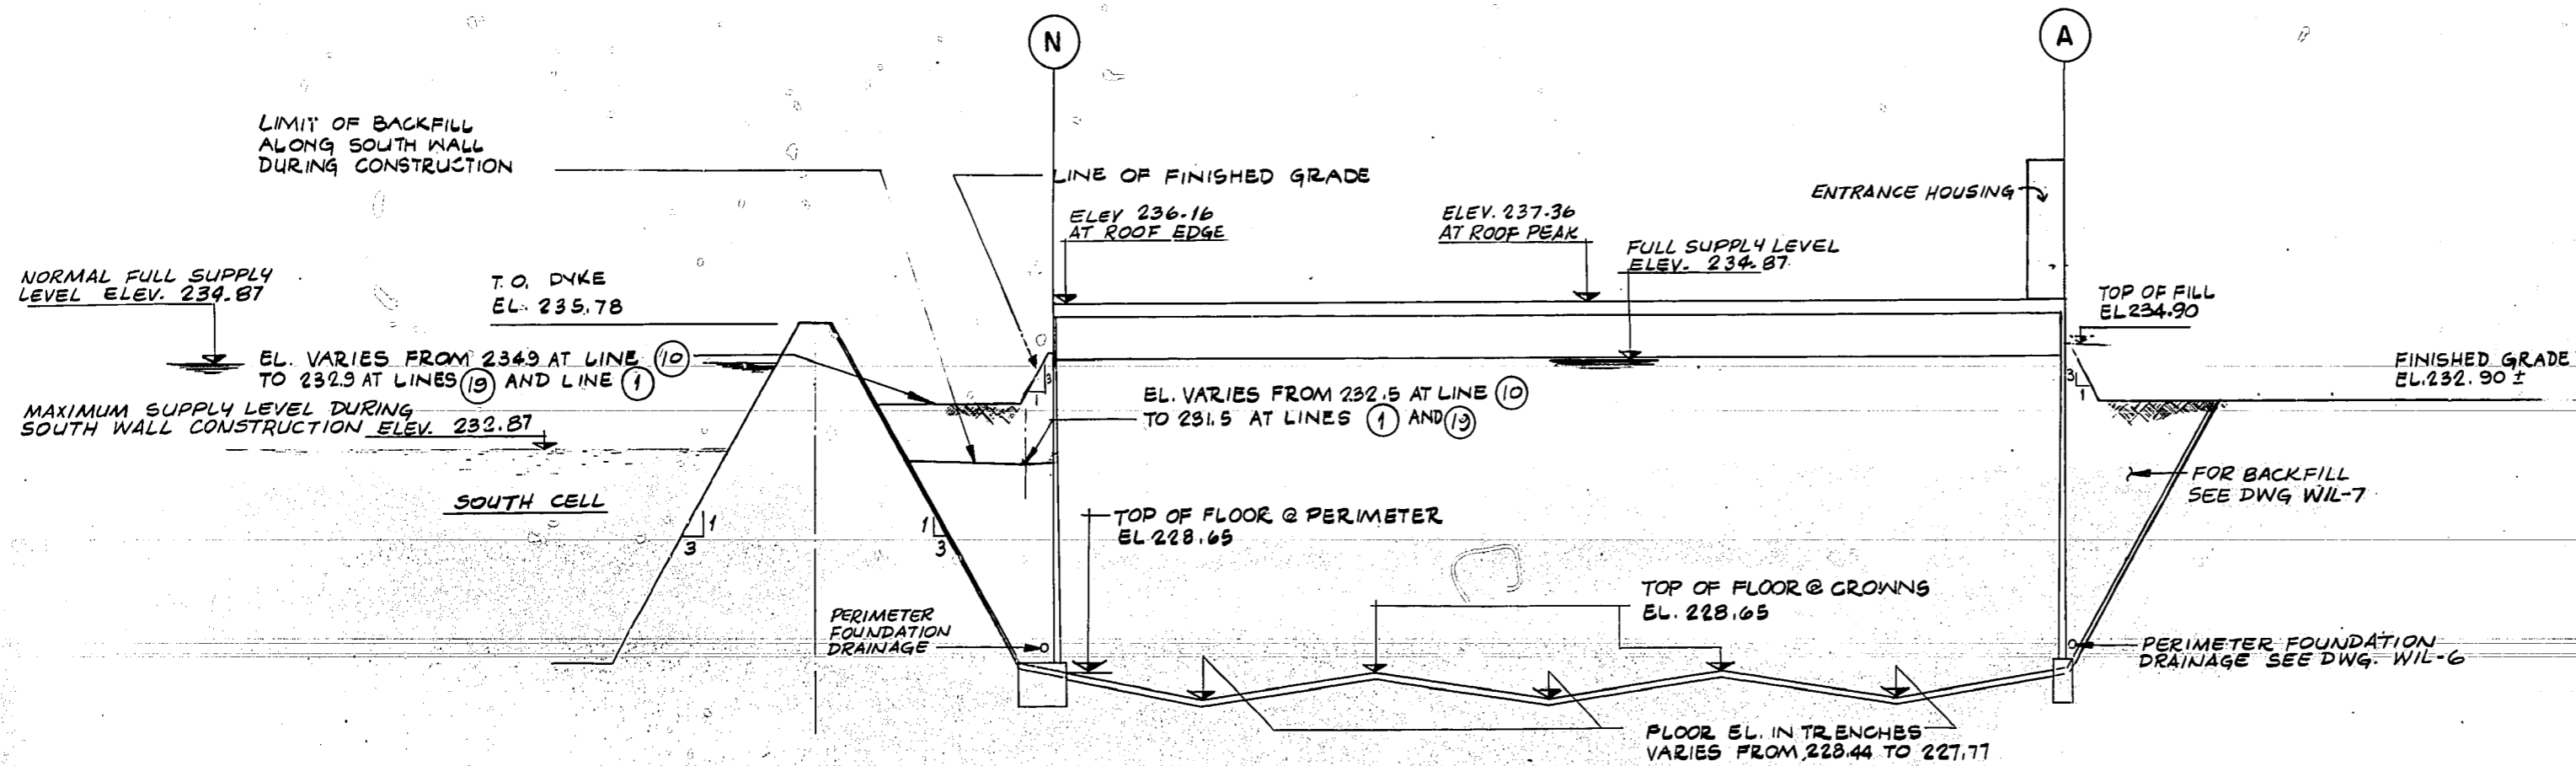

SECTION 2
4/3

MICROFILMED

RECORD DRAWING

METRIC NOTES
WHOLE NUMBERS IND. MILLIMETRES
DECIMALIZED EXPRESSIONS IND. METRES

NO.	REVISIONS	DATE	APP.
2	RECORD DRWG.	NOV 25 1980	RMM
1	CONST. RECORD CHANGES	MAR 20 1980	R.B.T.



Underwood McLellan Ltd.
Consulting Engineers and Planners

DESIGNED BY: RMM
DRAWN BY: R.B.T.
CHECKED BY: [Signature]
DATE: MARCH 20, 1980
APPROVED BY: [Signature]
DATE: 20/3/80

THE CITY OF WINNIPEG
WORKS & OPERATIONS DEPARTMENT
WATERWORKS, WASTE & DISPOSAL DIVISION

WILKES AVENUE RESERVOIR RECONSTRUCTION
GENERAL SECTIONS

RELEASED FOR CONSTRUCTION DATE: 20/03/80

SCALE: 1:500 HORZ.
1:100 VERT.

DRAWING NO: **WIL-4** REV 2