



421 DEBORNE ST. SHOP FACILITIES
 DRAWING NO. 2185-702
 PART FLOOR PLAN - GARAGE NORTH - LIGHTING

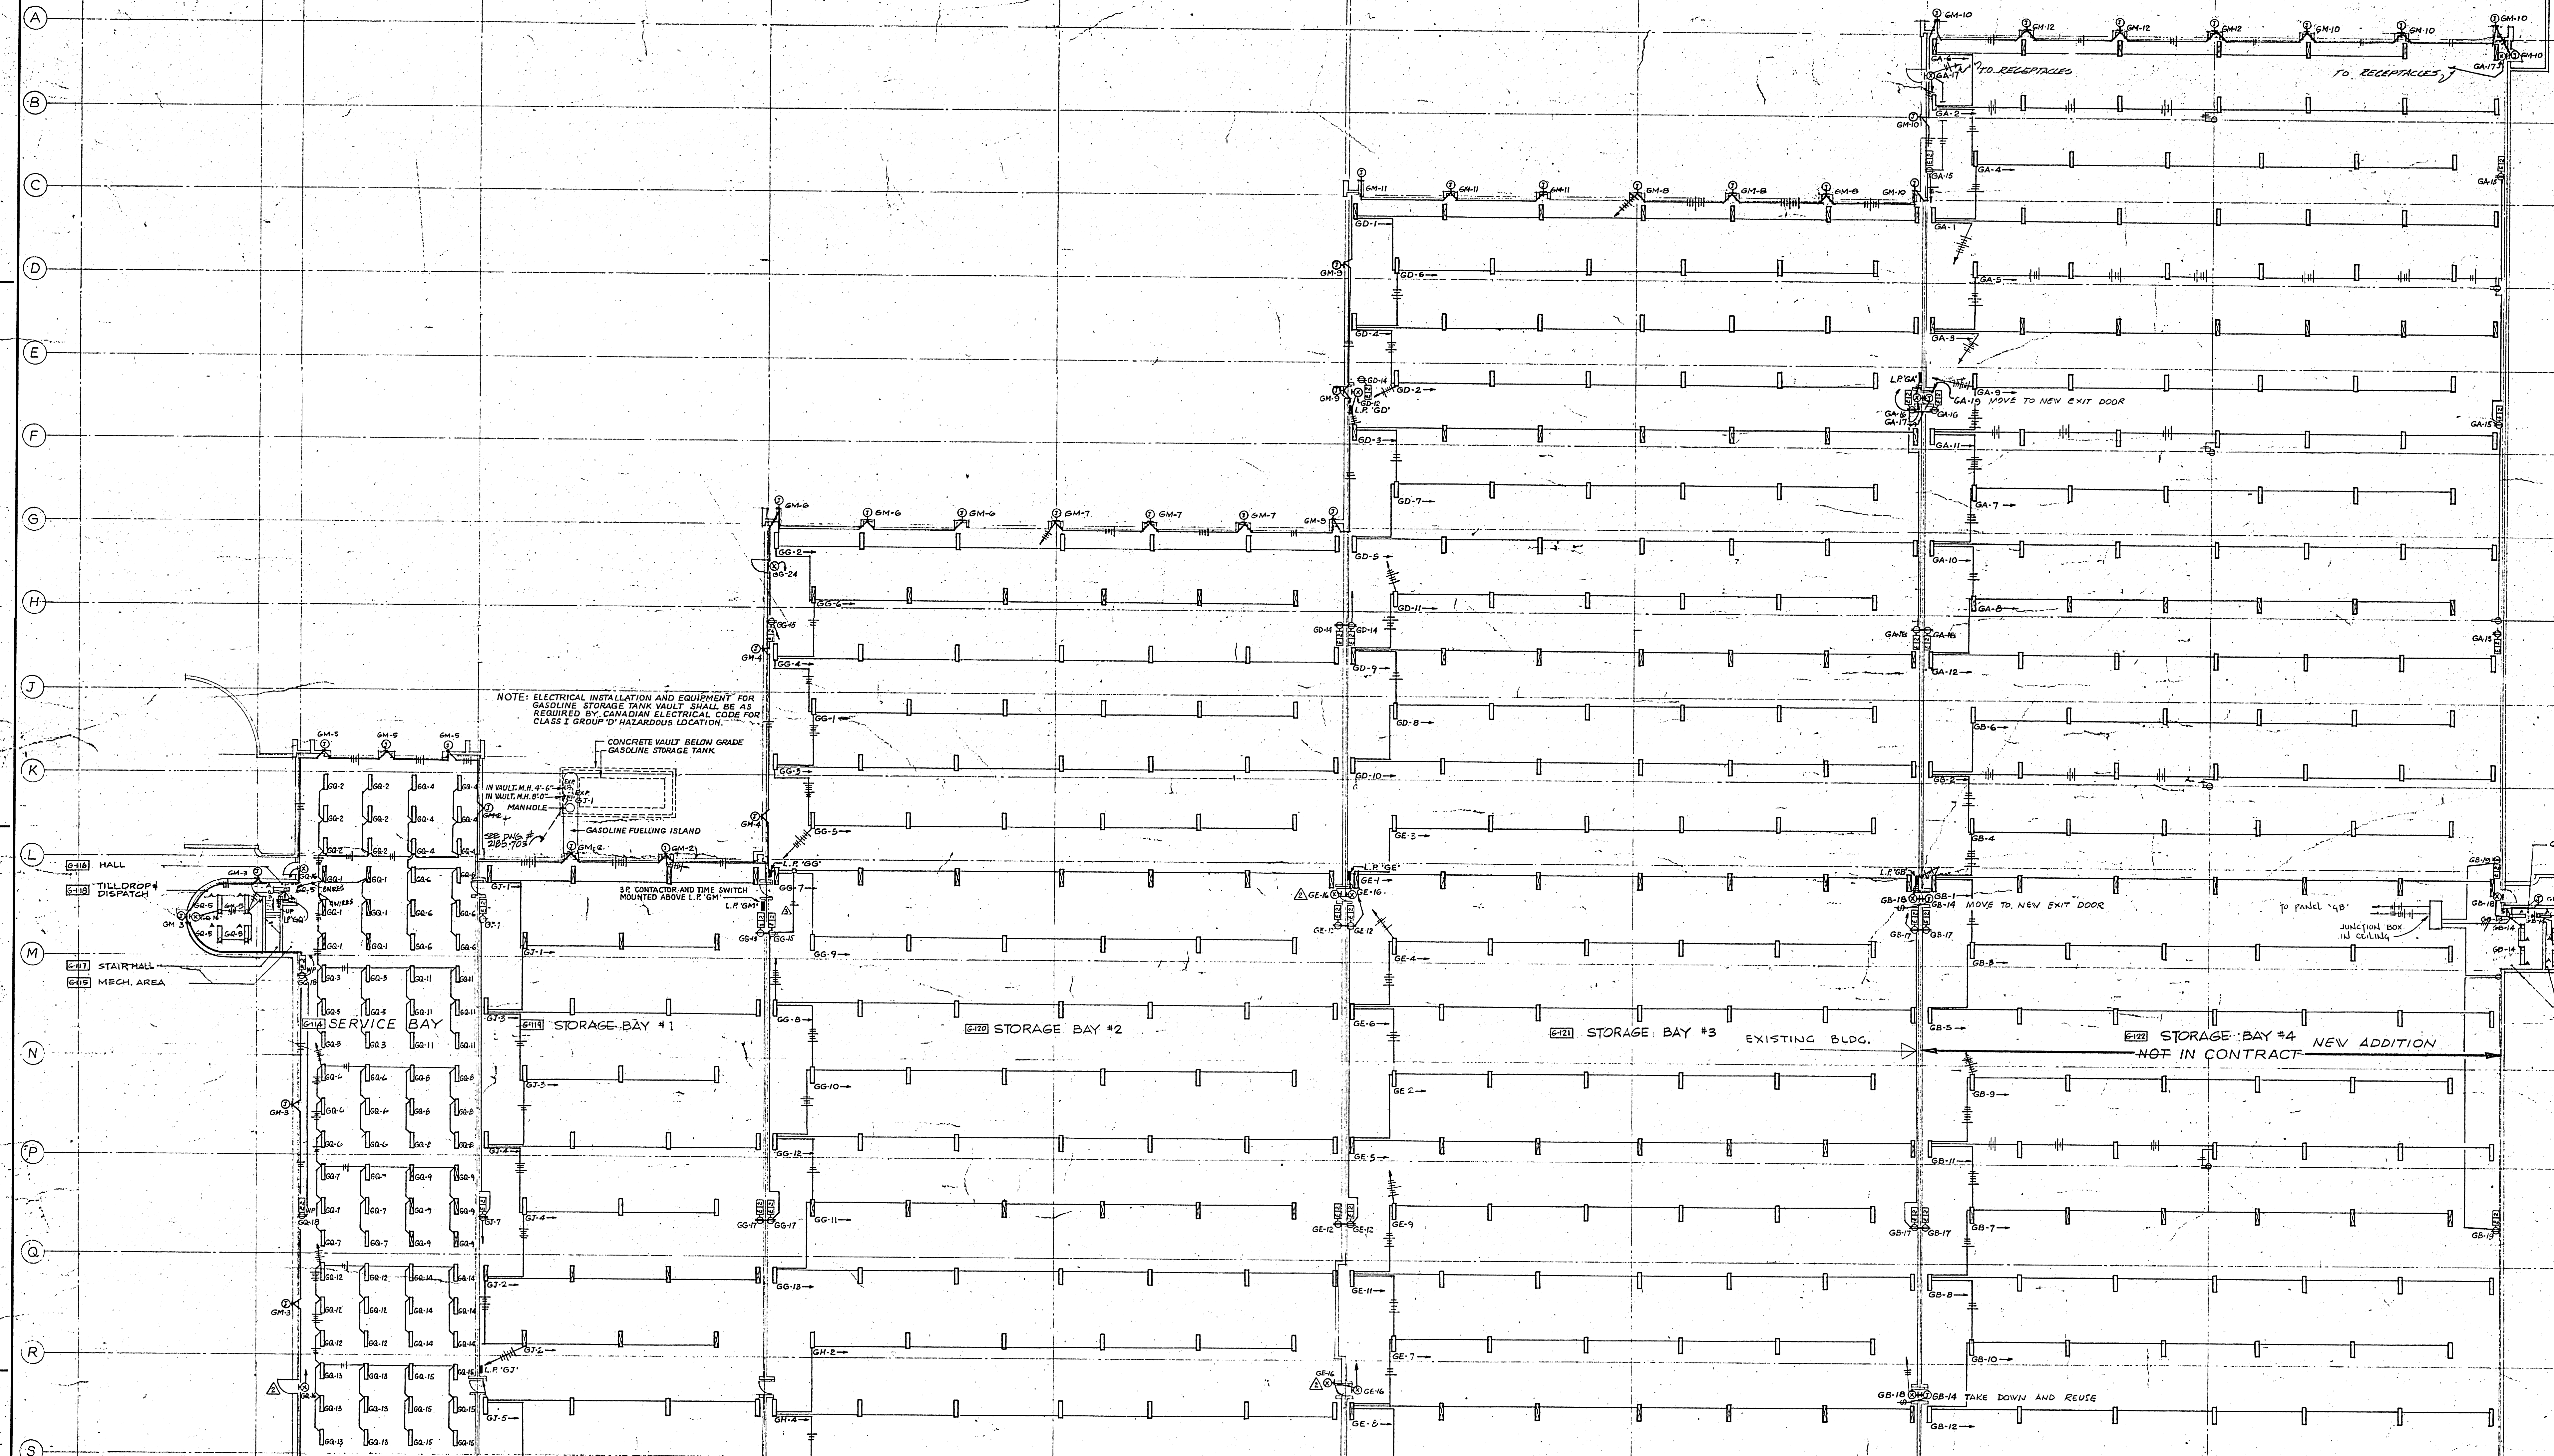

NOTE: ELECTRICAL INSTALLATION AND EQUIPMENT FOR GASOLINE STORAGE TANK WALLS SHALL BE AS REQUIRED BY CANADIAN ELECTRICAL CODE FOR CLASS I, GROUP D HAZARDOUS LOCATION.

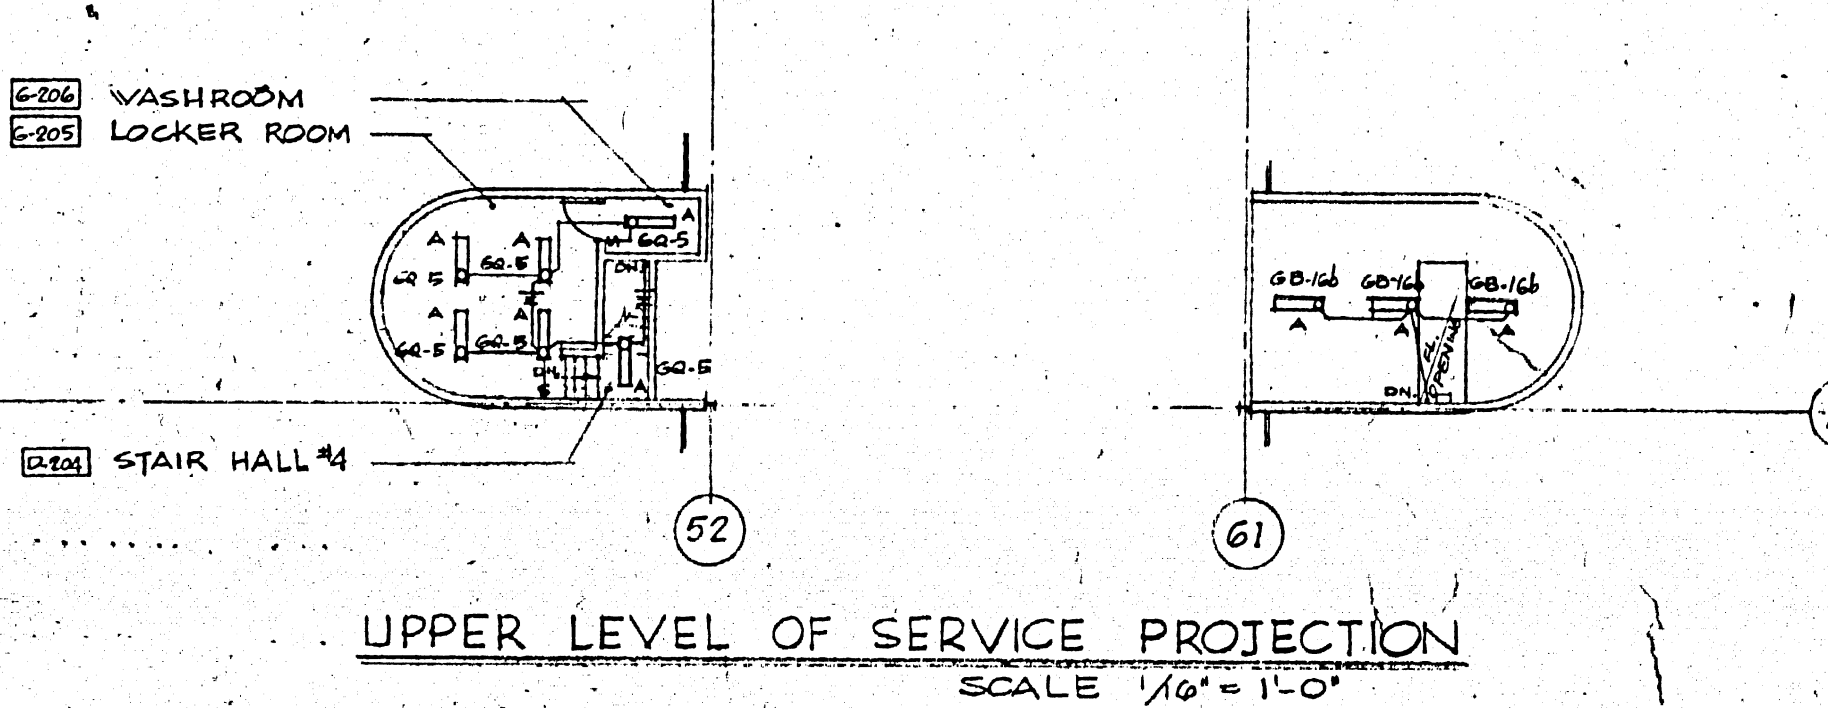

FOR CONTINUATION, SEE DRAWING NO. 2185-704


2185-702

NOTE: FOR NOTES, & TYPICAL MOUNTING DETAIL OF FLUORESCENT LIGHTING FIXTURES IN GARAGES SEE DRAWING NO. 2185-704.



REV.	DATE	DESCRIPTION
APR. 11/77		AS BUILT
MAY 7/77	7	REVISE WIRING IN BAY #4
MAY 9/77	7	GARAGE ADDITION - FOR TENDER
MAR 24/78	6	AS BUILT
MAR 24/78	5	DOOR #001 LIGHT ADDED ON WEST WALL BETWEEN COL. LINES R & S, EXIT LIGHTS ADDED.
MAR 24/78	4	ISSUED FOR CONSTRUCTION
MAR 24/78	3	GENERAL REVISIONS
MAR 24/78	2	FOR TENDER
MAR 24/78	1	FOR APPROVAL

APPROVED
 MAY 1977

A. D. MARGISON ASSOCIATES LTD.
 CONSULTING PROFESSIONAL ENGINEERS
 SUITE 202 - 1330 YONGE STREET
 TORONTO, ONTARIO M4T 1X2

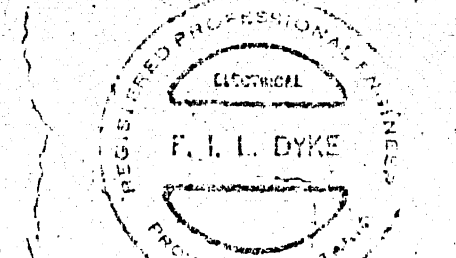

NUMBER TEN ARCHITECTURAL GROUP
 ARCHITECTS

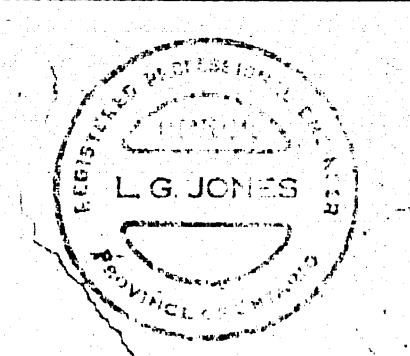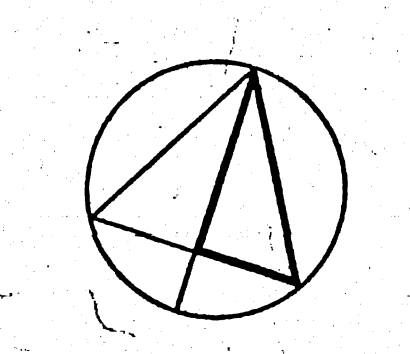

ISSUE OR REVISION
 METROPOLITAN CORPORATION OF GREATER WINNIPEG
 STREETS AND TRANSIT DIVISION

TRANSIT STORAGE AND SHOP FACILITIES
 PART FLOOR PLAN - GARAGE NORTH - LIGHTING

CONSULTING PROFESSIONAL ENGINEERS
 A. D. MARGISON AND ASSOCIATES LIMITED
 1555 LESLIE STREET, DON MILLS, ONTARIO

ARCHITECTS
 Wainman Ross + Blankstein Coop Gillmor Hanna
 20 SPADINA STREET, WINNIPEG, MANITOBA

DATE: 21 JULY 1977
 SCALE: 1/8" = 1'-0"
 SHEET NO.: 2185-702
 ELECTRICAL