
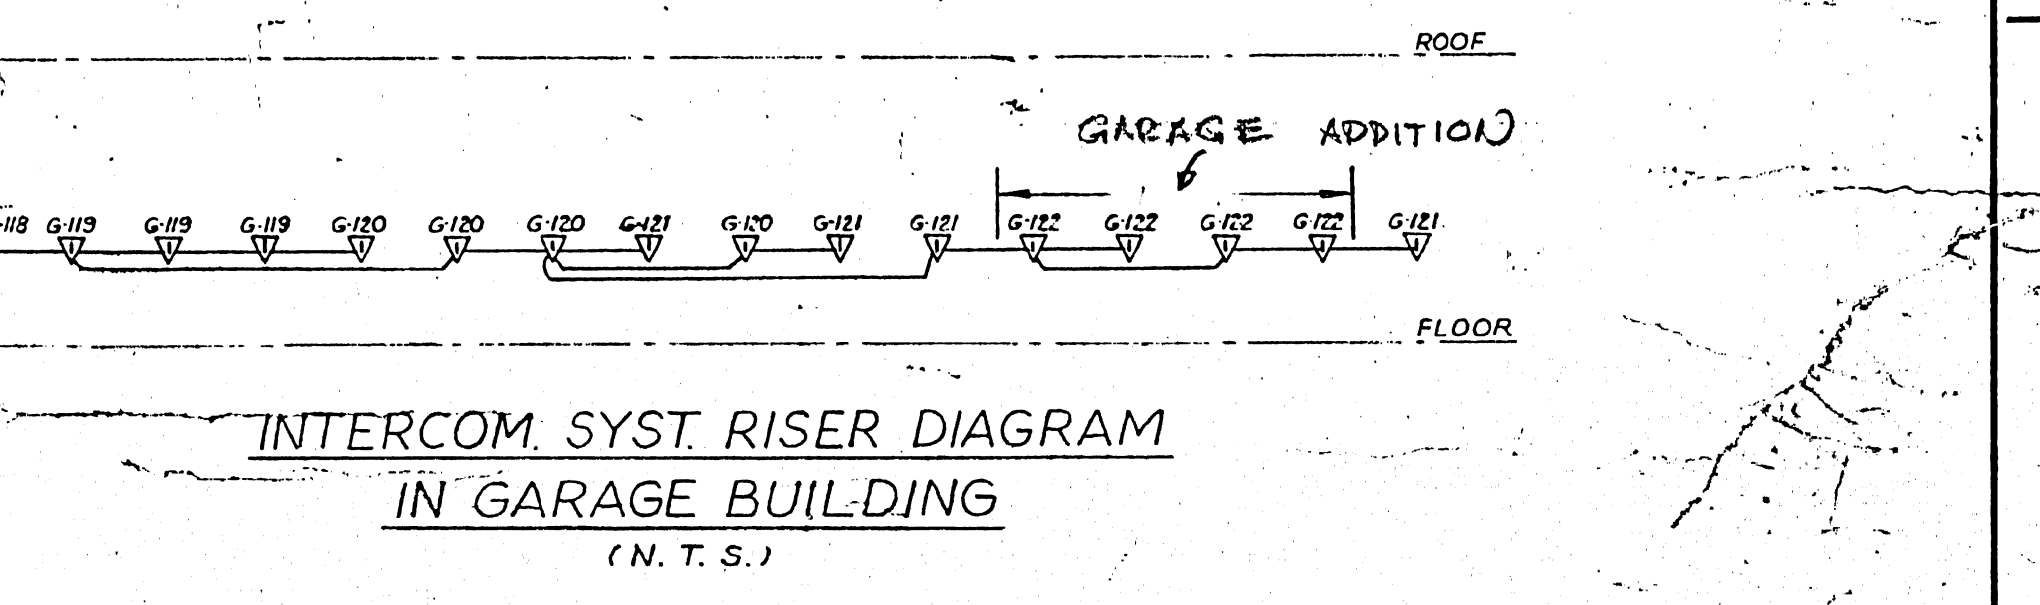
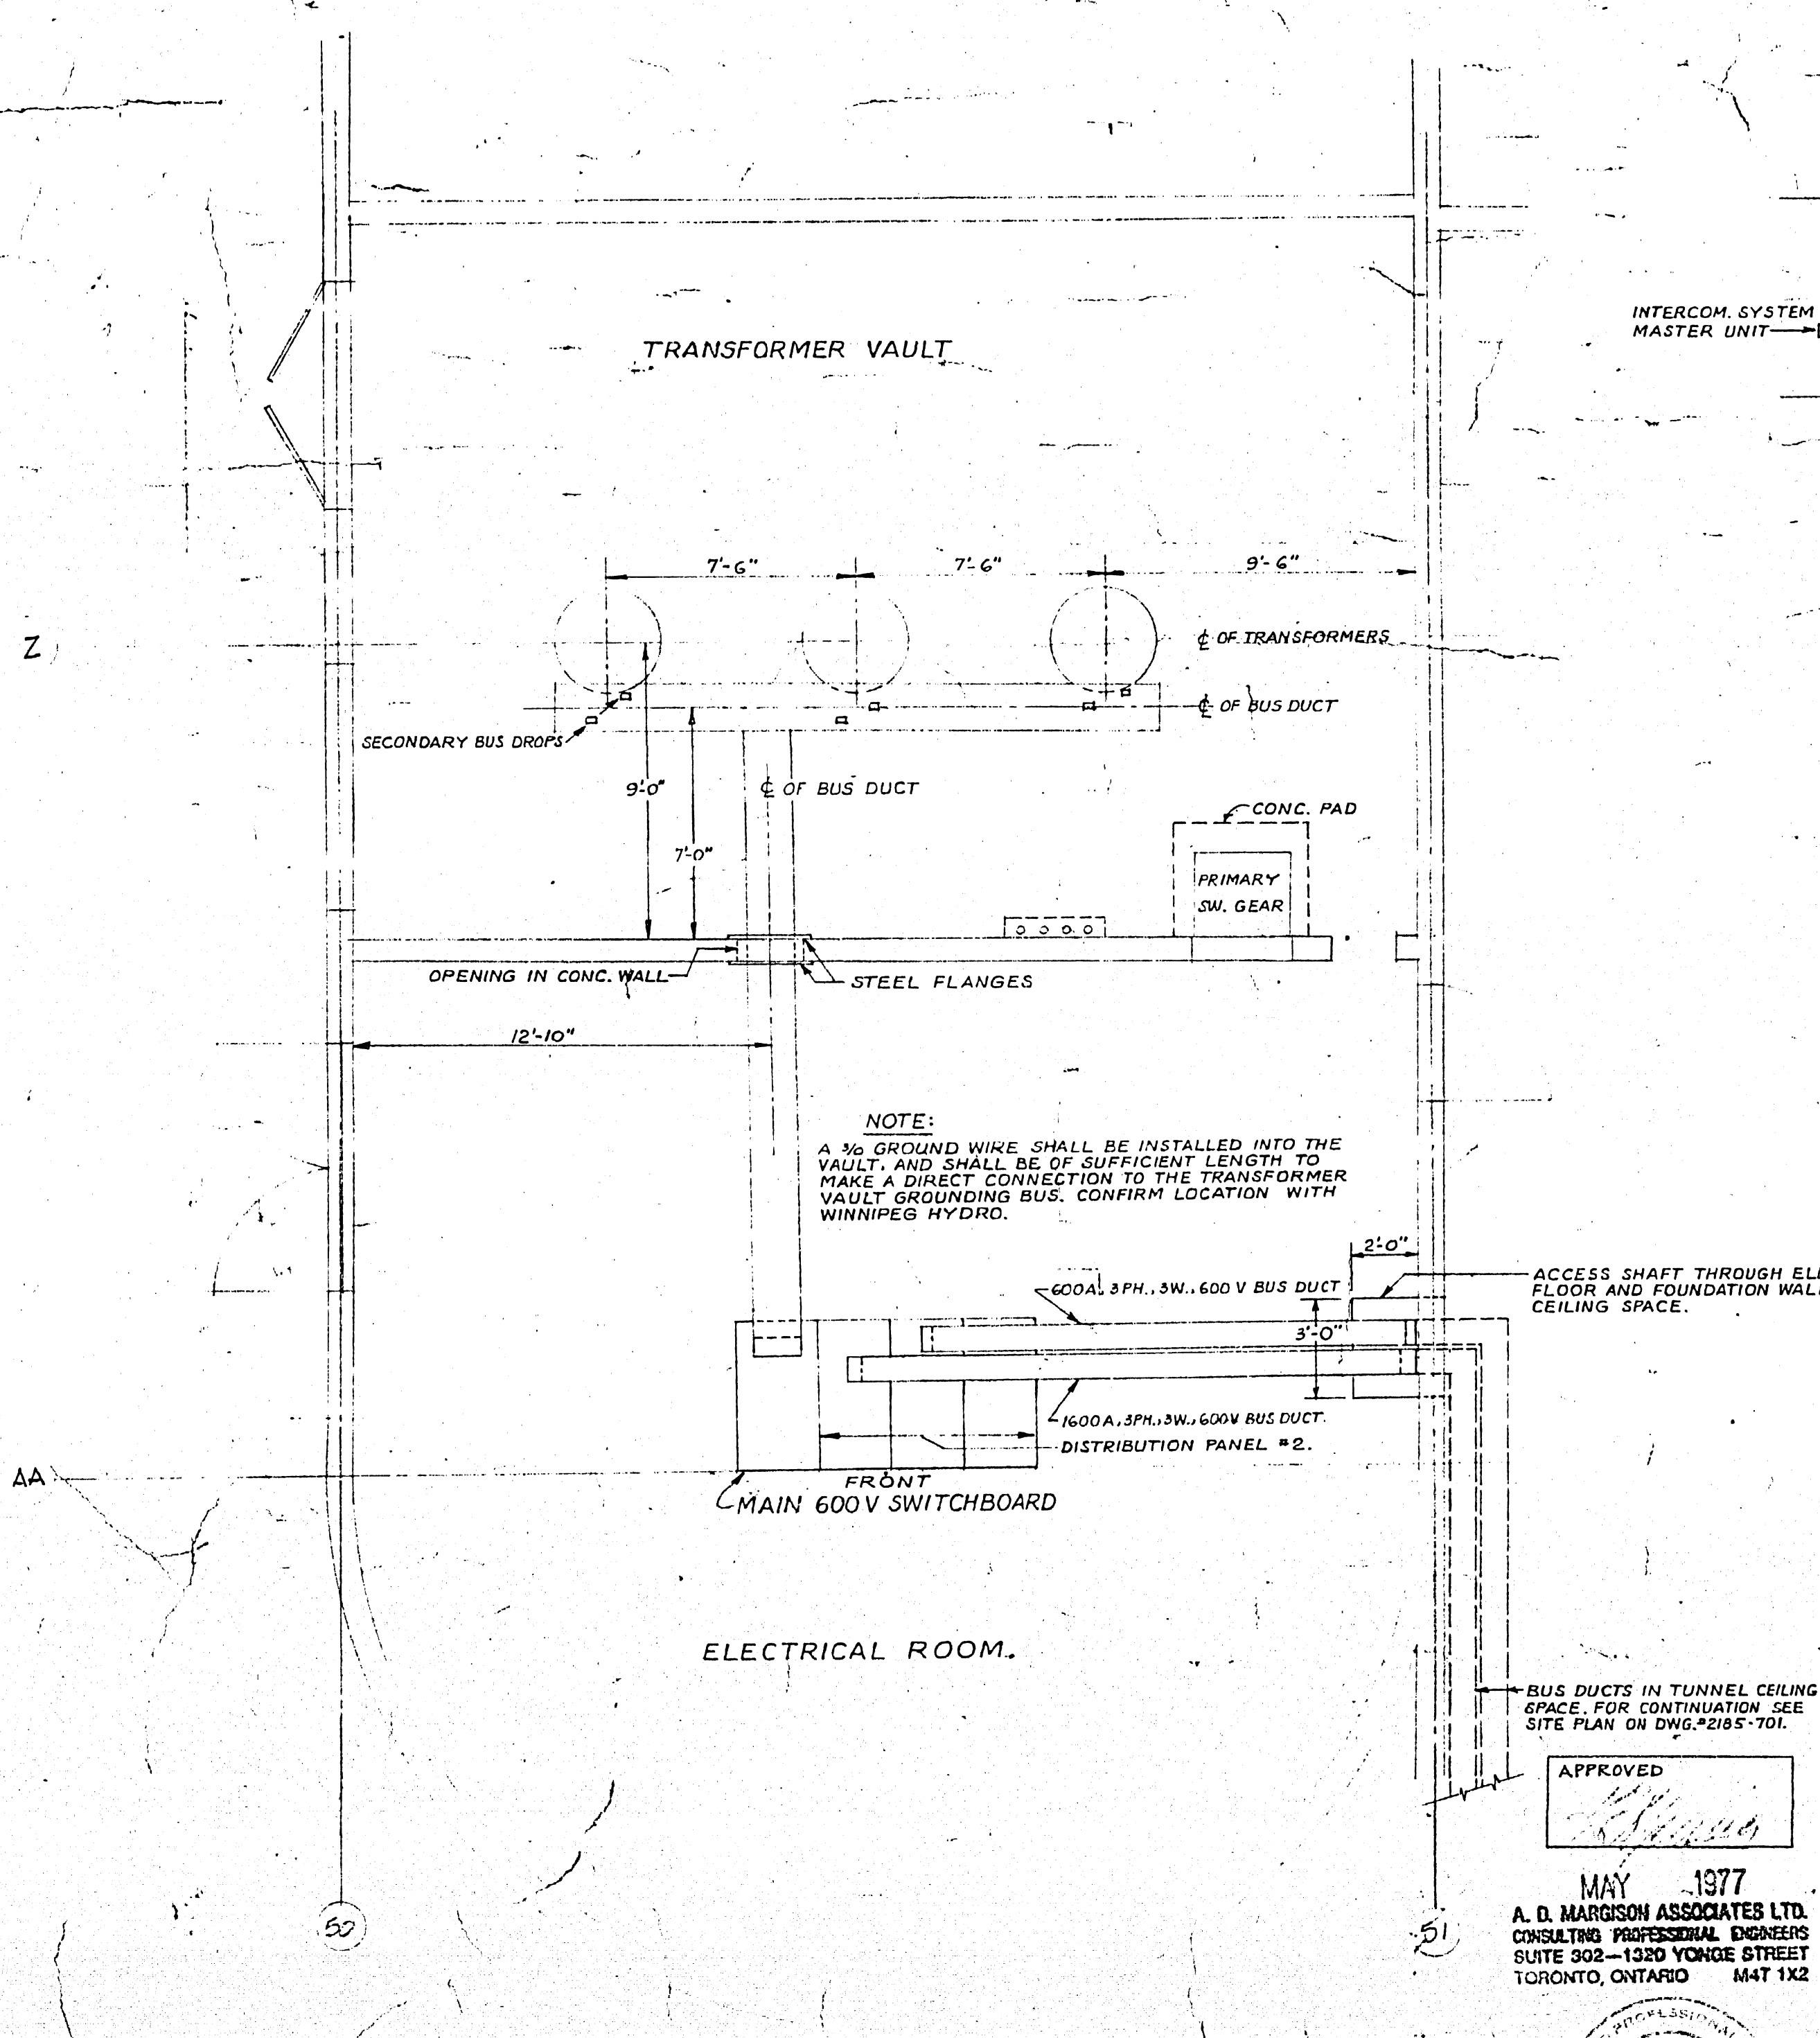
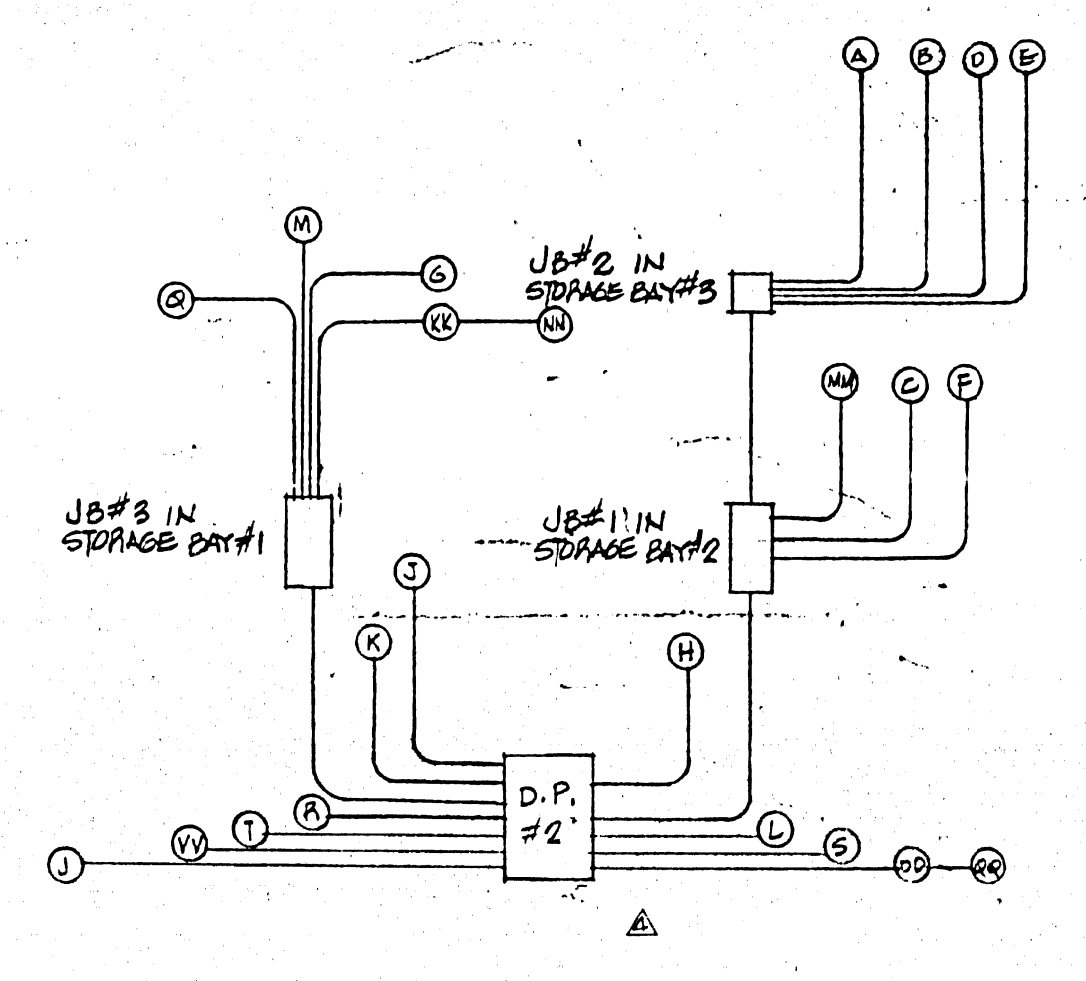
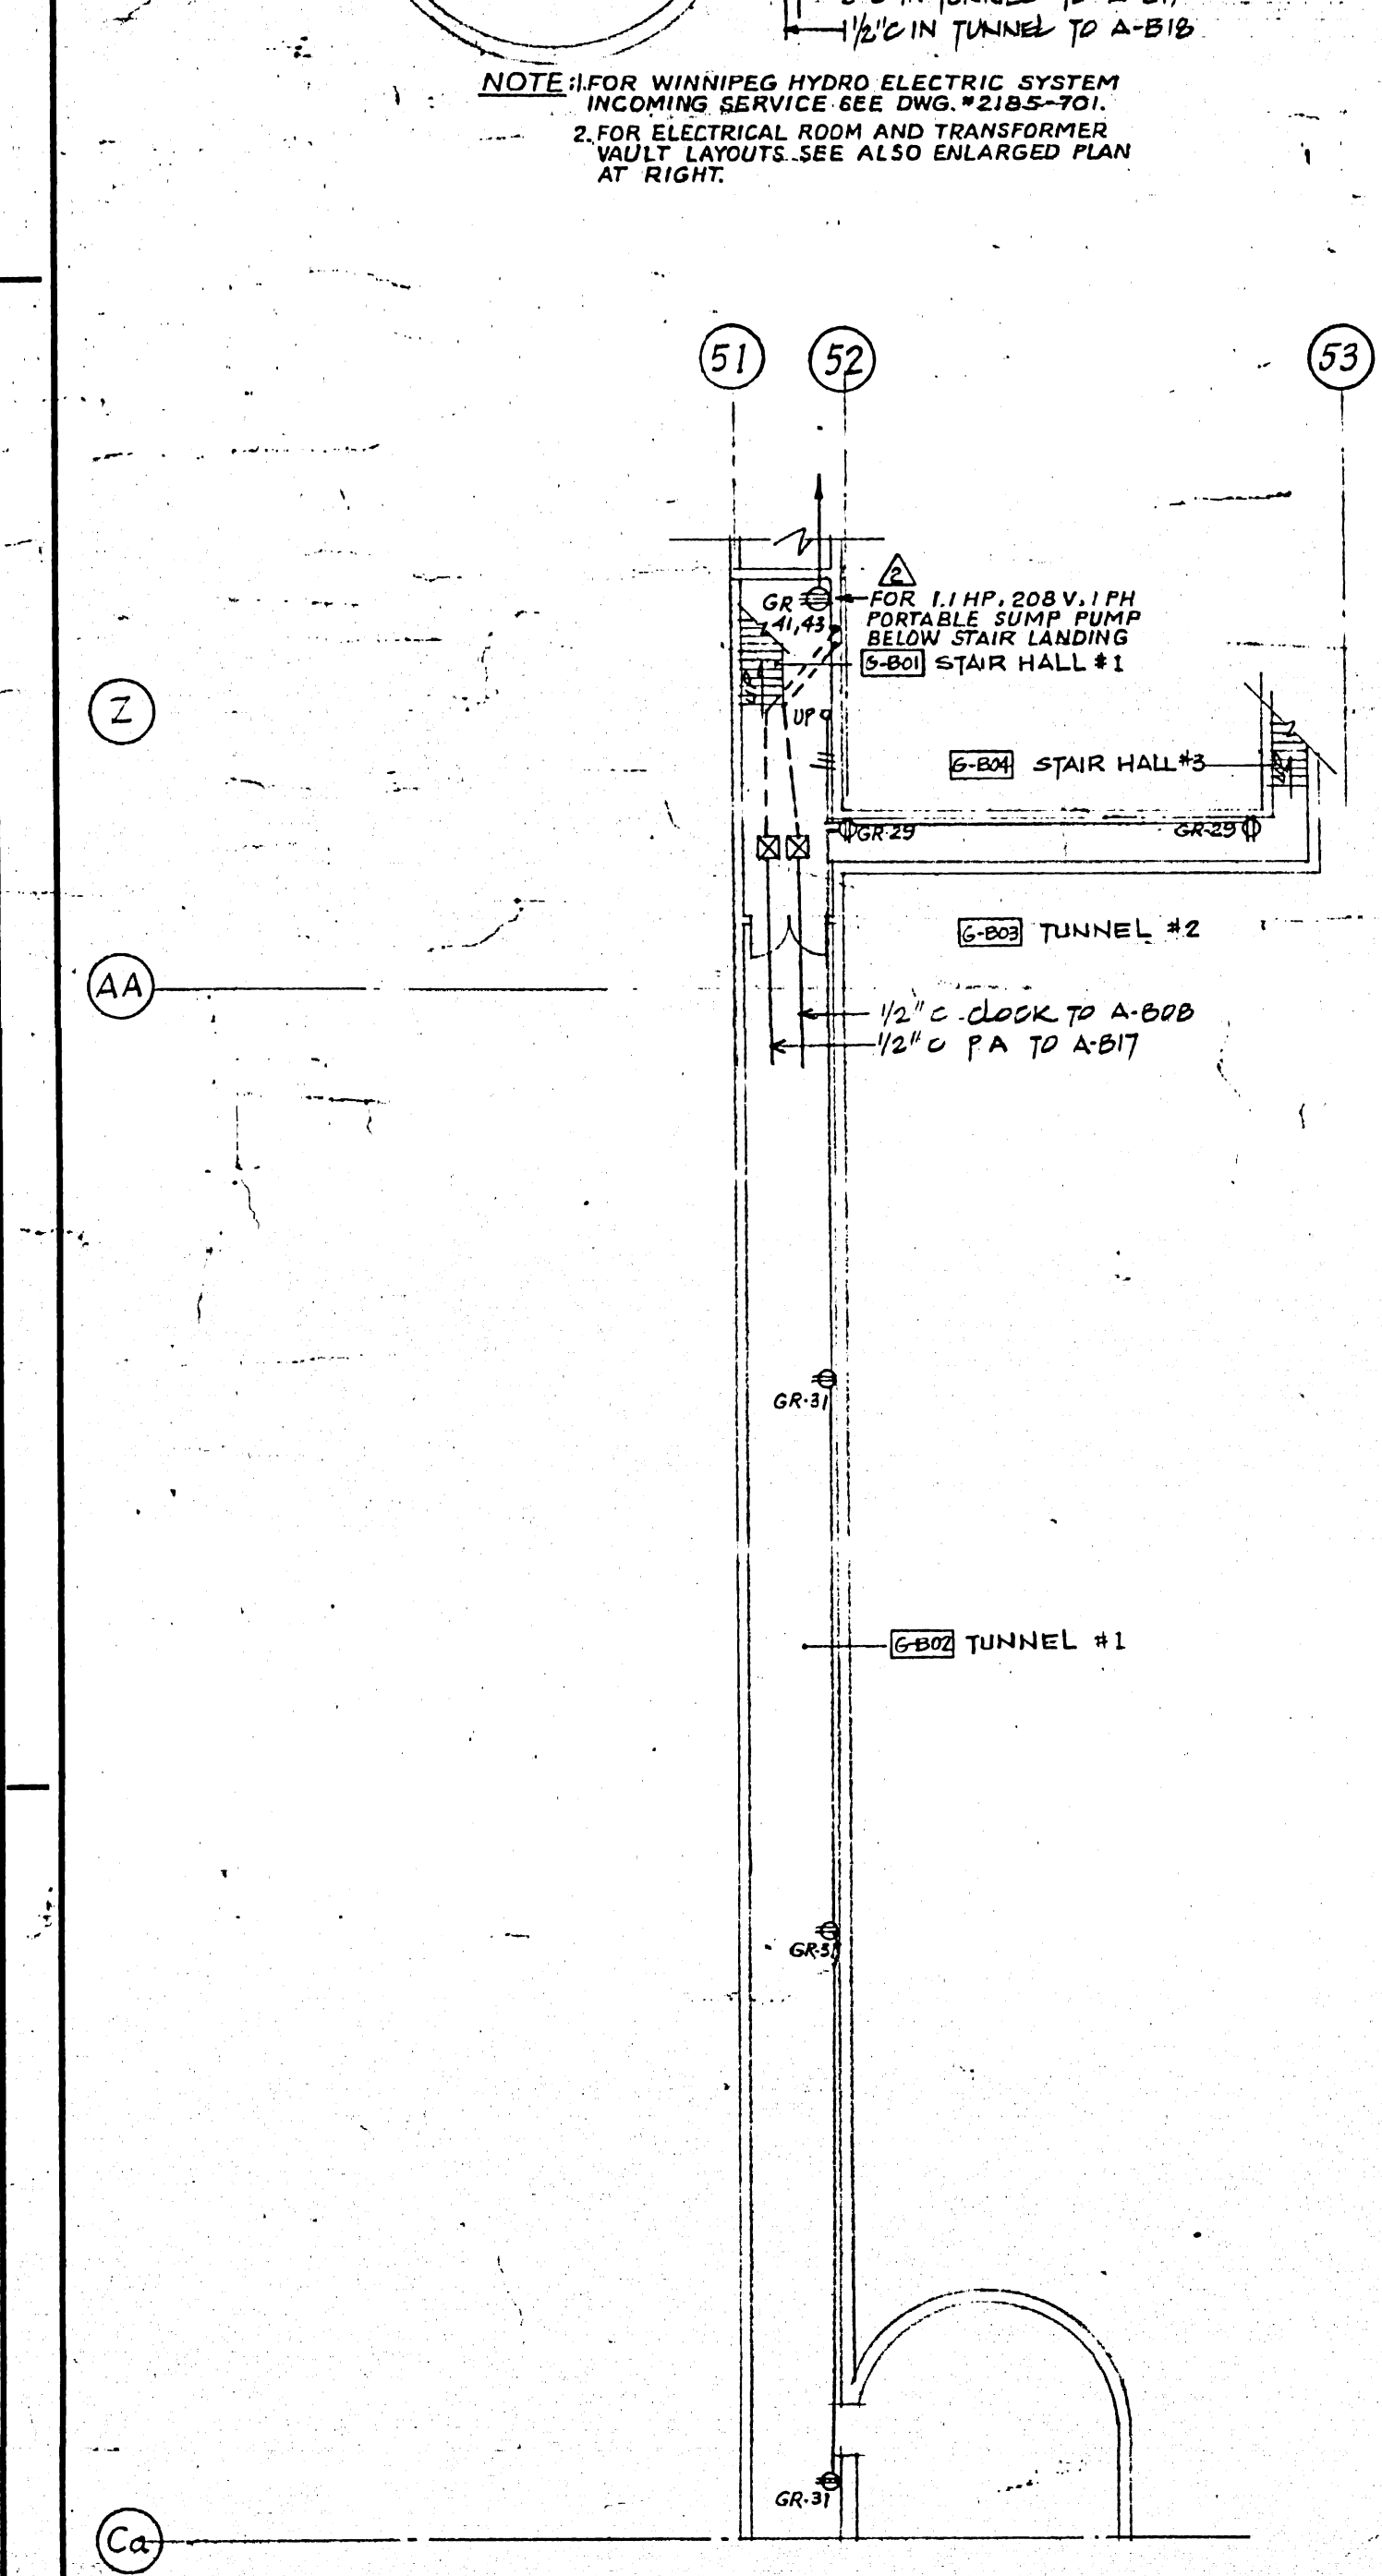


TRANSIT STORAGE AND SHOP FACILITIES  
 PART FLOOR PLAN - GARAGE SOUTH - POWER

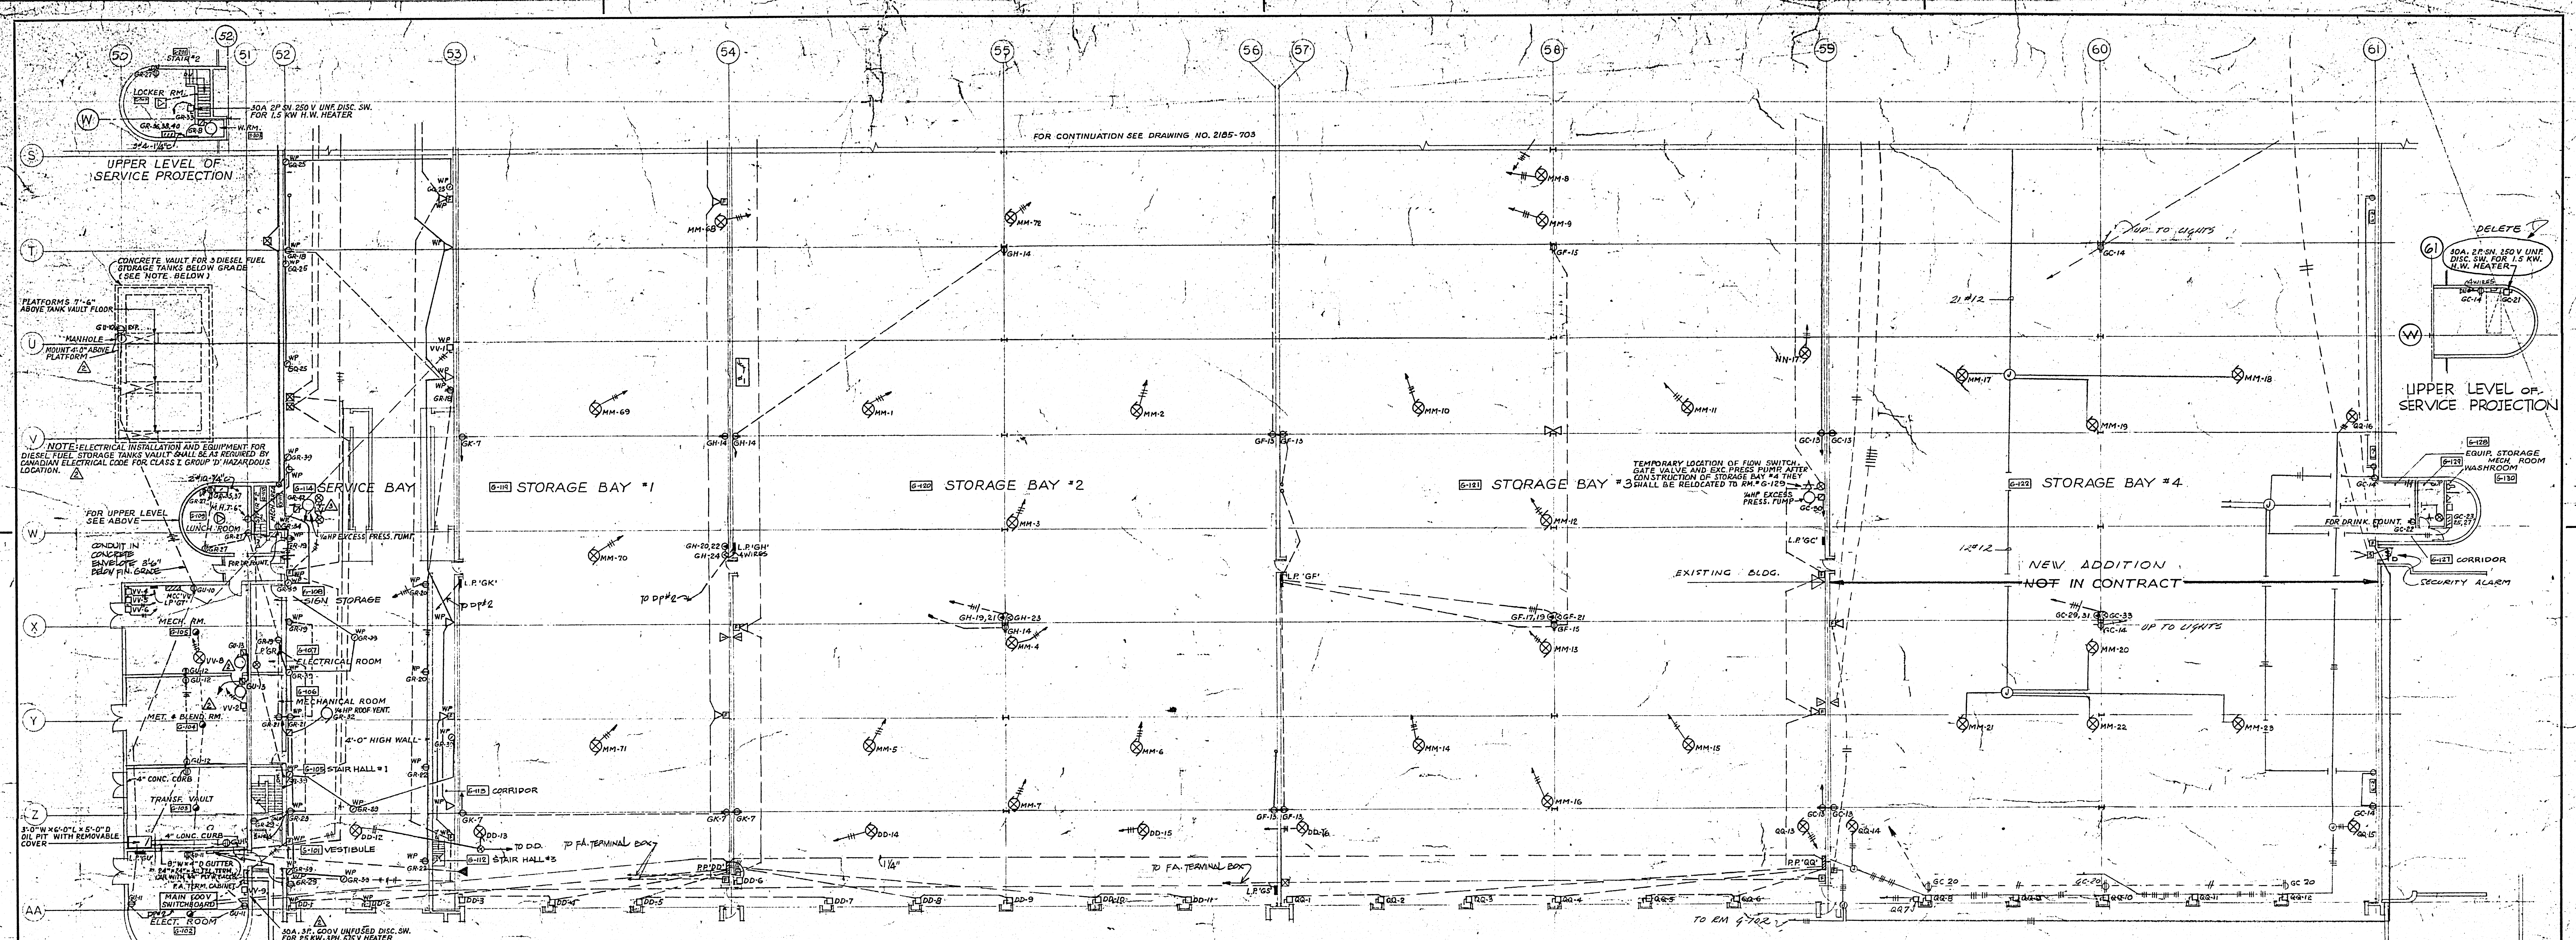

2185-705

DATE	BY	REV.	DESCRIPTION	DRAWN BY
APR 77	AV	1	AS BUILT DRAWING UPDASH - BAY #4	
MAR 77	AV	2	REMOVE WIRING IN BAY #2	
MAY 77	E	3	GARAGE ADDITION - FOR TENDER	
MAY 77	AV	4	AS BUILT	
APR 78	AV	5	EXCESS PUMP ADDED IN ROOM #6-11 ON OCT #GR-42	
MAY 78	AV	6	ELECTRICAL R.M. #10 CHANGED TO NON-HAZARDOUS HAZARD CLASS IN R.M. #10 AND R.M. #11. PERMIT ADDED TO TUNNEL #1 (S-B), DIESEL FREE STORAGE TANK. VERIFY CHANGE AND REEVALUATE REQUIRED.	
MAR 79	AV	7	ISSUED FOR CONSTRUCTION	
FEB 80	AV	8	GENERAL REVISION	
APR 80	AV	9	FOR TENDER	
APR 82	AV	10	FOR APPROVAL	

ISSUE OR REVISION

METROPOLITAN CORPORATION OF GREATER WINNIPEG  
 STREETS AND TRANSIT DIVISION

TRANSIT STORAGE AND SHOP FACILITIES

PART FLOOR PLAN - GARAGE SOUTH - POWER

CONSULTING PROFESSIONAL ENGINEERS  
 A. D. MARGISON AND ASSOCIATES LIMITED  
 10 DONALD STREET, DON MILLS, ONTARIO

ARCHITECTS  
 Walsman Ross + Blankstein Coop Gillmor Hanna  
 10 DONALD STREET, WINNIPEG, MANITOBA

APPROVED: [Signature]  
 DATE: 21 July 1987

SCALE: 1/8" = 1'-0" OR AS SHOWN

2185-705 ELECTRICAL