


9	com	RW	Rec lain	ned Water		MET	Metallic				CC	
	Cable	SL	Street I	Light		CP	Clay Pipe			h ssu ssu 7 4	PL	
		TS	Traffic	Signal		AC	Asbestos	Cement	(Trans	site)	CD	
		EXP	Explora	tory		CP	Copper Pi	be				
		UNK	Unknov	vn						PL ansite) CC ansite) CC this section of the sectio		
					5	Surface T	ype					
		С	Concre	te		I	Interlock				NG	
	Drawing #	Utility Type	Utility Material	Jtility Width (Nom.)	Ref. Point Elev.	Bottom of Utility Elev.	Top of Utility Elev.	Manual From (		os s al View	N ≜	
	Draw	Itility	L.A.		Re	B B	5	Bottom	Тор	tion C		
			5	mm.	m	m	m	m	m	Sec	Ļ	
	18	W	PL	200	231.47	2	229.20	-	2.27	0	\$	
	18	W	PL	200	231.36	-	229.12	÷	2.24	0	\$	
	18	FM	MET	300	231.50	-	227.70	-	3. <mark>80</mark>	$\bigcirc$	1	

V         V        TE	ST HOL	E INFC	ORMATIC	<u>NC</u>												TE	EST HO	LE INFO	ORMATI	ON												Ţ	EST HO	DLE INF	FORMA	TION					
B         B		Utility T	ype						Utility I	Materi	al				19*	6/25/14	11	W	MET	50	231.20	- 1	228.09	-	3.11	0	1		NG	_	44*	7/2/14	19	EXP	-	-	NOT	SURVE	YED	6.00 -	-	-		NG	-
in an and base in the serie in the	ALC IN TRANSPORTATION AND A DESCRIPTION					COLOR DE COLOR			e					1				1.2.1								~	*											1					Dod 9		
N + N +												-			20*	6/25/14	11	RAS	PL	250	231.20	-	228.42	-	2.78	$O \mid$	Ŧ		NG	-	45	7/4/14	13	W	PL	150	231.40	-	229.20	- 2.20				NG	-
N         N        N        N        N        N         N         N         N        N         N       N        N       N						CP							a ciuji cup	<u> </u>	21*	6/25/14	11	WAS	PL	200	230.98	-	227.65	-	3.33	$\cap$	+		NG	-	46	7/4/14	13	BT	PL	50x2	231.48	-	230.28	- 1.20	00	~		NG	-
	W Water	TS	Traffic	Signal		AC	Asbestos	Cement	(Transite)		CD	Concrete	Duct						1.1127120		Contraction of the						*														-	$\square$	Rod &		
V motor         V motor <t< td=""><td></td><td></td><td></td><td></td><td></td><td>CP</td><td>Copper Pip</td><td>pe</td><td></td><td></td><td></td><td></td><td></td><td></td><td>22</td><td>6/25/14</td><td>11</td><td>SL</td><td>DBC</td><td>40</td><td>230.95</td><td>e -</td><td>229.75</td><td>÷</td><td>1.20</td><td>0</td><td>~</td><td></td><td>NG</td><td>-</td><td>47</td><td>7/4/14</td><td>20</td><td>W</td><td>PL</td><td>150</td><td>231.12</td><td>-</td><td>228.17</td><td>- 2.98</td><td></td><td>  ↓</td><td></td><td>NG</td><td>-</td></t<>						CP	Copper Pip	pe							22	6/25/14	11	SL	DBC	40	230.95	e -	229.75	÷	1.20	0	~		NG	-	47	7/4/14	20	W	PL	150	231.12	-	228.17	- 2.98		↓		NG	-
k + k + k + k + k + k + k + k + k + k +	SIM Storm	UNK	Unknov	vn											23	6/26/14	11	RAS	PL	250	230.94	-	227.76	-	3.18	$\cap$	+		NG	-	48*	7/4/14	13	FOC	CC	-	231.00	-	230.30	- 0.70		i 🕇 🖞		NG	-
A mart         C         Virtual Cond         Virtual Cond        Virtual Cond        Vi						Surface 1	Гуре																			$\frac{1}{2}$	*	100000		-		7/7/4		100	NET		0.04.00		000 74	0.50			Dod 8	10	
	A A sphalt	С	Concre	te	-	1				1	NG	Natural (	Ground				11	WAS	PL	200	230.93	-	227.69	-	3.24	$\bigcirc$	+	Cap	NG	-	49	////14	14	VV	MET	38	231.32	-	228.74	- 2.58	5 0		Сар	NG	-
v v	a 26 1	ype g #	Iterial	Width ()	Point ev.	Elev	o of Elev			View	N	Ŋ	Type	thes s	25*	6/26/14	17	EXP		-	231.19	228.19	н	3.00	-	~	-		NG	-	50	7/7/14	5	BE	CD	2750	231.43	230.18	230.97	1.25 0.46	6	**		NG	-
v v	HL H		Ŋ Ma	(Nc	Ref.	Utility	Tol Utility			ional	1 I		lace	Thick	26	6/26/14	17	BE/BT	CC	1200	231.41	14	229.73	-	1.68		Î		NG		51	7/7/14	5	BE	CC	1100	231.22	-	230.14	- 1.08	3	11		NG	-
1         2       2       2         2 <th< td=""><td></td><td>5 5</td><td>Ctill</td><td>mm.</td><td>m</td><td></td><td>m</td><td></td><td></td><td>Sect</td><td>T</td><td></td><td></td><td></td><td>27</td><td>6/26/14</td><td>11</td><td>BE/BT</td><td>CON</td><td>2100</td><td>NO</td><td></td><td>EYED</td><td>-</td><td>1 09</td><td></td><td>Ť</td><td>Rod &amp;</td><td>NG</td><td>_</td><td>52</td><td>7/7/14</td><td>5</td><td>BE</td><td>MET</td><td>50</td><td>231 22</td><td>-</td><td>230.36</td><td>- 0.86</td><td>5 0</td><td>Ť</td><td>Rod &amp;</td><td>NG</td><td></td></th<>		5 5	Ctill	mm.	m		m			Sect	T				27	6/26/14	11	BE/BT	CON	2100	NO		EYED	-	1 09		Ť	Rod &	NG	_	52	7/7/14	5	BE	MET	50	231 22	-	230.36	- 0.86	5 0	Ť	Rod &	NG	
0         0        0        0        0          0      <	1 6/24/14 1	18 W	PL	200	231.47	0	229.20	-2	2.27 (	$\overline{\Omega}$	1		NG	20						2.721							*															+	Cap Rod &		
0         0        0        0        0        0         0        0        0        0 </td <td>0 00000</td> <td></td> <td>- DI</td> <td>000</td> <td>004.00</td> <td></td> <td>000 40</td> <td></td> <td>0.04</td> <td>ž</td> <td>*</td> <td></td> <td>NO</td> <td></td> <td>28</td> <td>6/26/14</td> <td>11</td> <td>BT</td> <td>DBC</td> <td>25</td> <td>231.10</td> <td>-</td> <td>230.50</td> <td>-</td> <td>0.60</td> <td>0</td> <td></td> <td>Сар</td> <td>NG</td> <td>-</td> <td>53</td> <td>////14</td> <td>6</td> <td>BE</td> <td>DBC</td> <td>40</td> <td>231.16</td> <td>-</td> <td>230.48</td> <td>- 0.68</td> <td>3 0</td> <td></td> <td>Cap</td> <td>NG</td> <td>_</td>	0 00000		- DI	000	004.00		000 40		0.04	ž	*		NO		28	6/26/14	11	BT	DBC	25	231.10	-	230.50	-	0.60	0		Сар	NG	-	53	////14	6	BE	DBC	40	231.16	-	230.48	- 0.68	3 0		Cap	NG	_
	2 6/24/14 1	18 W	PL	200	231.36	-	229.12	-	2.24	$\Box$	+		NG	-	29*	6/26/14	12	TUN	CON	-	231.07	- 14	230.49	4	0.58	$\Box$	N		NG		54	7/7/14	19	FM	MET	350	231.55	-	229.31	- 2.24		↔		NG	-
4 6 </td <td>3 6/24/14 1</td> <td>I8 FM</td> <td>MET</td> <td>300</td> <td>231.50</td> <td>5</td> <td>227.70</td> <td>5</td> <td>3.<mark>80</mark> {</td> <td><math>\circ  </math></td> <td>2</td> <td></td> <td>NG</td> <td></td> <td>30*</td> <td>6/26/14</td> <td>12</td> <td>TUN</td> <td>CON</td> <td>-</td> <td>231.12</td> <td>227.12</td> <td>230.51</td> <td>4.00</td> <td>0.61</td> <td>τ</td> <td>**</td> <td>Rod &amp;</td> <td>NG</td> <td>-</td> <td>55*</td> <td>7/7/14</td> <td>19</td> <td>EXP</td> <td>-</td> <td>н (</td> <td>231.55</td> <td>225.45</td> <td>-</td> <td>6.10 -</td> <td>-</td> <td>-</td> <td></td> <td>NG</td> <td>-</td>	3 6/24/14 1	I8 FM	MET	300	231.50	5	227.70	5	3. <mark>80</mark> {	$\circ  $	2		NG		30*	6/26/14	12	TUN	CON	-	231.12	227.12	230.51	4.00	0.61	τ	**	Rod &	NG	-	55*	7/7/14	19	EXP	-	н (	231.55	225.45	-	6.10 -	-	-		NG	-
S </td <td>4 6/24/14 1</td> <td>18 FM</td> <td>MET</td> <td>300</td> <td>231.00</td> <td>н</td> <td>227.51</td> <td>-</td> <td>3.49 (</td> <td>0</td> <td>¢</td> <td></td> <td>NG</td> <td>~</td> <td>31</td> <td>6/27/14</td> <td>13</td> <td>BT</td> <td>DBC</td> <td></td> <td>231.33</td> <td></td> <td>230.93</td> <td>-</td> <td>0.40</td> <td>00</td> <td>97</td> <td>Rod &amp;</td> <td>NG</td> <td>-</td> <td>56</td> <td>7/7/14</td> <td>19</td> <td>FM</td> <td>MET</td> <td>200</td> <td>231.49</td> <td>-</td> <td>228.91</td> <td>- 2.58</td> <td>30</td> <td>++</td> <td>Rod &amp;</td> <td>NG</td> <td>4</td>	4 6/24/14 1	18 FM	MET	300	231.00	н	227.51	-	3.49 (	0	¢		NG	~	31	6/27/14	13	BT	DBC		231.33		230.93	-	0.40	00	97	Rod &	NG	-	56	7/7/14	19	FM	MET	200	231.49	-	228.91	- 2.58	30	++	Rod &	NG	4
6 8	5 6/24/14 1	18 FO	D PL	50	230.91	-	230.06	-	0.85	0	Î		NG	-1										-	0.27					-	57*	7/8/14	19	EXP	-	-	231.45	227.20	-	4.25 -	-	-	Rod &	NG	-
<	6 6/24/14 1	IT FM	MET	300	231.32	_	227.56	-	3.76 {	$\overline{\mathbf{n}}$	<b>▼</b>	Rod &	NG	-	32	6/27/14	13	BT	DBC		NO	TSURVE	EYED			0 o	+		NG	-	58*	7/8/14	6	EFFL	CD	- 1	231.10	-	227.80	- 3.30		++	Rod &	NG	-
P         P       <th< td=""><td></td><td>BE</td><td>CON</td><td>1180</td><td></td><td>-</td><td>229.88</td><td></td><td>1 60</td><td></td><td>ä</td><td></td><td></td><td></td><td></td><td></td><td></td><td></td><td></td><td></td><td></td><td></td><td>230 68</td><td>-</td><td></td><td></td><td>1</td><td></td><td></td><td>_</td><td>59*</td><td>7/8/14</td><td>6</td><td>EFFL</td><td>CD</td><td>- 1</td><td>231.12</td><td>-</td><td>227.80</td><td>- 3.32</td><td></td><td>**</td><td>Rod &amp;</td><td>NG</td><td></td></th<>		BE	CON	1180		-	229.88		1 60		ä												230 68	-			1			_	59*	7/8/14	6	EFFL	CD	- 1	231.12	-	227.80	- 3.32		**	Rod &	NG	
N         N        N       N        N         N        N </td <td><b>7</b>* 6/24/14 1</td> <td>7</td> <td></td> <td></td> <td>231.48</td> <td></td> <td>-</td> <td></td> <td></td> <td>000</td> <td>1</td> <td></td> <td>NG</td> <td>-</td> <td>33</td> <td>6/26/14</td> <td>12</td> <td>BT</td> <td>DBC</td> <td>and the second s</td> <td>231 21</td> <td></td> <td></td> <td></td> <td>0.70</td> <td></td> <td>*</td> <td></td> <td>NG</td> <td></td> <td>60*</td> <td>7/8/14</td> <td>6</td> <td>EFFL</td> <td>CD</td> <td>-</td> <td>231.08</td> <td>225.28</td> <td>227.78</td> <td>5.80 3.30</td> <td></td> <td>++</td> <td>Rod &amp;</td> <td>NG</td> <td>-</td>	<b>7</b> * 6/24/14 1	7			231.48		-			000	1		NG	-	33	6/26/14	12	BT	DBC	and the second s	231 21				0.70		*		NG		60*	7/8/14	6	EFFL	CD	-	231.08	225.28	227.78	5.80 3.30		++	Rod &	NG	-
0         0.0        0.0        0.0        0.0        0.0        0.0        0.0        0.0       0.0       0.0      <	<b>9</b> * C/05/4 4			1200	001.00						*	Rod &	NC			0/20/14	12	5.	000		201.21	-			F	ното	*	Cap			61*	7/8/14	6	EFFL	CD	-	231.08	-	227.80	- 3.28		**	Rod &	NG	
				-						$\exists$	+			-	24	C/07/44	10	OTM.	MET		001 44	-		-				Rod &	NC			-									-		Rod &		-
n         n						0				$\bigcirc$	+	Cap		-21		2.2.2.1										$\frac{\circ}{\circ}$	*			-	-	and a sec	12	S.EFF									Rod &		
1 62/4 1 w c 45 22.1 . 22.4 . 22.4 . 22.4 . 2 0 . 0 <th0< th=""> 0</th0<>	10 6/25/14 1	I7 SAI	N PL	100	232.12	-	229.62	-	2.50	0	Ţ	Cap	NG	-						200						$\frac{\circ}{=}$		Сар		-1			6			-					<u> </u>	-	Rod &		
12         625/14         17         EAP         2         2         10         0         10         0       0       0	11 6/25/14 1	17 W	CP	45	232.13	5	229.46		2.67	0	ţ	Cap	NG	-		Sec. of the sec.	18	TUN	CON	-	231.42	226.97	230.22	4.45	1.20		Ţ	Сар	NG	<u>_</u>		1000000000000				200							Rod &		
13         625/14         17         W         MET         50         231.0         -         282.0         -         280.0         -         Res         Res <th< td=""><td><b>12</b>* 6/25/14 1</td><td>I7 EX</td><td>2 -</td><td>-</td><td>231.00</td><td>229.10</td><td>r =</td><td>1.90</td><td>-</td><td>-</td><td>-</td><td></td><td>NG</td><td></td><td>37</td><td>6/27/14</td><td>18</td><td>LDS</td><td></td><td>375</td><td>231.38</td><td>-</td><td>229.28</td><td>-</td><td>2.10</td><td>0</td><td>~</td><td>Сар</td><td>NG</td><td>-</td><td></td><td></td><td></td><td></td><td></td><td></td><td>231 45</td><td>-</td><td>225 75</td><td></td><td><math>\sim</math></td><td></td><td>Rod &amp;</td><td></td><td></td></th<>	<b>12</b> * 6/25/14 1	I7 EX	2 -	-	231.00	229.10	r =	1.90	-	-	-		NG		37	6/27/14	18	LDS		375	231.38	-	229.28	-	2.10	0	~	Сар	NG	-							231 45	-	225 75		$\sim$		Rod &		
1       1       R       P       2	13 6/25/14 1	17 W	MET	50	231.01	-	228.21	=	2.80	0	↔		NG	-	38	6/27/14	12	CEN	-	350	231.23	-	229. <mark>4</mark> 3		1.80	0	ţ.	Сар	NG														Rod &		
A       A       A       B       A       B       A       B       C	14 6/25/14 1	I7 RAS	S PL	250	231.02	2	228.32	-	2.70	0	$\leftrightarrow$		NG	-	39*	6/27/14	12	TUN	CON	1800	231.16	-	230.16	-	1.00		1		NG	21												★	Rod &		
A         A	15 6/25/14 1	17 WA	S PL	200	231.01	-	228.24	÷	2.77	0	$\leftrightarrow$		NG	-	40*	6/27/14	12	TUN	CON	1800	231.17	-	230.17	-	1.00		\$		NG	-			1.273										Rod &		
1       1       1       0       2       2       2       2       0	16 6/25/14 1	I <mark>7</mark> FM	MET	300	231,11		227.80	-	3.31 (	$\overline{o}$	$\leftrightarrow$	Rod &	NG		41	7/2/14	19	TUN	CON	3750	231.42	)	230.47		0.95		1		NG	-			. 22										Rod &		
	<b>17</b> * 6/25/14 1	I7 EX	-	-	231.74	229.48	-	2.26	-	-	-	Rod &	NG	-1	42	7/2/14	19	TUN	CON	3750	231.42		230.47	-	0.95		Ì	Rod &	NG	-													Rod &		-
		11 W	-	200	230.89	-	227.68	_	3.21 (	$\overline{o}$	$\leftrightarrow$	Rod &	NG	-	43*	7/2/14	19	EXP	-	-	231.41	225.41	-	6.00	-	-	-	Rod &	NG	-						_							Rod &		
						ASE SE		PAGE		~		Udp			*								ENOTES		:			Udp		$\dashv$						OPMATH							Сар		


	150 WM	WATERMAIN	150 WM	¢`	CURB STOP	•	INF	INFLUENT		LOCATION APPROVED								PROFESSIONAL
-	-0-	HYDRANT	+		REDUCER		EFF	EFFLUENT		UNDERGROUND STRUCTURES				( ↓   🥒	utility			
0	⊗	VALVE	۲	X	COUPLING	<del>x</del>	PS	PRIMARY SLUDGE								AEC		
0	300 LDS	LAND DRAINAGE SEWER	300 LDS	۶	ANODE	~	RS	RAW SEWAGE		SUPR. U/G STRUCTURES DATE					ineers			
	250 WWS	WASTE WATER SEWER	250 WWS	• •	LAMP STANDARD									1-855-222-T2UE   W	WW.T2UE.COM			Original Sta
	0	MANHOLE		$\odot$	TREE					NOTE: LOCATION OF UNDERGROUND STRUCTURES						CHECKED	RG , JB	L.E. AR( Jan. 19,
Ĺ		CATCH BASIN		Онр	HYDRO POLE					AS SHOWN ARE BASED ON THE BEST	5 ISSUED FOR CITY OF WINNIPEG USE	15/01/19	AJW					Jan. 19,
L		CURB INLET	<b></b>	<u>+</u>	BENCH MARK					INFORMATION AVAILABLE. BUT NO GUARANTEE IS GIVEN THAT ALL EXISTING	4 FINAL REVIEW	14/08/25	AJW	DRAWN BY	AJW	APPROVED BY	LEA	
		CULVERT		INV	INVERT					UTILITIES ARE SHOWN OR THAT THE GIVEN	3 REVISED TENDER	14/06/13	AJW					_
L		PIPE ABANDONMENTS	<b>_</b>	OBV	OBVERT					<ul> <li>LOCATIONS ARE EXACT. CONFIRMATION OF EXISTENCE AND EXACT LOCATION OF ALL</li> </ul>	2 ISSUED FOR TENDER	14/04/03	AJW	HOR. SCALE	NTS	RELEASED FOR CONSTRUCTION		CONSULTANT
Ē	+ ste	SURVEY BAR								SERVICES MUST BE OBTAINED FROM THE INDIVIDUAL UTILITIES BEFORE PROCEEDING	1 PRELIMINARY REVIEW	14/03/04	AJW	VERT. SCALE				6031 <i>°</i>
Ċ	DNITSIXA G	LEGEND - PLAN	NEW	EXISTING	LEGEND - PLAN	NEW	EXISTING	LEGEND - PLAN	NEW		NO. REVISIONS	YY/MM/DD	BY	DATE	28-OCT-14	DATE		T2UE DRAV 61000



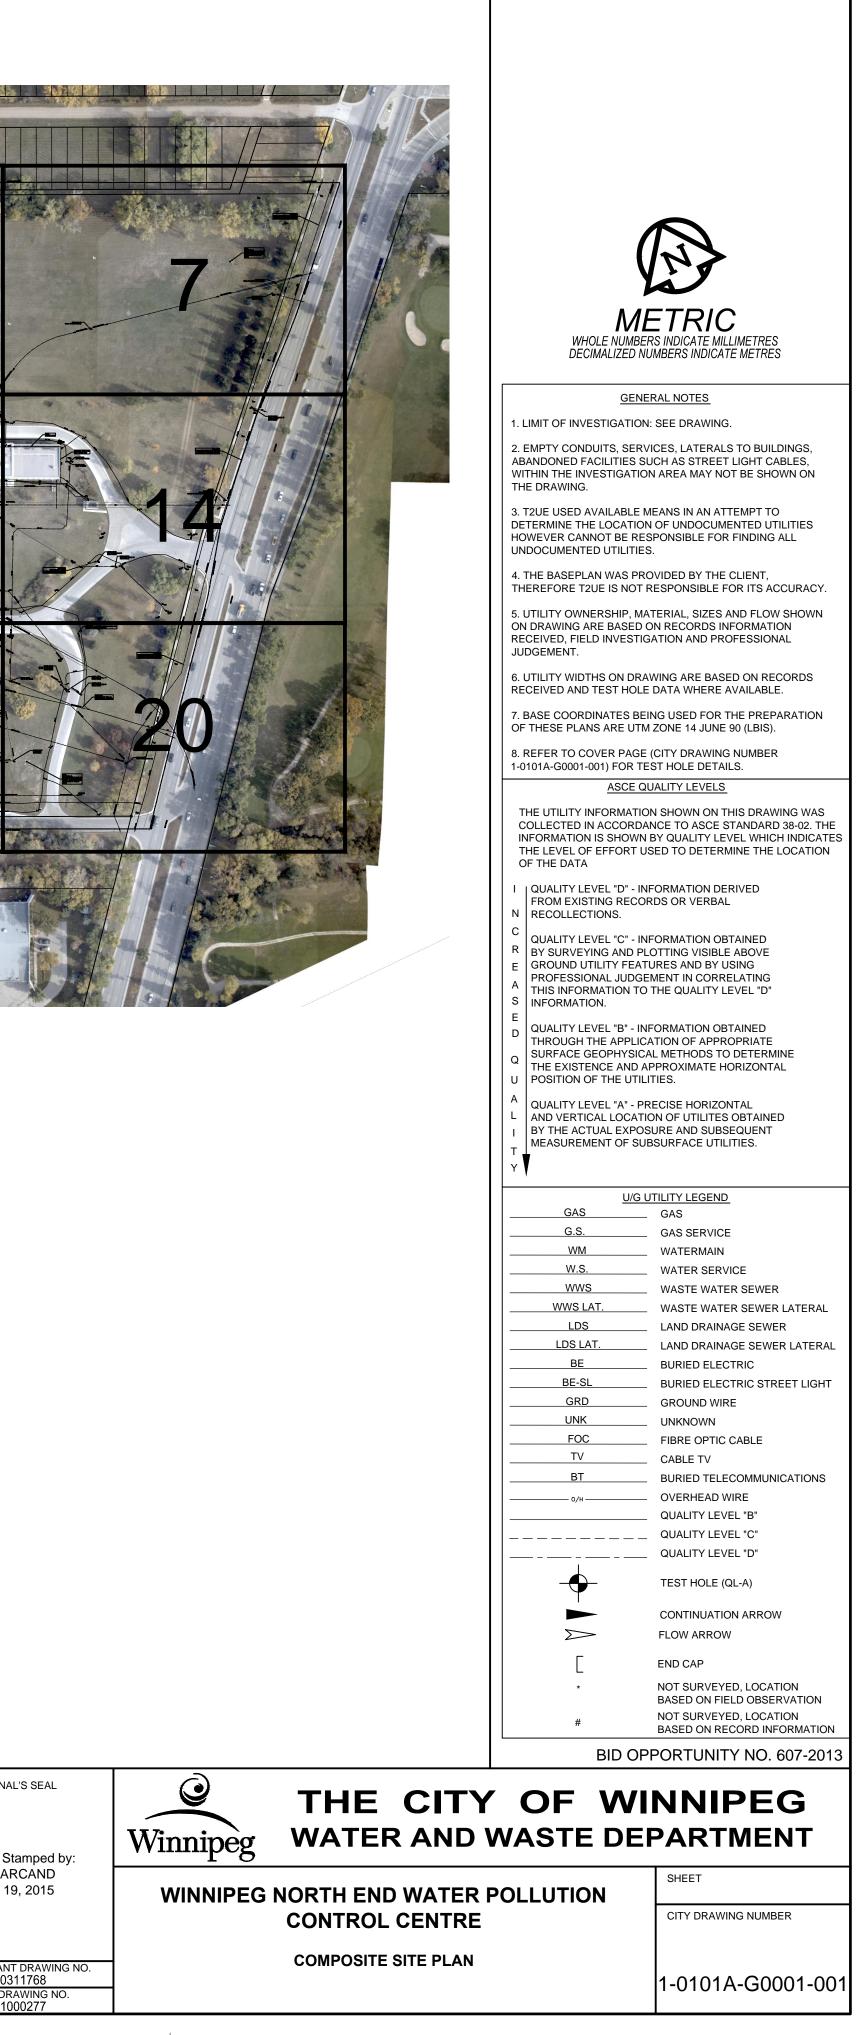






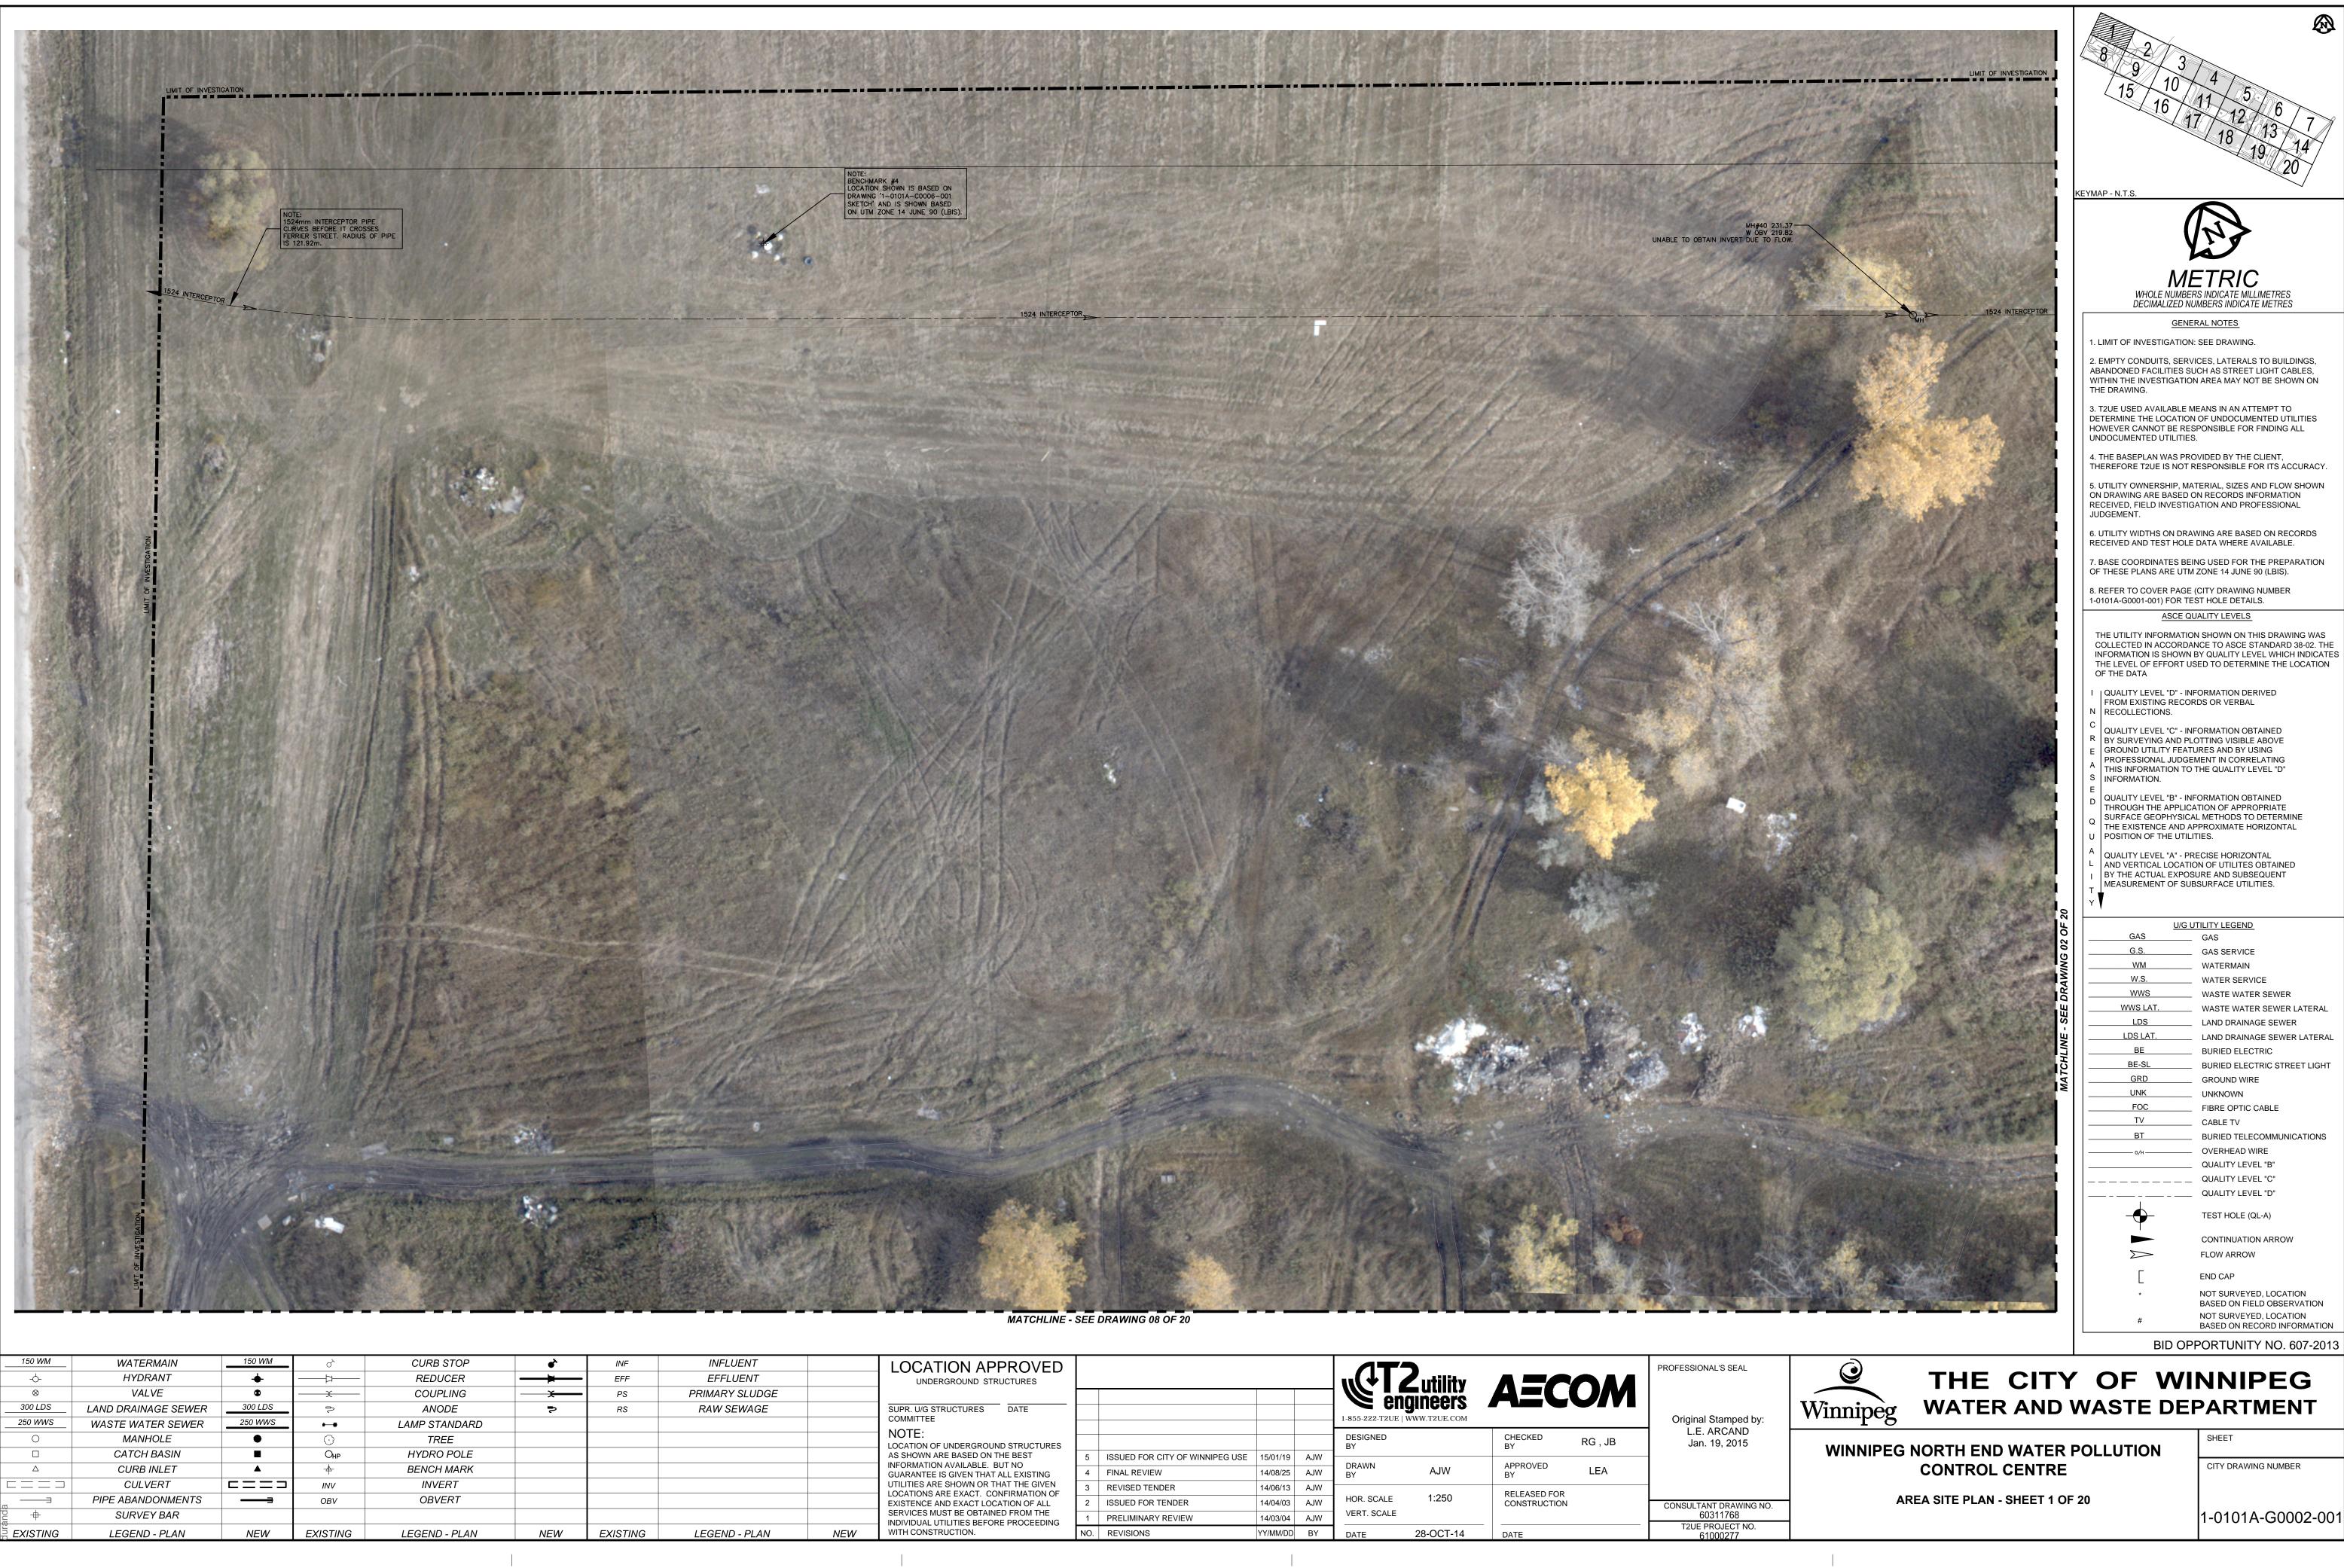

150 WM	WATERMAIN	150 WM	o <sup>ک</sup>	CURB STOP	•	INF	INFLUENT	
-0-	HYDRANT	+		REDUCER		EFF	EFFLUENT	
⊗	VALVE	0	—X	COUPLING	<b>— X</b> —	PS	PRIMARY SLUDGE	
300 LDS	LAND DRAINAGE SEWER	300 LDS	ĥ	ANODE	•	RS	RAW SEWAGE	
250 WWS	WASTE WATER SEWER	250 WWS	**	LAMP STANDARD				
0	MANHOLE	•	$\odot$	TREE				
	CATCH BASIN		Онр	HYDRO POLE				
	CURB INLET		+	BENCH MARK				
	CULVERT		INV	INVERT				
	PIPE ABANDONMENTS		OBV	OBVERT				
	SURVEY BAR							
EXISTING	LEGEND - PLAN	NEW	EXISTING	LEGEND - PLAN	NEW	EXISTING	LEGEND - PLAN	

	LOCATION APPROVED UNDERGROUND STRUCTURES SUPR. U/G STRUCTURES COMMITTEE						<b>Zutility</b> <b>gineers</b> www.t2ue.com	AEC	OM	PROFESSIONAL'S
	NOTE: LOCATION OF UNDERGROUND STRUCTURES					DESIGNED BY		CHECKED BY	RG , JB	L.E. AR Jan. 19,
	AS SHOWN ARE BASED ON THE BEST	5	ISSUED FOR CITY OF WINNIPEG USE	15/01/19	AJW					-
	INFORMATION AVAILABLE. BUT NO GUARANTEE IS GIVEN THAT ALL EXISTING	4	FINAL REVIEW	14/08/25	AJW	DRAWN BY	AJW	APPROVED BY	LEA	
	UTILITIES ARE SHOWN OR THAT THE GIVEN LOCATIONS ARE EXACT. CONFIRMATION OF	3	REVISED TENDER	14/06/13	AJW			RELEASED FOR		-
	EXISTENCE AND EXACT LOCATION OF ALL	2	ISSUED FOR TENDER	14/04/03	AJW	HOR. SCALE	1:250	CONSTRUCTION		CONSULTANT D
		1	PRELIMINARY REVIEW	14/03/04	AJW	VERT. SCALE				60311
/	INDIVIDUAL UTILITIES BEFORE PROCEEDING WITH CONSTRUCTION.	NO.	REVISIONS	YY/MM/DD	BY	DATE	28-OCT-14	DATE		T2UE PRO. 61000




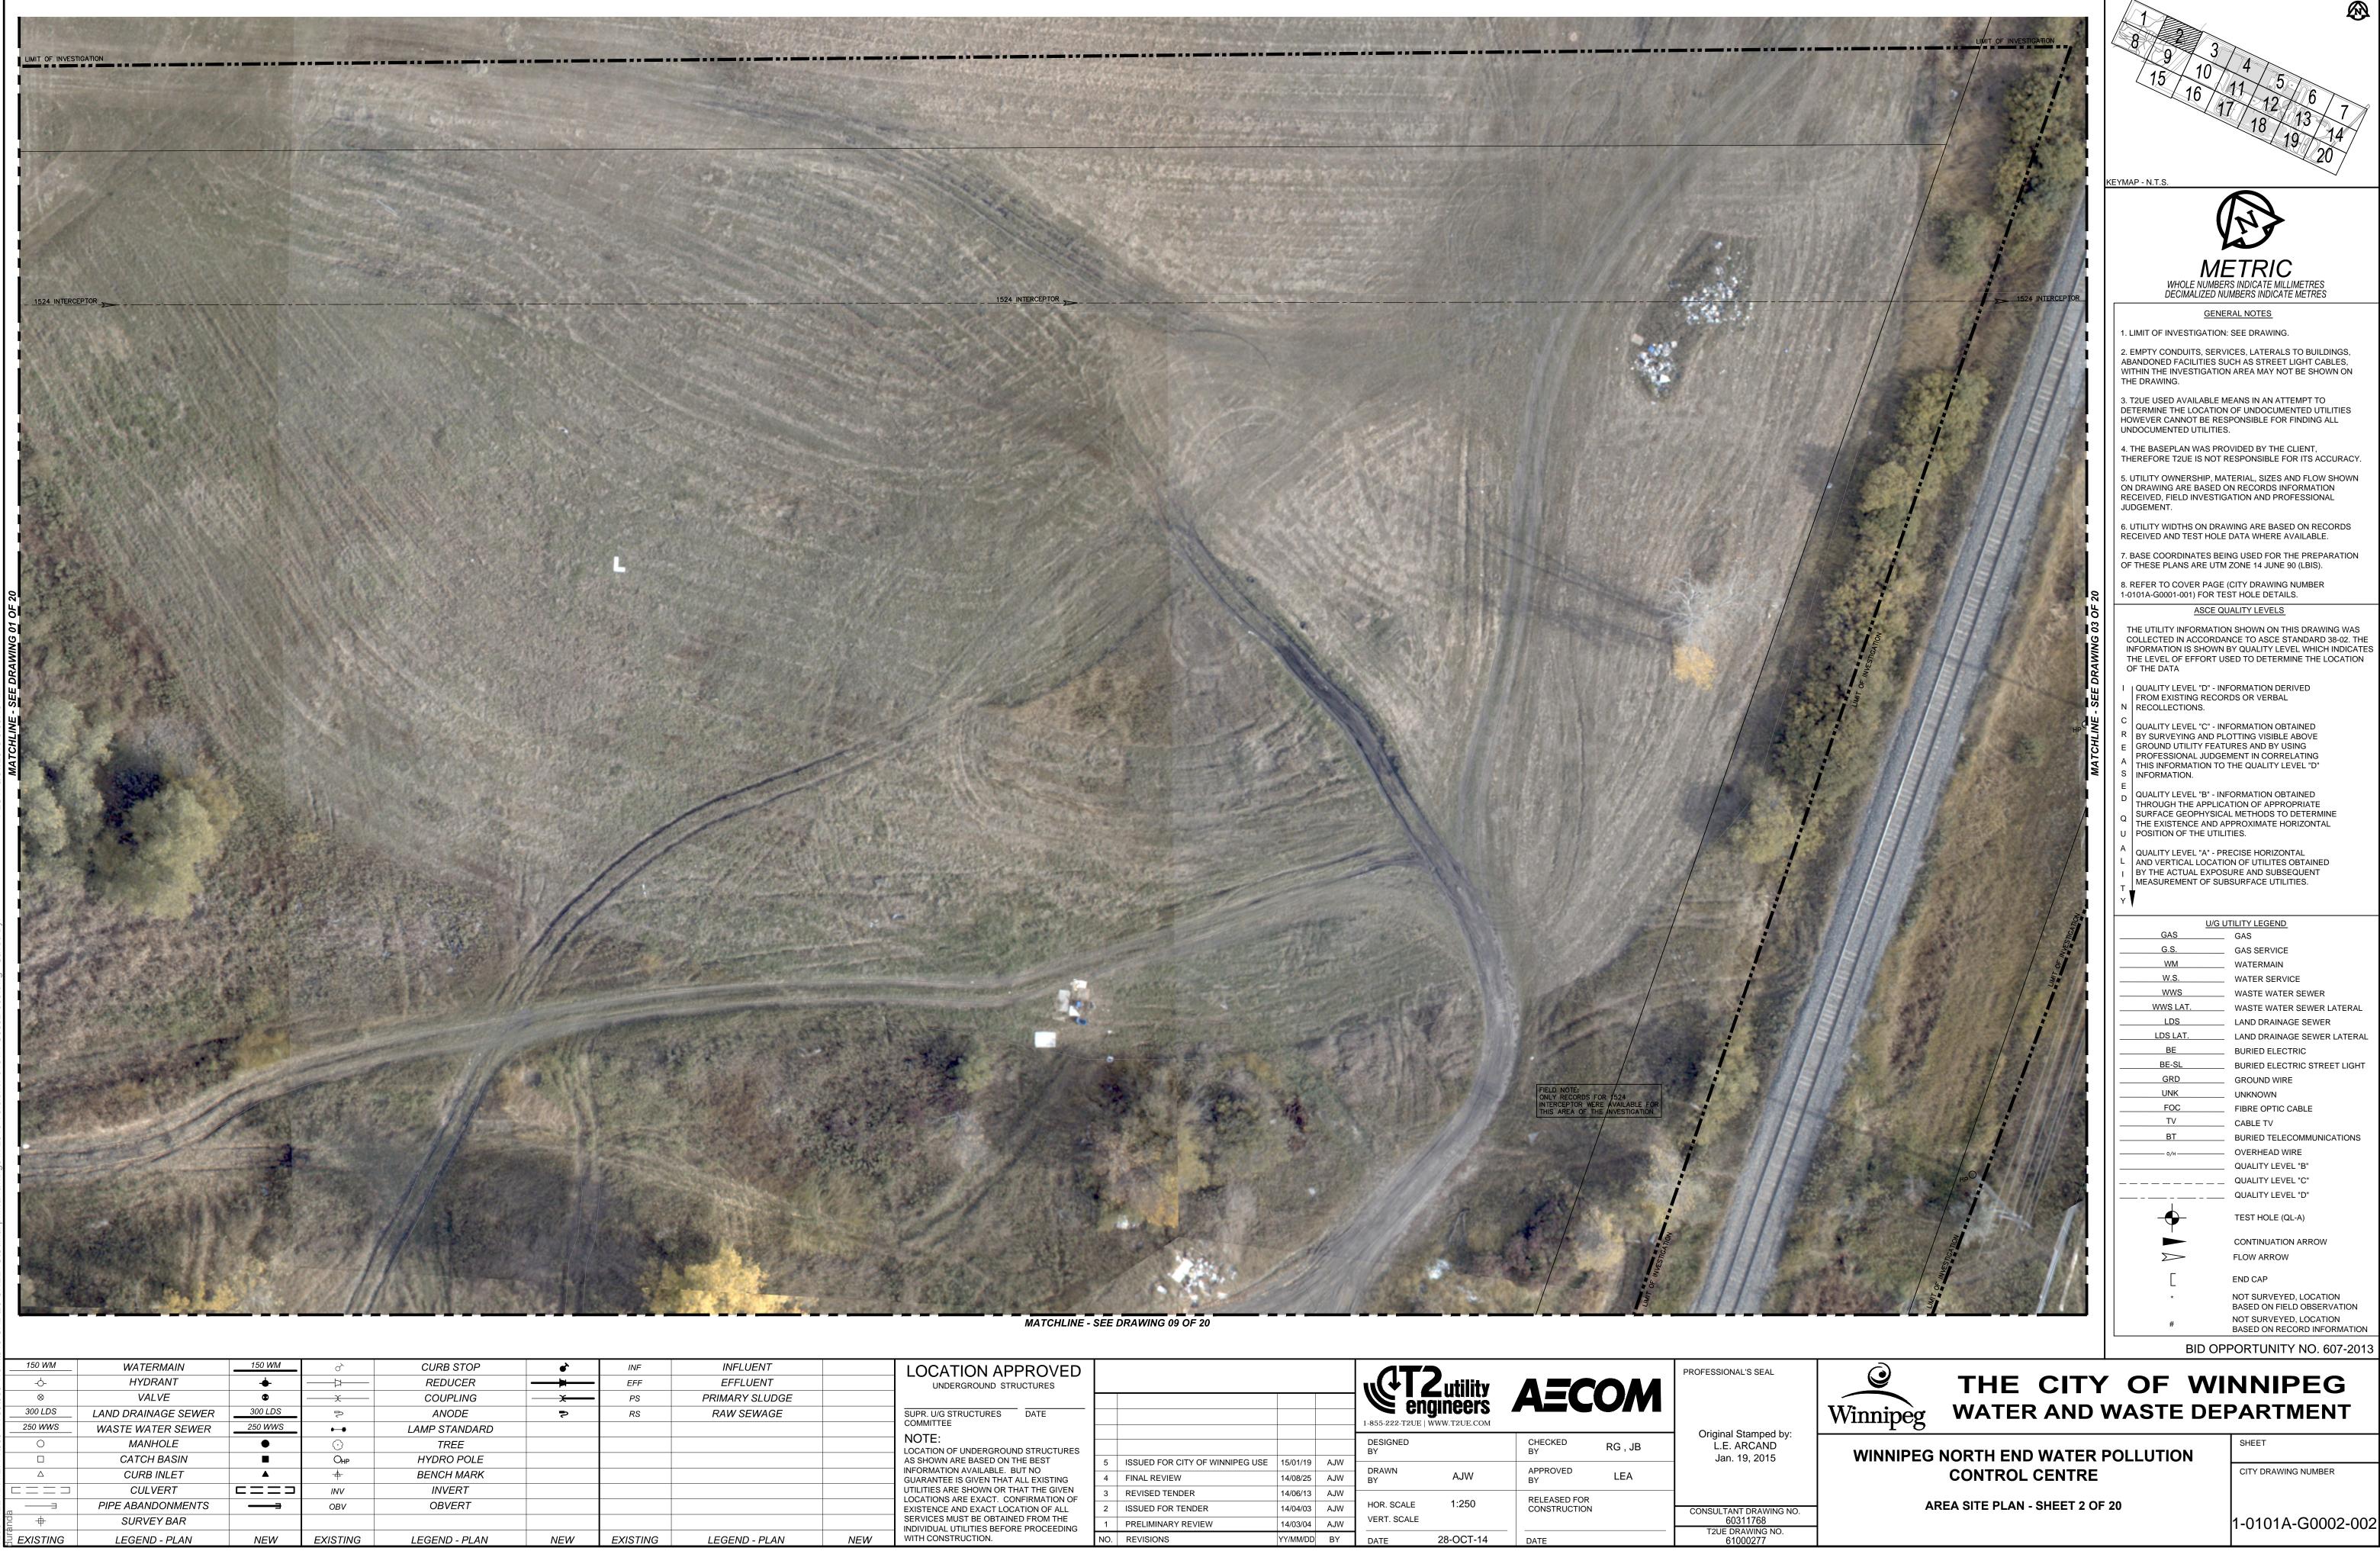

/ork	150 WM	WATERMAIN	150 WM	o <sup>ک</sup>	CURB STOP	<u>م</u>	INF	INFLUENT	
C	-0-	HYDRANT	- <b>+</b> -		REDUCER		EFF	EFFLUENT	
006\	$\otimes$	VALVE	۲	X	COUPLING	<b>X</b>	PS	PRIMARY SLUDGE	
768	300 LDS	LAND DRAINAGE SEWER	300 LDS	ĥ	ANODE	->	RS	RAW SEWAGE	
311.	250 WWS	WASTE WATER SEWER	250 WWS	+	LAMP STANDARD				
09	0	MANHOLE	•	$\odot$	TREE				
ġ.		CATCH BASIN		Онр	HYDRO POLE				
ME	Δ	CURB INLET	<b></b>	4	BENCH MARK				
NΑ		CULVERT		INV	INVERT				
Ш		PIPE ABANDONMENTS	<b>_</b>	OBV	OBVERT				
ue F	anda +	SURVEY BAR							
	EXISTING	LEGEND - PLAN	NEW	EXISTING	LEGEND - PLAN	NEW	EXISTING	LEGEND - PLAN	
			//2//	2,001110		11211	2/10/11/0		

	LOCATION APPROVED UNDERGROUND STRUCTURES					<b>CT</b>	<b>Z</b> utility gineers	AEC	OM	PROFESSIONAL
	SUPR. U/G STRUCTURES DATE COMMITTEE						WWW.T2UE.COM		<b>•</b> •••	
	NOTE: LOCATION OF UNDERGROUND STRUCTURES					DESIGNED BY		CHECKED BY	RG , JB	Original Sta L.E. AR
	AS SHOWN ARE BASED ON THE BEST	5	ISSUED FOR CITY OF WINNIPEG USE	15/01/19	AJW					Jan. 19
	INFORMATION AVAILABLE. BUT NO GUARANTEE IS GIVEN THAT ALL EXISTING	4	FINAL REVIEW	14/08/25	AJW	DRAWN BY	AJW	APPROVED BY	LEA	
	UTILITIES ARE SHOWN OR THAT THE GIVEN LOCATIONS ARE EXACT. CONFIRMATION OF	3	REVISED TENDER	14/06/13	AJW			RELEASED FOR		-
	EXISTENCE AND EXACT LOCATION OF ALL	2	ISSUED FOR TENDER	14/04/03	AJW	HOR. SCALE	1:250	CONSTRUCTION		CONSULTANT I
		1	PRELIMINARY REVIEW	14/03/04	AJW	VERT. SCALE				6031
/	INDIVIDUAL UTILITIES BEFORE PROCEEDING WITH CONSTRUCTION.	NO.	REVISIONS	YY/MM/DD	BY	DATE	28-OCT-14	DATE		T2UE DRAV 6100



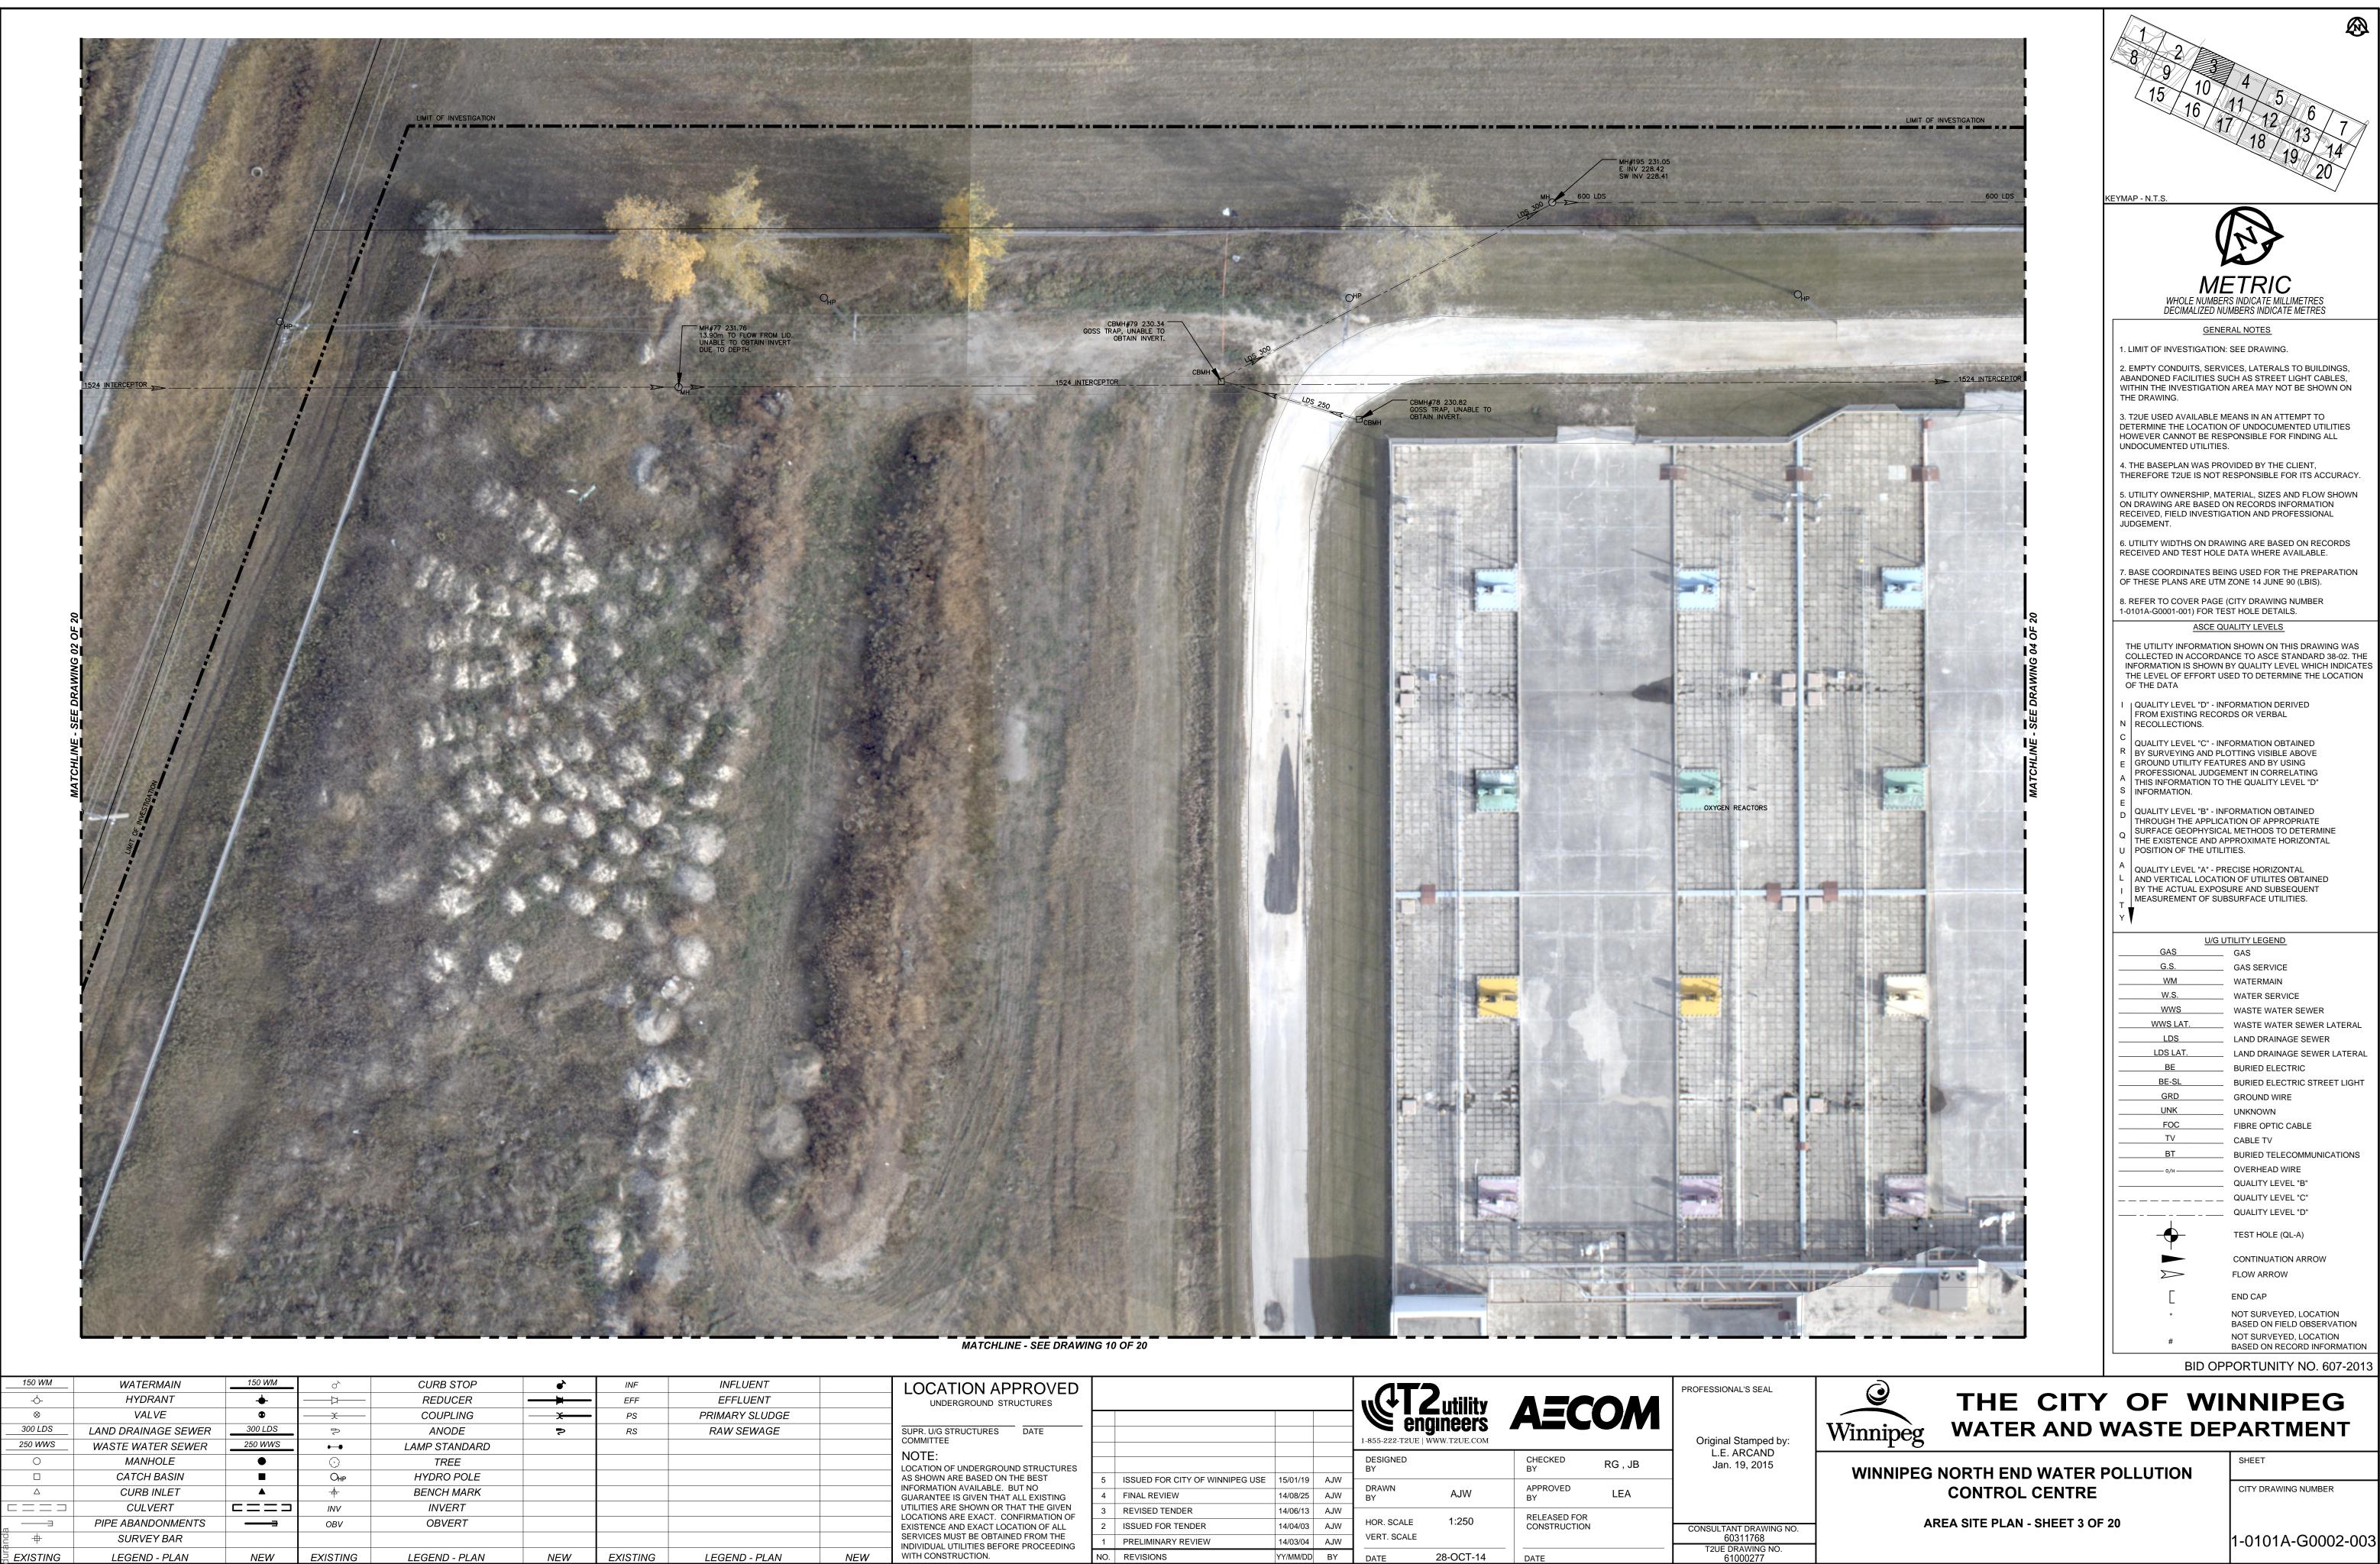


0,									
'ork'	150 WM	WATERMAIN	150 WM	0 <sup>×</sup>	CURB STOP	•	INF	INFLUENT	
N-0	-0-	HYDRANT	+		REDUCER	<b>—</b>	EFF	EFFLUENT	
/906	$\otimes$	VALVE	0	X	COUPLING	<b>X</b>	PS	PRIMARY SLUDGE	
768	300 LDS	LAND DRAINAGE SEWER	300 LDS	ĥ	ANODE	₽	RS	RAW SEWAGE	
311	250 WWS	WASTE WATER SEWER	250 WWS	**	LAMP STANDARD				
/603	0	MANHOLE	•	$\odot$	TREE				
ġ.		CATCH BASIN		Онр	HYDRO POLE				
ME	Δ	CURB INLET	<b></b>	4	BENCH MARK				
NA		CULVERT		INV	INVERT				
Ш	m	PIPE ABANDONMENTS		OBV	OBVERT				
E E	and the the the the the the the the the the	SURVEY BAR							
T2u	EXISTING	LEGEND - PLAN	NEW	EXISTING	LEGEND - PLAN	NEW	EXISTING	LEGEND - PLAN	

	LOCATION APPROVED UNDERGROUND STRUCTURES					"(‡T/	<b>2</b> tility			PROFESSIONAL'S
	SUPR. U/G STRUCTURES DATE COMMITTEE					1-855-222-T2UE	-	AEC		Original Star
	NOTE: LOCATION OF UNDERGROUND STRUCTURES					DESIGNED BY		CHECKED BY	RG , JB	L.E. ARC Jan. 19, 2
	AS SHOWN ARE BASED ON THE BEST	5	ISSUED FOR CITY OF WINNIPEG USE	15/01/19	AJW					-
	INFORMATION AVAILABLE. BUT NO GUARANTEE IS GIVEN THAT ALL EXISTING	4	FINAL REVIEW	14/08/25	AJW	DRAWN BY	AJW	APPROVED BY	LEA	
	UTILITIES ARE SHOWN OR THAT THE GIVEN LOCATIONS ARE EXACT. CONFIRMATION OF	3	REVISED TENDER	14/06/13	AJW			RELEASED FOR		
	EXISTENCE AND EXACT LOCATION OF ALL	2	ISSUED FOR TENDER	14/04/03	AJW	HOR. SCALE	1:250	CONSTRUCTION		CONSULTANT DR
	SERVICES MUST BE OBTAINED FROM THE	1	PRELIMINARY REVIEW	14/03/04	AJW	VERT. SCALE				603117
NEW	INDIVIDUAL UTILITIES BEFORE PROCEEDING WITH CONSTRUCTION.	NO.	REVISIONS	YY/MM/DD	BY	DATE	28-OCT-14	DATE		T2UE DRAWI 610002



	_									
	'ork'	150 WM	WATERMAIN	150 WM	0 <sup>×</sup>	CURB STOP	•	INF	INFLUENT	
	<b>M−C</b>	-¢-	HYDRANT	+		REDUCER		EFF	EFFLUENT	
<	/900	$\otimes$	VALVE	۹	X	COUPLING	<b>X</b>	PS	PRIMARY SLUDGE	
5	768	300 LDS	LAND DRAINAGE SEWER	300 LDS	N	ANODE	~	RS	RAW SEWAGE	
Ļ	311.	250 WWS	WASTE WATER SEWER	250 WWS	**	LAMP STANDARD				
	09	0	MANHOLE	•	$\odot$	TREE				
	Ū.		CATCH BASIN		Онр	HYDRO POLE				
>	ME	Δ	CURB INLET	<b></b>	<del>-</del>	BENCH MARK				
>	NA		CULVERT		INV	INVERT				
	Ш	т П	PIPE ABANDONMENTS	<del>3</del>	OBV	OBVERT				
ZUt	еFI	and 中	SURVEY BAR							
_	T2u	EXISTING	LEGEND - PLAN	NEW	EXISTING	LEGEND - PLAN	NEW	EXISTING	LEGEND - PLAN	

			MES 230.56 TEX LOU OUTANI NORTS. 124 INTERCEPTOR	MICHE LIQUOR CONDUL 1524 INTERCEPTOR 200 DRAIN MTCHTINE - SEE DRAVNING 03 01 30	CONTRICT OF THE PROVIDED BY THE CLIENT, THEREFORE SUCH AS STRATED AND PROVIDED BY THE CLIENT, THEREFORE SUCH AS STREET LIGHT CABLES, WITHIN THE INVESTIGATION AREA MAY NOT BE SHOWN ON THE DRAWING.      CONTROL OF CONTROL OF CONTROL OF THE CLIENT, THE ADVISTIGATION AREA MAY NOT BE SHOWN ON THE DRAWING.      THE DRAWING.      THE DRAWING.      TURUSTIGATION AREA MAY NOT BE SHOWN ON THE DRAWING.      TURUSTIGATION AREA MAY NOT BE SHOWN ON THE DRAWING.      TURUSTIGATION AREA MAY NOT BE SHOWN ON THE DRAWING.      TURUSTIGATION AREA MAY NOT BE SHOWN ON THE DRAWING.      TURUSTIGATION AREA MAY NOT BE SHOWN ON THE DRAWING.      TURUSTIGATION AREA MAY NOT BE SHOWN ON THE DRAWING.      TURUSTIGATION AREA MAY NOT BE SHOWN ON THE DRAWING.      TURUSTIGATION AREA MAY NOT BE SHOWN ON THE DRAWING.      TURUSTIGATION AREA MAY NOT BE SHOWN ON THE DRAWING.      TURUSTIGATION AREA MAY NOT BE SHOWN ON THE DRAWING.      TURUSTIGATION AREA MAY NOT BE SHOWN ON THE DRAWING.      TURUSTIGATION AREA MAY NOT BE SHOWN ON THE DRAWING.      TURUSTIGATION AREA MAY NOT BE SHOWN ON THE DRAWING ARE BASED ON RECORDS INFORMATION RECEIVED, FIELD INVESTIGATION AND PROFESSIONAL JUDGEMENT.      TURUSTIGATION SHOWN ON THE DRAWING ARE BASED ON RECORDS RECEIVED AND TEST HOLE DATA WHERE AVAILABLE.      ARECEIVED AND TEST HOLE DATA WHERE AVAILABLE.      ARECEIVED AND TEST HOLE DATA WHERE AVAILABLE.      ARECEIVED AND TEST HOLE DATA WHERE AVAILABLE.      DUCLETED IN ACCORDANCE TO ASCE STANDARD 38-02. THE INFORMATION SHOWN ON THE DRAWING NUMBER     1-01014-00001-001 FOR TEST HOLE DETAILS.      THE UTILITY WERENTION SHOWN ON THIS DRAWING WAS COLLECTED IN ACCORDANCE TO ASCE STANDARD 38-02. THE INFORMATION IS SHOWN BY OULLITY FEATURES AND BY OLALITY LEVEL WHICH INTOCATES THE LEVEL OF EFFORT USED TO DETERMINE THE LOCATION OF THE DATA.      DUALITY LEVEL 'D' - INFORMATION OBTAINED THE THE LOCATION OF THE DATA.      DUALITY LEVEL 'D' - INFORMATION OBTAINED THE THE LOCATION OF THE DATA.      DUALITY LEVEL 'D' - INFORMATION OBTAINED THE THE LOCATION OF THE DAT
			PROFESSIONAL'S SEAL Original Stamped by: L.E. ARCAND Jan. 19, 2015	Winnipeg WATER AND V WINNIPEG NORTH END WATER P	
GUARANTEE IS GIVEN THAT ALL EXISTING       4       FINAL RE         UTILITIES ARE SHOWN OR THAT THE GIVEN       3       REVISED         LOCATIONS ARE EXACT. CONFIRMATION OF       3       REVISED         EXISTENCE AND EXACT LOCATION OF ALL       2       ISSUED F	VIEW         14/08/25         AJW         BY           TENDER         14/06/13         AJW         HOR. SC/           'OR TENDER         14/04/03         AJW         HOR. SC/           JARY REVIEW         14/03/04         AJW         VERT. SC/	AJW BY LEA ALE 1:250 RELEASED FOR CONSTRUCTION	CONSULTANT DRAWING NO. 60311768 T2UE DRAWING NO. 61000277	CONTROL CENTRE AREA SITE PLAN - SHEET 4 OF 2	CITY DRAWING NUMBER 20 1-0101A-G0002-004

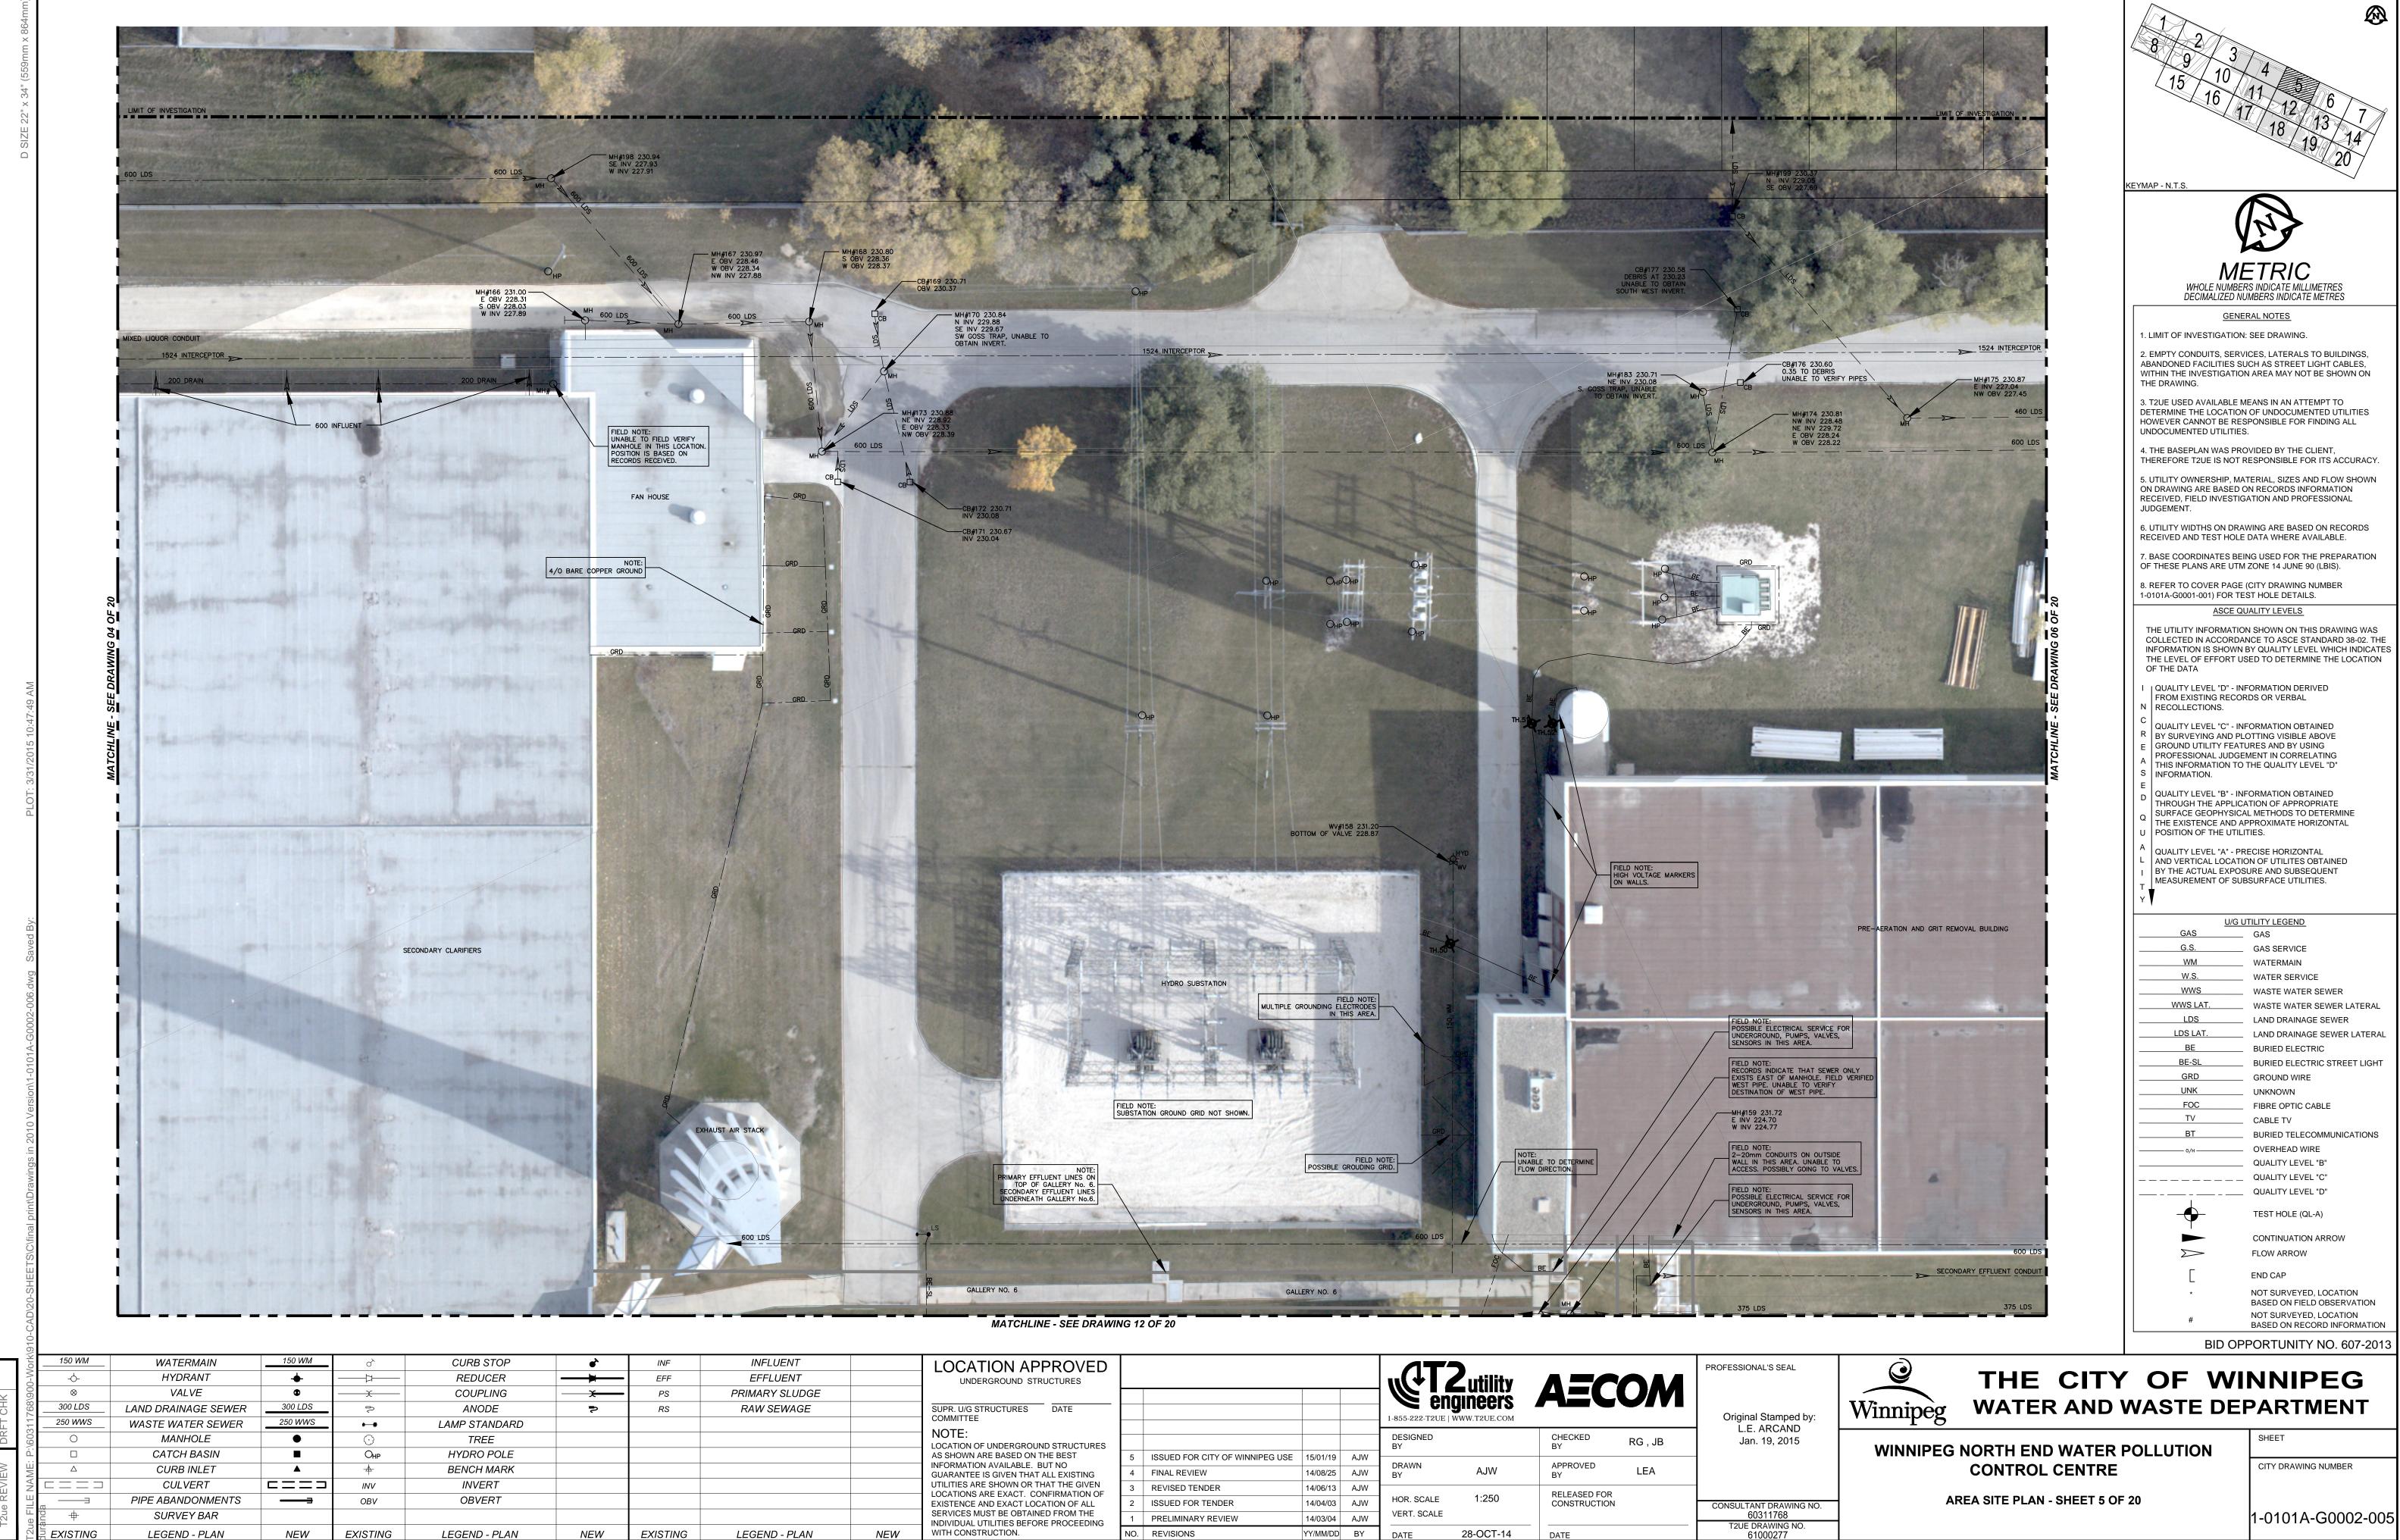

SURVEY BAR EXISTING LEGEND - PLAN

NEW

EXISTING

LEGEND - PLAN

NEW

EXISTING

LEGEND - PLAN

	LOCATION APPROVED UNDERGROUND STRUCTURES					(T	<b>Z</b> utility			PROFESSIONAL'S S
	SUPR. U/G STRUCTURES DATE COMMITTEE					1-855-222-T2UE	3	AEC	UM	Original Stan
	NOTE: LOCATION OF UNDERGROUND STRUCTURES AS SHOWN ARE BASED ON THE BEST					DESIGNED BY		CHECKED BY	RG , JB	L.E. ARC Jan. 19, 2
	INFORMATION AVAILABLE. BUT NO GUARANTEE IS GIVEN THAT ALL EXISTING	5 4	ISSUED FOR CITY OF WINNIPEG USE FINAL REVIEW	15/01/19 14/08/25	AJW	DRAWN BY	AJW	APPROVED BY	LEA	
	UTILITIES ARE SHOWN OR THAT THE GIVEN LOCATIONS ARE EXACT. CONFIRMATION OF	3	REVISED TENDER	14/06/13	AJW	HOR. SCALE	1:250	RELEASED FOR		
	EXISTENCE AND EXACT LOCATION OF ALL SERVICES MUST BE OBTAINED FROM THE	2	ISSUED FOR TENDER PRELIMINARY REVIEW	14/04/03 14/03/04	AJW	VERT. SCALE	1.250	CONSTRUCTION		CONSULTANT DR. 6031176
NEW	INDIVIDUAL UTILITIES BEFORE PROCEEDING WITH CONSTRUCTION.	NO.	REVISIONS	YY/MM/DD	-	DATE	28-OCT-14	DATE		T2UE DRAWIN 610002



SURVEY BAR EXISTING LEGEND - PLAN NEW EXISTING LEGEND - PLAN NEW EXISTING LEGEND - PLAN

	LOCATION APPROVED UNDERGROUND STRUCTURES					"(‡T/	<b>2</b> utility			PROFESSIONAL'S S
	SUPR. U/G STRUCTURES DATE COMMITTEE					1-855-222-T2UE	3	AEC		Original Star
	NOTE: LOCATION OF UNDERGROUND STRUCTURES					DESIGNED BY		CHECKED BY	RG , JB	L.E. ARC Jan. 19,
	AS SHOWN ARE BASED ON THE BEST INFORMATION AVAILABLE. BUT NO	5	ISSUED FOR CITY OF WINNIPEG USE	15/01/19		DRAWN	A 1) A /	APPROVED		
	GUARANTEE IS GIVEN THAT ALL EXISTING	4	FINAL REVIEW	14/08/25	AJW	BY	AJW	BY	LEA	
	UTILITIES ARE SHOWN OR THAT THE GIVEN LOCATIONS ARE EXACT. CONFIRMATION OF	3	REVISED TENDER	14/06/13	AJW		1.250	RELEASED FOR		
	EXISTENCE AND EXACT LOCATION OF ALL	2	ISSUED FOR TENDER	14/04/03	AJW	HOR. SCALE	1:250	CONSTRUCTION		CONSULTANT DR
	SERVICES MUST BE OBTAINED FROM THE INDIVIDUAL UTILITIES BEFORE PROCEEDING	1	PRELIMINARY REVIEW	14/03/04	AJW	VERT. SCALE				6031170 TOLIE DRAM
NEW	WITH CONSTRUCTION.	NO.	REVISIONS	YY/MM/DD	BY	DATE	28-OCT-14	DATE		T2UE DRAWII 610002



NEW


					-		
-0-	HYDRANT	+		REDUCER		EFF	EFFLUENT
8	VALVE	Ø	X	COUPLING	—— <del>X</del> ——	PS	PRIMARY SLUDGE
300 LDS	LAND DRAINAGE SEWER	300 LDS	ĥ	ANODE	P	RS	RAW SEWAGE
250 WWS	WASTE WATER SEWER	250 WWS	**	LAMP STANDARD			
0	MANHOLE	•	$\odot$	TREE			
	CATCH BASIN		Онр	HYDRO POLE			
Δ	CURB INLET	<b></b>	+	BENCH MARK			
$\equiv$ $\Box$ $\Box$	CULVERT		INV	INVERT			
	PIPE ABANDONMENTS		OBV	OBVERT			
<del>ф</del>	SURVEY BAR						
EXISTING	LEGEND - PLAN	NEW	EXISTING	LEGEND - PLAN	NEW	EXISTING	LEGEND - PLAN

LOCATION APPROVED         UNDERGROUND STRUCTURES         SUPR. U/G STRUCTURES         DATE         COMMITTEE					1-855-222-T2UE	9	AEC	ОМ	PROFESSIONAL'S SEAL
NOTE: LOCATION OF UNDERGROUND STRUCTURES					DESIGNED BY		CHECKED BY	RG , JB	Original Stamped by: L.E. ARCAND Jan. 19, 2015
AS SHOWN ARE BASED ON THE BEST INFORMATION AVAILABLE. BUT NO GUARANTEE IS GIVEN THAT ALL EXISTING	5 4	ISSUED FOR CITY OF WINNIPEG USE FINAL REVIEW	15/01/19 14/08/25	AJW AJW	DRAWN BY	AJW	APPROVED BY	LEA	
 UTILITIES ARE SHOWN OR THAT THE GIVEN LOCATIONS ARE EXACT. CONFIRMATION OF	3	REVISED TENDER	14/06/13	AJW	HOR. SCALE	1:250	RELEASED FOR		
 EXISTENCE AND EXACT LOCATION OF ALL SERVICES MUST BE OBTAINED FROM THE	2	ISSUED FOR TENDER PRELIMINARY REVIEW	14/04/03 14/03/04	AJW AJW	VERT. SCALE	1.200	CONSTRUCTION		CONSULTANT DRAWING NO. 60311768
INDIVIDUAL UTILITIES BEFORE PROCEEDING WITH CONSTRUCTION.	NO.	REVISIONS	14/03/04 YY/MM/DD	BY	DATE	28-OCT-14	DATE		T2UE DRAWING NO. 61000277

		8 2 3	
		15/10	4 5
LIMIT OF		16 17	12 6
	ERILAIN		18 19 14
	400 FEELERMINAIN		207
	Онр	KEYMAP - N.T.S.	
		Y Y	N
		ME	TRIC
		WHOLE NUMBER	S INDICATE MILLIMETRES MBERS INDICATE METRES
		GENER 1. LIMIT OF INVESTIGATION:	AL NOTES SEE DRAWING.
	MAIN STREET	ABANDONED FACILITIES SU	CES, LATERALS TO BUILDINGS, CH AS STREET LIGHT CABLES, AREA MAY NOT BE SHOWN ON
		3. T2UE USED AVAILABLE ME DETERMINE THE LOCATION HOWEVER CANNOT BE RESI UNDOCUMENTED UTILITIES.	OF UNDOCUMENTED UTILITIES
		4. THE BASEPLAN WAS PRO THEREFORE T2UE IS NOT RI	VIDED BY THE CLIENT, ESPONSIBLE FOR ITS ACCURACY.
		5. UTILITY OWNERSHIP, MAT ON DRAWING ARE BASED OI RECEIVED, FIELD INVESTIGA JUDGEMENT.	
			/ING ARE BASED ON RECORDS DATA WHERE AVAILABLE.
/	11 111 1 1 1 500 1	7. BASE COORDINATES BEIN OF THESE PLANS ARE UTM 2	IG USED FOR THE PREPARATION ZONE 14 JUNE 90 (LBIS).
		8. REFER TO COVER PAGE ( 1-0101A-G0001-001) FOR TES	
	1 1 1		ALITY LEVELS
PCEPIOR		INFORMATION IS SHOWN B	ICE TO ASCE STANDARD 38-02. THE Y QUALITY LEVEL WHICH INDICATES ED TO DETERMINE THE LOCATION
LINIT OF INVESTIGATE		I QUALITY LEVEL "D" - INF FROM EXISTING RECOR N RECOLLECTIONS.	
MIT OF INVESTIG	1 Protect of 1	C QUALITY LEVEL "C" - INF R BY SURVEYING AND PLC E GROUND UTILITY FEATU	TTING VISIBLE ABOVE
ļ		A THIS INFORMATION TO T S INFORMATION.	IENT IN CORRELATING
Ť.	and the second produce	E D URLAUTY LEVEL "B" - INFA THROUGH THE APPLICA	TION OF APPROPRIATE
<u>i</u>	N IS THE		. METHODS TO DETERMINE PROXIMATE HORIZONTAL IES.
i	1 1 2 2 2 2 1	A QUALITY LEVEL "A" - PRE L AND VERTICAL LOCATIO	N OF UTILITES OBTAINED
	A REAL	T Y	SURFACE UTILITIES.
14		<u>U/G UT</u>	ILITY LEGEND GAS
		G.S WM	GAS SERVICE WATERMAIN
		W.S	WATER SERVICE WASTE WATER SEWER
H		UWS_LATLDS	WASTE WATER SEWER LATERAL LAND DRAINAGE SEWER
	the 1	BE	LAND DRAINAGE SEWER LATERAL BURIED ELECTRIC
1		BE-SL GRD	BURIED ELECTRIC STREET LIGHT GROUND WIRE
1		UNK FOC	UNKNOWN FIBRE OPTIC CABLE
	and the second second	тv вт	CABLE TV BURIED TELECOMMUNICATIONS
1200	I I I E MANNE	0/H	OVERHEAD WIRE
PAG.			QUALITY LEVEL "B" QUALITY LEVEL "C"
STREET	E I THE E		QUALITY LEVEL "D" TEST HOLE (QL-A)
S MIL			CONTINUATION ARROW
			FLOW ARROW
and an	1 1 1 1 1 1		END CAP NOT SURVEYED, LOCATION
S. Ir		#	BASED ON FIELD OBSERVATION NOT SURVEYED, LOCATION BASED ON RECORD INFORMATION
		BID OPF	PORTUNITY NO. 607-2013
SEAL			
amped by:		D WASTE DEF	
CAND , 2015	WINNIPEG NORTH END WATE	ER POLLUTION	SHEET
	CONTROL CENTI		CITY DRAWING NUMBER

AREA SITE PLAN - SHEET 7 OF 20



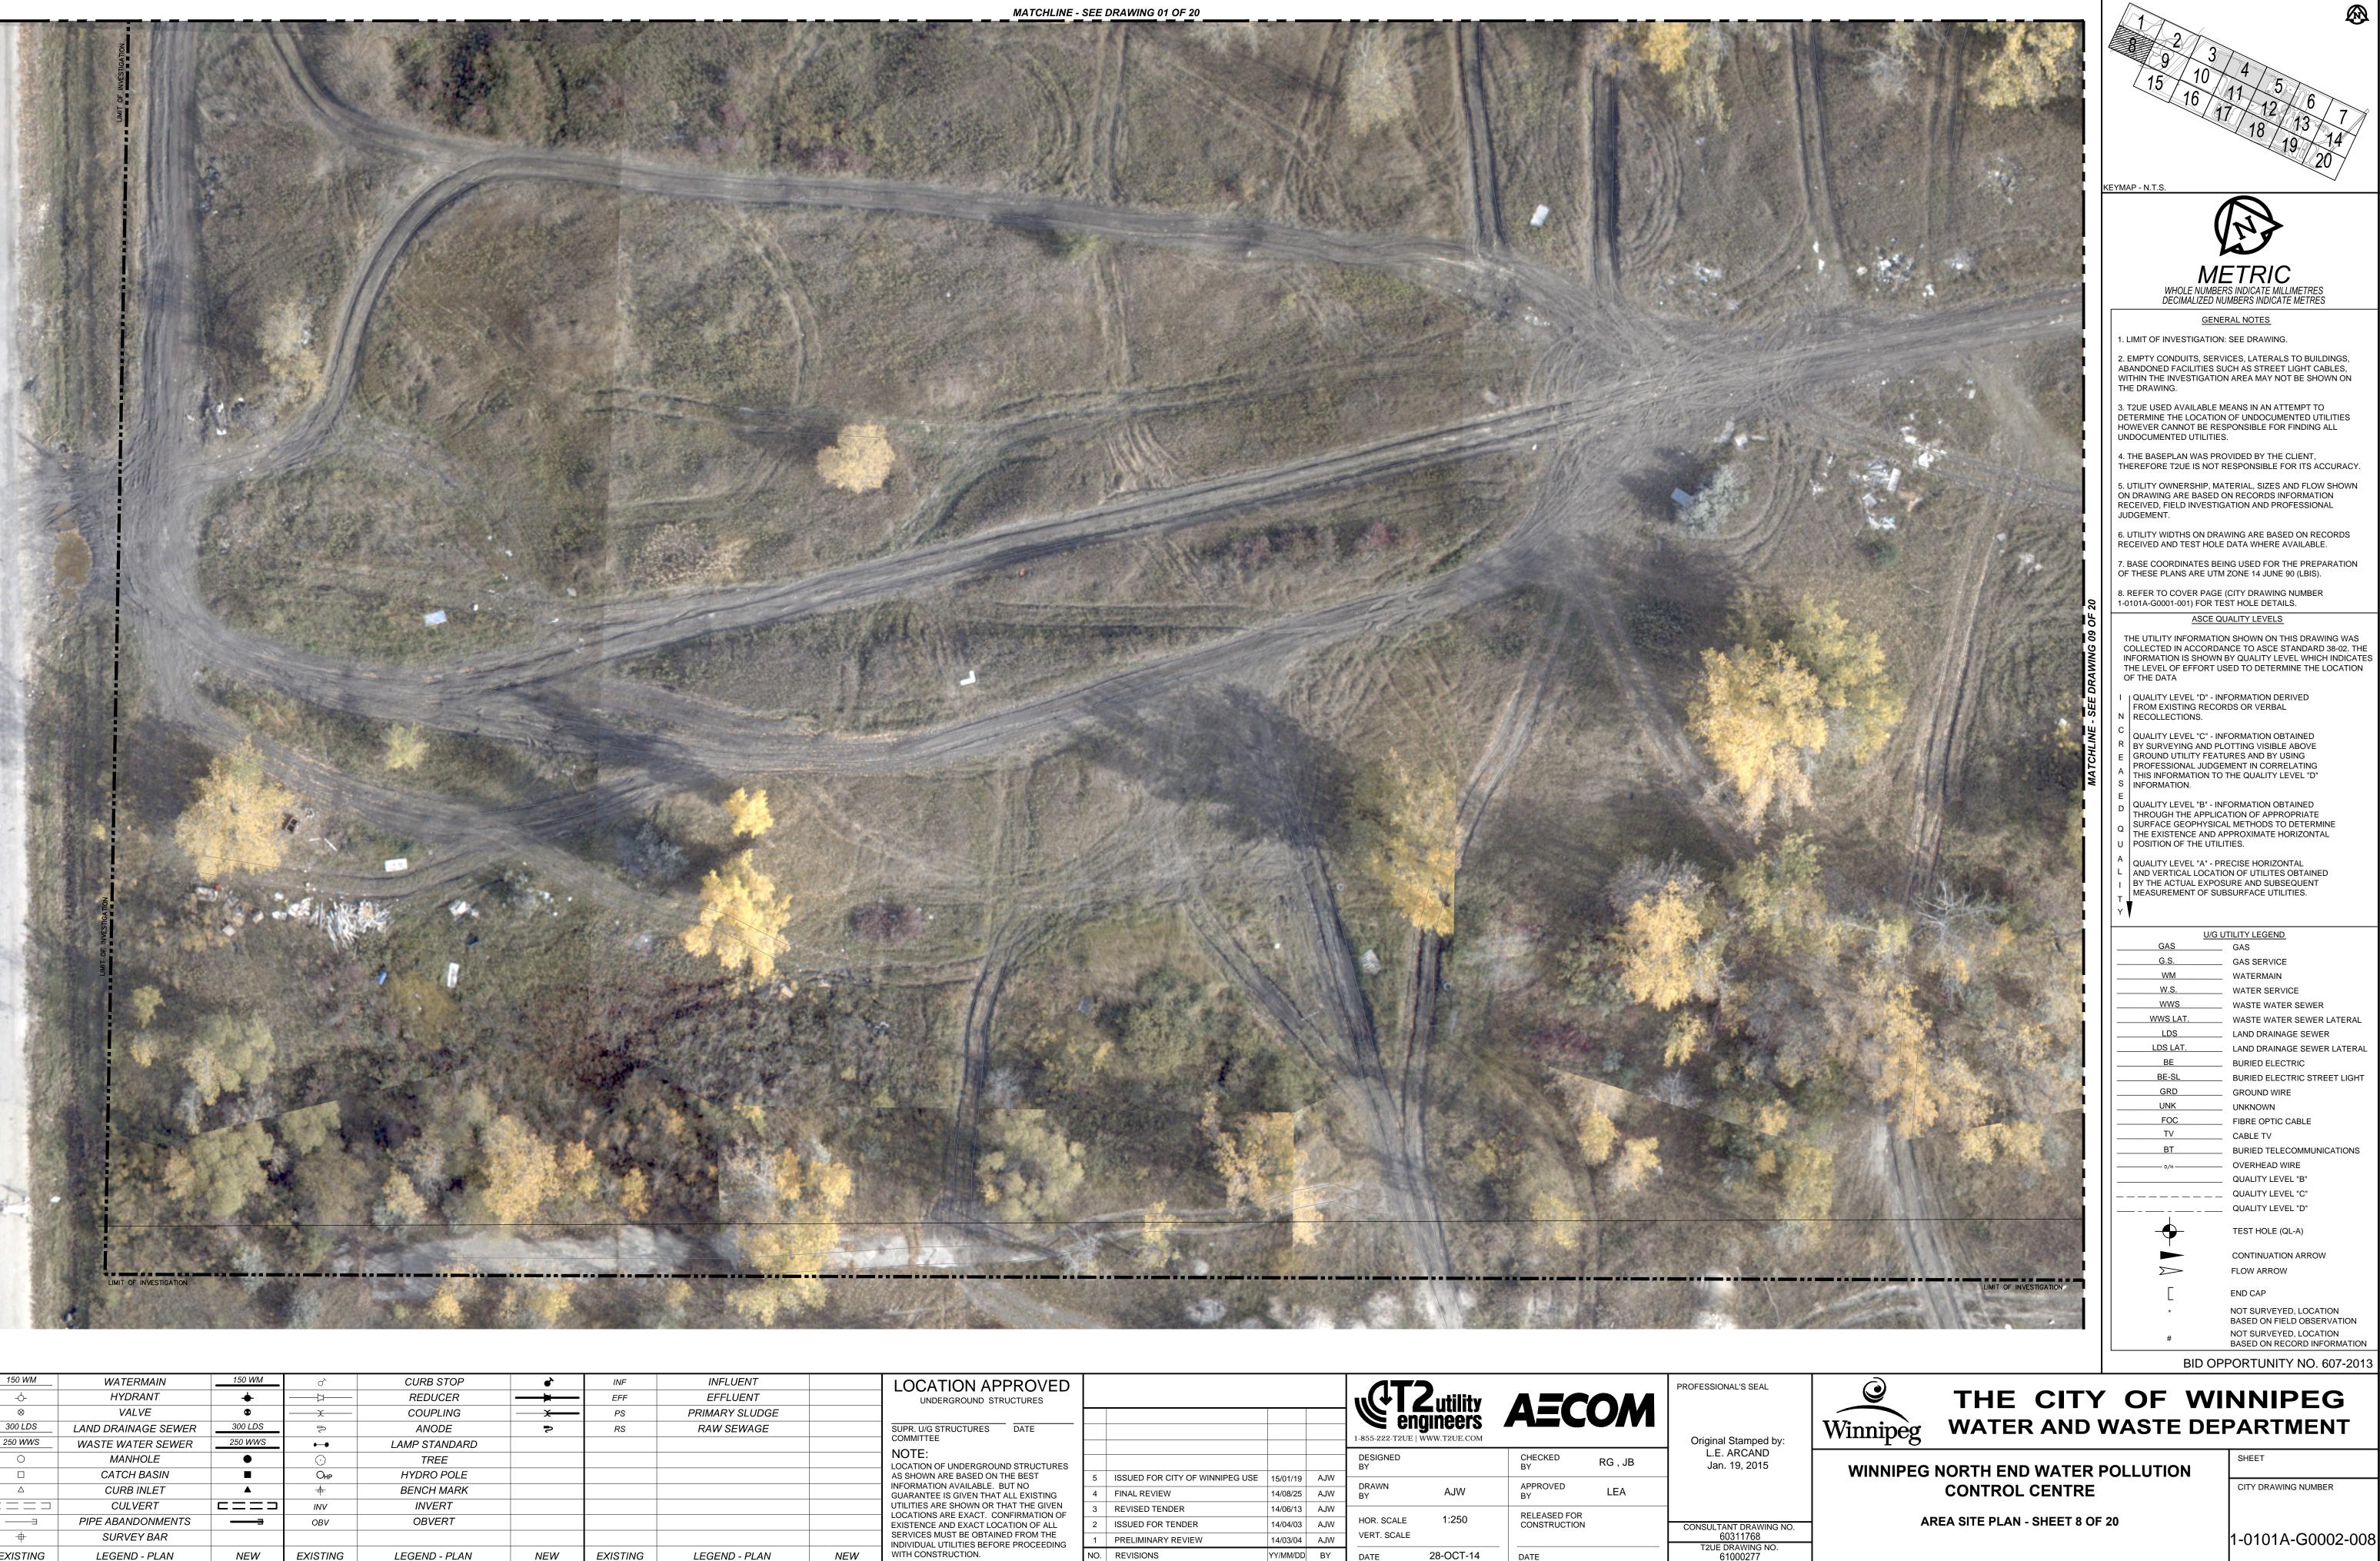


~	2								
ork,	150 WM	WATERMAIN	150 WM	°≻	CURB STOP	•	INF	INFLUENT	
V-C	-0-	HYDRANT	+		REDUCER		EFF	EFFLUENT	
000		VALVE	۲	X	COUPLING	<b>X</b>	PS	PRIMARY SLUDGE	
768	300 LDS	LAND DRAINAGE SEWER	300 LDS	٦ ک	ANODE	2	RS	RAW SEWAGE	
	250 WWS	WASTE WATER SEWER	250 WWS	•	LAMP STANDARD				
09	0	MANHOLE		$\odot$	TREE				
à		CATCH BASIN		Онр	HYDRO POLE				
Ш	Δ	CURB INLET	<b></b>	<u>+</u>	BENCH MARK				
ΔN		CULVERT		INV	INVERT				
Ш.		PIPE ABANDONMENTS	<del></del>	OBV	OBVERT				
LL Q	and t	SURVEY BAR							
ТО.		LEGEND - PLAN	NEW	EXISTING	LEGEND - PLAN	NEW	EXISTING	LEGEND - PLAN	
				•			•		

LOCATION APPROVED UNDERGROUND STRUCTURES SUPR. U/G STRUCTURES COMMITTEE					1-855-222-T2UE	3	AEC	OM	PROFESSIONAL'S Original Stan
NOTE: LOCATION OF UNDERGROUND STRUCTURES					DESIGNED BY		CHECKED BY	RG , JB	L.E. ARC Jan. 19, 2
AS SHOWN ARE BASED ON THE BEST INFORMATION AVAILABLE. BUT NO	5	ISSUED FOR CITY OF WINNIPEG USE	15/01/19	AJW	DRAWN				
GUARANTEE IS GIVEN THAT ALL EXISTING	4	FINAL REVIEW	14/08/25	AJW	BY	AJW	APPROVED BY	LEA	
UTILITIES ARE SHOWN OR THAT THE GIVEN LOCATIONS ARE EXACT. CONFIRMATION OF	3	REVISED TENDER	14/06/13	AJW			RELEASED FOR		
EXISTENCE AND EXACT LOCATION OF ALL	2	ISSUED FOR TENDER	14/04/03	AJW	HOR. SCALE	1:250	CONSTRUCTION		CONSULTANT DF
SERVICES MUST BE OBTAINED FROM THE	1	PRELIMINARY REVIEW	14/03/04	AJW	VERT. SCALE				603117
INDIVIDUAL UTILITIES BEFORE PROCEEDING WITH CONSTRUCTION.	NO.	REVISIONS	YY/MM/DD	BY	DATE	28-OCT-14	DATE		T2UE DRAW 610002




		1:50	No. State		P. C. Charles		
10.dwg Saved By							
01A-GUUU2-U		1			Lei		
Version/1-UI		K					
					Contraction of	11	
	A REAL PROPERTY OF A REAL PROPER						
		190	25 A 64	ins man is	1		The second
CVtinal print/Urawing							
SHEE I S/C/tinal print/Drawing							
0-CAU/20-SHEE I S/C/final print/Drawing	LIMIT OF INVESTIGATION						
	LIMIT OF INVESTIGATION		<i>d</i>	CURB STOP	s and the second	INF	INFLUE
0-Work/910-CAD/20-SHEETS/C/final print/Drawing	WATERMAIN HYDRANT	+		REDUCER		INF EFF	EFFLUI
8)900-Work/910-CAD/20-SHEETS/C/final print/Drawing	WATERMAIN HYDRANT VALVE	• •	——	REDUCER COUPLING	— ► — X	<ul> <li>EFF</li> <li>PS</li> </ul>	EFFLUE PRIMARY S
1268\900-Work\910-CAD\20-SHEETS\C\final print\Drawing	WATERMAIN HYDRANT VALVE LAND DRAINAGE SEWER			REDUCER COUPLING ANODE		• EFF	EFFLUI
0311768/900-Work/910-CAD/20-SHEETS/C/final print/Drawing	<ul> <li>WATERMAIN</li> <li>HYDRANT</li> <li>VALVE</li> <li>LAND DRAINAGE SEWER</li> <li>WASTE WATER SEWER</li> </ul>			REDUCER COUPLING ANODE LAMP STANDARD	— ► — X	<ul> <li>EFF</li> <li>PS</li> </ul>	EFFLUE PRIMARY S
11768\900-Work\910-CAD\20-SHEETS\C\final print\Drawing 120 MM 120 MM -↔ 300 FDS 250 MWS ○ ○	<ul> <li>WATERMAIN</li> <li>HYDRANT</li> <li>VALVE</li> <li>LAND DRAINAGE SEWER</li> <li>WASTE WATER SEWER</li> <li>MANHOLE</li> </ul>		→ → → → · · · · ·	REDUCER COUPLING ANODE LAMP STANDARD TREE	— ► — X	<ul> <li>EFF</li> <li>PS</li> </ul>	EFFLUE PRIMARY S
	<ul> <li>WATERMAIN</li> <li>HYDRANT</li> <li>VALVE</li> <li>LAND DRAINAGE SEWER</li> <li>WASTE WATER SEWER</li> <li>MANHOLE</li> <li>CATCH BASIN</li> </ul>		→ → → → · → ·	REDUCER COUPLING ANODE LAMP STANDARD TREE HYDRO POLE	— ► — X	<ul> <li>EFF</li> <li>PS</li> </ul>	EFFLUE PRIMARY S
	<ul> <li>WATERMAIN</li> <li>HYDRANT</li> <li>VALVE</li> <li>LAND DRAINAGE SEWER</li> <li>WASTE WATER SEWER</li> <li>MANHOLE</li> <li>CATCH BASIN</li> <li>CURB INLET</li> </ul>	↓       ③       300 LDS       250 WWS       ↓	↓     ↓       ×     ↓       >     ↓       ↓     ↓       ↓     ↓       ↓     ↓	REDUCER COUPLING ANODE LAMP STANDARD TREE HYDRO POLE BENCH MARK	— ► — X	<ul> <li>EFF</li> <li>PS</li> </ul>	EFFLUE PRIMARY S
	<ul> <li>WATERMAIN</li> <li>HYDRANT</li> <li>VALVE</li> <li>LAND DRAINAGE SEWER</li> <li>WASTE WATER SEWER</li> <li>MANHOLE</li> <li>CATCH BASIN</li> <li>CURB INLET</li> <li>CULVERT</li> </ul>		→ → · · · · · · · · · · · · · · · · · ·	REDUCER COUPLING ANODE LAMP STANDARD TREE HYDRO POLE BENCH MARK INVERT	— ► — X	<ul> <li>EFF</li> <li>PS</li> </ul>	EFFLUE PRIMARY S
→ → → → → → → → → → → → → →	<ul> <li>WATERMAIN</li> <li>HYDRANT</li> <li>VALVE</li> <li>LAND DRAINAGE SEWER</li> <li>WASTE WATER SEWER</li> <li>MANHOLE</li> <li>CATCH BASIN</li> <li>CURB INLET</li> </ul>	↓       ③       300 LDS       250 WWS       ↓	↓     ↓       ×     ↓       >     ↓       ↓     ↓       ↓     ↓       ↓     ↓       ↓     ↓	REDUCER COUPLING ANODE LAMP STANDARD TREE HYDRO POLE BENCH MARK	— ► — X	<ul> <li>EFF</li> <li>PS</li> </ul>	EFFLUE PRIMARY S

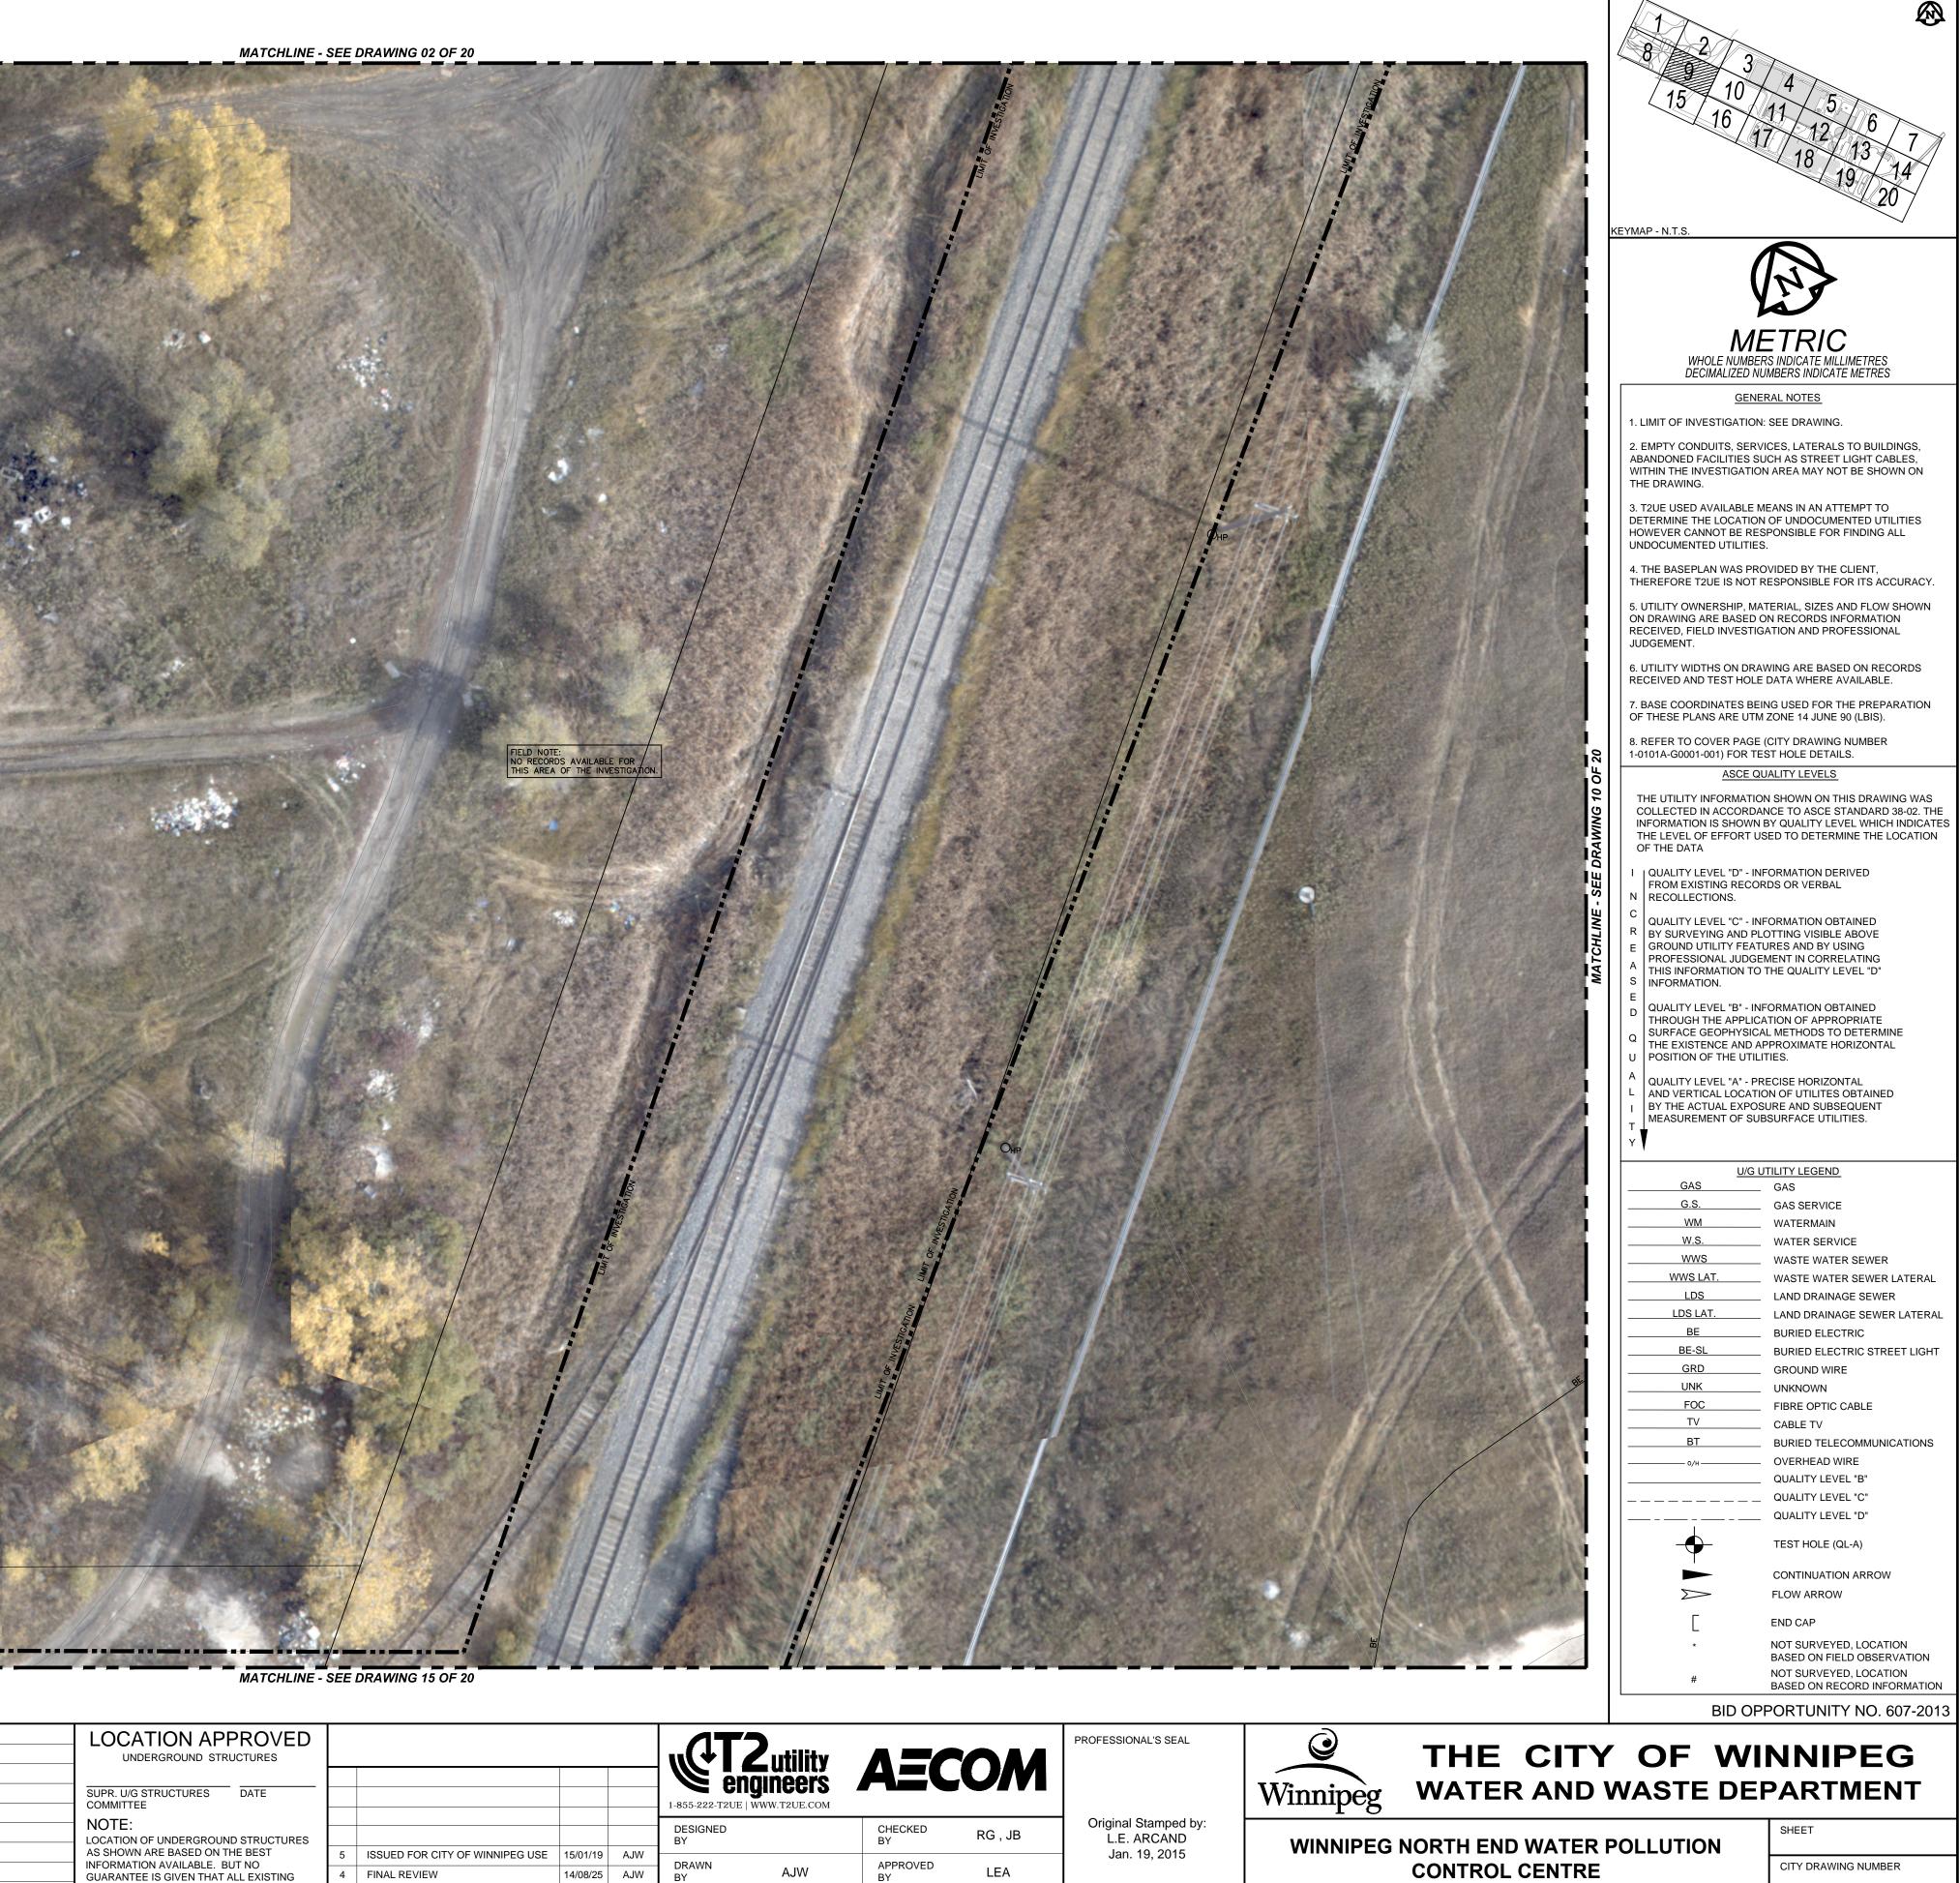

	LOCATION APPROVED UNDERGROUND STRUCTURES					<b>CT</b>	2 utility gineers	AEC	OM	PROFESSIONAL'S SEAL
	SUPR. U/G STRUCTURES DATE COMMITTEE					1-855-222-T2UE   1	3		<b>•</b> •••	
	NOTE: LOCATION OF UNDERGROUND STRUCTURES					DESIGNED BY		CHECKED BY	RG , JB	Original Stamped by: L.E. ARCAND
	AS SHOWN ARE BASED ON THE BEST	5	ISSUED FOR CITY OF WINNIPEG USE	15/01/19	AJW					Jan. 19, 2015
	INFORMATION AVAILABLE. BUT NO GUARANTEE IS GIVEN THAT ALL EXISTING	4	FINAL REVIEW	14/08/25	AJW	DRAWN BY	AJW	APPROVED BY	LEA	
	UTILITIES ARE SHOWN OR THAT THE GIVEN LOCATIONS ARE EXACT. CONFIRMATION OF	3	REVISED TENDER	14/06/13	AJW			RELEASED FOR		
	EXISTENCE AND EXACT LOCATION OF ALL	2	ISSUED FOR TENDER	14/04/03	AJW	HOR. SCALE	1:250	CONSTRUCTION		CONSULTANT DRAWING NO.
	SERVICES MUST BE OBTAINED FROM THE INDIVIDUAL UTILITIES BEFORE PROCEEDING	1	PRELIMINARY REVIEW	14/03/04	AJW	VERT. SCALE				60311768
NEW	WITH CONSTRUCTION.	NO.	REVISIONS	YY/MM/DD	BY	DATE	28-OCT-14	DATE		T2UE DRAWING NO. 61000277


AREA SITE PLAN - SHEET 9 OF 20

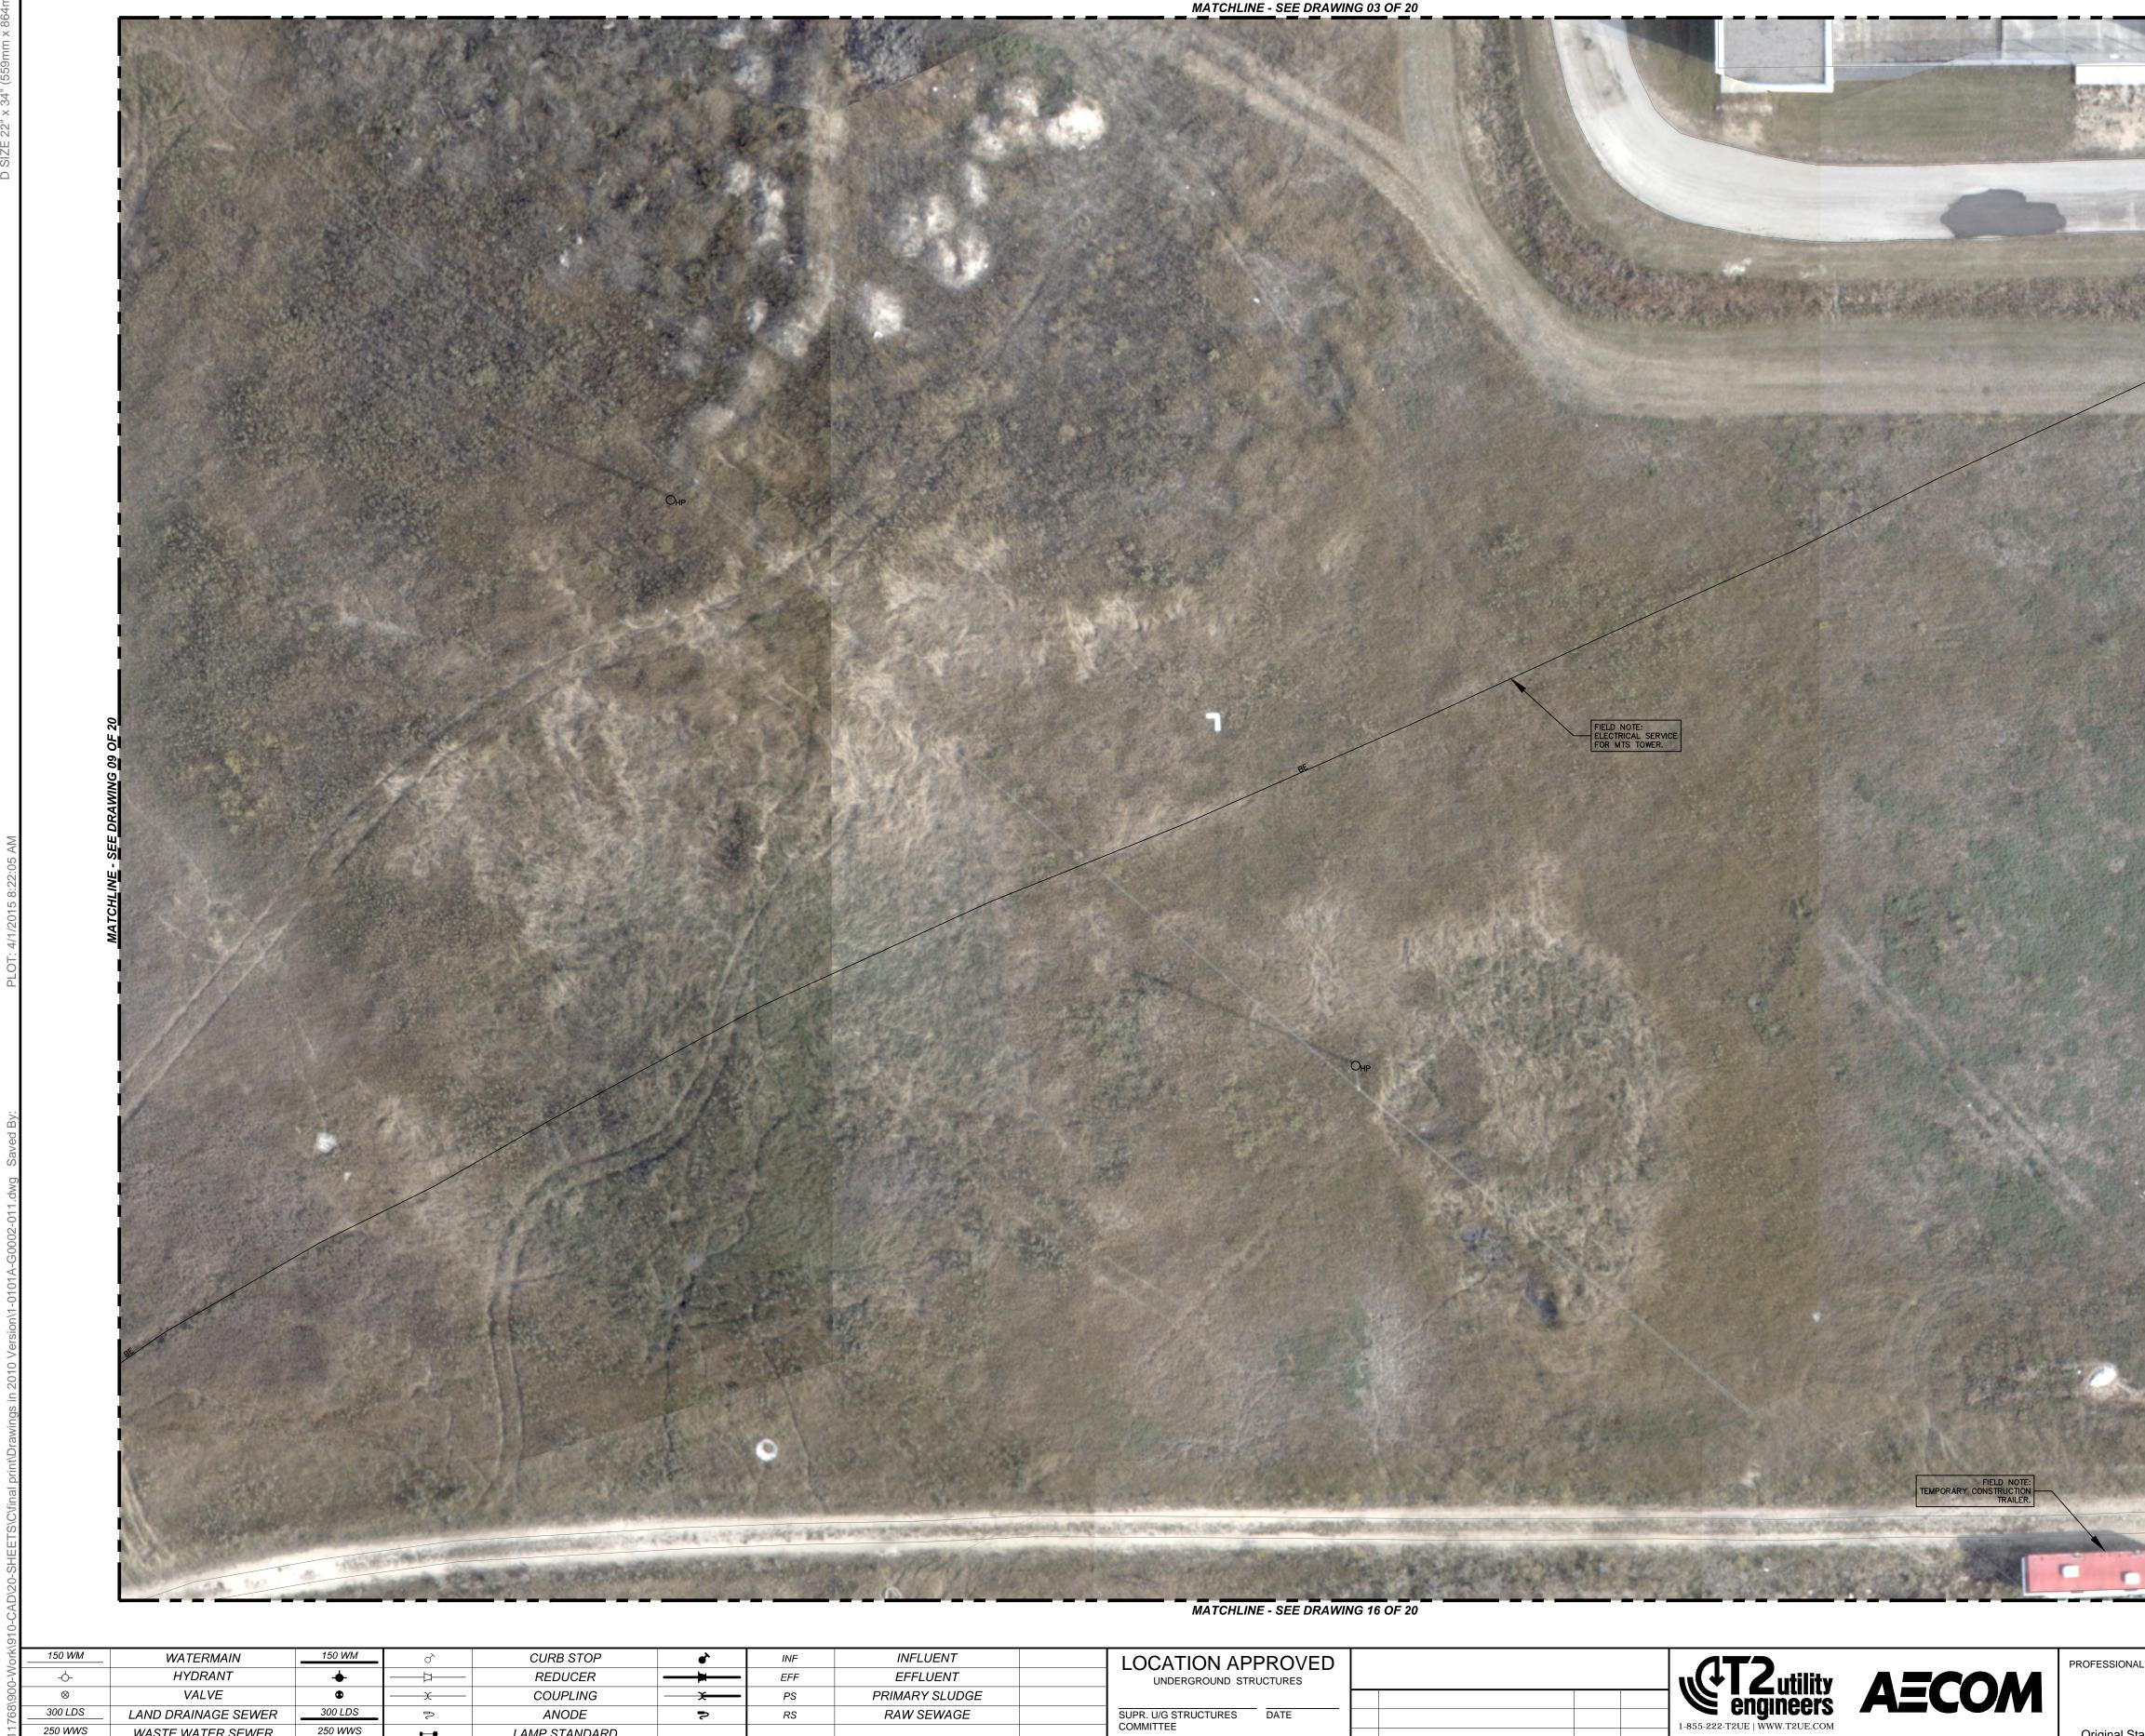


NEW

			Ŭ	CONE CICI	•		
-0-	HYDRANT	+		REDUCER	<b>—</b>	EFF	EFFLUENT
$\otimes$	VALVE	۲	X	COUPLING	<b>X</b>	PS	PRIMARY SLUDGE
300 LDS	LAND DRAINAGE SEWER	300 LDS	î۷	ANODE	2	RS	RAW SEWAGE
250 WWS	WASTE WATER SEWER	250 WWS	* *	LAMP STANDARD			
0	MANHOLE	•	$\odot$	TREE			
	CATCH BASIN		Онр	HYDRO POLE			
Δ	CURB INLET		4	BENCH MARK			
	CULVERT		INV	INVERT			
	PIPE ABANDONMENTS		OBV	OBVERT			
the the state of t	SURVEY BAR						
IN EXISTING	LEGEND - PLAN	NEW	EXISTING	LEGEND - PLAN	NEW	EXISTING	LEGEND - PLAN
	CULVERT PIPE ABANDONMENTS SURVEY BAR		INV OBV	INVERT OBVERT	NEW	EXISTING	LEGE


MATCHLINE - SEE DRAWI	NG 03 OF 20				FIELD NOTE: 2 PVC CONDUITS ON BUILDING WALL FOR GROUNDING GRID.		4 5
					FIELD NOTE: ELECTRICAL SERVICE FOR MTS TOWER.	кеумар - N.T.S.	$ \begin{array}{c ccccccccccccccccccccccccccccccccccc$
		C.H. M. W. M. K.		H	The second second second	ME	<b>ETRIC</b> RS INDICATE MILLIMETRES IMBERS INDICATE METRES
						GENE 1. LIMIT OF INVESTIGATION 2. EMPTY CONDUITS, SERV ABANDONED FACILITIES SL WITHIN THE INVESTIGATION THE DRAWING.	RAL NOTES : SEE DRAWING. ICES, LATERALS TO BUILDINGS, JCH AS STREET LIGHT CABLES, N AREA MAY NOT BE SHOWN ON
						HOWEVER CANNOT BE RES UNDOCUMENTED UTILITIES 4. THE BASEPLAN WAS PRO THEREFORE T2UE IS NOT F 5. UTILITY OWNERSHIP, MA ON DRAWING ARE BASED O RECEIVED, FIELD INVESTIG	I OF UNDOCUMENTED UTILITIES SPONSIBLE FOR FINDING ALL S. DVIDED BY THE CLIENT, RESPONSIBLE FOR ITS ACCURACY. TERIAL, SIZES AND FLOW SHOWN DN RECORDS INFORMATION
	FELD NOTE:				20	RECEIVED AND TEST HOLE 7. BASE COORDINATES BEI OF THESE PLANS ARE UTM 8. REFER TO COVER PAGE 1-0101A-G0001-001) FOR TE	NG USED FOR THE PREPARATION ZONE 14 JUNE 90 (LBIS). (CITY DRAWING NUMBER ST HOLE DETAILS.
BE	FIELD NOTE: ELECTRICAL SERV FOR MTS TOWER.	ICE			SEE DRAWING 11 OF	THE UTILITY INFORMATIO COLLECTED IN ACCORDA INFORMATION IS SHOWN	
					MATCHLINE -	SURFACE GEOPHYSICA	OTTING VISIBLE ABOVE URES AND BY USING MENT IN CORRELATING THE QUALITY LEVEL "D" FORMATION OBTAINED ATION OF APPROPRIATE
	CHP					U POSITION OF THE UTILI A QUALITY LEVEL "A" - PR L AND VERTICAL LOCATIO I BY THE ACTUAL EXPOS MEASUREMENT OF SUE T	ECISE HORIZONTAL DN OF UTILITES OBTAINED URE AND SUBSEQUENT
						GAS G.S. WM W.S. WWS WWS LAT. LDS	GAS GAS SERVICE WATERMAIN WATER SERVICE WASTE WATER SEWER WASTE WATER SEWER LATERAL LAND DRAINAGE SEWER
						LDS LAT. BE BE-SL GRD UNK FOC TV BT	LAND DRAINAGE SEWER LATERAL BURIED ELECTRIC BURIED ELECTRIC STREET LIGHT GROUND WIRE UNKNOWN FIBRE OPTIC CABLE CABLE TV BURIED TELECOMMUNICATIONS
			FIELD NOTE: TEMPORARY CONSTRUCTION TRAILER.				OVERHEAD WIRE QUALITY LEVEL "B" QUALITY LEVEL "C" QUALITY LEVEL "D" TEST HOLE (QL-A) CONTINUATION ARROW
MATCHLINE - SEE DRAWI	NG 16 OF 20					E # BID OP	FLOW ARROW END CAP NOT SURVEYED, LOCATION BASED ON FIELD OBSERVATION NOT SURVEYED, LOCATION BASED ON RECORD INFORMATION PORTUNITY NO. 607-2013
LOCATION APPROVED         UNDERGROUND STRUCTURES         SUPR. U/G STRUCTURES         DATE         COMMITTEE		1-855-222-T2UE   WWW.T2UE.COM	AECOM	PROFESSIONAL'S SEAL	Winnipeg WATER AND	OF WI	NNIPEG
NOTE: LOCATION OF UNDERGROUND STRUCTURES AS SHOWN ARE BASED ON THE BEST INFORMATION AVAILABLE. BUT NO GUARANTEE IS GIVEN THAT ALL EXISTING UTILITIES ARE SHOWN OR THAT THE GIVEN	Image: Second system     Image: Second system       5     ISSUED FOR CITY OF WINNIPEG USE     15/01/19       4     FINAL REVIEW     14/08/25       3     REVISED TENDER     14/06/13	DESIGNED BY DRAWN BY AJW	CHECKED BY     RG , JB       APPROVED BY     LEA	Original Stamped by: L.E. ARCAND Jan. 19, 2015	WINNIPEG NORTH END WATER CONTROL CENTRE		SHEET CITY DRAWING NUMBER
LOCATIONS ARE EXACT. CONFIRMATION OF EXISTENCE AND EXACT LOCATION OF ALL SERVICES MUST BE OBTAINED FROM THE INDIVIDUAL UTILITIES BEFORE PROCEEDING WITH CONSTRUCTION.	2ISSUED FOR TENDER14/04/03AJW1PRELIMINARY REVIEW14/03/04AJWNO.REVISIONSYY/MM/DDBY	HOR. SCALE 1:250 VERT. SCALE DATE 28-OCT-14	RELEASED FOR CONSTRUCTION 	CONSULTANT DRAWING NO. 60311768 T2UE DRAWING NO. 61000277	AREA SITE PLAN - SHEET 10 C	DF 20	1-0101A-G0002-010

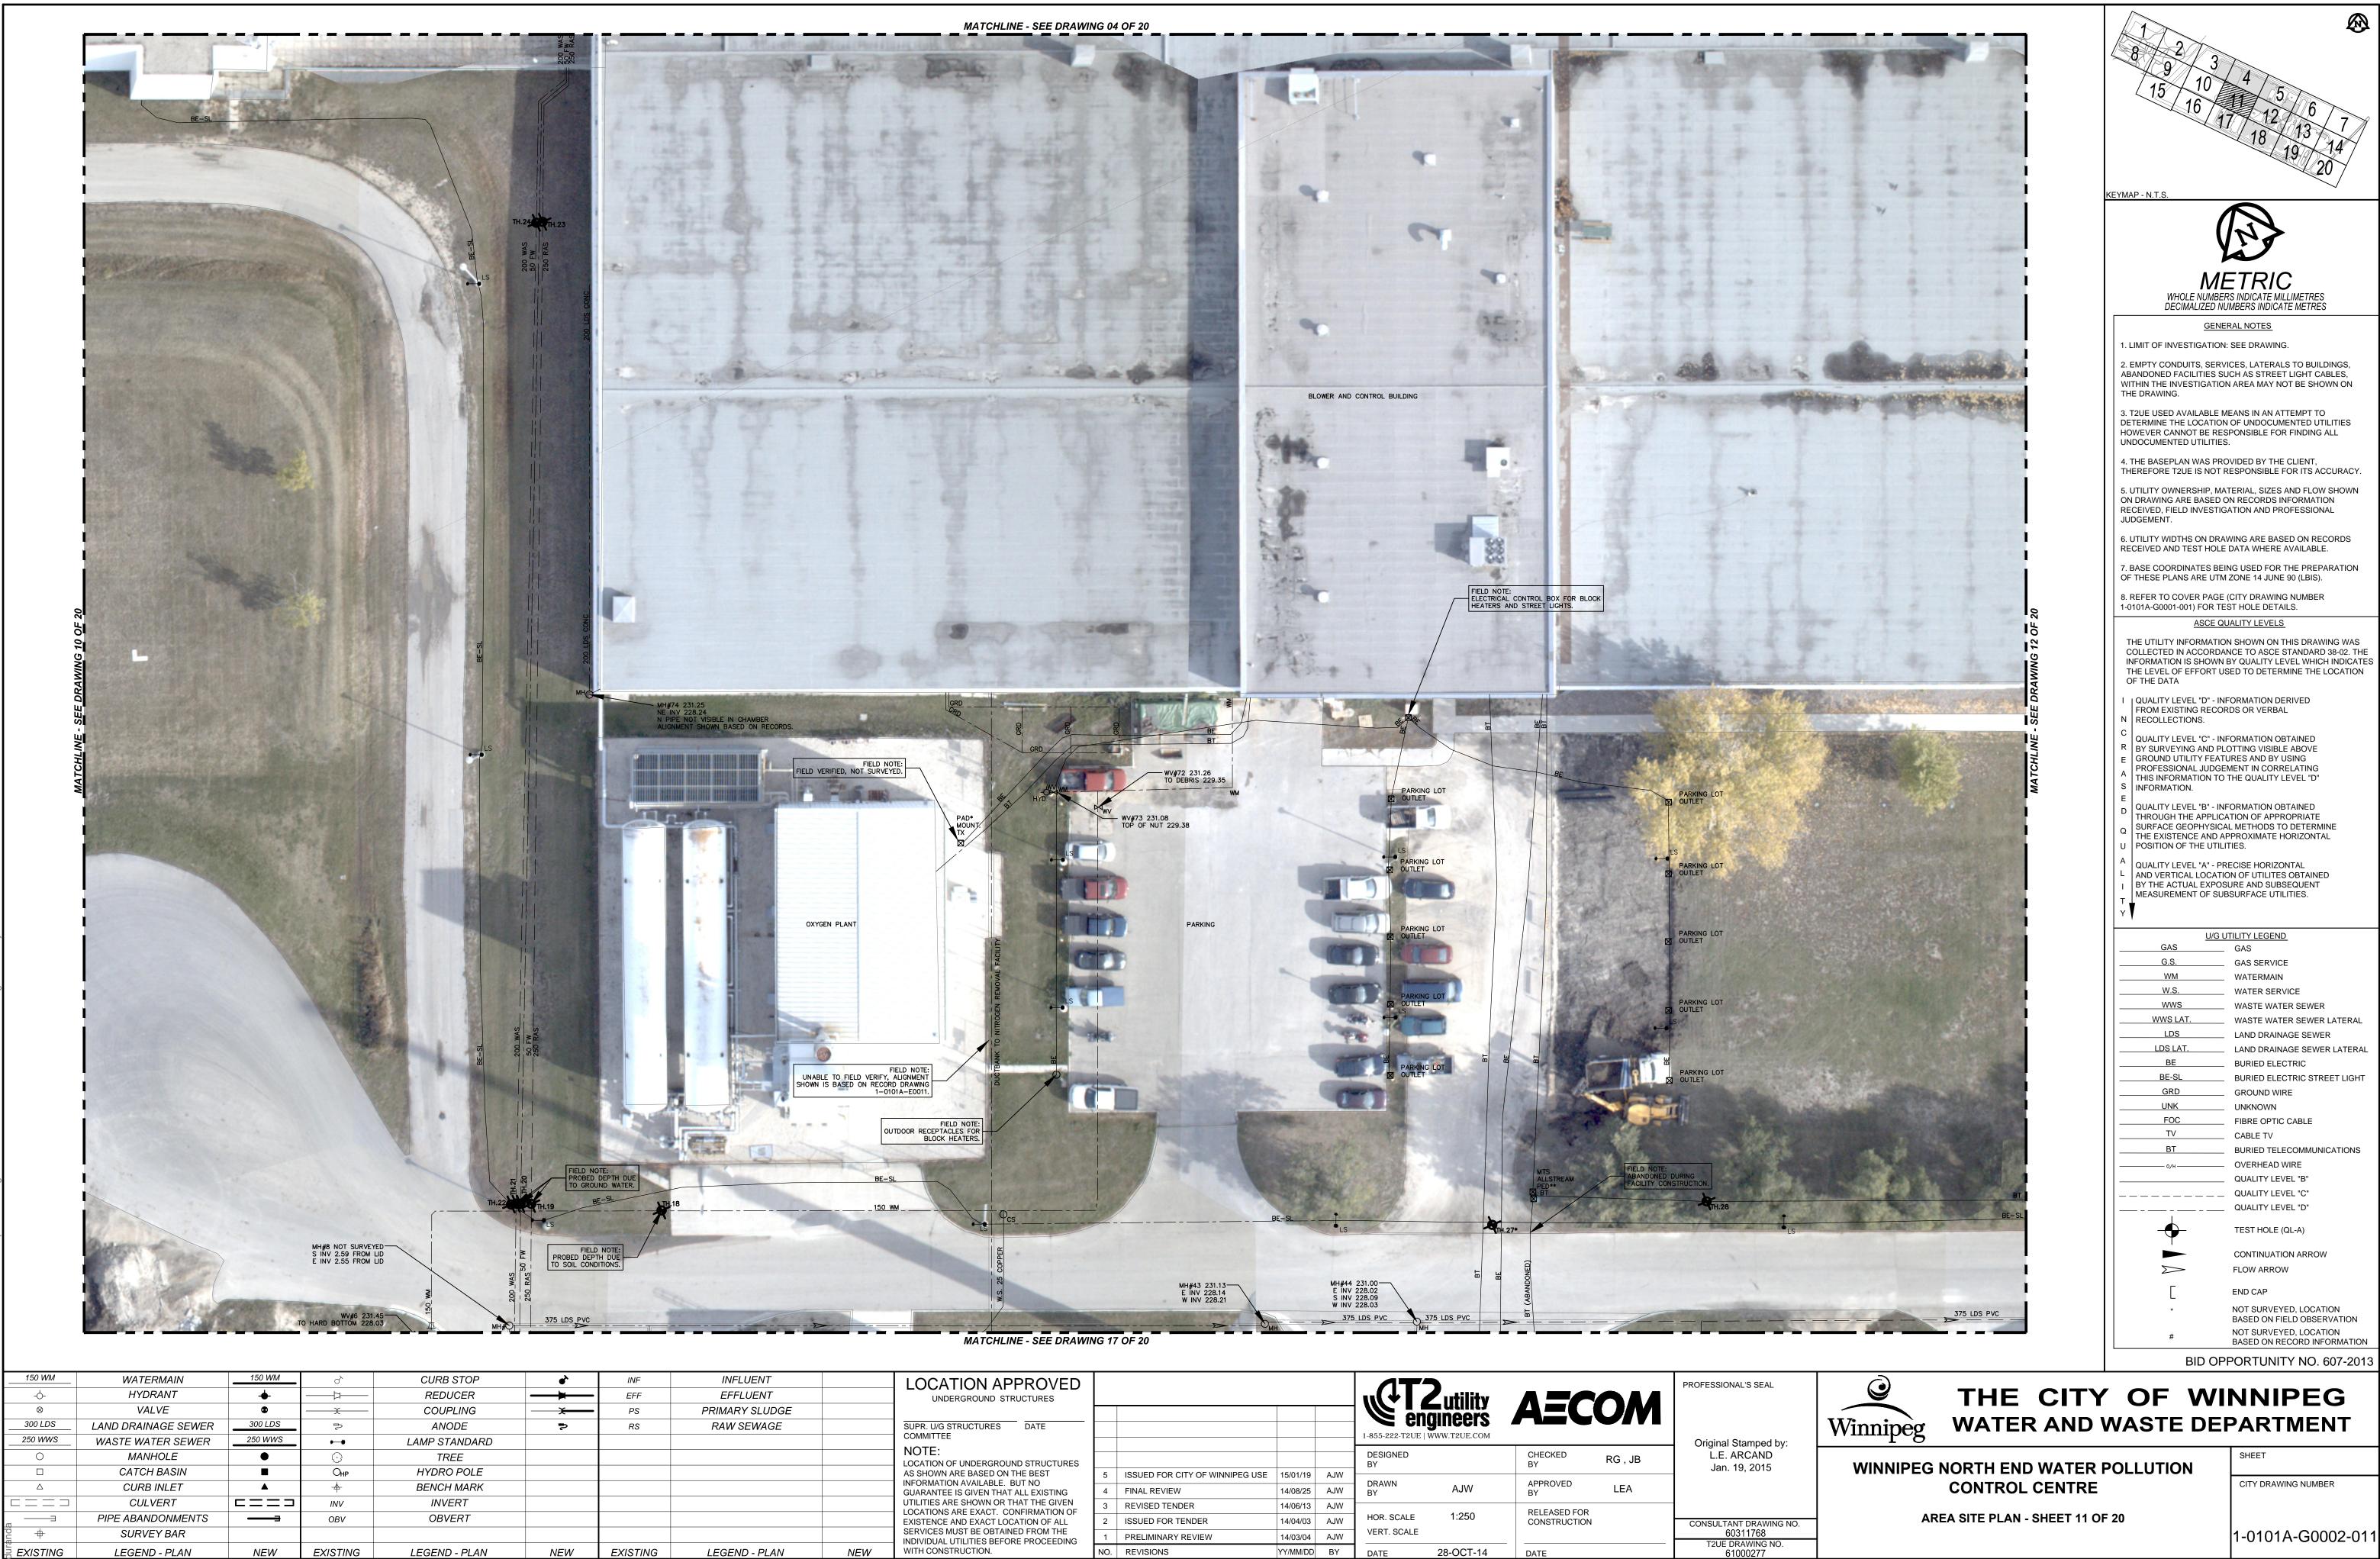

ork/	150 WM	WATERMAIN	150 WM	o <sup>ک</sup>	CURB STOP	•	INF	INFLUENT		LOCATION APPROVED									PROFESSIONAL'S SE
^-0	-\$-	HYDRANT	+		REDUCER		EFF	EFFLUENT		UNDERGROUND STRUCTURES						Lutility	ΔΞ		
06	$\otimes$	VALVE	٢	X	COUPLING	<b>x</b>	PS	PRIMARY SLUDGE								aineers	AEC		
768	300 LDS	LAND DRAINAGE SEWER	300 LDS	IJ	ANODE	₽	RS	RAW SEWAGE		SUPR. U/G STRUCTURES DATE									
311	250 WWS	WASTE WATER SEWER	250 WWS	••	LAMP STANDARD										1-855-222-T2UE	WWW.T2UE.COM			Original Stampe
	0	MANHOLE	•	$\odot$	TREE					NOTE: LOCATION OF UNDERGROUND STRUCTURES							CHECKED	RG , JB	L.E. ARCAN
ė.		CATCH BASIN		Онр	HYDRO POLE					AS SHOWN ARE BASED ON THE BEST	5	ISSUED FOR CITY OF WINNIPEG USE	15/01/19	AJW					Jan. 19, 201
N N	Δ	CURB INLET		+	BENCH MARK					INFORMATION AVAILABLE. BUT NO GUARANTEE IS GIVEN THAT ALL EXISTING	4	FINAL REVIEW	14/08/25	AJW	DRAWN BY	AJW	APPROVED BY	LEA	
AN AN		CULVERT		INV	INVERT					UTILITIES ARE SHOWN OR THAT THE GIVEN	3	REVISED TENDER	14/06/13	AJW					_
	m ────────────────────────────	PIPE ABANDONMENTS		OBV	OBVERT					LOCATIONS ARE EXACT. CONFIRMATION OF     EXISTENCE AND EXACT LOCATION OF ALL	2	ISSUED FOR TENDER	14/04/03	AJW	HOR. SCALE	1:250	RELEASED FOR CONSTRUCTION		CONSULTANT DRAV
	ф <u>ц</u>	SURVEY BAR								SERVICES MUST BE OBTAINED FROM THE INDIVIDUAL UTILITIES BEFORE PROCEEDING	1	PRELIMINARY REVIEW	14/03/04	AJW	VERT. SCALE				60311768
		LEGEND - PLAN	NEW	EXISTING	LEGEND - PLAN	NEW	EXISTING	LEGEND - PLAN	NEW	WITH CONSTRUCTION.	NO.	REVISIONS	YY/MM/DD		DATE	28-OCT-14	DATE		T2UE DRAWING 61000277

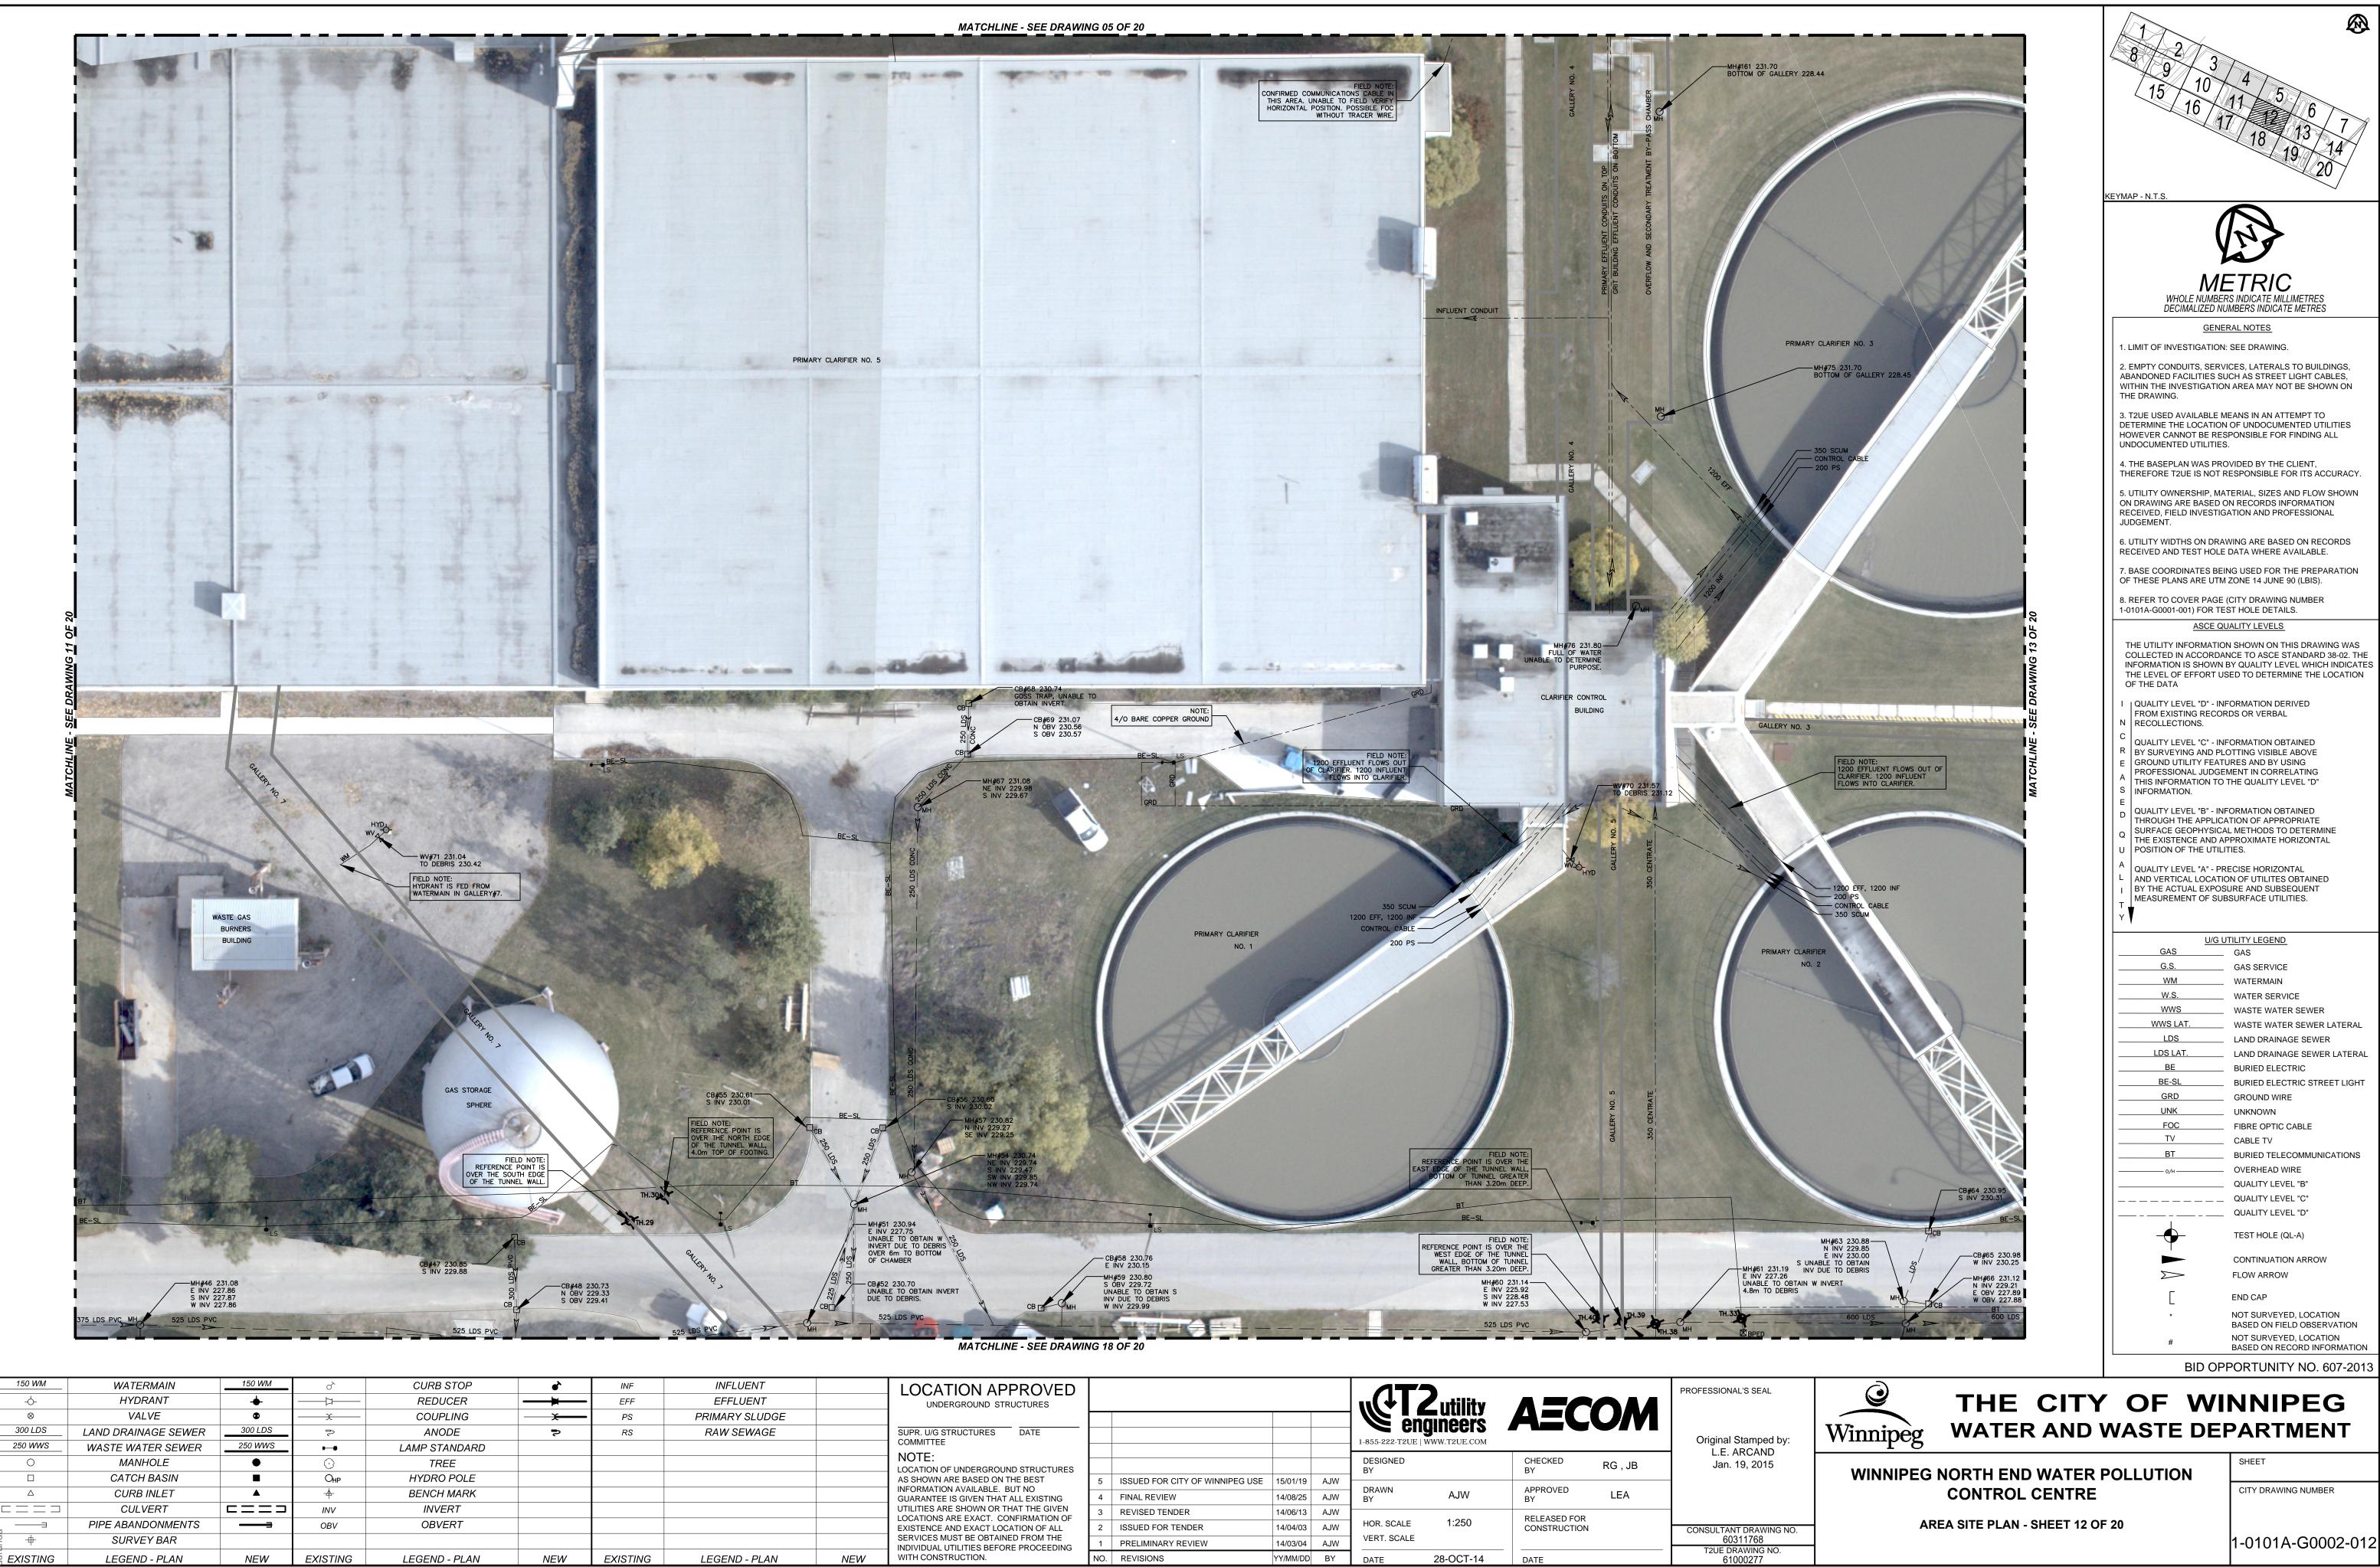


Ork	150 WM	WATERMAIN	150 WM	ک ک	CURB STOP	<b>*</b>	INF	INFLUENT		LOCATION APPROVED									PROFESSIONAL'S SI
M-C	-0-	HYDRANT	+	Z	REDUCER	<b></b>	EFF	EFFLUENT							(↓ ⊿	utility			
006	$\otimes$	VALVE	٢	X	COUPLING	<del>x</del>	PS	PRIMARY SLUDGE											
268	300 LDS	LAND DRAINAGE SEWER	300 LDS	ĥ	ANODE	~	RS	RAW SEWAGE		SUPR. U/G STRUCTURES DATE						jineers			
	250 WWS	WASTE WATER SEWER	250 WWS		LAMP STANDARD					COMMITTEE					1-855-222-T2UE   V	/WW.T2UE.COM			Original Stam
	0	MANHOLE	•	$\odot$	TREE					NOTE: LOCATION OF UNDERGROUND STRUCTURES							CHECKED	RG , JB	Jan. 19, 2
á		CATCH BASIN		O <sub>HP</sub>	HYDRO POLE					AS SHOWN ARE BASED ON THE BEST	5	ISSUED FOR CITY OF WINNIPEG USE	15/01/19	AJW	Ы			-	_
	Δ	CURB INLET	<b></b>	- <del>4</del> -	BENCH MARK					INFORMATION AVAILABLE. BUT NO GUARANTEE IS GIVEN THAT ALL EXISTING	4	FINAL REVIEW	14/08/25	AJW	DRAWN BY	AJW	APPROVED BY	LEA	
ANA -		CULVERT		INV	INVERT					UTILITIES ARE SHOWN OR THAT THE GIVEN	3	REVISED TENDER	14/06/13	AJW					_
		PIPE ABANDONMENTS		OBV	OBVERT					LOCATIONS ARE EXACT. CONFIRMATION OF     EXISTENCE AND EXACT LOCATION OF ALL	2	ISSUED FOR TENDER	14/04/03	AJW	HOR. SCALE	1:250	RELEASED FOR CONSTRUCTION		CONSULTANT DRA
	th th	SURVEY BAR								SERVICES MUST BE OBTAINED FROM THE INDIVIDUAL UTILITIES BEFORE PROCEEDING	1	PRELIMINARY REVIEW	14/03/04	AJW	VERT. SCALE				6031176
	EXISTING	LEGEND - PLAN	NEW	EXISTING	LEGEND - PLAN	NEW	EXISTING	LEGEND - PLAN	NEW	WITH CONSTRUCTION.	NO.	REVISIONS	YY/MM/DD		DATE	28-OCT-14	DATE		T2UE DRAWIN 6100027

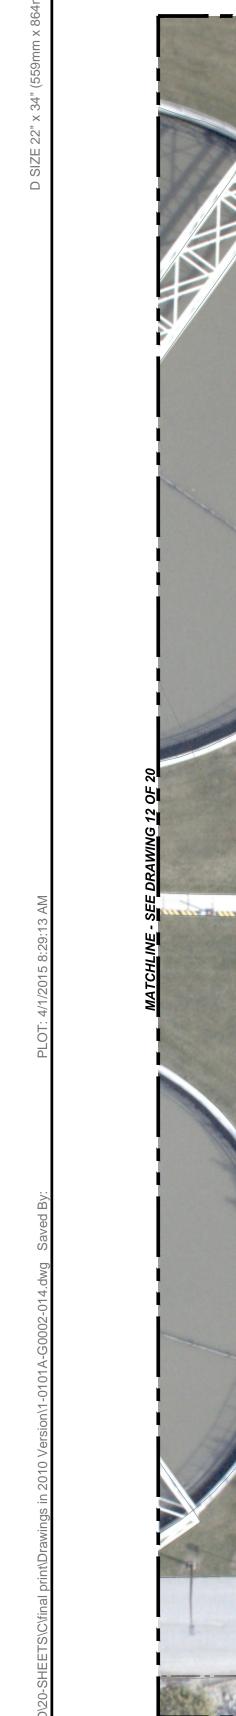


CB#141 230.87 NW INV 230.23 LDS CBMH#142 231.06	A A. C.
CBMH#142 231.06 E INV TO #140 229.97 E INV TO #141 230.08 NW GOSS TRAP, UNABLE TO MEASURE INVERT. CB#144 231.21 N INV 226.78 UNABLE TO OBTAIN INV OF, EAST PIPE S INV 226.76	
MH#137 231.23 W INV 229 02	
MH#137 231.23 W INV 229.02 UNABLE TO VERIFY EAST PIPE DUE TO DEBRIS. ALIGNMENT BASED ON RECORDS.	
MH#138 231.30 N INV 226.96 E INV 228.67 W INV 226.94 W OBV 227.45	
MATCHLINE - SEE DRAWING 12 OF 20	
MATCHLINE - SE	
	-
FIELD NOTE: CABLE OBSERVED FROM TH#33-31, POSSIBLY ABANDONED TELECOM. MH#131 231.37 E INV 227.24 W INV 227.26	MH#132 S INV 2 SW INV ABANDO

/ork/	150 WM	WATERMAIN	150 WM	o^`	CURB STOP	•	INF	INFLUENT	LOCATION APPROVED							PROFESSIONAL'S SEAL
∽-0	-0-	HYDRANT	-	Z	REDUCER		EFF	EFFLUENT	UNDERGROUND STRUCTURES			uu( <b>↓  </b> ⊿	Intility	ΔΞ		
06	$\otimes$	VALVE	۲	X	COUPLING	— <del>x — -</del>	PS	PRIMARY SLUDGE								
168	300 LDS	LAND DRAINAGE SEWER	300 LDS	ĥ	ANODE	~	RS	RAW SEWAGE	SUPR. U/G STRUCTURES DATE				gineers			
11	250 WWS	WASTE WATER SEWER	250 WWS	• •	LAMP STANDARD				COMMITTEE			_ 1-855-222-T2UE   '	WWW.T2UE.COM			
09	0	MANHOLE	•	$\odot$	TREE				<b>NOTE:</b> LOCATION OF UNDERGROUND STRUCTURES						RG , JB	Original Stamped by: L.E. ARCAND
ġ.		CATCH BASIN		Онр	HYDRO POLE				AS SHOWN ARE BASED ON THE BEST	5 ISSUED FOR CITY OF WINNIPEG USE	E 15/01/19 AJW					Jan. 19, 2015
ME	Δ	CURB INLET		4	BENCH MARK				INFORMATION AVAILABLE. BUT NO GUARANTEE IS GIVEN THAT ALL EXISTING	4 FINAL REVIEW	14/08/25 AJW	– DRAWN BY	AJW	APPROVED BY	LEA	
	= $=$ $=$ $=$ $=$	CULVERT		INV	INVERT				UTILITIES ARE SHOWN OR THAT THE GIVEN	3 REVISED TENDER	14/06/13 AJW					-
Ш Ш	=	PIPE ABANDONMENTS	— <u> </u>	OBV	OBVERT				LOCATIONS ARE EXACT. CONFIRMATION OF EXISTENCE AND EXACT LOCATION OF ALL	2 ISSUED FOR TENDER	14/04/03 AJW	HOR. SCALE	1:250	RELEASED FOR CONSTRUCTION		CONSULTANT DRAWING NO.
e Fl	+	SURVEY BAR							SERVICES MUST BE OBTAINED FROM THE	1 PRELIMINARY REVIEW	14/03/04 AJW	VERT. SCALE				60311768
T2ue dura	EXISTING	LEGEND - PLAN	NEW	EXISTING	LEGEND - PLAN	NEW	EXISTING	LEGEND - PLAN	INDIVIDUAL UTILITIES BEFORE PROCEEDING           NEW         WITH CONSTRUCTION.	NO. REVISIONS	YY/MM/DD BY	DATE	28-OCT-14	DATE		T2UE DRAWING NO. 61000277

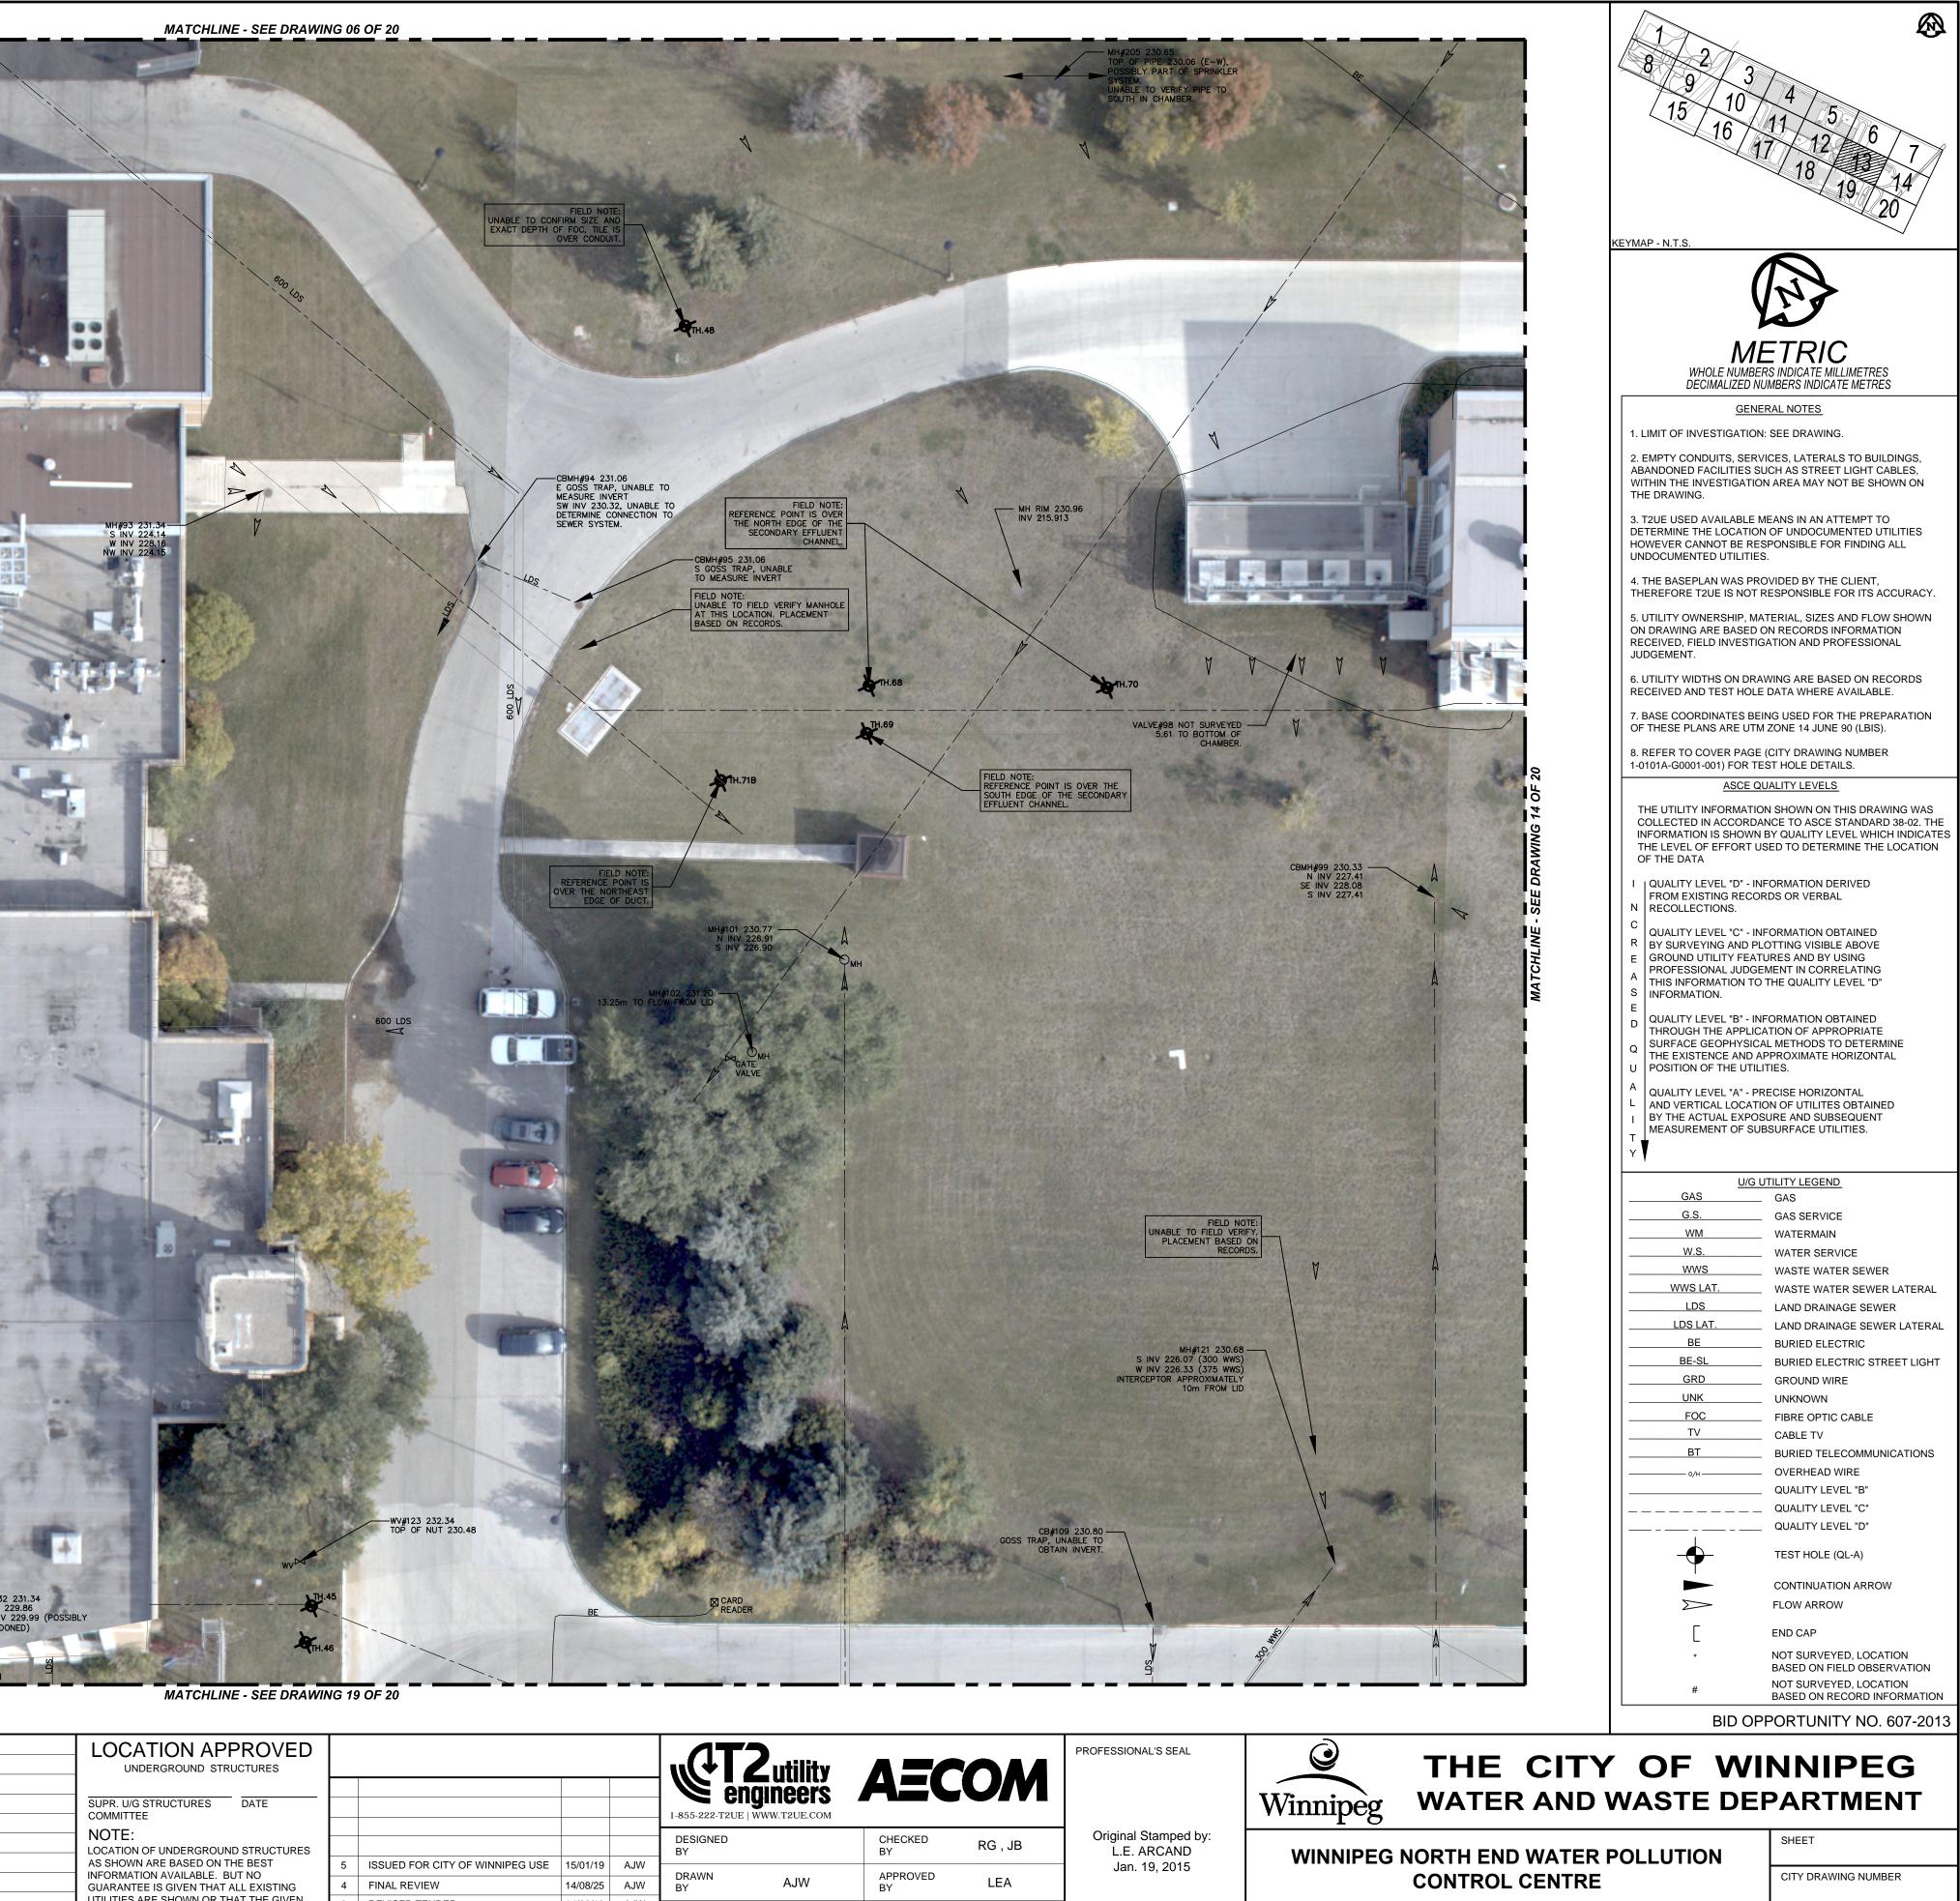

AREA SITE PLAN - SHEET 13 OF 20

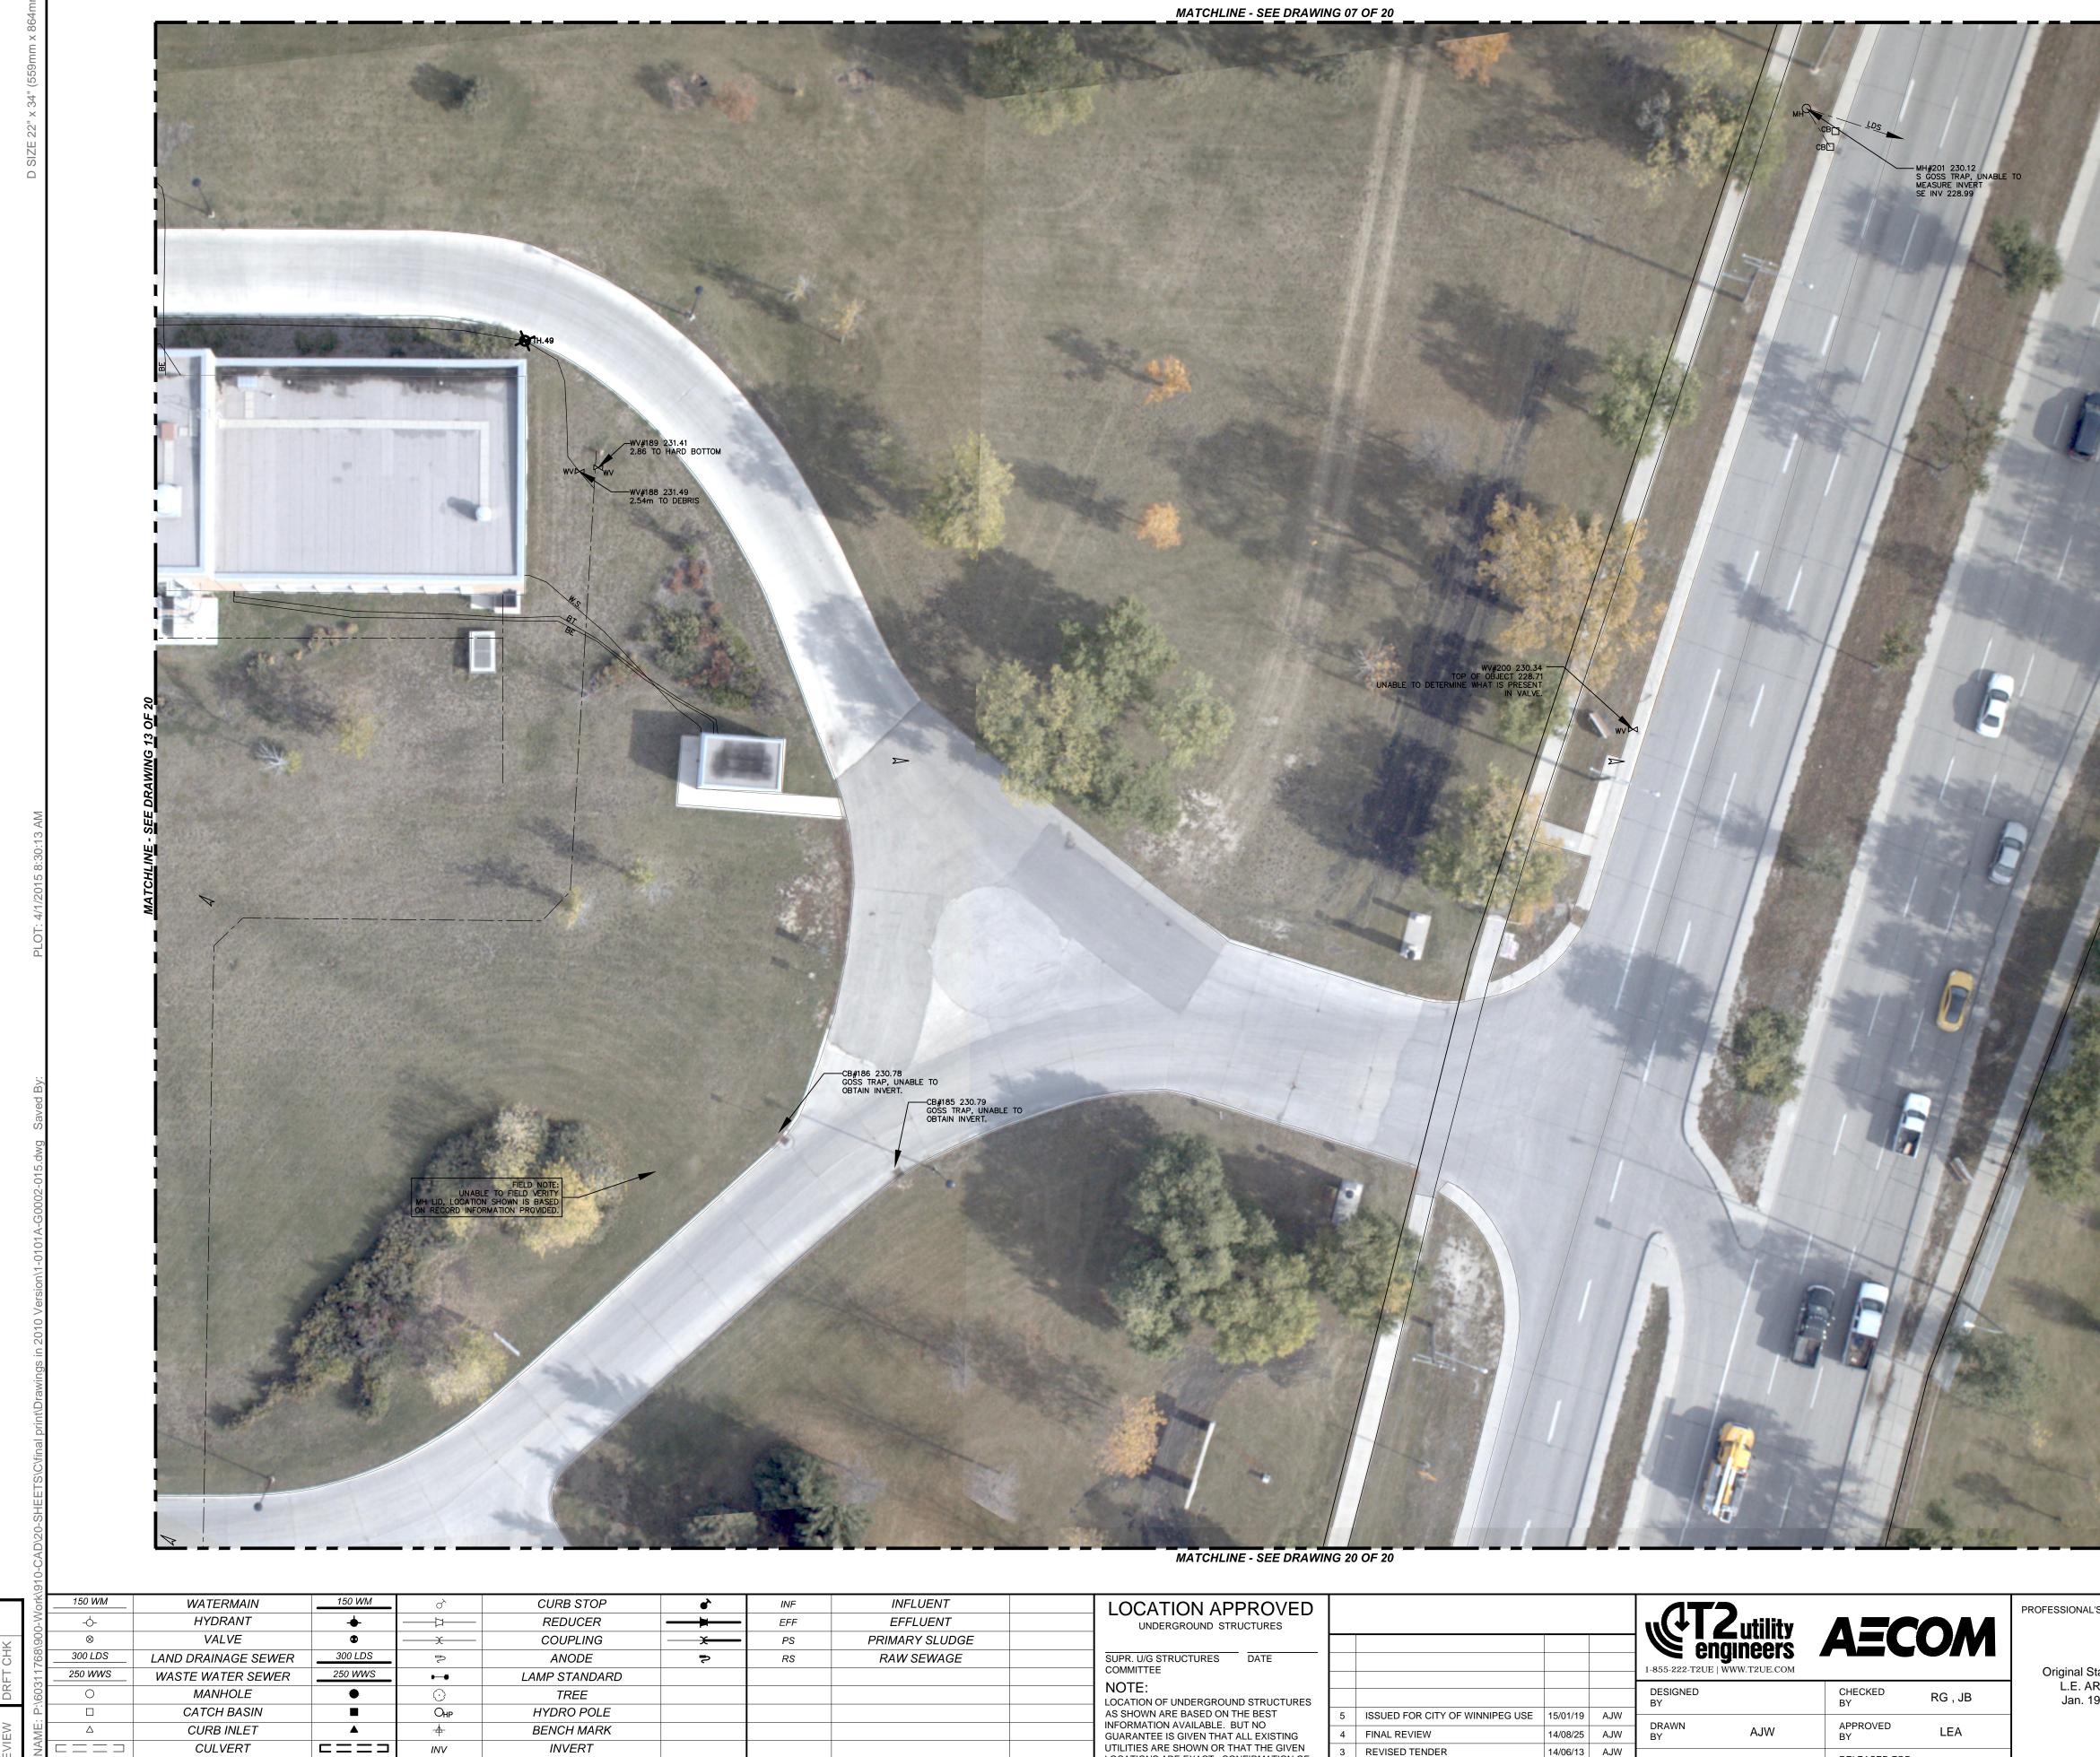

\_\_\_\_\_

-

EXISTING

CULVERT

PIPE ABANDONMENTS

SURVEY BAR

LEGEND - PLAN

INV

OBV

EXISTING

<del>\_\_\_\_</del>

NEW

INVERT

OBVERT

LEGEND - PLAN

EXISTING

LEGEND - PLAN


NEW

	LOCATION APPROVED UNDERGROUND STRUCTURES					T.	<b>Z</b> utility	AEC	OM	PROFESSIONAL'S S
	SUPR. U/G STRUCTURES DATE COMMITTEE					1-855-222-T2UE	3			Original Starr
	NOTE: LOCATION OF UNDERGROUND STRUCTURES					DESIGNED BY		CHECKED BY	RG , JB	L.E. ARC/ Jan. 19, 2
	AS SHOWN ARE BASED ON THE BEST	5	ISSUED FOR CITY OF WINNIPEG USE	15/01/19	AJW					
	INFORMATION AVAILABLE. BUT NO GUARANTEE IS GIVEN THAT ALL EXISTING	4	FINAL REVIEW	14/08/25	AJW	DRAWN BY	AJW	APPROVED BY	LEA	
	UTILITIES ARE SHOWN OR THAT THE GIVEN LOCATIONS ARE EXACT. CONFIRMATION OF	3	REVISED TENDER	14/06/13	AJW			RELEASED FOR		
	EXISTENCE AND EXACT LOCATION OF ALL	2	ISSUED FOR TENDER	14/04/03	AJW	HOR. SCALE	1:250	CONSTRUCTION		CONSULTANT DRA
	SERVICES MUST BE OBTAINED FROM THE	1	PRELIMINARY REVIEW	14/03/04	AJW	VERT. SCALE				6031176
NEW	INDIVIDUAL UTILITIES BEFORE PROCEEDING WITH CONSTRUCTION.	NO.	REVISIONS	YY/MM/DD	-	DATE	28-OCT-14	DATE		T2UE DRAWIN 6100027


10	A A A A	8 9 3	<b>8</b>
		KEYMAP - N.T.S.	$ \begin{array}{c ccccccccccccccccccccccccccccccccccc$
		WHOLE NUMBER	S INDICATE MILLIMETRES MBERS INDICATE METRES
		<ol> <li>LIMIT OF INVESTIGATION:</li> <li>EMPTY CONDUITS, SERVIO ABANDONED FACILITIES SUO WITHIN THE INVESTIGATION THE DRAWING.</li> <li>T2UE USED AVAILABLE ME</li> </ol>	CES, LATERALS TO BUILDINGS, CH AS STREET LIGHT CABLES, I AREA MAY NOT BE SHOWN ON
		HOWEVER CANNOT BE RESE UNDOCUMENTED UTILITIES. 4. THE BASEPLAN WAS PRO THEREFORE T2UE IS NOT RE	PONSIBLE FOR FINDING ALL VIDED BY THE CLIENT, ESPONSIBLE FOR ITS ACCURACY. TERIAL, SIZES AND FLOW SHOWN N RECORDS INFORMATION
		RECEIVED AND TEST HOLE I 7. BASE COORDINATES BEIN OF THESE PLANS ARE UTM 2 8. REFER TO COVER PAGE ( 1-0101A-G0001-001) FOR TES	IG USED FOR THE PREPARATION ZONE 14 JUNE 90 (LBIS). CITY DRAWING NUMBER
		COLLECTED IN ACCORDAN INFORMATION IS SHOWN B	
		QUALITY LEVEL "C" - INF         R       BY SURVEYING AND PLC         E       GROUND UTILITY FEATU         PROFESSIONAL JUDGEM         A       THIS INFORMATION TO T         S       INFORMATION.         E       QUALITY LEVEL "B" - INF         D       QUALITY LEVEL "B" - INF         THROUGH THE APPLICA       SURFACE GEOPHYSICAL	OTTING VISIBLE ABOVE IRES AND BY USING MENT IN CORRELATING THE QUALITY LEVEL "D" ORMATION OBTAINED TION OF APPROPRIATE L METHODS TO DETERMINE PROXIMATE HORIZONTAL
		A QUALITY LEVEL "A" - PRE AND VERTICAL LOCATIO I BY THE ACTUAL EXPOSE MEASUREMENT OF SUBS Y	N OF UTILITES OBTAINED JRE AND SUBSEQUENT
		U/G UT           GAS           G.S.           WM           W.S.           WWS           UNK           FOC           TV           BT           0/H	FILITY LEGEND         GAS         GAS SERVICE         WATERMAIN         WATER SERVICE         WASTE WATER SEWER         WASTE WATER SEWER LATERAL         LAND DRAINAGE SEWER         LAND DRAINAGE SEWER         LAND DRAINAGE SEWER         LAND DRAINAGE SEWER LATERAL         BURIED ELECTRIC         BURIED ELECTRIC STREET LIGHT         GROUND WIRE         UNKNOWN         FIBRE OPTIC CABLE         CABLE TV         BURIED TELECOMMUNICATIONS         OVERHEAD WIRE         QUALITY LEVEL "B"         QUALITY LEVEL "C"         QUALITY LEVEL "D"
		↓ ↓ ↓ ↓ ↓ ↓ ↓ ↓ ↓ ↓ ↓ ↓ ↓ ↓	TEST HOLE (QL-A) CONTINUATION ARROW FLOW ARROW END CAP NOT SURVEYED, LOCATION BASED ON FIELD OBSERVATION NOT SURVEYED, LOCATION BASED ON RECORD INFORMATION
S SEAL	Winnipeg <b>THE CITY</b> Water and	OF WI	PORTUNITY NO. 607-2013
amped by: CAND 9, 2015	WINNIPEG NORTH END WATER		SHEET CITY DRAWING NUMBER
DRAWING NO. 1768	CONTROL CENTRE AREA SITE PLAN - SHEET 14 O	F 20	1-0101A-G0002-014
VING NO. )277			1-0101A-G0002-014



910-C								
ork	150 WM	WATERMAIN	150 WM	٥ <sup>٢</sup>	CURB STOP	•	INF	INFLUENT
M-C	-0-	HYDRANT	+	Z	REDUCER		EFF	EFFLUENT
1900	$\otimes$	VALVE	٢	X	COUPLING	— <del>x — -</del>	PS	PRIMARY SLUDGE
768	300 LDS	LAND DRAINAGE SEWER		h	ANODE	2	RS	RAW SEWAGE
311.	250 WWS	WASTE WATER SEWER	250 WWS	* *	LAMP STANDARD			
09	0	MANHOLE	•	$\odot$	TREE			
ġ.		CATCH BASIN		Онр	HYDRO POLE			
ME	Δ	CURB INLET	▲	- <del> -</del>	BENCH MARK			
ΝA		CULVERT		INV	INVERT			
Ш	ш — — — — — — — — — — — — — — — — — — —	PIPE ABANDONMENTS	—— <del>—</del>	OBV	OBVERT			
В	and +	SURVEY BAR						
T2u	EXISTING	LEGEND - PLAN	NEW	EXISTING	LEGEND - PLAN	NEW	EXISTING	LEGEND - PLAN

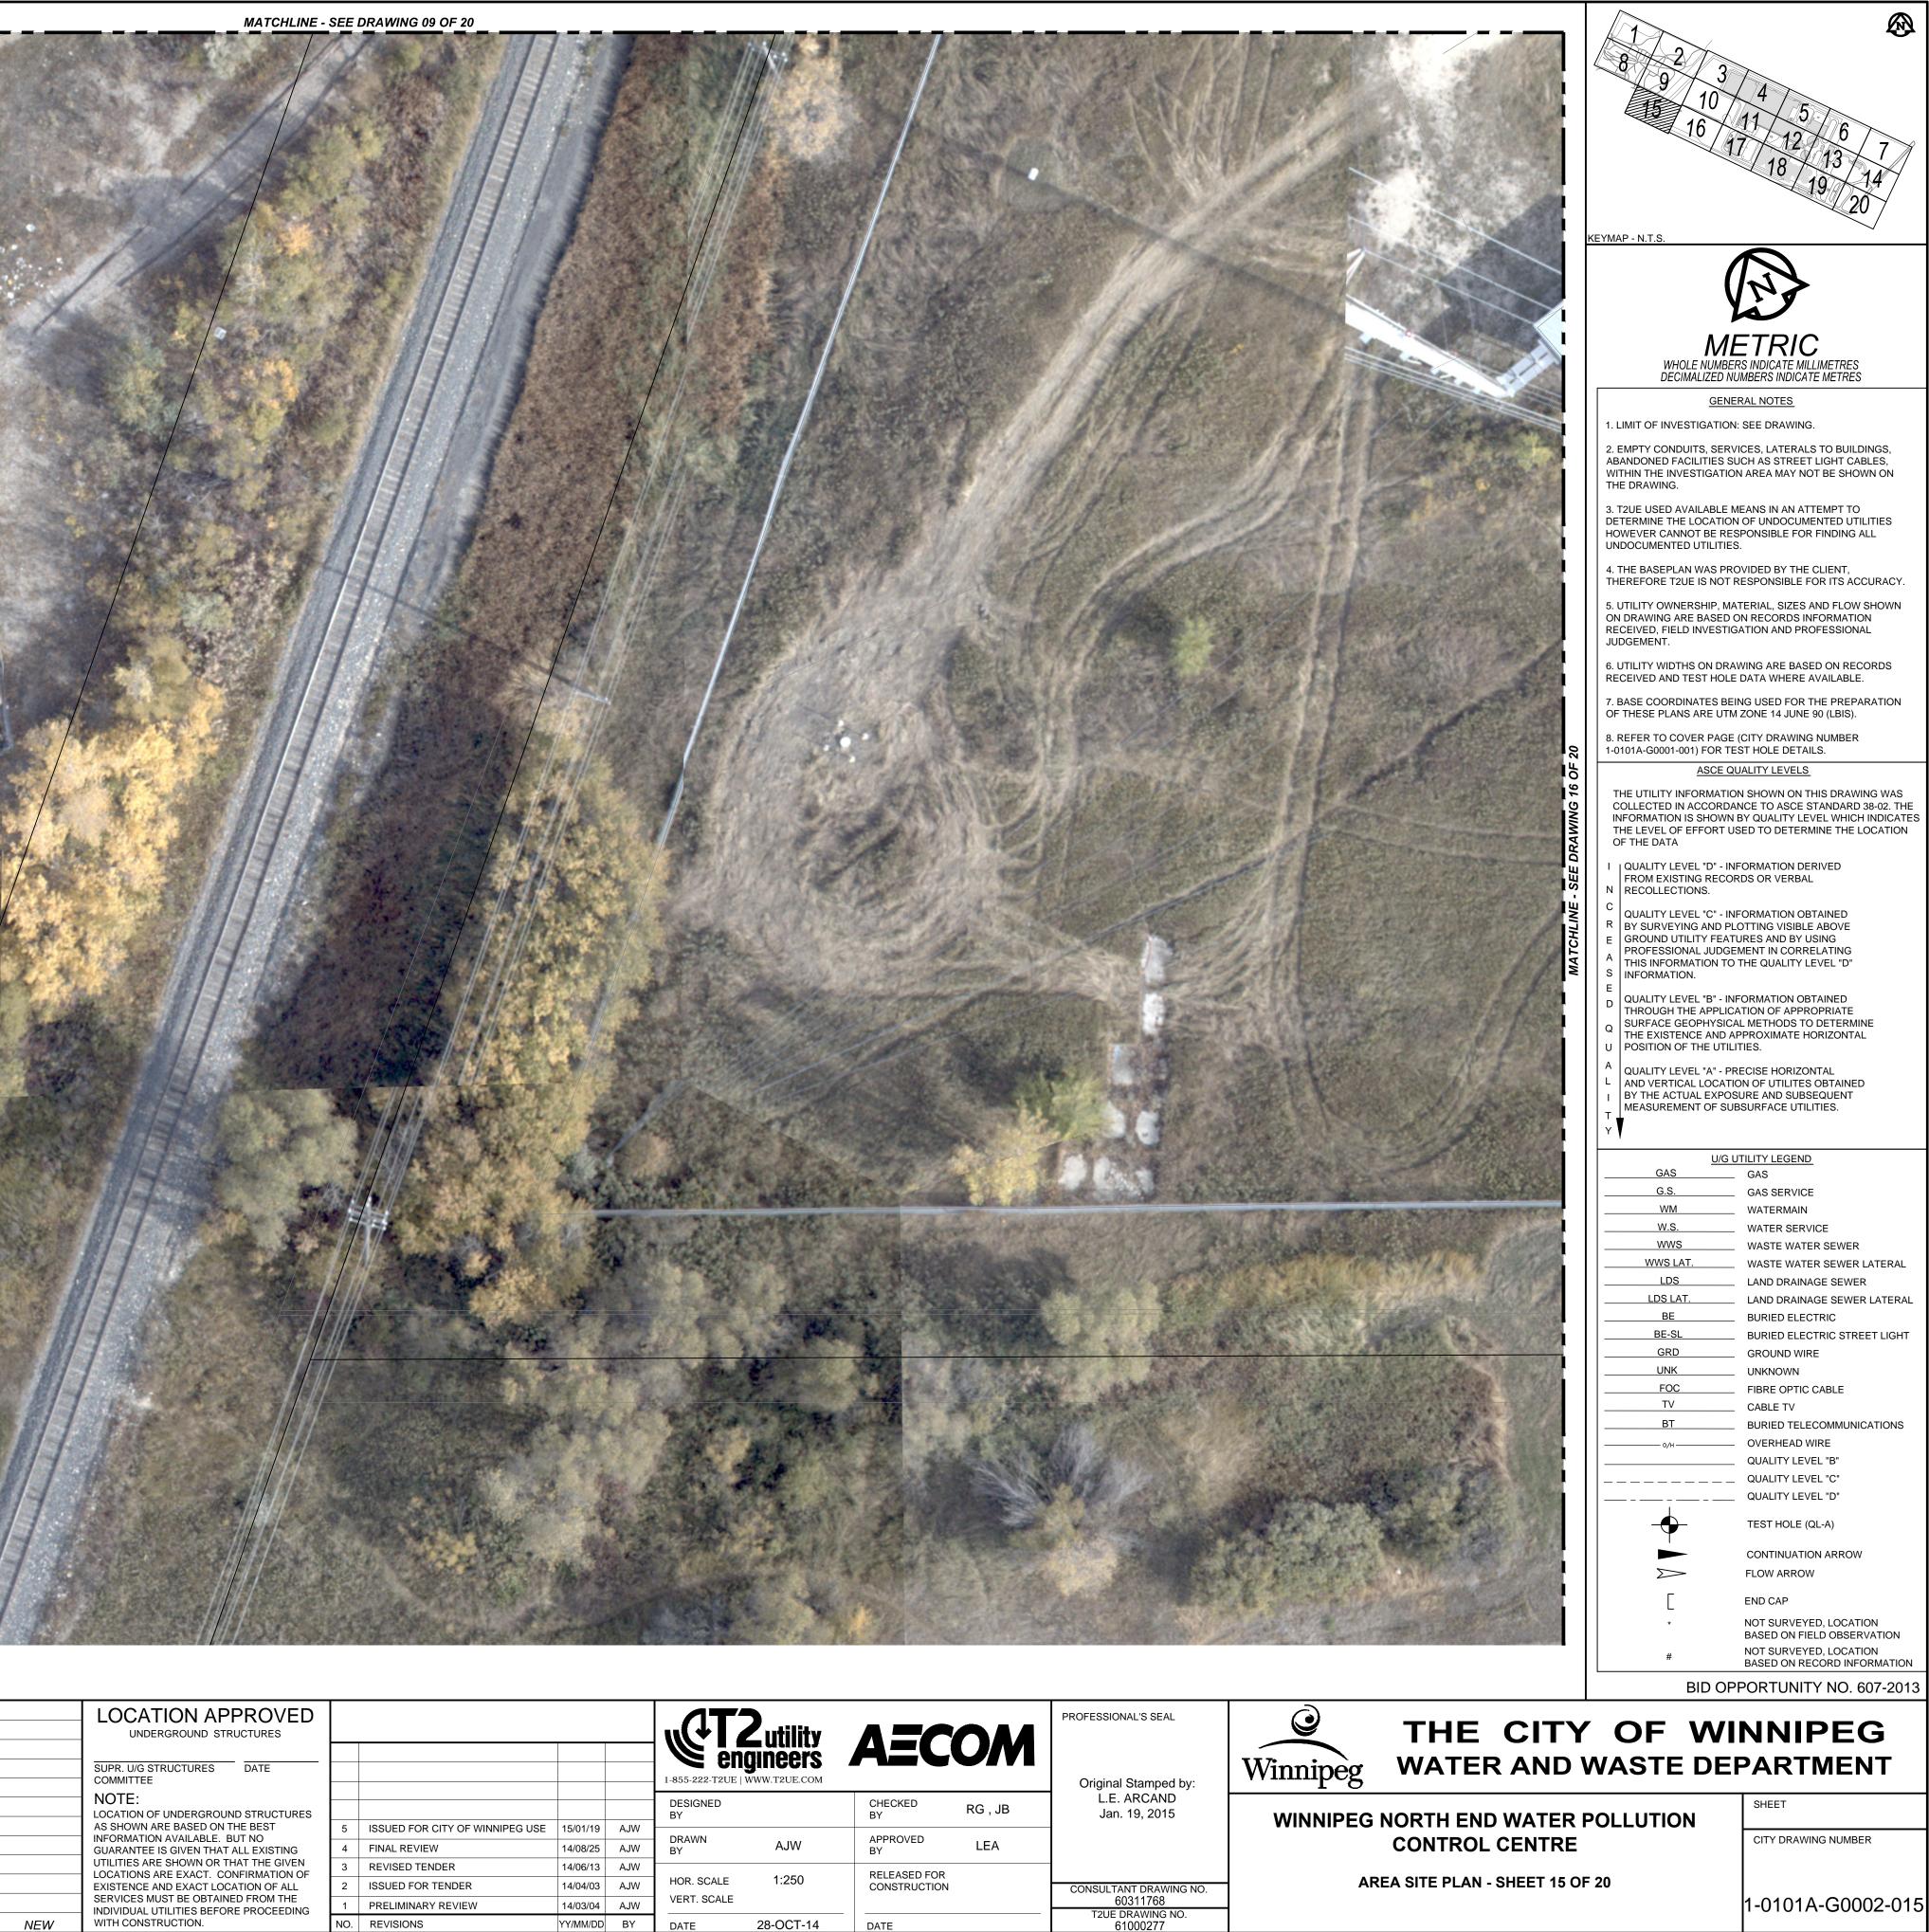


LOCATION APPROVED UNDERGROUND STRUCTURES SUPR. U/G STRUCTURES COMMITTEE					1-855-222-T2UE	ginaara	AEC	OM	PROFESSIONAL'S Original Stan
NOTE: LOCATION OF UNDERGROUND STRUCTURES					DESIGNED BY		CHECKED BY	RG , JB	L.E. ARC Jan. 19, 2
AS SHOWN ARE BASED ON THE BEST INFORMATION AVAILABLE. BUT NO	5	ISSUED FOR CITY OF WINNIPEG USE	15/01/19	AJW					
GUARANTEE IS GIVEN THAT ALL EXISTING	4	FINAL REVIEW	14/08/25	AJW	DRAWN BY	AJW	APPROVED BY	LEA	
UTILITIES ARE SHOWN OR THAT THE GIVEN LOCATIONS ARE EXACT. CONFIRMATION OF	3	REVISED TENDER	14/06/13	AJW			RELEASED FOR		
EXISTENCE AND EXACT LOCATION OF ALL	2	ISSUED FOR TENDER	14/04/03	AJW	HOR. SCALE	1:250	CONSTRUCTION		CONSULTANT DE
SERVICES MUST BE OBTAINED FROM THE INDIVIDUAL UTILITIES BEFORE PROCEEDING	1	PRELIMINARY REVIEW	14/03/04	AJW	VERT. SCALE				603117
WITH CONSTRUCTION.	NO.	REVISIONS	YY/MM/DD	BY	DATE	28-OCT-14	DATE		T2UE DRAW 610002

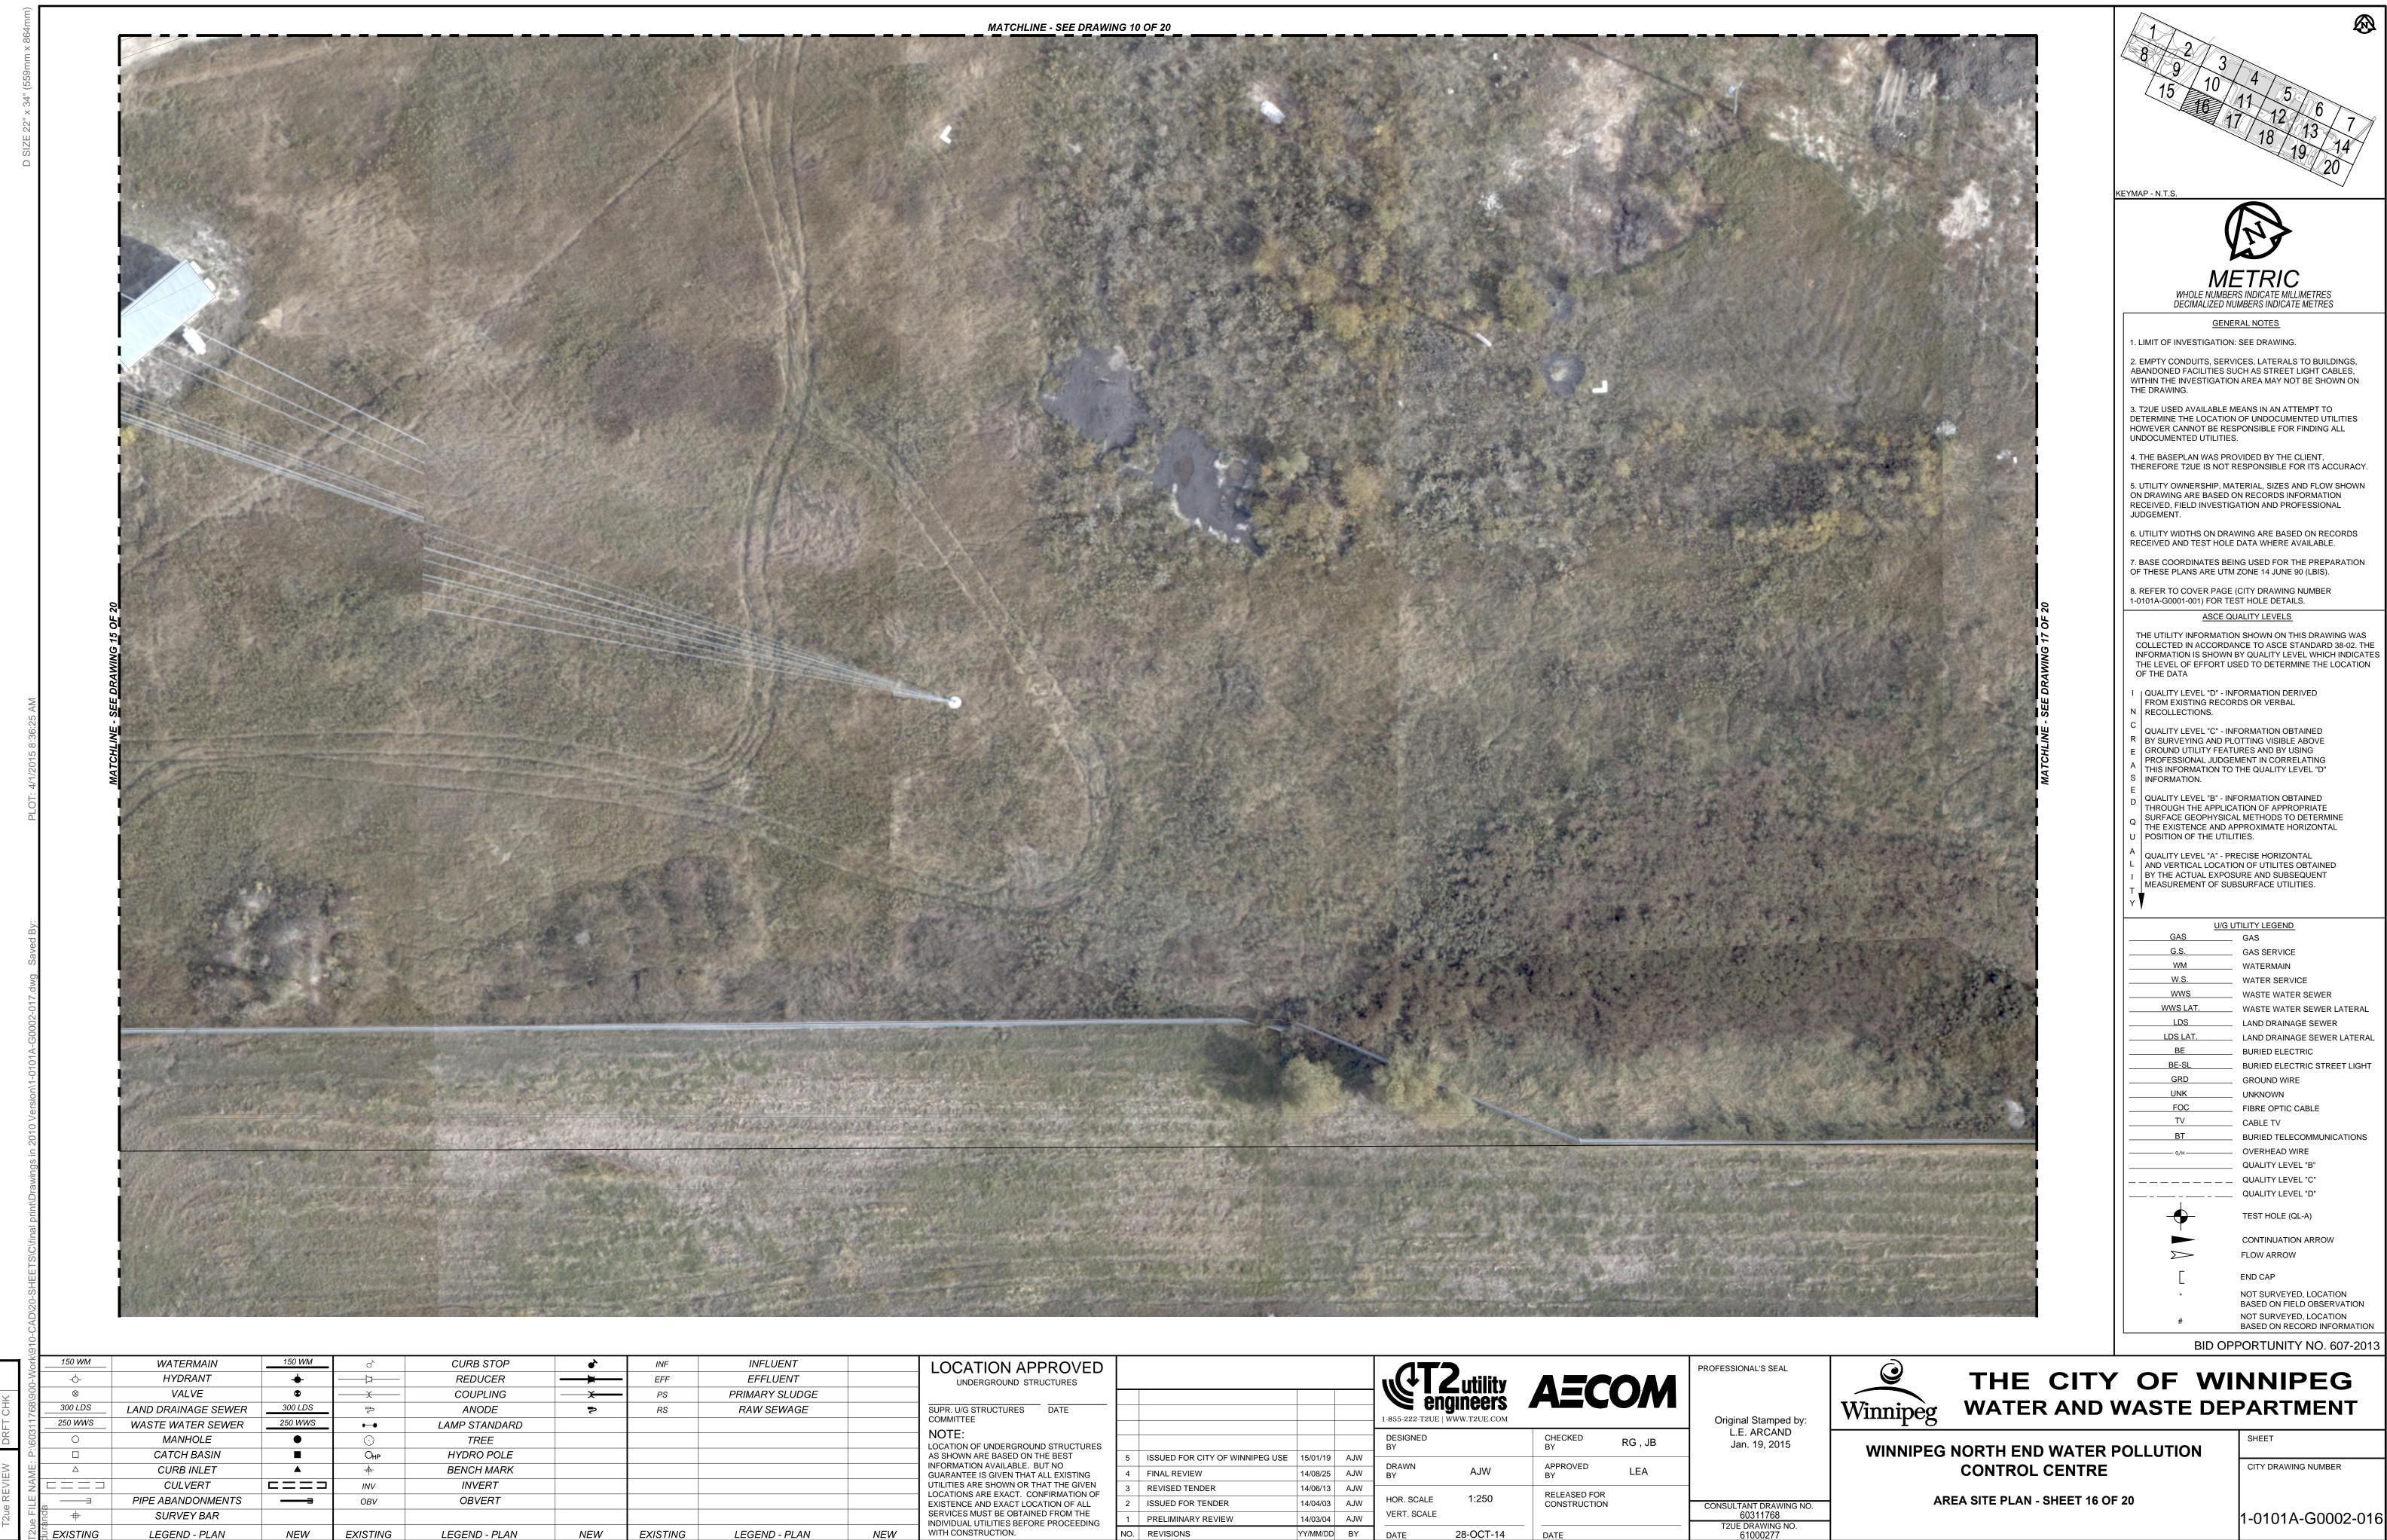


311	250 WWS	WAS7
P:\60311	0	
		C
ME	Δ	
NAME:		
Ш	т П	PIPE
ue FILE	⊕ ⊕	

 LOCATION APPROVED UNDERGROUND STRUCTURES						2 utility gineers	AEC	OM	PROFESSIONAL'S
 SUPR. U/G STRUCTURES DATE COMMITTEE					1-855-222-T2UE				Original Sta
NOTE: LOCATION OF UNDERGROUND STRUCTURES					DESIGNED BY		CHECKED BY	RG , JB	L.E. AR Jan. 19
AS SHOWN ARE BASED ON THE BEST INFORMATION AVAILABLE. BUT NO	5	ISSUED FOR CITY OF WINNIPEG USE	15/01/19	AJW	DRAWN	A 11.A/	APPROVED		-
GUARANTEE IS GIVEN THAT ALL EXISTING	4	FINAL REVIEW	14/08/25	AJW	BY	AJW	BY	LEA	
UTILITIES ARE SHOWN OR THAT THE GIVEN LOCATIONS ARE EXACT. CONFIRMATION OF	3	REVISED TENDER	14/06/13	AJW		4.050	RELEASED FOR		-
EXISTENCE AND EXACT LOCATION OF ALL	2	ISSUED FOR TENDER	14/04/03	AJW	HOR. SCALE	1:250	CONSTRUCTION		CONSULTANT D
SERVICES MUST BE OBTAINED FROM THE INDIVIDUAL UTILITIES BEFORE PROCEEDING	1	PRELIMINARY REVIEW	14/03/04	AJW	VERT. SCALE				60311
WITH CONSTRUCTION.	NO.	REVISIONS	YY/MM/DD	BY	DATE	28-OCT-14	DATE		T2UE DRAW 61000

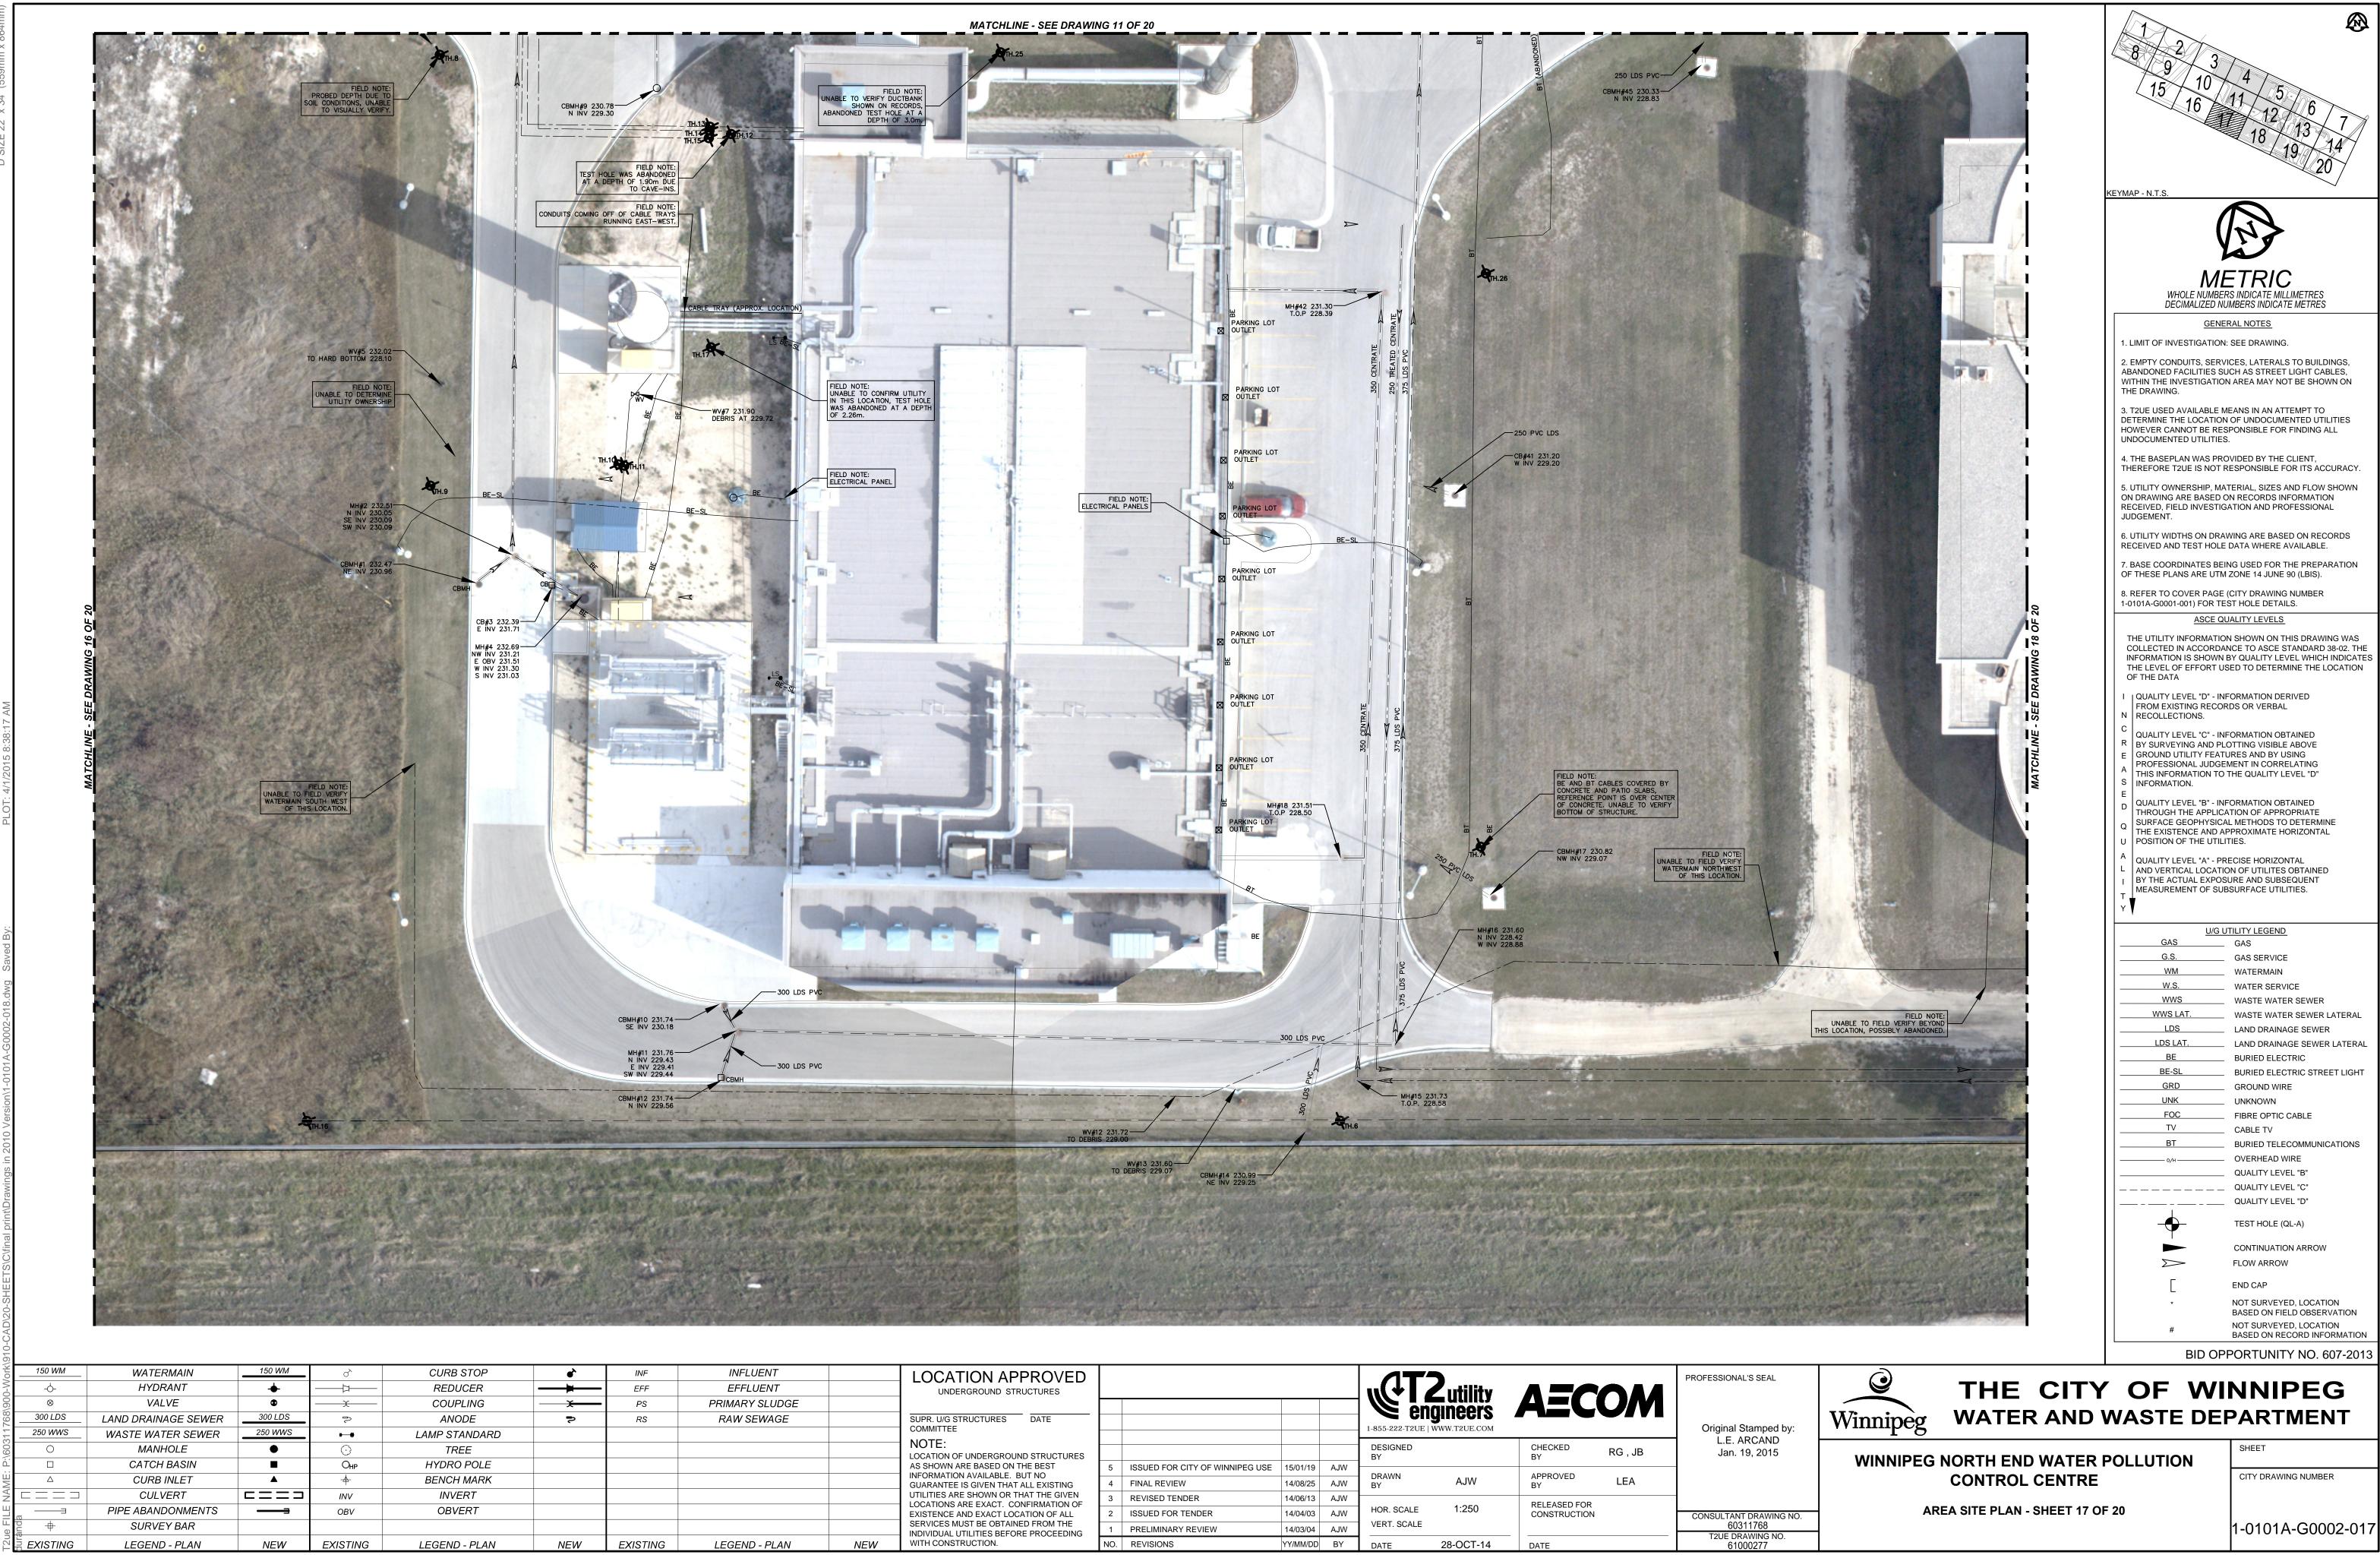


150 WM	WATERMAIN	150 WM	ð	CURB STOP	▲	INF	INFLUENT
-0-	HYDRANT	+		REDUCER	<b>—</b>	EFF	EFFLUENT
$\otimes$	VALVE	۲	X	COUPLING	<b>x</b>	PS	PRIMARY SLUDGE
300 LDS	LAND DRAINAGE SEWER	300 LDS	ĥ	ANODE	2	RS	RAW SEWAGE
250 WWS	WASTE WATER SEWER	250 WWS	***	LAMP STANDARD			
0	MANHOLE	•	$\odot$	TREE			
	CATCH BASIN		Онр	HYDRO POLE			
Δ	CURB INLET	<b></b>	+	BENCH MARK			
	CULVERT		INV	INVERT			
	PIPE ABANDONMENTS		OBV	OBVERT			
÷	SURVEY BAR						
EXISTING	LEGEND - PLAN	NEW	EXISTING	LEGEND - PLAN	NEW	EXISTING	LEGEND - PLAN

	LOCATION APPROVED UNDERGROUND STRUCTURES					<b>CT</b>	<b>2</b> utility gineers	AEC	OM	PROFESSIONAL'S SE
	COMMITTEE					1-855-222-T2UE				Original Stamp
	NOTE: LOCATION OF UNDERGROUND STRUCTURES					DESIGNED BY		CHECKED BY	RG , JB	L.E. ARCA Jan. 19, 20
	AS SHOWN ARE BASED ON THE BEST INFORMATION AVAILABLE. BUT NO	5	ISSUED FOR CITY OF WINNIPEG USE	15/01/19	AJW	DRAWN		APPROVED		
	GUARANTEE IS GIVEN THAT ALL EXISTING	4	FINAL REVIEW	14/08/25	AJW	BY	AJW	BY	LEA	
	UTILITIES ARE SHOWN OR THAT THE GIVEN LOCATIONS ARE EXACT. CONFIRMATION OF	3	REVISED TENDER	14/06/13	AJW			RELEASED FOR		
	EXISTENCE AND EXACT LOCATION OF ALL	2	ISSUED FOR TENDER	14/04/03	AJW	HOR. SCALE	1:250	CONSTRUCTION		CONSULTANT DRA
	SERVICES MUST BE OBTAINED FROM THE INDIVIDUAL UTILITIES BEFORE PROCEEDING	1	PRELIMINARY REVIEW	14/03/04	AJW	VERT. SCALE				60311768
v	WITH CONSTRUCTION.	NO.	REVISIONS	YY/MM/DD	BY	DATE	28-OCT-14	DATE		T2UE DRAWING 6100027

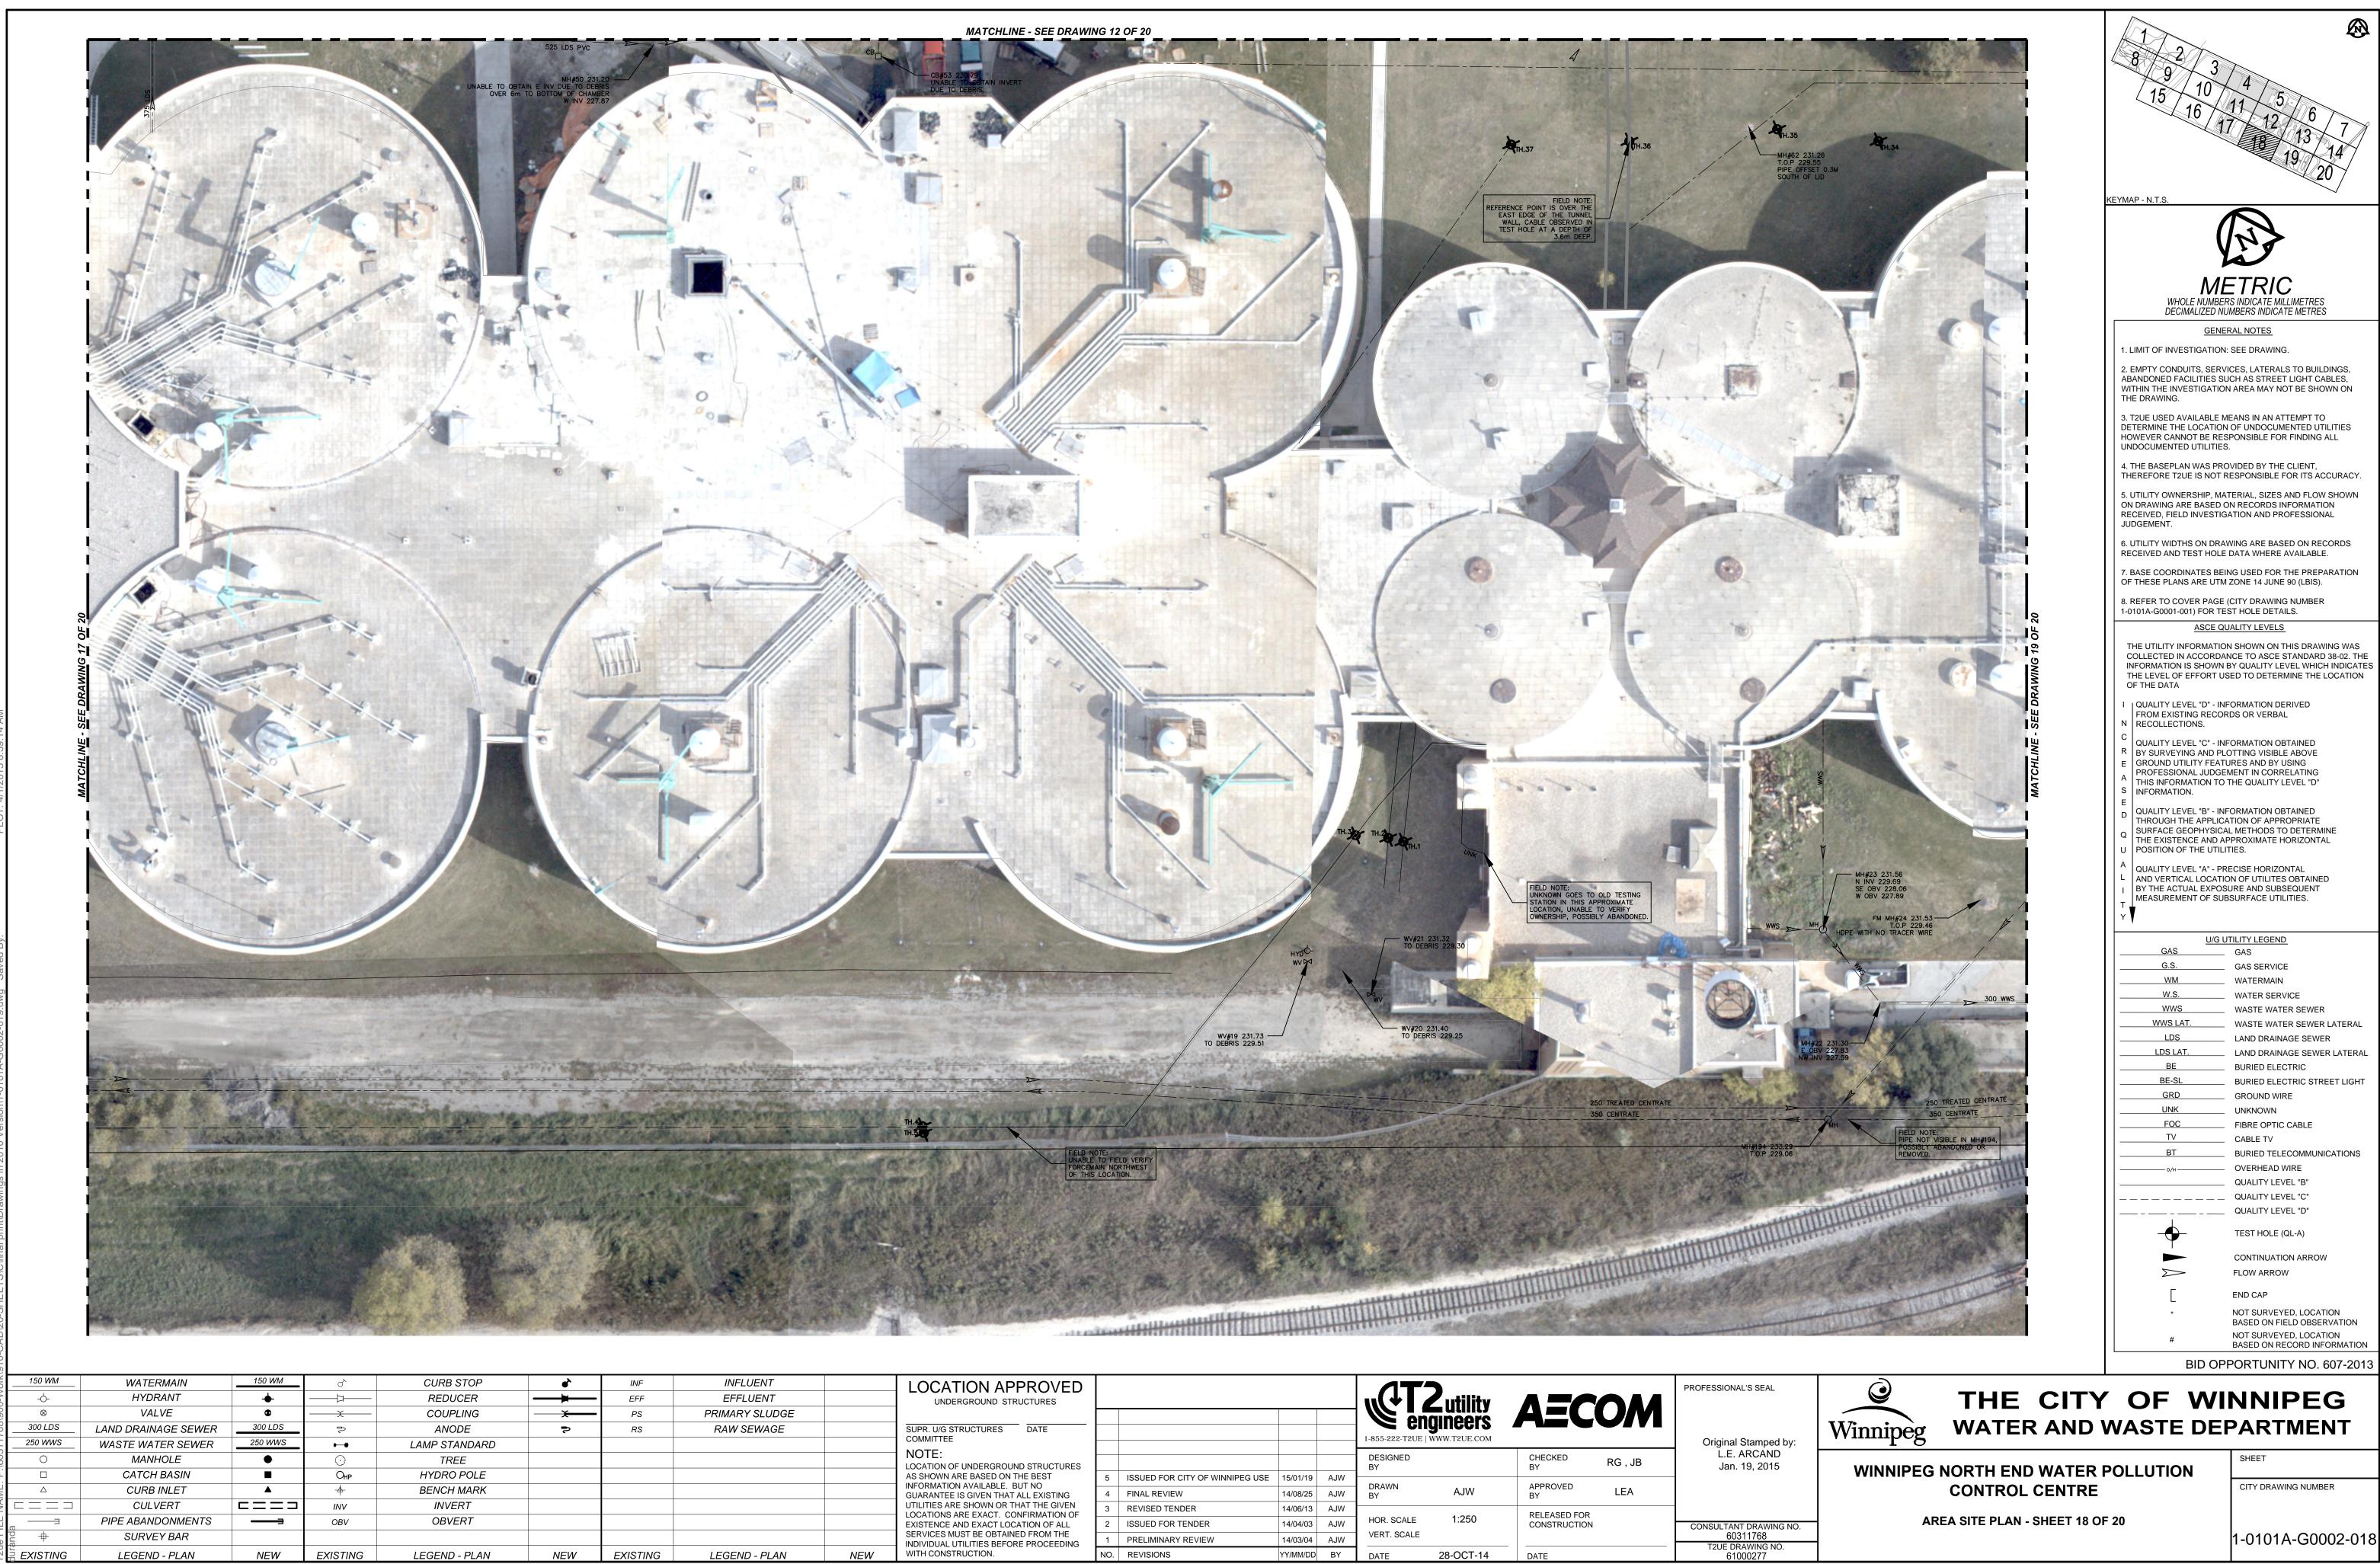


SURVEY BAR EXISTING LEGEND - PLAN NEW EXISTING LEGEND - PLAN NEW EXISTING LEGEND - PLAN

	LOCATION APPROVED UNDERGROUND STRUCTURES		1			"CT	<b>2</b> utility	AEC	OM	PROFESSIONAL'S
	SUPR. U/G STRUCTURES DATE COMMITTEE					1-855-222-T2UE	9			Original St
	NOTE: LOCATION OF UNDERGROUND STRUCTURES					DESIGNED BY		CHECKED BY	RG , JB	L.E. AF Jan. 19
	AS SHOWN ARE BASED ON THE BEST INFORMATION AVAILABLE. BUT NO GUARANTEE IS GIVEN THAT ALL EXISTING	5 4	ISSUED FOR CITY OF WINNIPEG USE FINAL REVIEW	15/01/19 14/08/25	AJW AJW	DRAWN BY	AJW	APPROVED BY	LEA	
	UTILITIES ARE SHOWN OR THAT THE GIVEN LOCATIONS ARE EXACT. CONFIRMATION OF	3	REVISED TENDER	14/06/13	AJW		1.050	RELEASED FOR		-
	EXISTENCE AND EXACT LOCATION OF ALL SERVICES MUST BE OBTAINED FROM THE	2		14/04/03	-	HOR. SCALE VERT. SCALE	1:250	CONSTRUCTION		CONSULTANT E
NEW	INDIVIDUAL UTILITIES BEFORE PROCEEDING WITH CONSTRUCTION.	NO.	PRELIMINARY REVIEW REVISIONS	14/03/04 YY/MM/DD	AJW BY	DATE	28-OCT-14	DATE		T2UE DRAV 61000

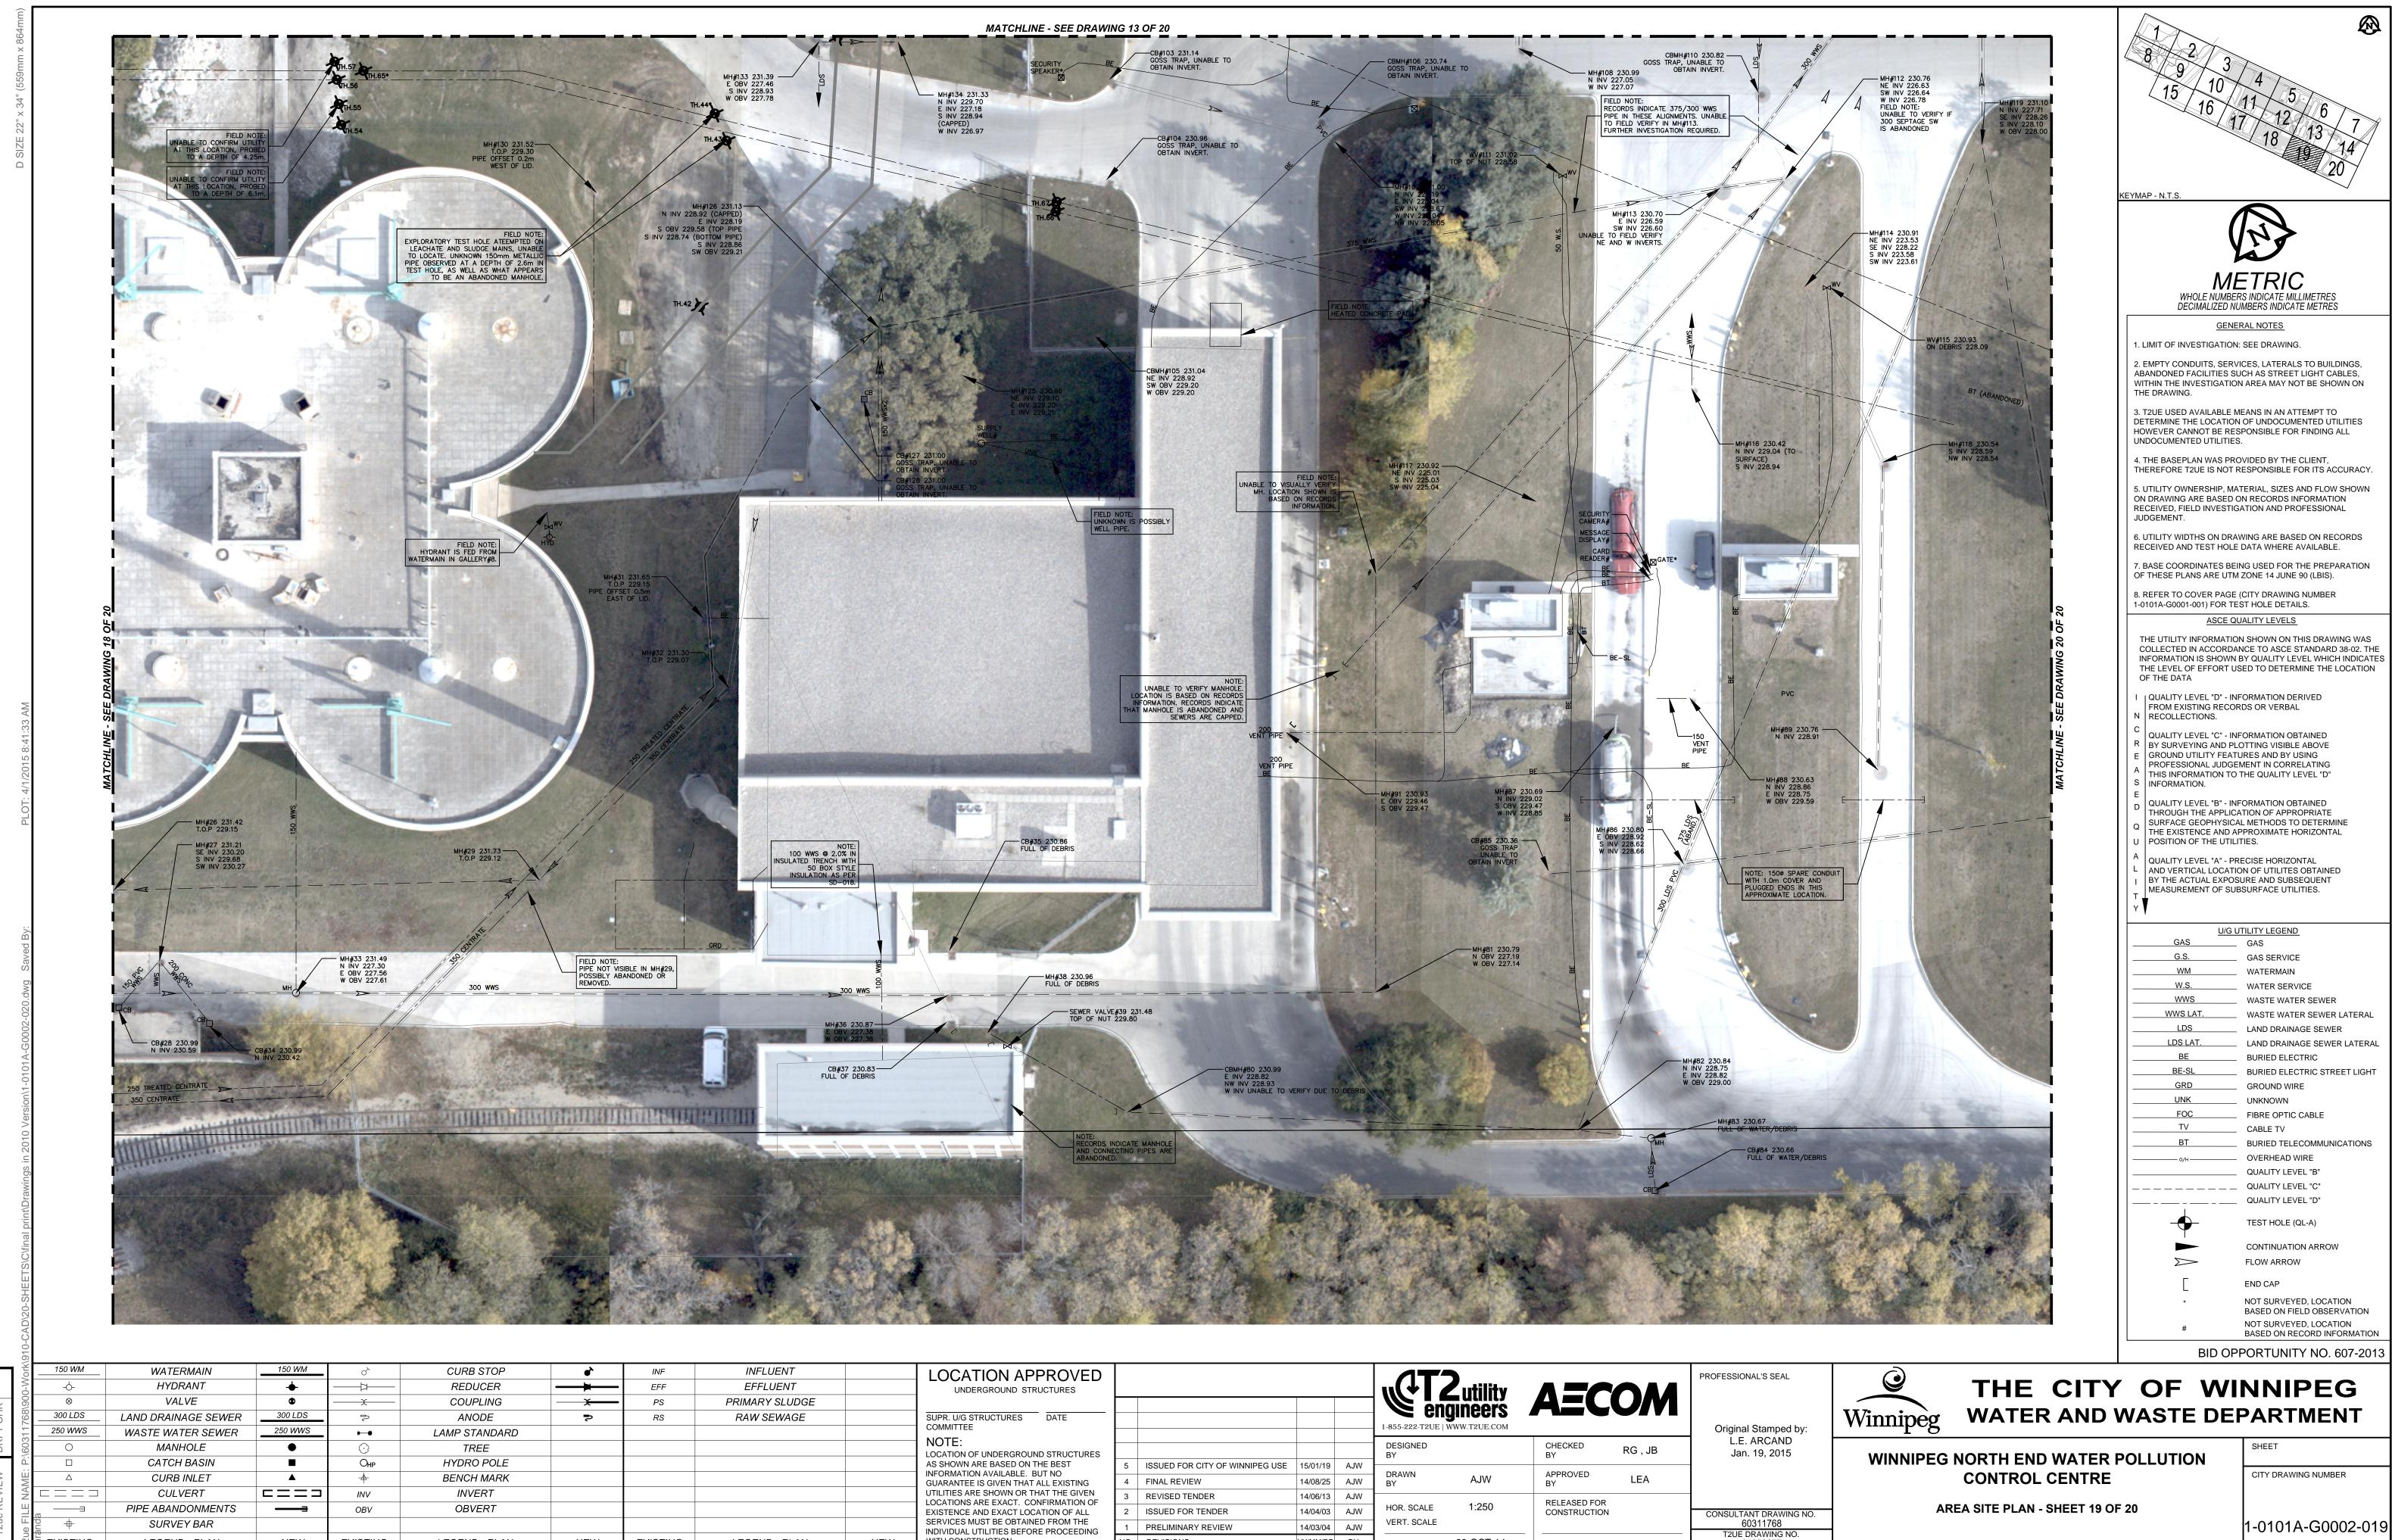

150 WM	WATERMAIN	150 WM	0×	CURB STOP	▲	INF	INFLUENT	
-\$-	HYDRANT	+		REDUCER	<b>—</b>	EFF	EFFLUENT	
$\otimes$	VALVE	8	X	COUPLING	<b>— X</b> —	PS	PRIMARY SLUDGE	
300 LDS	LAND DRAINAGE SEWER	300 LDS	ĥ	ANODE	2	RS	RAW SEWAGE	
250 WWS	WASTE WATER SEWER	250 WWS	* *	LAMP STANDARD				
0	MANHOLE	•	$\odot$	TREE				
	CATCH BASIN		Онр	HYDRO POLE				
Δ	CURB INLET		4	BENCH MARK				
	CULVERT		INV	INVERT				
м — — — — — — — — — — — — — — — — — — —	PIPE ABANDONMENTS		OBV	OBVERT				
anda 中	SURVEY BAR							
EXISTING	LEGEND - PLAN	NEW	EXISTING	LEGEND - PLAN	NEW	EXISTING	LEGEND - PLAN	

	LOCATION APPROVED UNDERGROUND STRUCTURES				CT2utility AECOM			PROFESSIONAL'S S	
	SUPR. U/G STRUCTURES DATE COMMITTEE					GINEERS www.t2ue.com	AEC	UM	Original Star
	NOTE: LOCATION OF UNDERGROUND STRUCTURES				DESIGNED BY		CHECKED BY	RG , JB	L.E. ARC/ Jan. 19, 2
	AS SHOWN ARE BASED ON THE BEST INFORMATION AVAILABLE. BUT NO GUARANTEE IS GIVEN THAT ALL EXISTING UTILITIES ARE SHOWN OR THAT THE GIVEN LOCATIONS ARE EXACT. CONFIRMATION OF	5     ISSUED FOR CITY OF WINNIPEG USE       4     FINAL REVIEW	15/01/19 14/08/25	AJW AJW	DRAWN BY	AJW	APPROVED BY	LEA	
		3 REVISED TENDER	14/06/13	AJW	HOR. SCALE 1:250		RELEASED FOR		-
	EXISTENCE AND EXACT LOCATION OF ALL SERVICES MUST BE OBTAINED FROM THE	2 ISSUED FOR TENDER     1 PRELIMINARY REVIEW	14/04/03 14/03/04	AJW	VERT. SCALE	1.200	CONSTRUCTION		CONSULTANT DR 6031170
NEW	INDIVIDUAL UTILITIES BEFORE PROCEEDING WITH CONSTRUCTION.	NO. REVISIONS	YY/MM/DD	-	DATE	28-OCT-14	DATE		T2UE DRAWII 610002

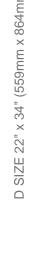



NEV

6									
'ork'	150 WM	WATERMAIN	150 WM	°≻	CURB STOP	•	INF	INFLUENT	
: P:\60311768\900-W	-\$-	HYDRANT	<b>.</b>		REDUCER		EFF	EFFLUENT	
	$\otimes$	VALVE	۲	X	COUPLING	<b>X</b>	PS	PRIMARY SLUDGE	
	300 LDS	LAND DRAINAGE SEWER		N	ANODE	٩	RS	RAW SEWAGE	
	250 WWS	WASTE WATER SEWER	250 WWS	* *	LAMP STANDARD				
	0	MANHOLE	•	$\odot$	TREE				
		CATCH BASIN		Онр	HYDRO POLE				
ME	Δ	CURB INLET		4	BENCH MARK				
ΝA		CULVERT		INV	INVERT				
Ш	ш	PIPE ABANDONMENTS		OBV	OBVERT				
еFI	and: +	SURVEY BAR							
T2u	EXISTING	LEGEND - PLAN	NEW	EXISTING	LEGEND - PLAN	NEW	EXISTING	LEGEND - PLAN	

						WHOLE NUMBER         DECIMALIZED NU         GENER         1. LIMIT OF INVESTIGATION:         2. EMPTY CONDUITS, SERV         ABANDONED FACILITIES SA         WITHIN THE INVESTIGATION         3. TZUE USED AVAILABLE M         DETERMINE THE LOCATION         HE BASEPLAN WAS PROC         HE BASEPLAN WAS PROC         HUNDOCUMENTED UTILITIES         A. THE BASEPLAN WAS PROC         NEREFORE TZUE IS NOT R         S. UTILITY WIDTHS ON DRAM         RECEIVED, FIELD INVESTIG         JUDAWING ARE BASED O         RECEIVED AND LEST HOLE         7. BASE COORDINATES BEIL         ON DRAWING ARE BASED O         RECEIVED AND LEST HOLE         7. BASE COORDINATES BEIL         OLDECTED IN ACCORDANNE         B. REFER TO COVER PAGE         1. OVALITY LEVEL '0' - INIT         RECOLLECTION IN COVER PAGE         1. OVALITY LEVEL '0' - INIT         RECOLLECTION IN COVER PAGE         1. OVALITY LEVEL '0' - INIT         RECOLLECTION IN COVER PAGE         1. OVALITY LEVEL '0' - INIT         RECOLLECTION IN COVER PAGE         1. OVALITY LEVEL '0' - INIT         RE BY SURVEYING AND PLIC         1. OVALITY LEVEL '0' - INIT	ICES, LATERALS TO BUILDINGS, ICH AS STREET LIGHT CABLES, N AREA MAY NOT BE SHOWN ON EANS IN AN ATTEMPT TO OF UNDOCUMENTED UTILITIES SPONSIBLE FOR FINDING ALL S. OVIDED BY THE CLIENT, RESPONSIBLE FOR ITS ACCURACY. TERIAL, SIZES AND FLOW SHOWN ION RECORDS INFORMATION ATION AND PROFESSIONAL WING ARE BASED ON RECORDS DATA WHERE AVAILABLE. NG USED FOR THE PREPARATION ZONE 14 JUNE 90 (LBIS). (CITY DRAWING NUMBER ST HOLE DETAILS. JALITY LEVELS N SHOWN ON THIS DRAWING WAS NCE TO ASCE STANDARD 38-02. THE BY QUALITY LEVEL WHICH INDICATES SED TO DETERMINE THE LOCATION FORMATION DERIVED RDS OR VERBAL FORMATION OBTAINED DITING VISIBLE ABOVE JRES AND BY USING MENT IN CORRELATING THE QUALITY LEVEL "D" FORMATION OBTAINED DITING VISIBLE ABOVE JRES AND BY USING MENT IN CORRELATING THE QUALITY LEVEL "D"
Image: Construction of the provided of the prov	5       ISSUED FOR CITY OF WINNIPEG USE	Designed BY           15/01/19         AJW	CHECKED BY	RG , JB	Winnipeg WAT		BURIED ELECTRIC BURIED ELECTRIC STREET LIGHT GROUND WIRE UNKNOWN FIBRE OPTIC CABLE CABLE TV BURIED TELECOMMUNICATIONS OVERHEAD WIRE QUALITY LEVEL "B" QUALITY LEVEL "C" QUALITY LEVEL "C" QUALITY LEVEL "D" TEST HOLE (QL-A) CONTINUATION ARROW FLOW ARROW END CAP NOT SURVEYED, LOCATION BASED ON FIELD OBSERVATION NOT SURVEYED, LOCATION BASED ON RECORD INFORMATION PORTUNITY NO. 607-2013 <b>SHEET</b>
GUARANTEE IS GIVEN THAT ALL EXISTING UTILITIES ARE SHOWN OR THAT THE GIVEN LOCATIONS ARE EXACT. CONFIRMATION OF EXISTENCE AND EXACT LOCATION OF ALL SERVICES MUST BE OBTAINED FROM THE INDIVIDUAL UTILITIES BEFORE PROCEEDING	<ul> <li>4 FINAL REVIEW</li> <li>3 REVISED TENDER</li> <li>2 ISSUED FOR TENDER</li> <li>1 PRELIMINARY REVIEW</li> <li>NO. REVISIONS</li> </ul>	14/08/25         AJW         DRAWN BY           14/06/13         AJW           14/04/03         AJW           14/03/04         AJW           YY/MM/DD         BY	AJW APPROVED BY BY RELEASED F CONSTRUCT 28-OCT-14 DATE	FOR	G NO. AREA SITE PI	ROL CENTRE _AN - SHEET 20 OF 20	CITY DRAWING NUMBER