


EXISTING


DETAIL A
1: 15

(PIER CAP REMEDIAL WORK DETAIL)

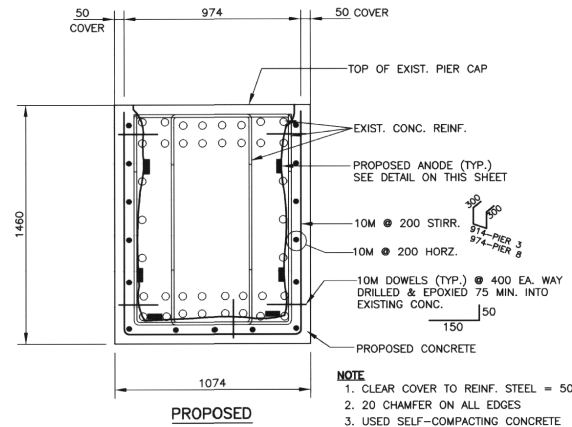

PROPOSED


NOTE
1. CLEAR COVER TO REINF. STEEL = 50
2. 20 CHAMFER ON ALL EDGES
3. USED SELF-COMPACTING CONCRETE IN THE JACKET OF THE CAPS (10mm AGGREGATE).

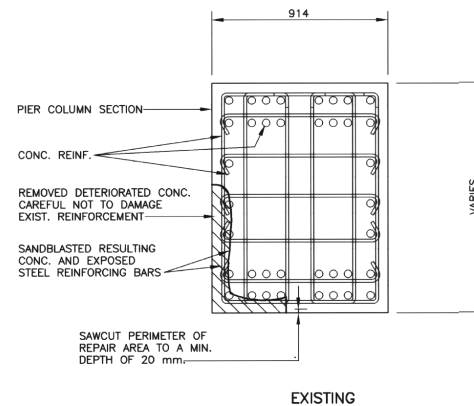


EXISTING

SECTION 2
1: 15


(PIER COLUMN REMEDIAL WORK DETAIL)

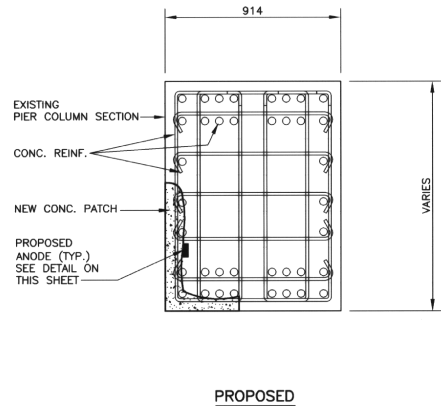

PROPOSED

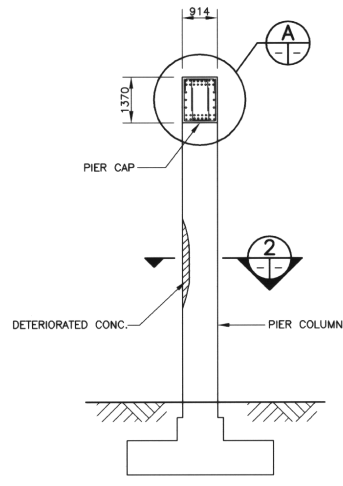

SECTION 1
1: 75

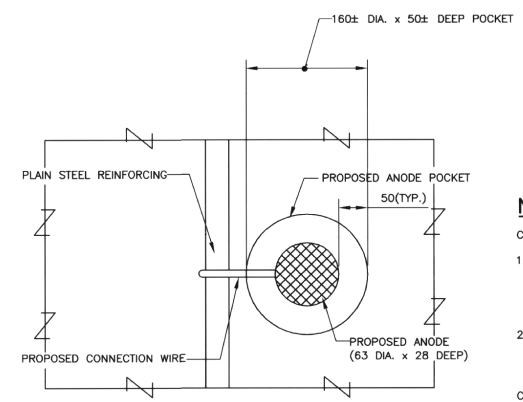

ANODE TO REBAR CONNECTION DETAIL
1: 5

NOTES:

- COLUMNS:
- PLACED ANODE IN LOW RESISTIVITY MORTAR/GROUT
 - COVERED ALL SURFACES OF ANODE WITH GROUT. (CONTRACTOR USED SIKA-GROUT 212).
 - SURFACE OF ANODE TO FLUSHED WITH SURFACE OF LONGITUDINAL REINFORCING.
 - PIER 8 COLUMNS COMPLETELY COATED WITH "SIL-FLEX" TO COVER HAIRLINE CRACKS IN THE "EMACO S66" PATCH MATERIAL AND TO COSMETICALLY MAKE THE ENTIRE COLUMNS UNIFORM. THE CITY PLANS TO DO THE SAME ON PIER 3 THEMSELVES.
- CAPS:
- CONTRACTOR USED A NATURALLY LOW RESISTIVITY SELF COMPACTING CONCRETE SUPPLIED BY BUILDING PRODUCTS TO "JACKET" THE PIER CAP. THEREFORE, NO SEPARATE GROUT WAS REQUIRED TO ENCASE THE ANODES INTO THE CAP.

RECORD DRAWING
R.A. WIEBE, P.ENG 02/5/03
APPROVED BY: DATE:

B.M. ELEV.	DESIGNED BY: A.S.D.				CITY DRAWING NUMBER B121-02-03AC
	DRAWN BY: N.B.G.				
	CHECKED BY: R.A.W.	DATE: AUG. 2002	ORIGINAL SIGNED BY B. EBENSPIGGER, P.Eng.	ORIGINAL PROJECT NO.	SHEET 3 OF 3
	APPROVED BY:				
	SCALE: HORIZ. AS SHOWN VERT.				
	DATE:				
	NO. REVISIONS	DATE	BY		