


TYPICAL RIPRAP EDGE DETAIL

**LEGEND**

- NEW GROUDED FIELDSTONE RIPRAP
- EXIST. FIELDSTONE RIPRAP TO BE REMOVED

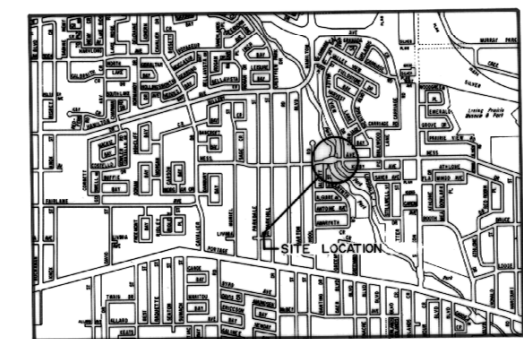

LOCATION PLAN

**RECORD DRAWING**

APPROVED BY: *[Signature]* DATE: 02 11 07

NO.	REVISIONS	DATE	BY

**DILLON**  
Consulting Engineers • Planners  
Environmental Scientists

DESIGNED BY	B.A.N.	CHECKED BY	R.A.W.
DRAWN BY	R.M.A.	APPROVED BY	R.A.W.
HOR. SCALE	N.T.S.	DATE	08-08-03
VERTICAL	N.T.S.	DATE	08-08-03

ENGINEER'S SEAL

PROVINCE OF MANITOBA

08 07 22

R.A. WIEBE

REGISTERED ENGINEER

CONSULTANT DRAWING NO.

**THE CITY OF WINNIPEG**  
WORKS AND OPERATIONS DIVISION

**1988 BRIDGE MAINTENANCE**  
MISCELLANEOUS REHABILITATION WORKS  
PHASE I

NESS AVE. AT STURGEON CREEK  
WORKS

CITY DRAWING NUMBER  
C324-88-01  
SHEET 1 OF 2

B-5798-1