


NOTE:
 1. EXCAVATE UNSUITABLE SUB-GRADE AS ADVISED BY CONTRACT ADMINISTRATOR.
 2. WHERE CALLED FOR, FLEXIBLE JOINT SEALANT SHALL BE A SINGLE COMPONENT GUN GRADE POLYURETHANE.

RECORD DRAWING
R. A. Wiebe 93.08.27
 APPROVED BY: DATE

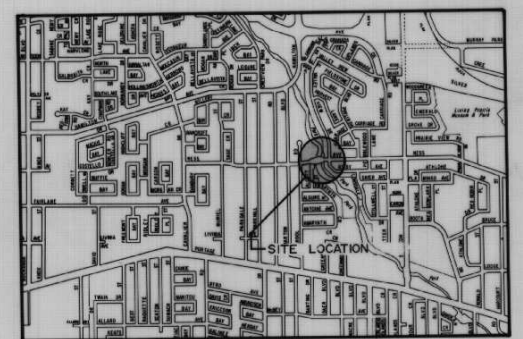

NO.	REVISIONS	DATE	BY

DILLON
 Consulting Engineers • Planners
 Environmental Scientists

DESIGNED BY: R. A. W.	CHECKED BY: R. A. W.
DRAWN BY: C. R. B.	APPROVED BY: N. B. U.
HOR. SCALE: N.T.S.	VERTICAL: N.T.S.
DATE: AUG. 1993	DATE: 93-08-27

THE CITY OF WINNIPEG
 WORKS AND OPERATIONS DIVISION

1993 FLOOD DAMAGE REPAIR

NESS AVE. AT STURGEON CREEK

CONSULTANT DRAWING NO. 93-1469-01

CITY DRAWING NUMBER C324-93-01
 SHEET 1 OF 2

B-5924-1