


SECTION 3
SCALE: 3/4" = 1'-0"

- GENERAL NOTES**
1. THE CONTRACTOR SHALL BE RESPONSIBLE FOR VERIFYING LOCATIONS OF EXIST. UNDERGROUND SERVICES PRIOR TO CONSTRUCTION. AND NOTIFY UTILITIES.
 2. SEE THE CITY OF WINNIPEG STANDARD CONSTRUCTION SPECIFICATIONS 1979 FOR LONGITUDINAL JOINTS (DWG. NO. SD-209) & TRANSVERSE JOINTS (DWG. NO. SD-210)
 3. NEW PAVEMENT GRADES & STATIONS ARE SHOWN IN METRIC VALUES ONLY.

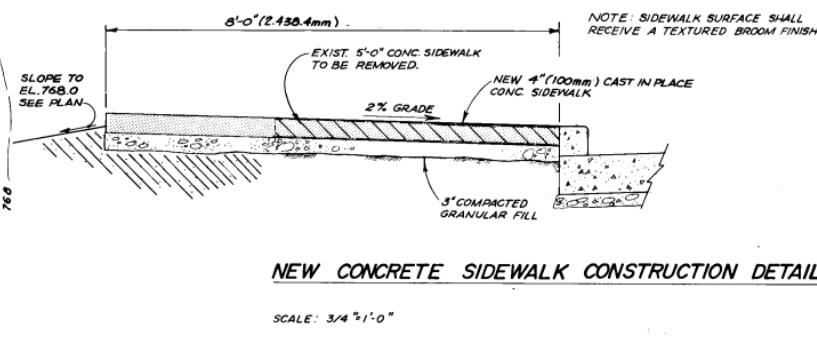

NEW CONCRETE SIDEWALK CONSTRUCTION DETAIL
SCALE: 3/4" = 1'-0"

SECTION AT CULVERT
SCALE: 1" = 10'


AS BUILT
APPROVED BY: *R. Wiebe*

B-5156-2

NO.	DATE	REVISIONS

DESIGN	RA
DRAWN	G.A.M. DCG.
CHECKED	RA
APPROVED	RA
DATE	MAY 1979
SCALE	AS NOTED

RELEASED FOR CONSTRUCTION
MANAGER OF STREETS AND TRAFFIC
DATE

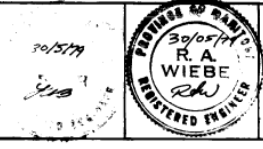

THE CITY OF WINNIPEG
WORKS AND OPERATIONS DEPARTMENT
STREETS AND TRANSPORTATION DIVISION

Consulting Engineers & Planners
DILLON

PROJECT NO.	
DRAWN	G.A.M. DCG.
CHECKED	RA
APPROVED	RA
DATE	MAY 1979
SCALE	AS NOTED

NESS AVENUE
STURGEON CREEK CROSSING
PAVEMENT & BANK
FLOOD REPAIRS
PROJECT NO. MMD.
SHEET NO. C324-79-01