


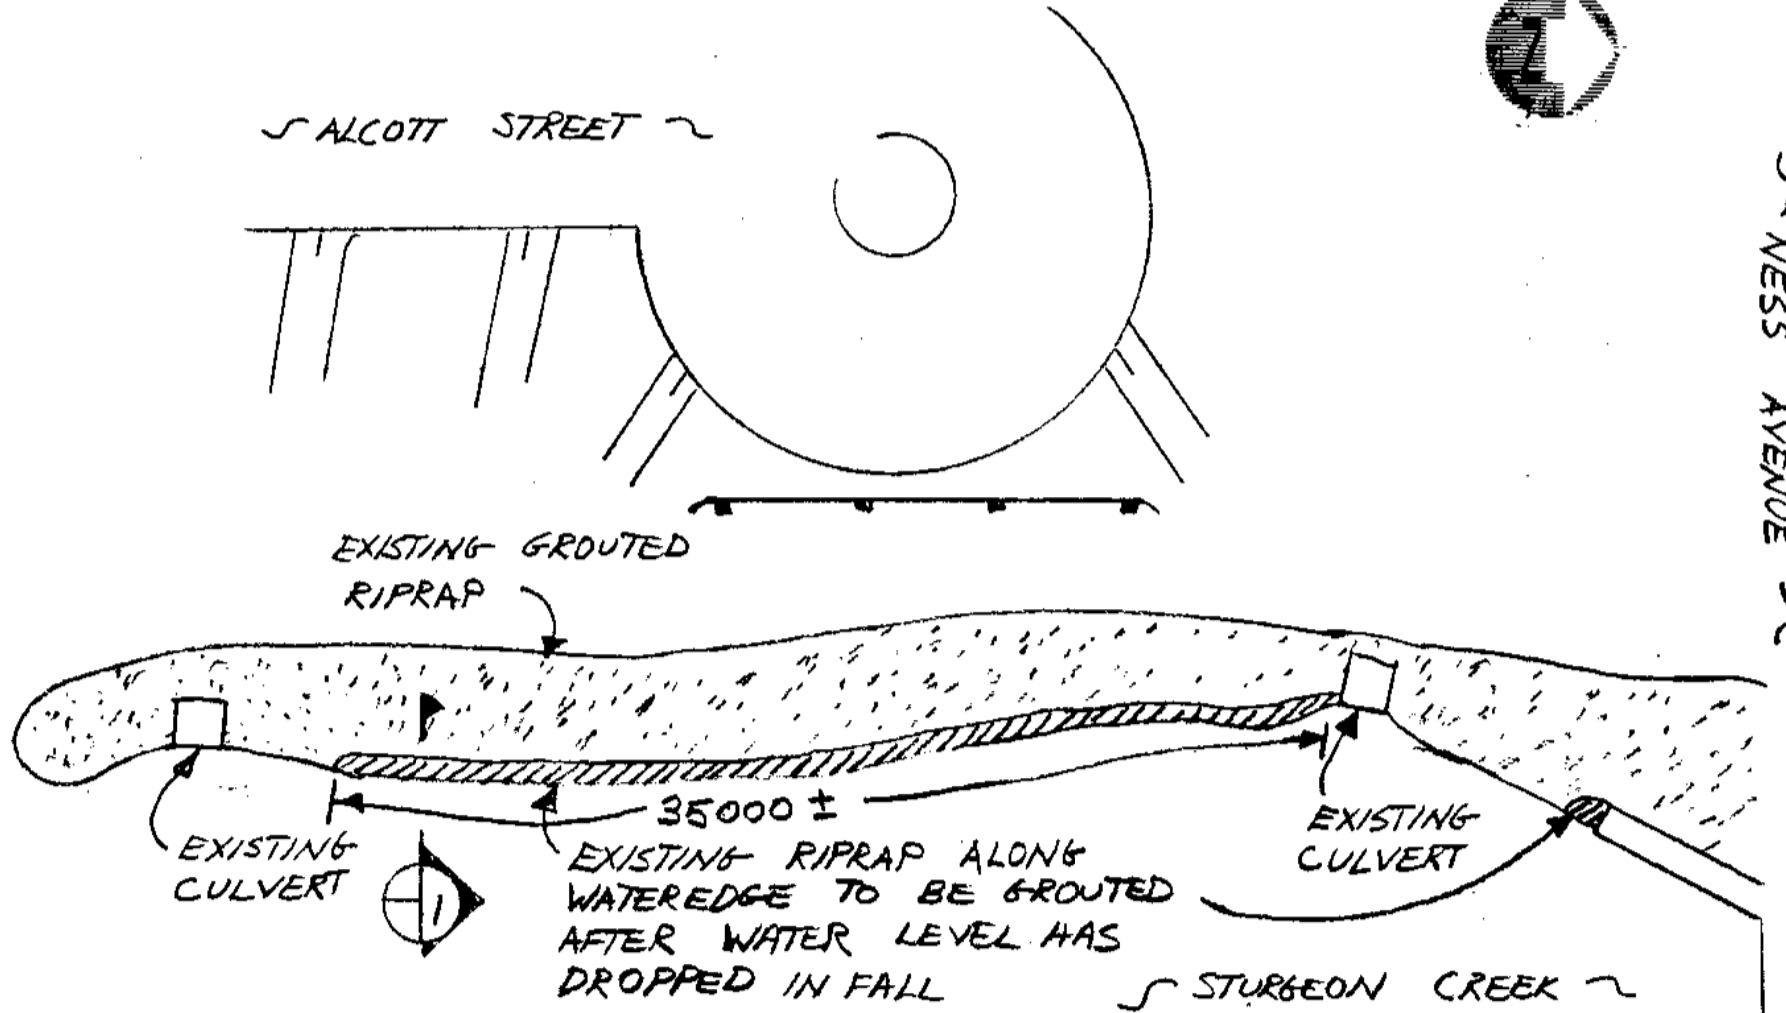


ALCOTT STREET

NESS AVENUE




**AS BUILT**

APPROVED BY: *H. Hunter*

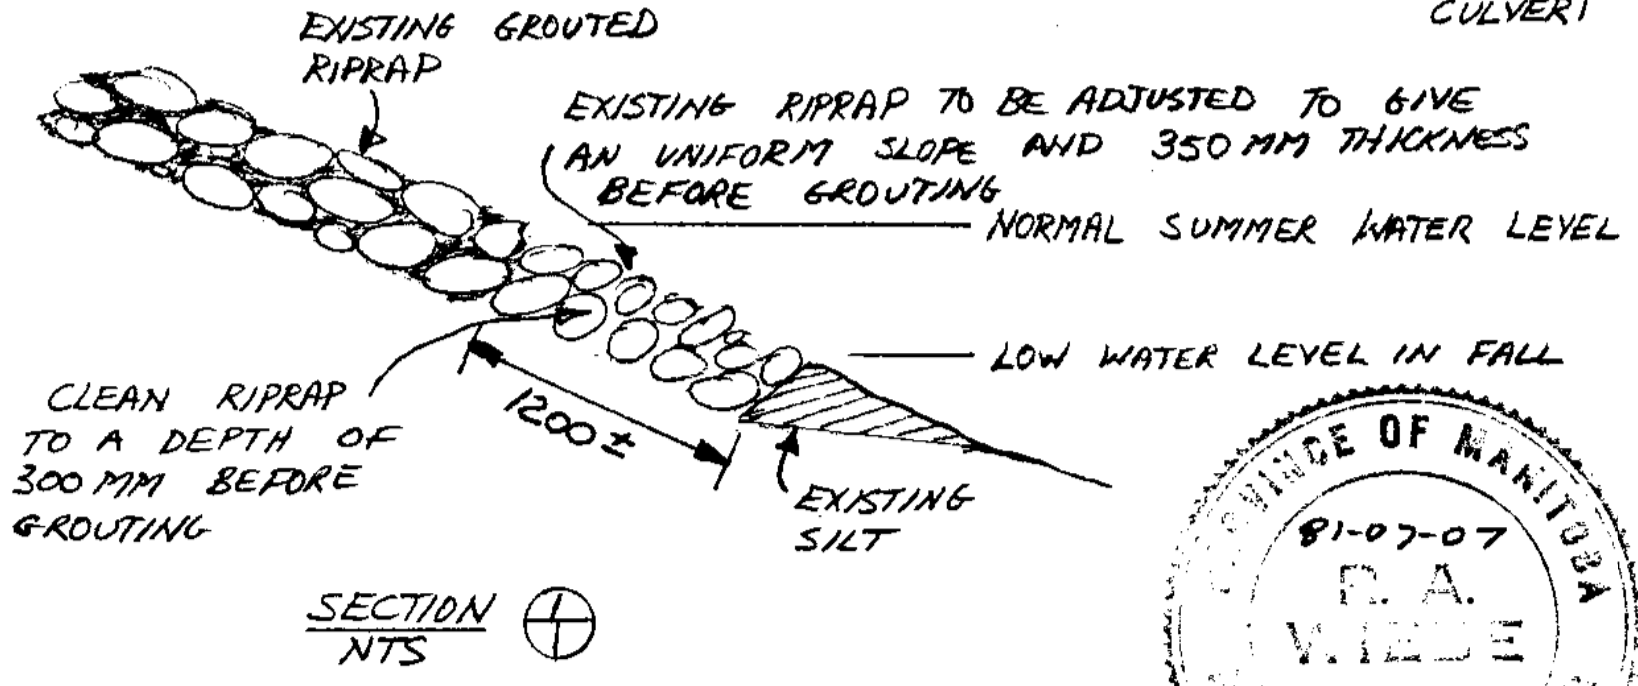

B-5348

CITY OF WINNIPEG ACCEPTED FOR CONST. BY <i>H. Hunter</i> DATE 81-10-05		MM DILLON APPROVED BY <i>W. B. Wiese</i> DATE 6/2/81
 <b>Consulting Engineers &amp; Planners</b>	TITLE <i>NESS AVENUE AT STURGEON CREEK - GROUDED RIPRAP ALONG S.W. BANK</i>	PROJECT NO. 9029-01
	PROJECT <i>BRIDGE MAINTENANCE PHASE 8101</i>	DRAWING NO. <i>C324-81-01</i> 1 of 1
DATE <i>JUNE, 1981</i>		