



TRANSCONA YARD



- ① Holding Tank 17'4" FROM EAST side of buildi
23' Feet SOUTH OF building.
- ② Well Head 9' Feet FROM NORTH
Side OF GARAGE.

Septic Field
APROX 74 x 73 FT SITS
58 FEET SOUTH OF Well Head.

DUGALD RD

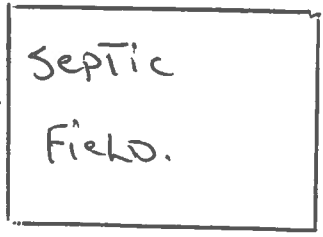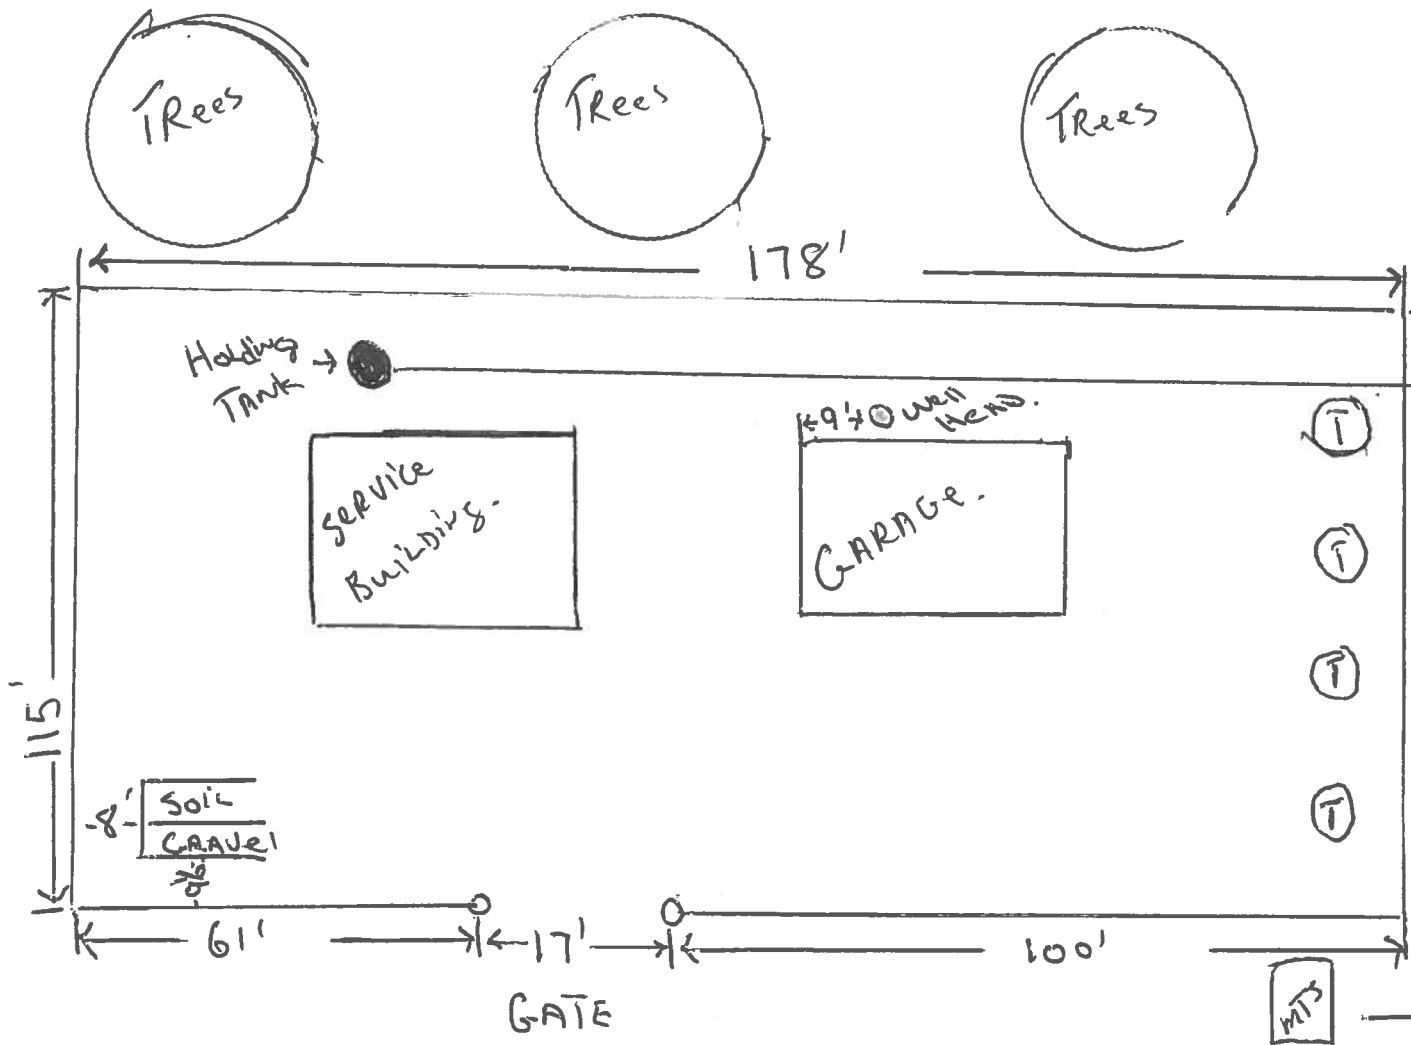

MTS Box @ 97' From SOUTH
Side OF GATE.