



BLOCKOUT
450x450 FOR
FLEXBEAM POST
EAST WINGWALL
EAST ABUT.

2500 1300

EXCAVATE EXISTING
GROUND TO PROVIDE
UNIFORM GRADIENT
ON TOP OF RIP RAP



7000

NOTE: BLOCKOUTS 450x450
TO BE LEFT FOR FLEX-
BEAM POST WHERE
SPECIFIED BY THE
ENGINEER.

LIMIT OF
EXISTING
RIP-RAP

OMANDS CREEK

900

900



AS BUILT
APPROVED BY: *R. Wiebe*


WEST ABUT.
WEST WINGWALL
BLOCKOUT 450x450
FOR FLEXBEAM
POST
SIDEWALK

6000


1400 TYP.

SWALE IN RIP-RAP TO GUIDE
RUN-OFF INTO CHANNEL.

PLAN
N.T.S.

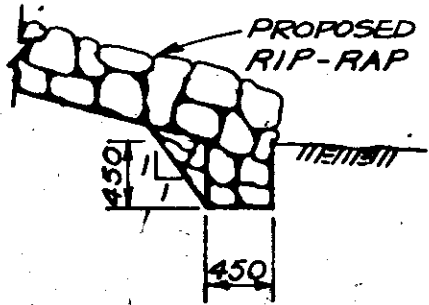

SECTION 1
N.T.S.
(AT TOE OF SLOPE)

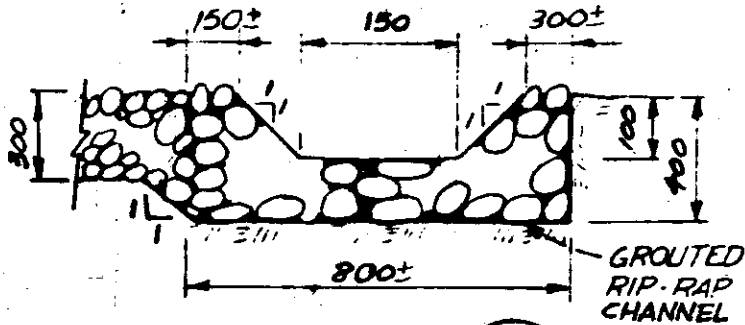

SECTION 2
N.T.S.

B-5199



Consulting
Engineers
& Planners

TITLE SASKATCHEWAN AVE. BRIDGE
AT OMAND'S CREEK

PROJECT NO.
M.M.D. 8584

DATE JULY, 1979

PROJECT
BRIDGE MAINTENANCE - PHASE 7904

DRAWING NO
B144-79-01