


\\CD1201-F02\work\_group\1112\active\111213650\0300\_drawing\305\_record\sheet\_files\electrical\Olive (Ainslie)\13650e-2201-olv.dwg  
 2013/08/22 10:18 AM By: Betker, Kyle

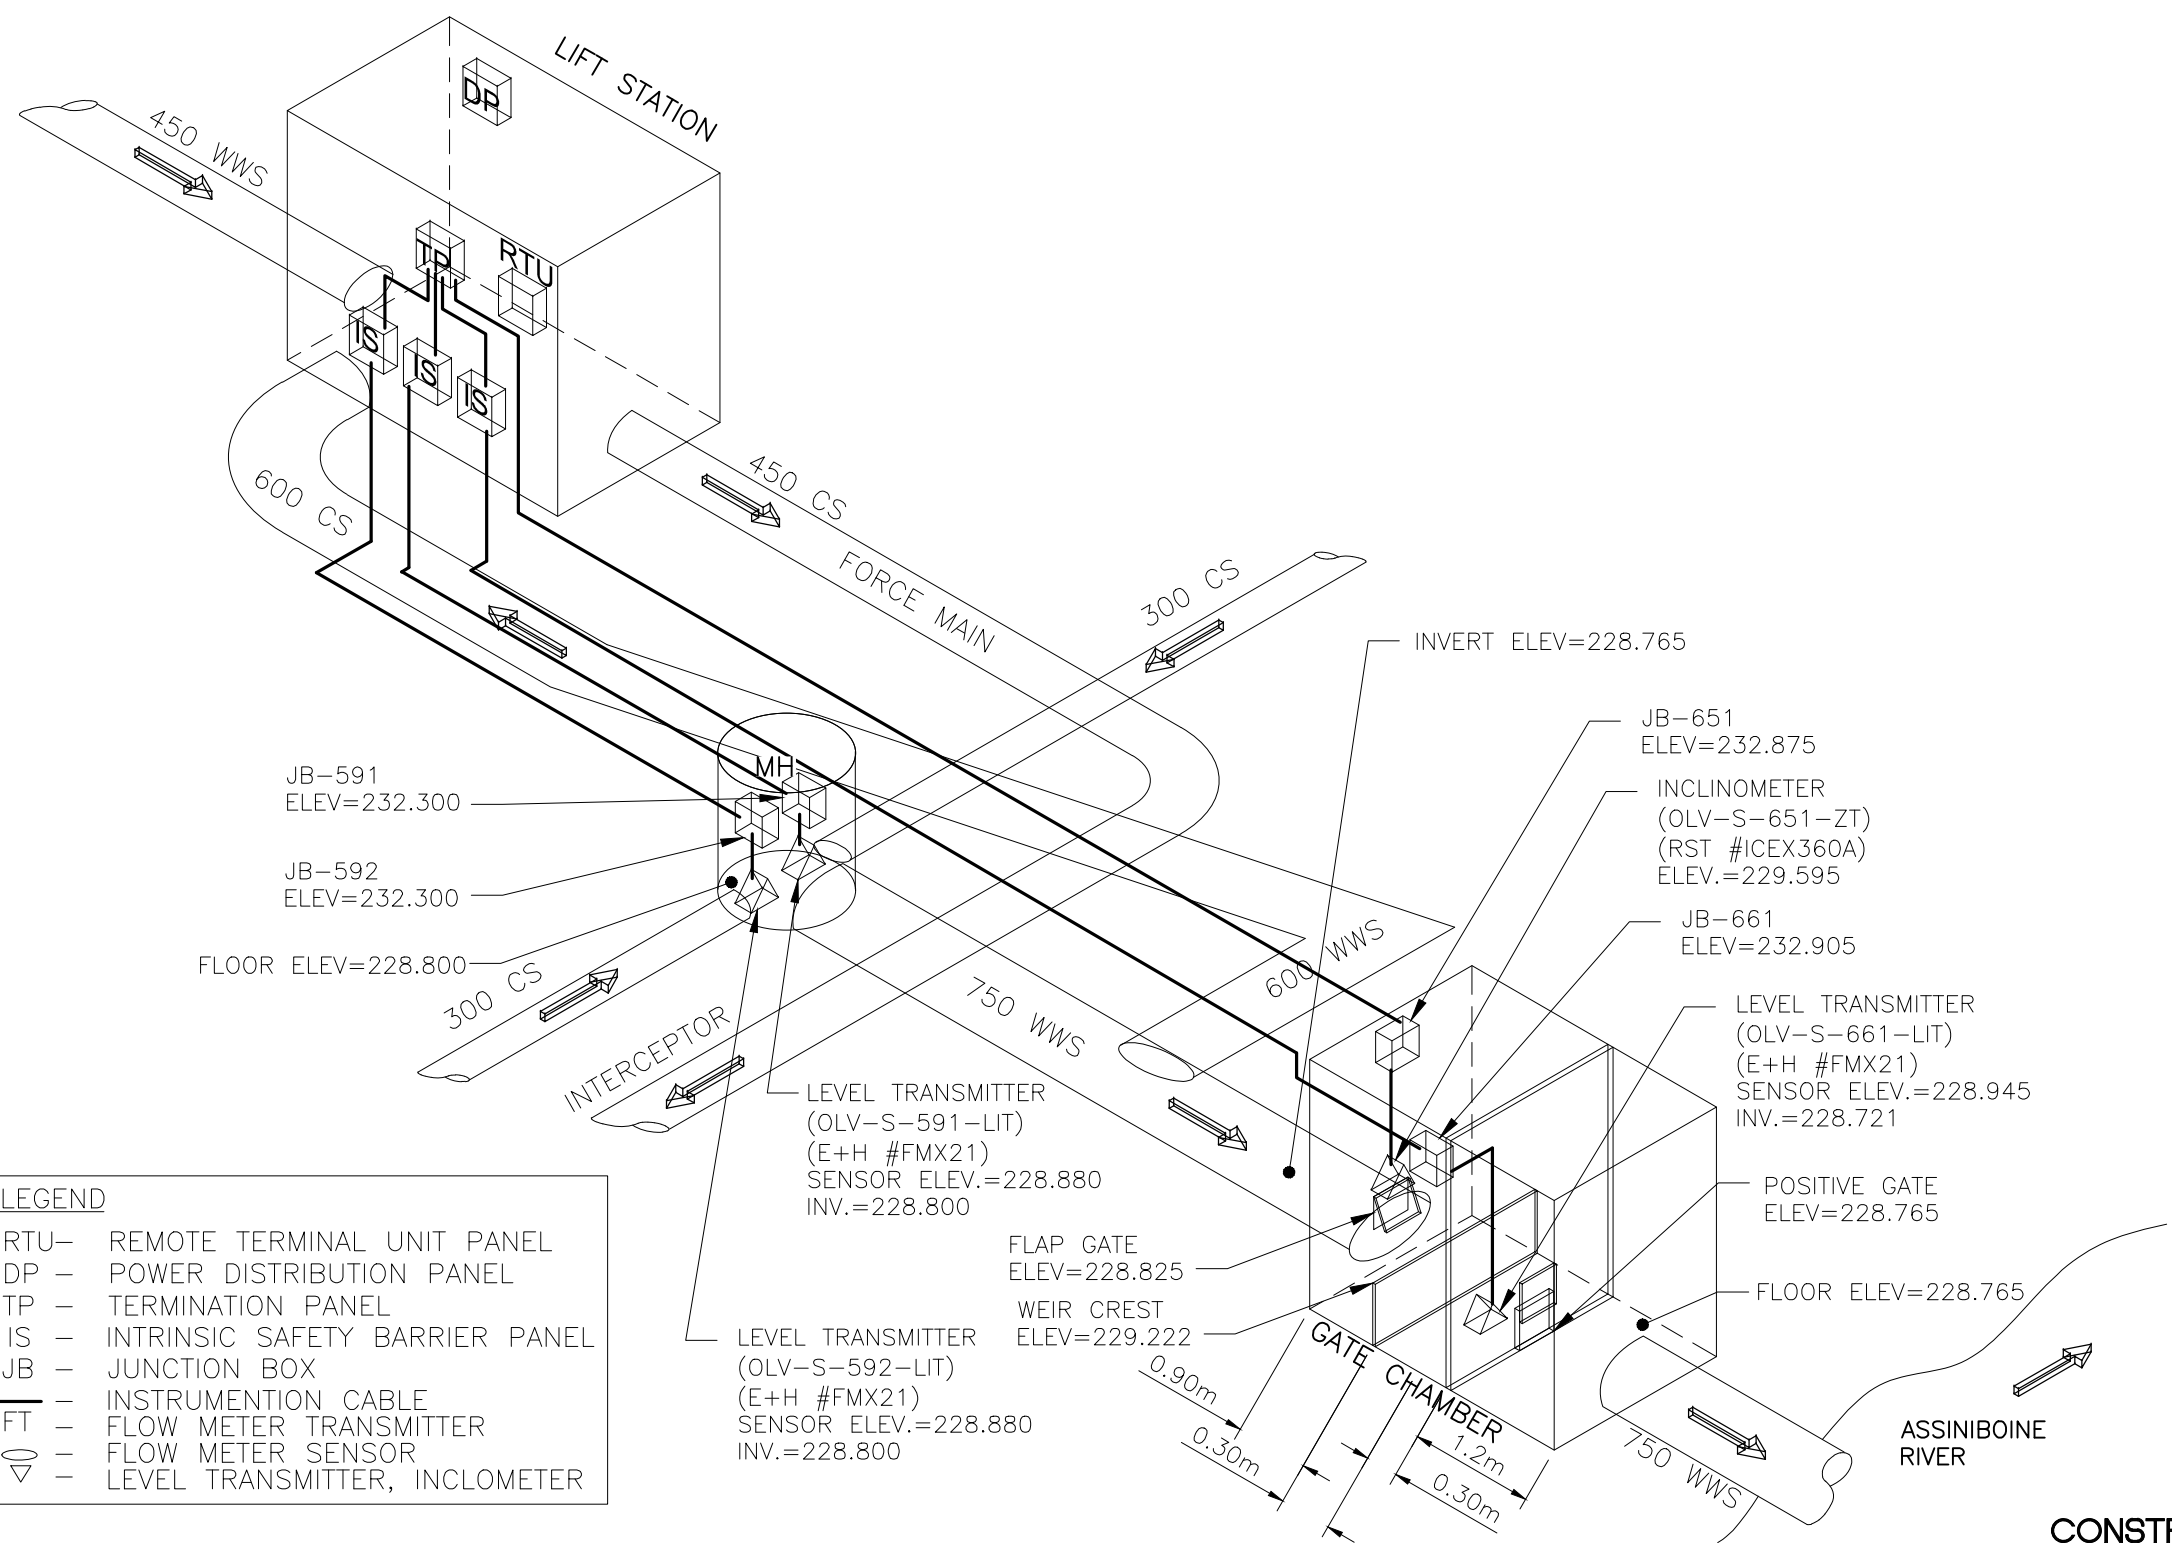

**LEGEND**

- RTU- REMOTE TERMINAL UNIT PANEL
- DP - POWER DISTRIBUTION PANEL
- TP - TERMINATION PANEL
- IS - INTRINSIC SAFETY BARRIER PANEL
- JB - JUNCTION BOX
- — INSTRUMENTATION CABLE
- FT - FLOW METER TRANSMITTER
- - FLOW METER SENSOR
- ▽ - LEVEL TRANSMITTER, INCLINOMETER

**METRIC**  
 WHOLE NUMBERS INDICATE MILLIMETRES  
 DECIMALIZED NUMBERS INDICATE METRES

**APEGM**  
 Certificate of Authorization  
 Stantec Consulting Ltd.  
 No. 1301

CONSTRUCTION COMPLETION DATE - FEBRUARY 2013

**LOCATION APPROVED UNDERGROUND STRUCTURES**

| SUPV. U/G STRUCTURES COMMITTEE | DATE |
|--------------------------------|------|
|                                |      |

**NOTE:**  
 LOCATION OF UNDERGROUND STRUCTURES AS SHOWN ARE BASED ON THE BEST INFORMATION AVAILABLE BUT NO GUARANTEE IS GIVEN THAT ALL EXISTING UTILITIES ARE SHOWN OR THAT THE GIVEN LOCATIONS ARE EXACT. CONFIRMATION OF EXISTENCE AND EXACT LOCATION OF ALL SERVICES MUST BE OBTAINED FROM THE INDIVIDUAL UTILITIES BEFORE PROCEEDING WITH CONSTRUCTION.

| B.M. ELEV. |                          |          |      |
|------------|--------------------------|----------|------|
|            |                          |          |      |
| D          | AS-BUILT DRAWING         | 13.05.31 | S.T. |
| C          | ISSUED FOR CLIENT REVIEW | 13.04.15 | J.C. |
| B          | ISSUED FOR CLIENT REVIEW | 13.03.21 | J.C. |
| A          | ISSUED FOR CLIENT REVIEW | 12.07.13 | J.C. |
| NO.        | REVISIONS                | DATE     | BY   |

**Stantec Consulting Ltd.**  
 905 Waverley Street, Winnipeg, Manitoba  
 Tel 204-489-5900 Fax 204-453-9012

DESIGNED BY: S.T.      CHECKED BY: J.C.  
 DRAWN BY: B.W.      APPROVED BY: J.C.  
 HOR. SCALE: N.T.S.      RELEASED FOR CONSTRUCTION:  
 VERTICAL:      DATE: 2012.06.06

ENGINEER'S SEAL  
 PROVINCE OF MANITOBA  
 S. TREBIC  
 MEMBER 21332  
 REGISTERED PROFESSIONAL ENGINEER  
 CONSULTANT DRAWING NO. E-2201

**THE CITY OF WINNIPEG**  
 WATER AND WASTE DEPARTMENT

Winnipeg

**CSO OUTFALL MONITORING**  
 OLIVE STREET  
 3D ISOMETRIC PLAN

SHEET 1 OF 2  
 CAD FILE DRAWING NUMBER 13650e-2201-olv.dwg  
 CITY DRAWING NUMBER I-0169-A-A0202-001-00