



- NOTES:**
- REFER TO SCHEMATIC DRAWING WB-H0505 FOR DETAIL OF HYDRONIC PIPING CONNECTION.
  - PROVIDE FIRE DAMPER AT ALL DUCT PENETRATION THRU FLOOR.
  - PROVIDE DRIP LEG ON GAS PIPES AS REQUIRED BY APPLICABLE GAS CODE.

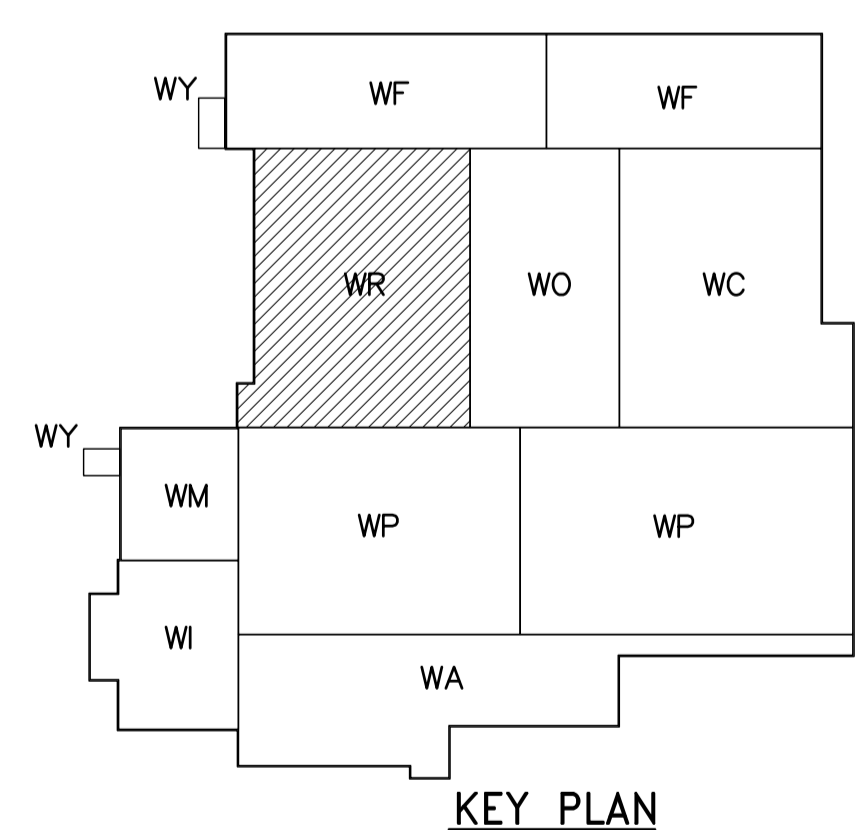

**THIRD FLOOR PLAN**  
1:100

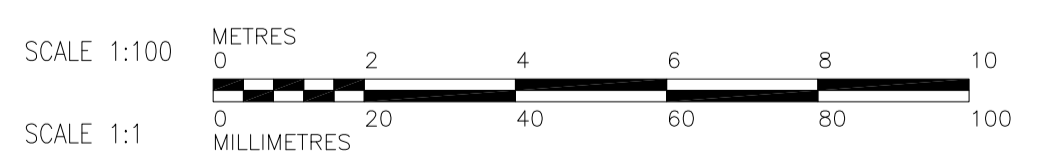

**AECOM**

As of January 3, 2009, EarthTech became AECOM Canada Ltd.

**AECOM AS-CONSTRUCTED**

SIG..... DATE.....



No. 1441 Expiry: April 30, 2007

NO.	REVISIONS	DATE	BY
02	AS CONSTRUCTED	09/11/10	ACL
01	ISSUED FOR CONSTRUCTION	06/07/28	TT
00	ISSUED FOR TENDER	06/03/29	TT

<b>CH2MHILL</b> Frederickson Cooper ARCHITECTS		<b>EarthTech</b>	
DESIGNED BY	TT	CHECKED BY	DL
DRAWN BY	AM	APPROVED BY	AHL
SCALE:	1:100	RELEASED FOR CONSTRUCTION BY:	R. SOROKOWSKI
DATE	2005/07/04	DATE	2006/03/29

ENGINEER'S SEAL  
ORIGINAL SIGNED BY  
D.K. CUDDINGTON  
2006/03/29  
CONSULTANT DRAWING NO.  
WR-H0131

**THE CITY OF WINNIPEG**  
WATER AND WASTE DEPARTMENT  
ENGINEERING DIVISION

**WATER TREATMENT PLANT**  
RESIDUALS HANDLING  
MECHANICAL AND ELECTRICAL

HVAC  
RESIDUALS HANDLING AREA  
THIRD FLOOR PLAN

CITY FILE NUMBER  
SHEET OF  
CITY DRAWING NUMBER  
1-0601R-H0002-001-02