


POWER REQUIREMENTS:

VOLTAGE-PRIMARY	120V/208	4 WIRE + GND
# OF PHASES	3	
AMPERES PER LINE	62	
MAXIMUM WATTS	22,400	
VOLTAGE-SECONDARY	N/A	

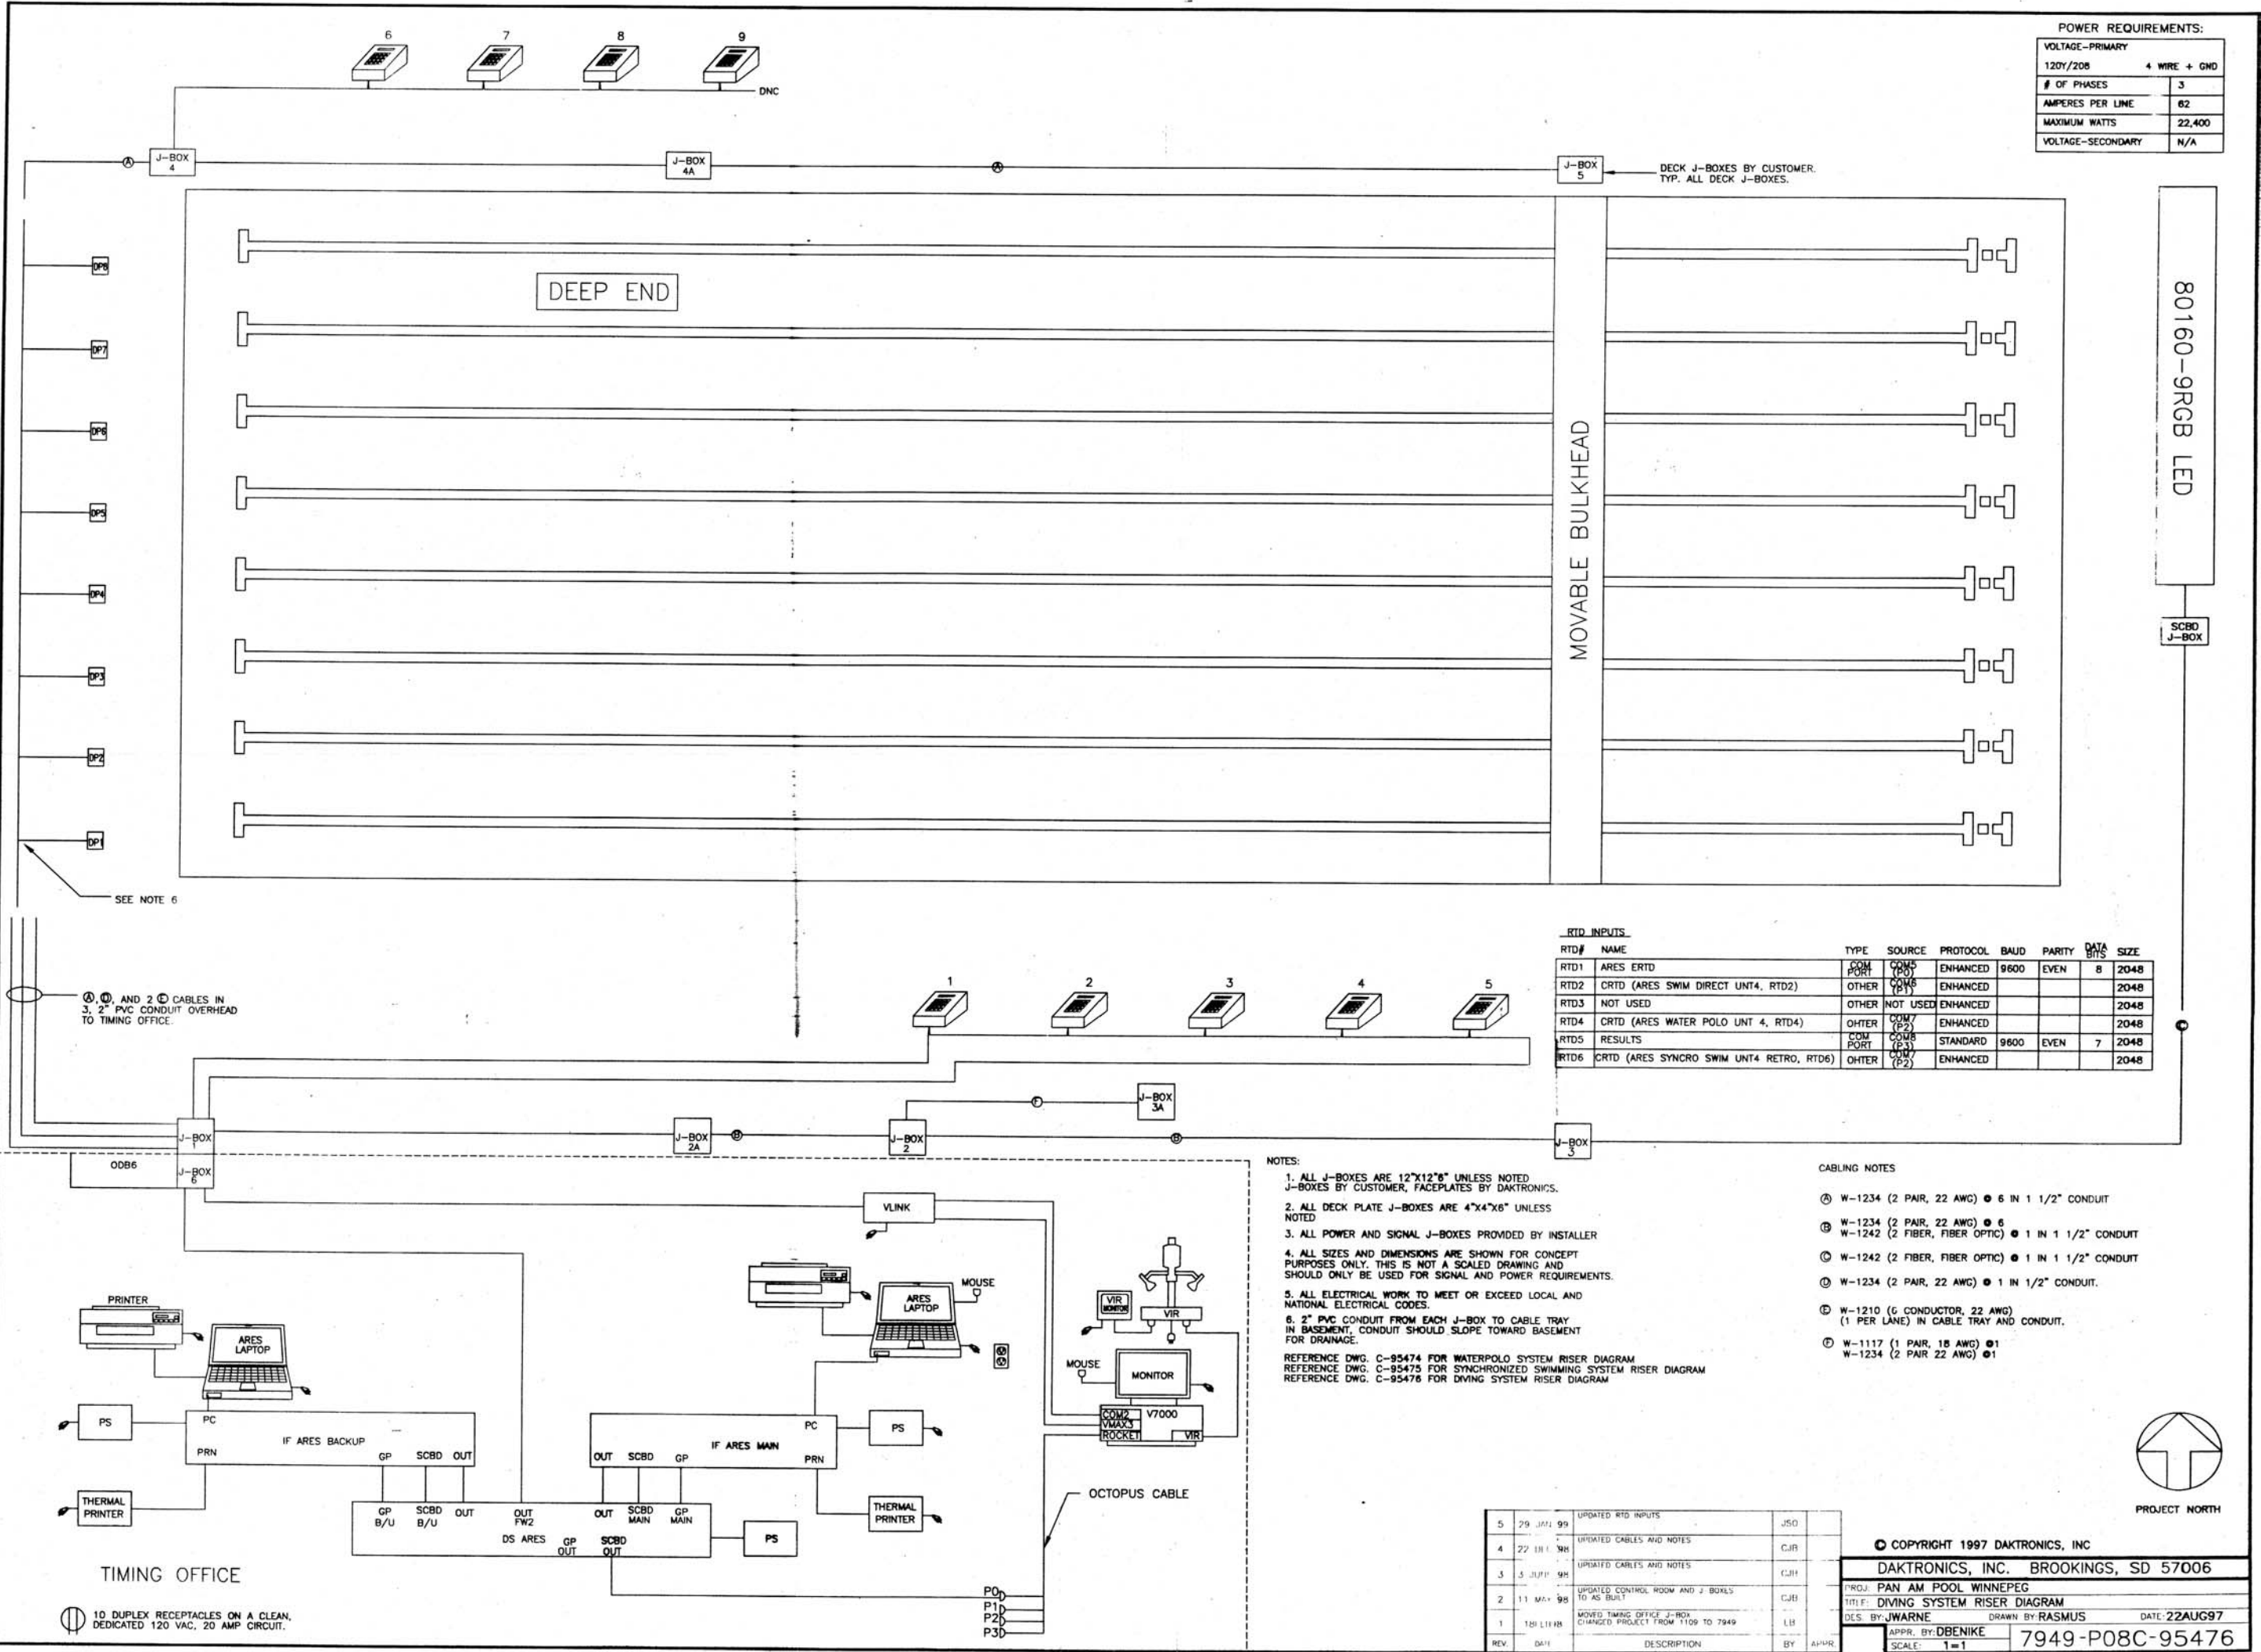

80160-9RGB LED

SCBD J-BOX

MOVABLE BULKHEAD

DEEP END

SEE NOTE 6

①, ②, AND ③ CABLES IN 3" 2" PVC CONDUIT OVERHEAD TO TIMING OFFICE.

RTD INPUTS

RTD#	NAME	TYPE	SOURCE	PROTOCOL	BAUD	PARITY	DATA BITS	SIZE
RTD1	ARES ERTD	COM PORT	COM7 (P2)	ENHANCED	9600	EVEN	8	2048
RTD2	CRTD (ARES SWIM DIRECT UNIT4, RTD2)	OTHER	COM8 (P1)	ENHANCED				2048
RTD3	NOT USED	OTHER	NOT USED	ENHANCED				2048
RTD4	CRTD (ARES WATER POLO UNIT 4, RTD4)	OTHER	COM7 (P2)	ENHANCED				2048
RTD5	RESULTS	COM PORT	COM8 (P3)	STANDARD	9600	EVEN	7	2048
RTD6	CRTD (ARES SYNCRO SWIM UNIT4 RETRO, RTD6)	OTHER	COM7 (P2)	ENHANCED				2048

- NOTES:**
1. ALL J-BOXES ARE 12"x12"x8" UNLESS NOTED. J-BOXES BY CUSTOMER, FACEPLATES BY DAKTRONICS.
 2. ALL DECK PLATE J-BOXES ARE 4"x4"x8" UNLESS NOTED.
 3. ALL POWER AND SIGNAL J-BOXES PROVIDED BY INSTALLER.
 4. ALL SIZES AND DIMENSIONS ARE SHOWN FOR CONCEPT PURPOSES ONLY. THIS IS NOT A SCALED DRAWING AND SHOULD ONLY BE USED FOR SIGNAL AND POWER REQUIREMENTS.
 5. ALL ELECTRICAL WORK TO MEET OR EXCEED LOCAL AND NATIONAL ELECTRICAL CODES.
 6. 2" PVC CONDUIT FROM EACH J-BOX TO CABLE TRAY IN BASEMENT. CONDUIT SHOULD SLOPE TOWARD BASEMENT FOR DRAINAGE.
- REFERENCE DWG. C-95474 FOR WATERPOLO SYSTEM RISER DIAGRAM
 REFERENCE DWG. C-95475 FOR SYNCHRONIZED SWIMMING SYSTEM RISER DIAGRAM
 REFERENCE DWG. C-95476 FOR DIVING SYSTEM RISER DIAGRAM

- CABLING NOTES**
- ① W-1234 (2 PAIR, 22 AWG) ● 6 IN 1 1/2" CONDUIT
 - ② W-1234 (2 PAIR, 22 AWG) ● 6
 - ③ W-1242 (2 FIBER, FIBER OPTIC) ● 1 IN 1 1/2" CONDUIT
 - ④ W-1242 (2 FIBER, FIBER OPTIC) ● 1 IN 1 1/2" CONDUIT
 - ⑤ W-1234 (2 PAIR, 22 AWG) ● 1 IN 1/2" CONDUIT.
 - ⑥ W-1210 (6 CONDUCTOR, 22 AWG) (1 PER LANE) IN CABLE TRAY AND CONDUIT.
 - ⑦ W-1117 (1 PAIR, 18 AWG) ● 1
 - ⑧ W-1234 (2 PAIR 22 AWG) ● 1

TIMING OFFICE

10 DUPLEX RECEPTACLES ON A CLEAN, DEDICATED 120 VAC, 20 AMP CIRCUIT.

REV.	DATE	DESCRIPTION	BY	APPR.
5	29 JAN 99	UPDATED RTD INPUTS	JSD	
4	27 FEB 98	UPDATED CABLES AND NOTES	CJB	
3	5 JUL 98	UPDATED CABLES AND NOTES	CJI	
2	11 MAY 98	UPDATED CONTROL ROOM AND J-BOXES TO AS BUILT	CJI	
1	18 FEB 98	MOVED TIMING OFFICE J-BOX CHANGED PROJECT FROM 1109 TO 7949	LB	

PROJECT NORTH

© COPYRIGHT 1997 DAKTRONICS, INC.

DAKTRONICS, INC. BROOKINGS, SD 57006

PROJ: PAN AM POOL WINNEPEG
 TITLE: DIVING SYSTEM RISER DIAGRAM
 DES. BY: JWARNE DRAWN BY: RASMUS DATE: 22AUG97
 APPR. BY: DBENIKE
 SCALE: 1=1 7949-P08C-95476