


INSTRUMENT LOOP DIAGRAM

LOOP NO. - M706

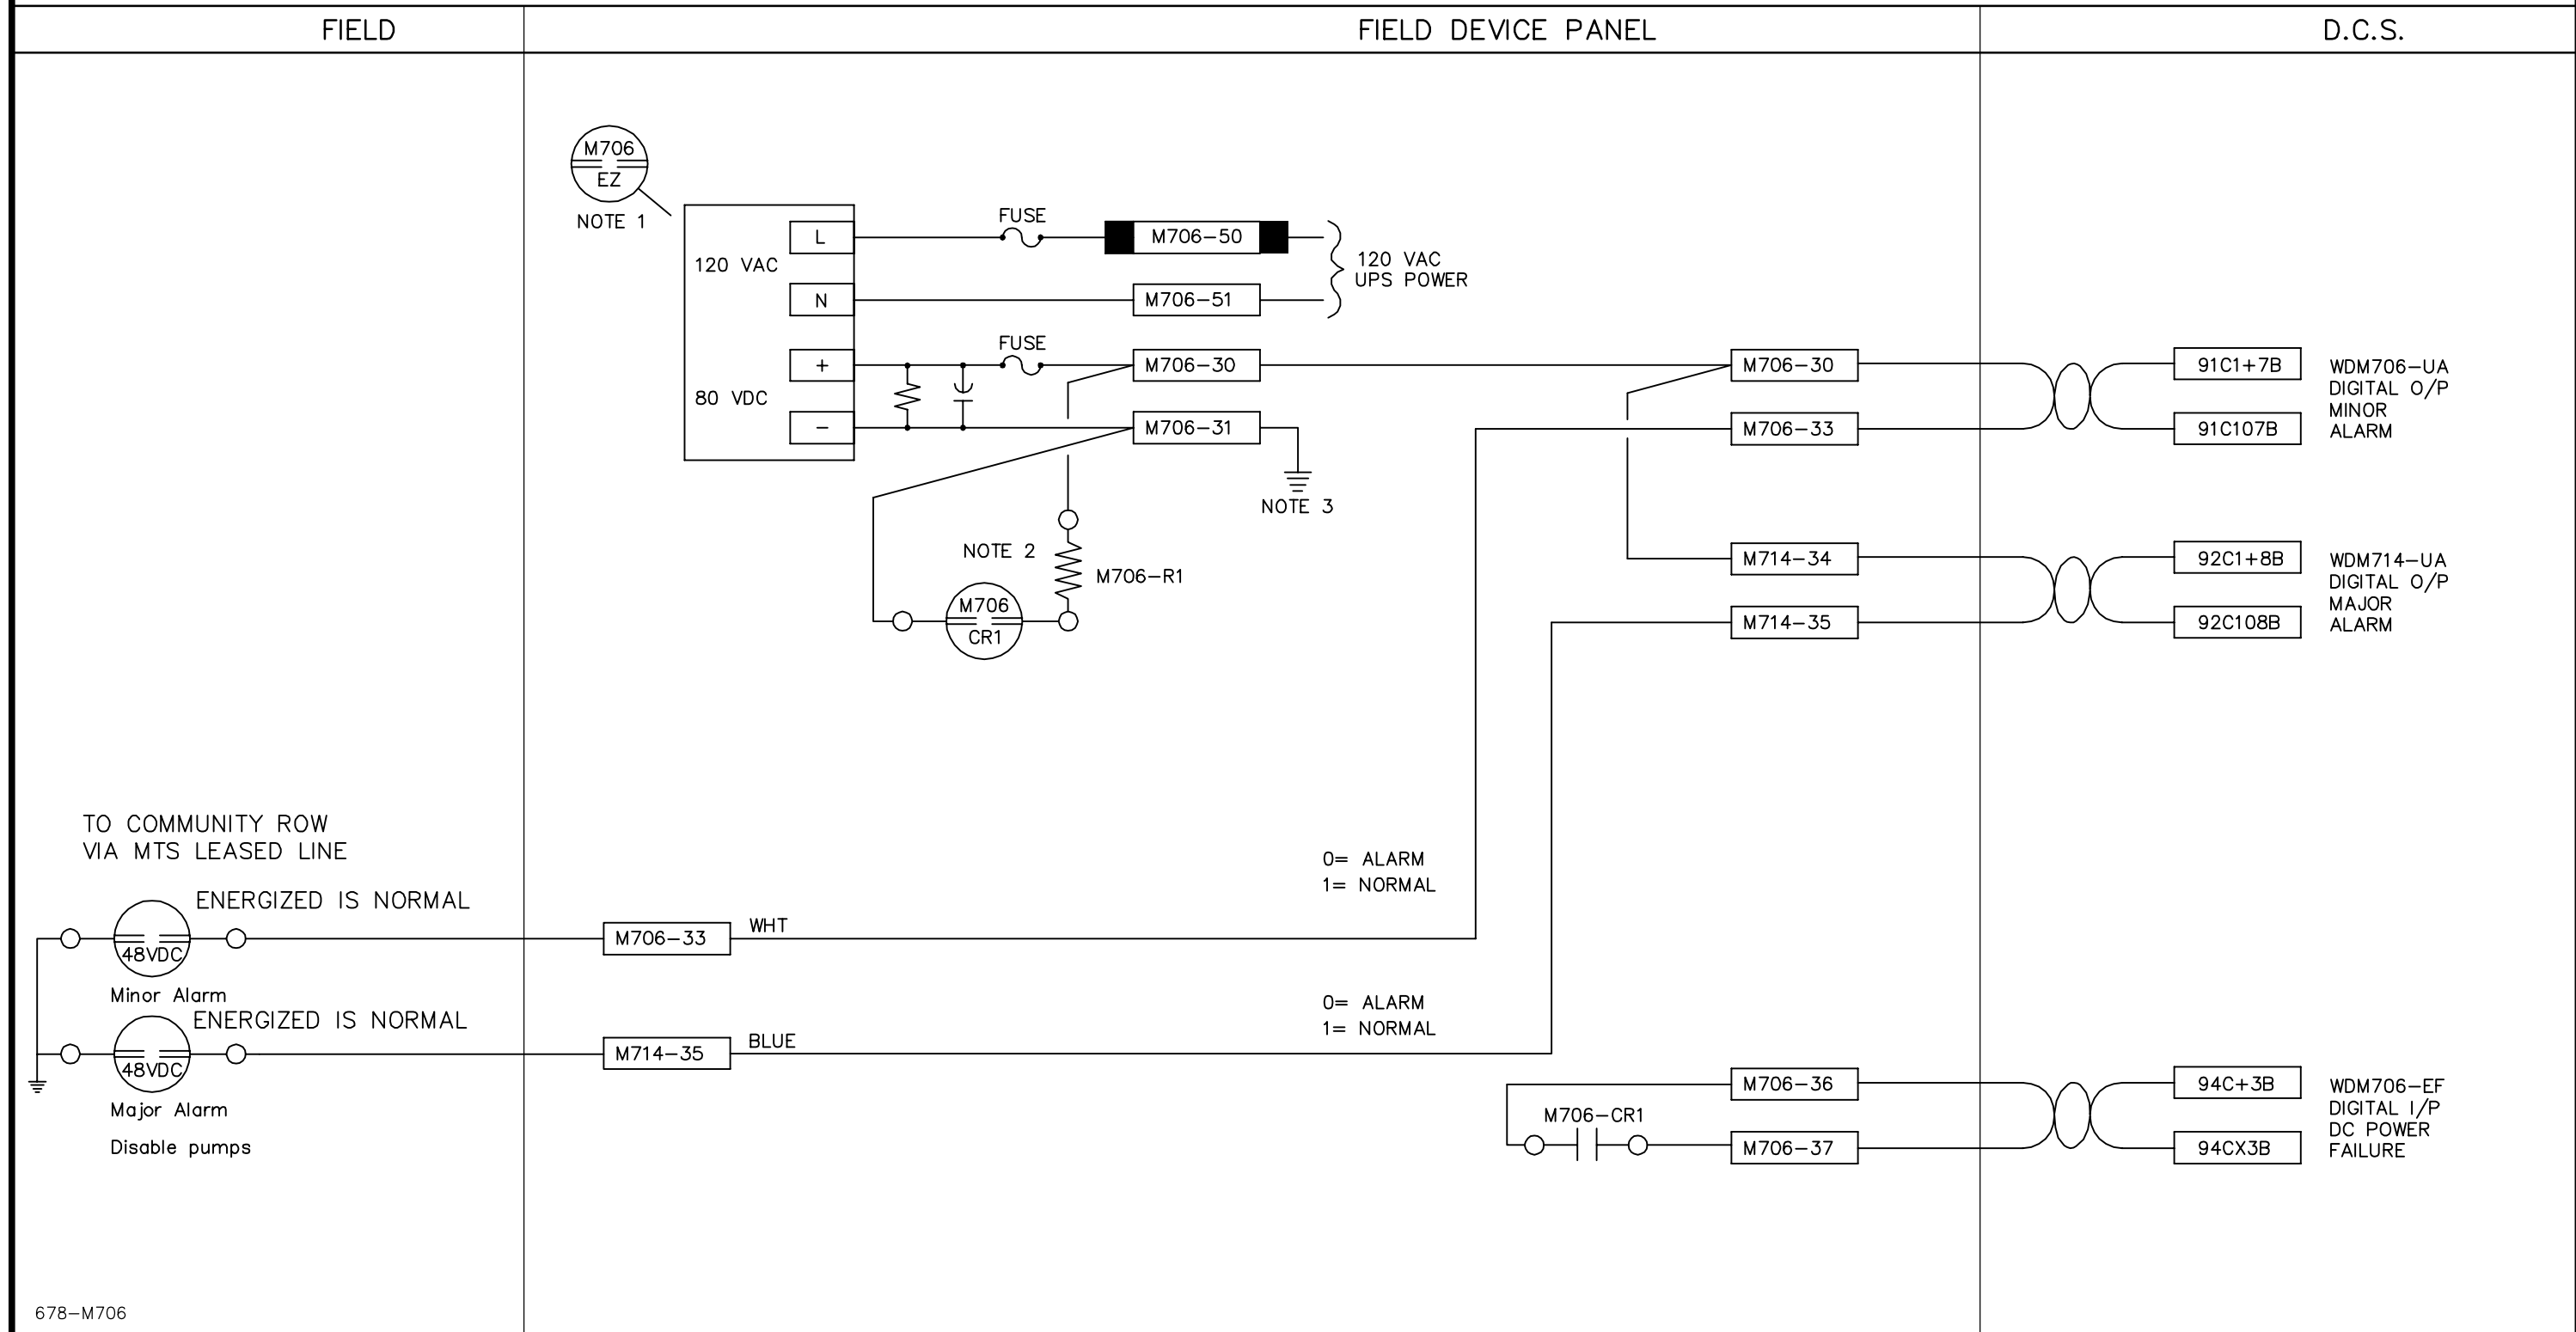


678-M706

NOTES

- 1.) EXISTING D.C. POWER SUPPLY RELOCATED TO FDP.
- 2.) RESISTOR ALLOWS 48 VDC RELAY TO OPERATE ON 80 VDC SUPPLY.
- 3.) CONNECT NEGATIVE SIDE OF DC POWER SUPPLY OUTPUT TO ELECTRICAL SYSTEM GROUND.

BAILEY TERMINAL NUMBERING

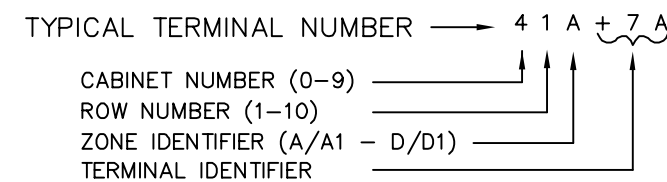

Reid Crowther

APR/15	RE DRAW	CN
DEC/96	GEN REVISION	MBD
JAN./94	AS BUILT	
DATE	REVISION	APP.



THE CITY OF WINNIPEG  
WORKS AND OPERATIONS DIVISION  
WATERWORKS, WASTE AND DISPOSAL DEPT.  
WEST END WATER POLLUTION CONTROL CENTRE

PERIMETER ROAD PUMPING STATION  
COMMUNITY ROW ALARMS WDM 706

SCALE N.T.S.  
DATE SEPT. 1993  
DES. BHK DWN DRP  
CKD APP

DRAWING NO.  
**WEP-678**