


COPYRIGHT: DUPLICATION, RECORDING, USE OR DISCLOSURE PROHIBITED WITHOUT WRITTEN AUTHORIZATION OF Roehampton Communications Ltd.

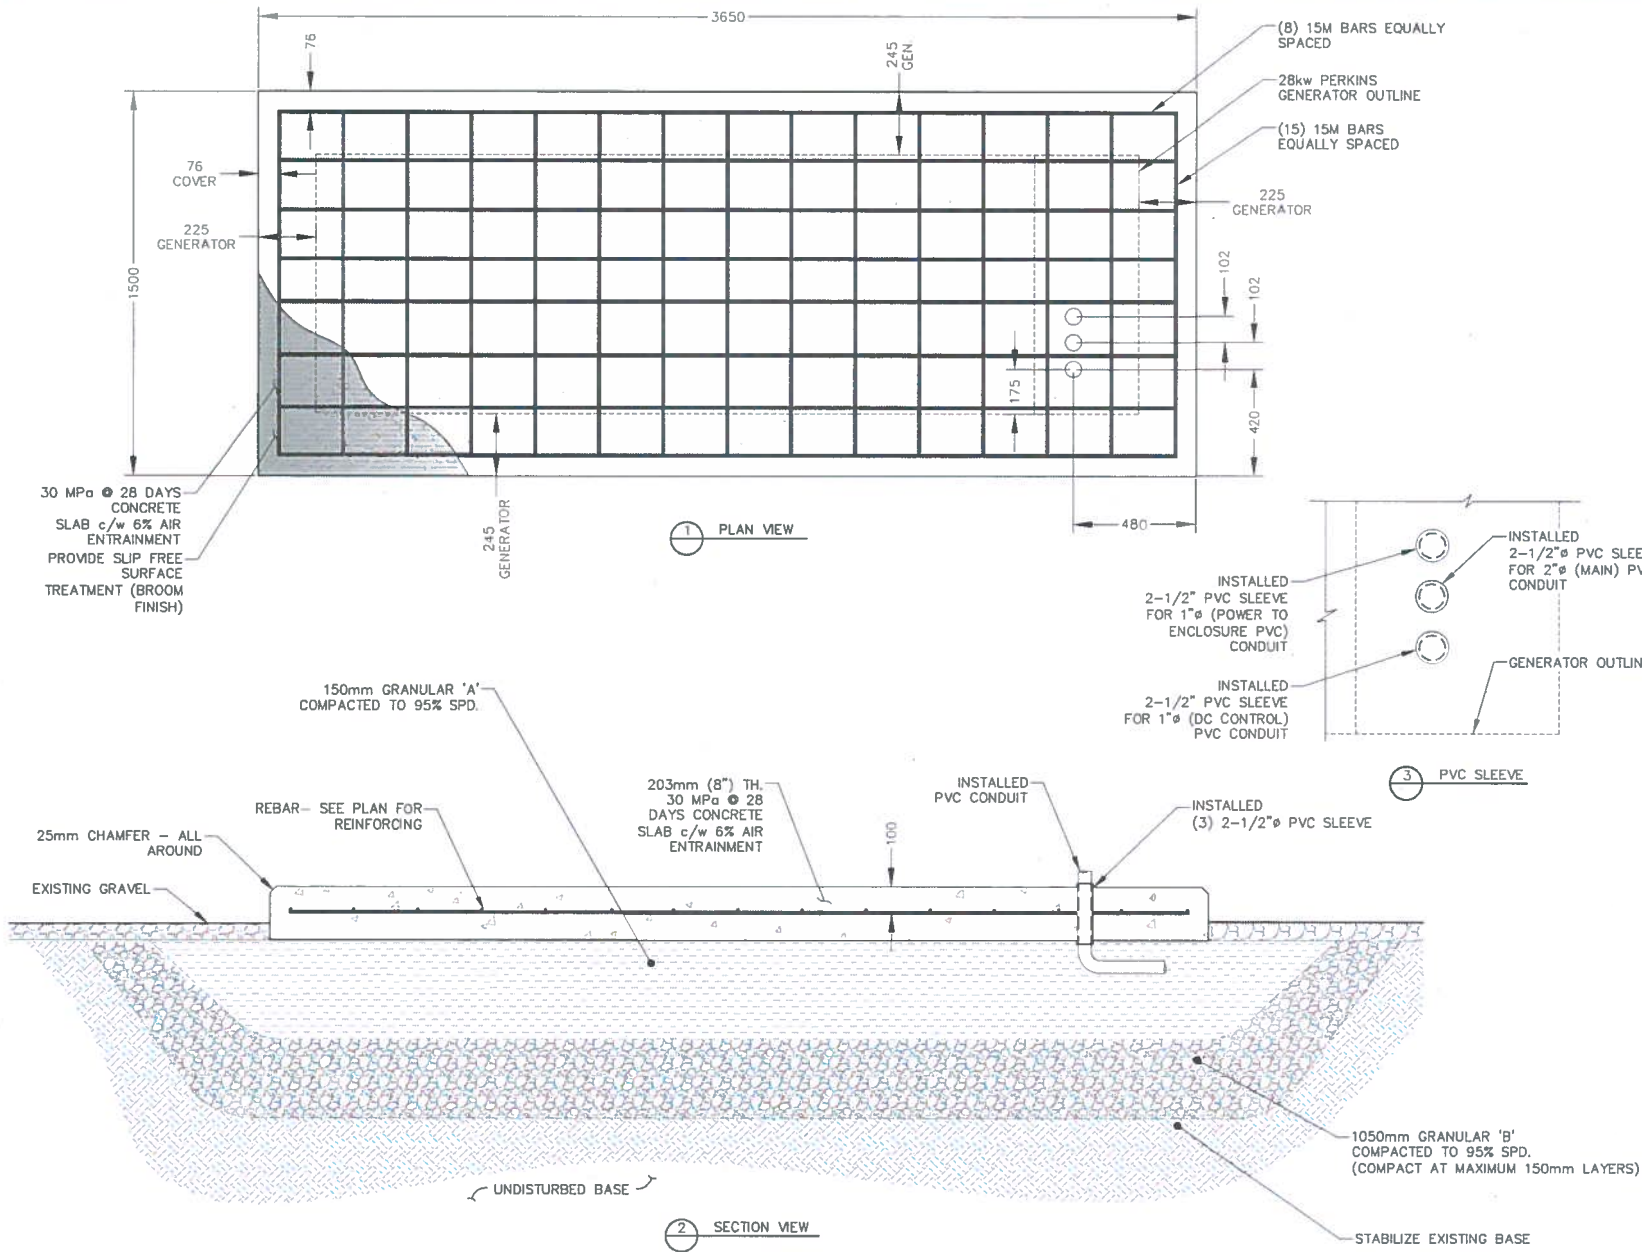

- NOTE:
1. FOUNDATION DESIGN IS BASED ON GEOTECHNICAL REPORT BY LAWRENCE, FLEMMING No.961116 DATED 01 AUG 1996.
 2. CONCRETE STRENGTH - 30MPa.
 3. REINF. TO CSA G30.18 GRADE 400.
 4. CONC. WORKS TO CSA A23.1, 23.2 & 23.3
 5. INSTALLATION MUST MEET ALL REQUIREMENTS OF HARRIS SPECIFICATIONS CONSTRUCTION REQUIREMENTS.

CLIENT:

CARRIER:

5			
4			
3			
2	NI	AS-BUILT 30 OCT 14	
1	AS	COMPOUND LAYOUT REVISION 22 OCT 13	
0	AG	ISSUED FOR CONSTRUCTION 23 SEP 13	
NO.	BY	DESCRIPTION	DATE
ROEHAMPTON COMMUNICATIONS LTD. 723 EVANS AVENUE, SUITE 803 TORONTO, ON M8C 6E9 TEL: (416) 223-0812 TORONTO - CALGARY - VANCOUVER			
LOCATION: HIGHWAY 12 & 48, BRECHIN, ONTARIO			
TITLE: GENERATOR PAD DETAILS			
PROJECT NAME:	PROJECT NO:	DWG. NO:	
NEXGEN P25	ON0120	F03	