


EQUIP No.:	C615	EQUIP No.:	C620	EQUIP No.:	C640	EQUIP No.:	C625
TYPE:	DUST FILTER BLOWER	TYPE:	DUST FILTER SHAKER	TYPE:	DRY FEEDER	TYPE:	VIBRATOR
CAPACITY:	17m³/min	POWER:	0.12 kW	POWER:	0.37 kW	POWER:	1.12 kW
POWER:	15 kW						

NOTICE:
AS-CONSTRUCTED DIMENSIONS, MEASUREMENTS AND OTHER DETAILS CONTAINED IN THIS RECORD DRAWING HAVE BEEN OBTAINED BY AECOM CANADA LTD. ("AECOM") FROM VARIOUS SOURCES. SUCH INFORMATION REPRESENTS THE BEST INFORMATION AVAILABLE TO AECOM AT THE TIME OF PREPARATION OF THIS RECORD DRAWING. AECOM DOES NOT IN ANY WAY REPRESENT OR WARRANT THAT SUCH INFORMATION IS ACCURATE AND ASSUMES NO RESPONSIBILITY FOR ANY ERRORS OR OMISSIONS CONTAINED THEREIN.

REVISION 03 CHANGES			
THE ENGINEER'S DESIGN RESPONSIBILITIES ARE LIMITED TO THE CHANGES INDICATED IN THE CLOUDED WORK			
DESIGNED BY:	CGL	CHECKED BY:	KJS
DRAWN BY:	SRG	APPROVED BY:	KJS
DATE:	-	RELEASED FOR CONSTR. DATE:	-

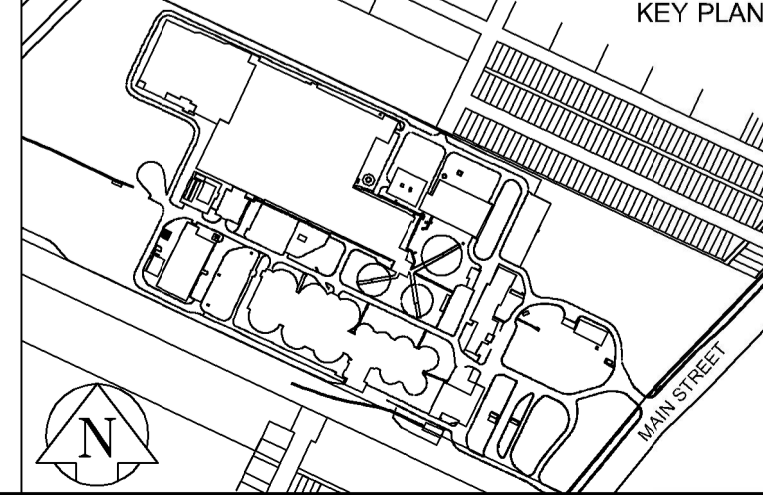

AECOM
Certificate of Authorization
AECOM Canada Ltd.
No. 4671 Date: April 6/16

B.M. ELEV.	NO.	REVISIONS	DATE	BY
	03	ISSUED FOR TENDER: BID OP 145-2016	16/04/06	SRG
	02	AS-CONSTRUCTED DRAWING	09/02/18	CD
	01	ISSUED FOR CONSTRUCTION	06/08/30	GLG
	00	ISSUED FOR TENDER	06/05/15	GLG

EarthTech
A Tyco International Ltd. Company

DESIGNED BY:	LW/CD	CHECKED BY:	SB/PS
DRAWN BY:	SRP	APPROVED BY:	
SCALE:	NONE	RELEASED FOR CONSTRUCTION BY:	
DATE:	2006/01/16	DATE:	

ENGINEER'S SEAL
PROVINCE OF MANITOBA
K.J. SEARS
REGISTERED PROFESSIONAL ENGINEER

THE CITY OF WINNIPEG
WATER AND WASTE DEPARTMENT
ENGINEERING DIVISION

NEWPCC CENTRATE NUTRIENT TREATMENT NITROGEN REMOVAL FACILITY

PROCESS
SODA ASH BLOWER SYSTEM
PROCESS & INSTRUMENTATION DIAGRAM

CITY FILE NUMBER
SHEET OF
CITY DRAWING NUMBER
1-0101C-P0028-001-03

CONSULTANT DRAWING NO. P10.02