


- NOTES:
1. REMOVE VALVE & BACKFLOW PREVENTER FROM EXISTING 1000 PW LINE, AND INSTALL BLIND FLANGE.
  2. CONNECT NEW FLUSHING WATER SERVICE TO EXISTING POTABLE WATER LINE.
  3. EXISTING POTABLE WATER LINES REPURPOSED FOR FLUSHING WATER SUPPLY.

NOTICE:  
AS-CONSTRUCTED DIMENSIONS, MEASUREMENTS AND OTHER DETAILS CONTAINED IN THIS RECORD DRAWING HAVE BEEN OBTAINED BY AECOM CANADA LTD. ("AECOM") FROM VARIOUS SOURCES. SUCH INFORMATION REPRESENTS THE BEST INFORMATION AVAILABLE TO AECOM AT THE TIME OF PREPARATION OF THIS RECORD DRAWING. AECOM DOES NOT IN ANY WAY REPRESENT OR WARRANT THAT SUCH INFORMATION IS ACCURATE AND ASSUMES NO RESPONSIBILITY FOR ANY ERRORS OR OMISSIONS CONTAINED THEREIN.

REVISION 03 CHANGES THE ENGINEER'S DESIGN RESPONSIBILITIES ARE LIMITED TO THE CHANGES INDICATED IN THE CLOUDED WORK			
DESIGNED BY: CGL	CHECKED BY: KJS		
DRAWN BY: SRG	APPROVED BY: KJS		
DATE: -	RELEASED FOR CONSTR. DATE: -		

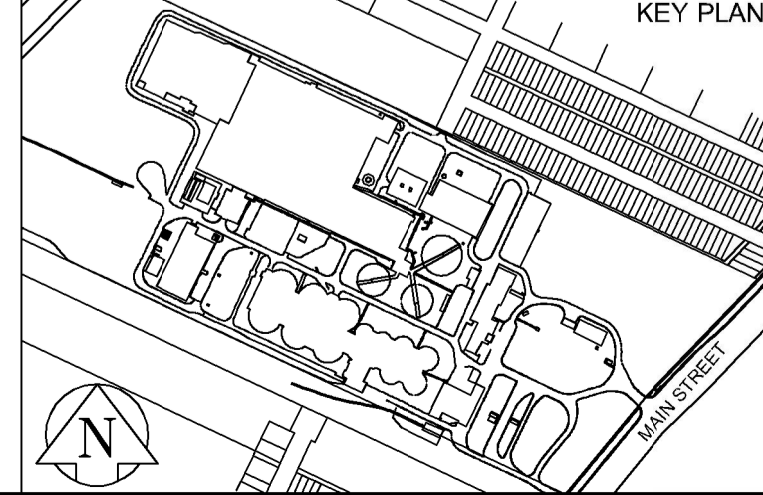

**AECOM**  
Certificate of Authorization  
AECOM Canada Ltd.  
No. 4671 Date: April 6/16

B.M. ELEV.	NO.	REVISIONS	DATE	BY
	03	ISSUED FOR TENDER: BID OP 145-2016	16/04/06	SRG
	02	AS-CONSTRUCTED DRAWING	09/02/18	CD
	01	ISSUED FOR CONSTRUCTION	06/08/30	GLG
	00	ISSUED FOR TENDER	06/05/15	SRP

**EarthTech**  
A Tyco International Ltd. Company

DESIGNED BY: LW/CD	CHECKED BY: SB/PS
DRAWN BY: SRP	APPROVED BY:
SCALE: NONE	RELEASED FOR CONSTRUCTION BY:
DATE: 2006/01/16	DATE:

ENGINEER'S SEAL  
PROVINCE OF MANITOBA  
K.J. SEARS  
REGISTERED PROFESSIONAL ENGINEER

**THE CITY OF WINNIPEG**  
WATER AND WASTE DEPARTMENT  
ENGINEERING DIVISION

NEWPCC CENTRATE NUTRIENT TREATMENT NITROGEN REMOVAL FACILITY

PROCESS  
SODA ASH SOLUTION TANK  
PROCESS & INSTRUMENTATION DIAGRAM

CITY FILE NUMBER  
SHEET OF  
CITY DRAWING NUMBER  
1-0101C-P0029-001-03

CONSULTANT DRAWING NO. P10.03